



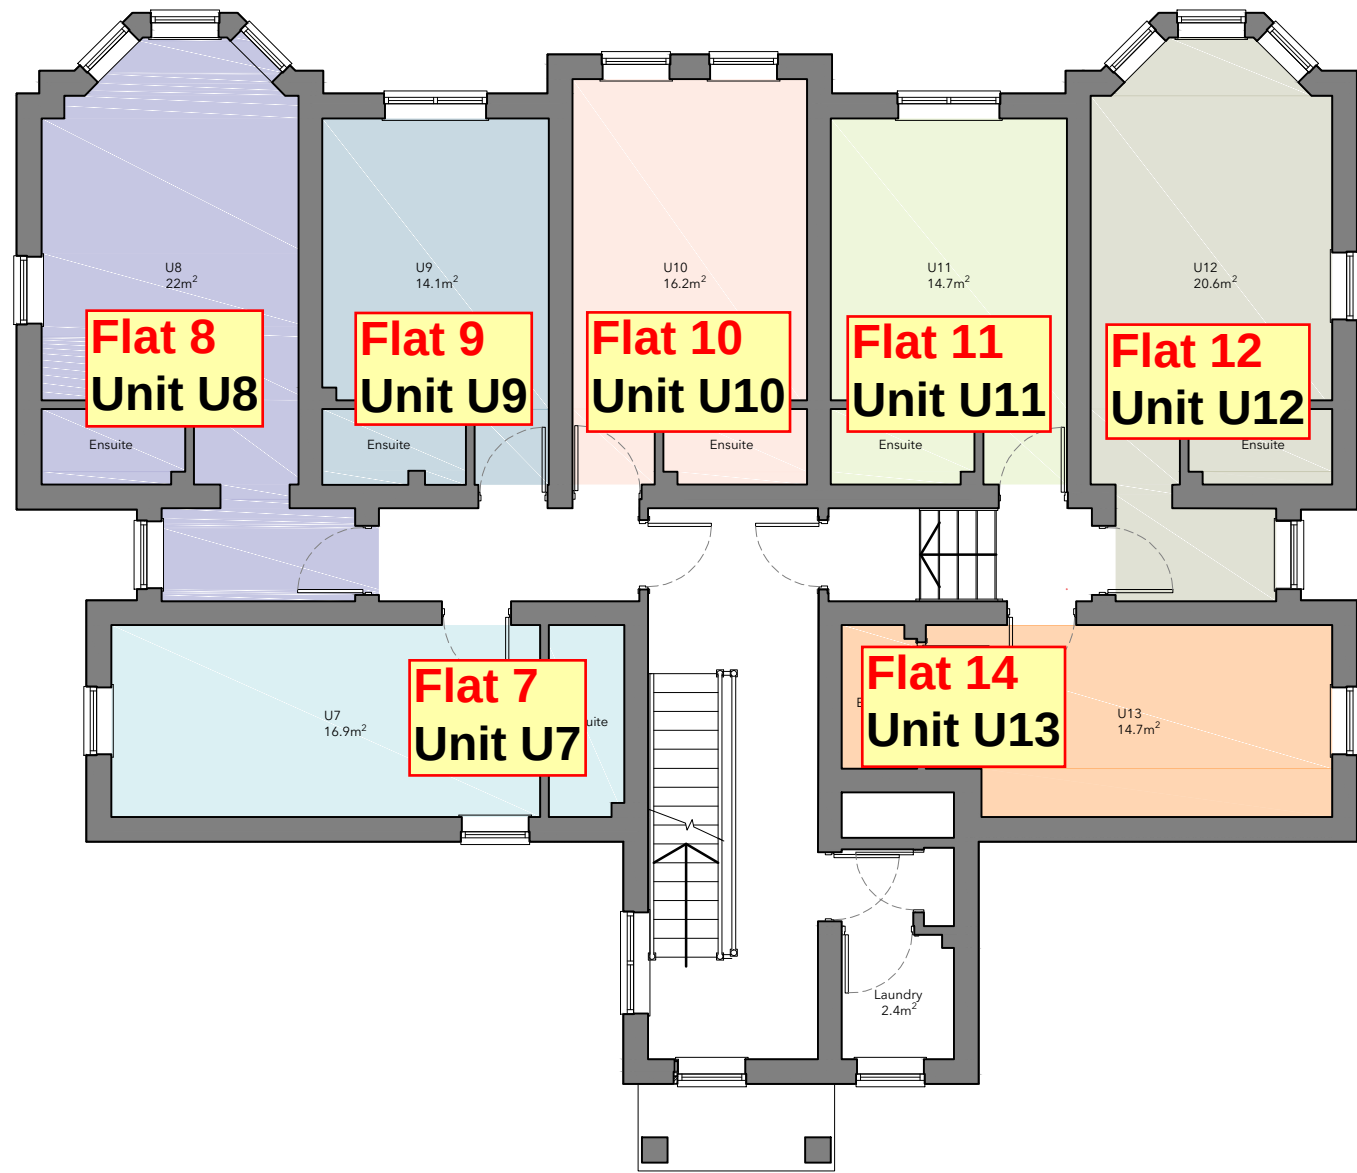


First Floor	
Flat No	GIA/m2 (Room + Ensuite)
U7	16.9
U8	22
U9	14.1
U10	16.2
U11	14.7
U12	20.6
U13	14.7

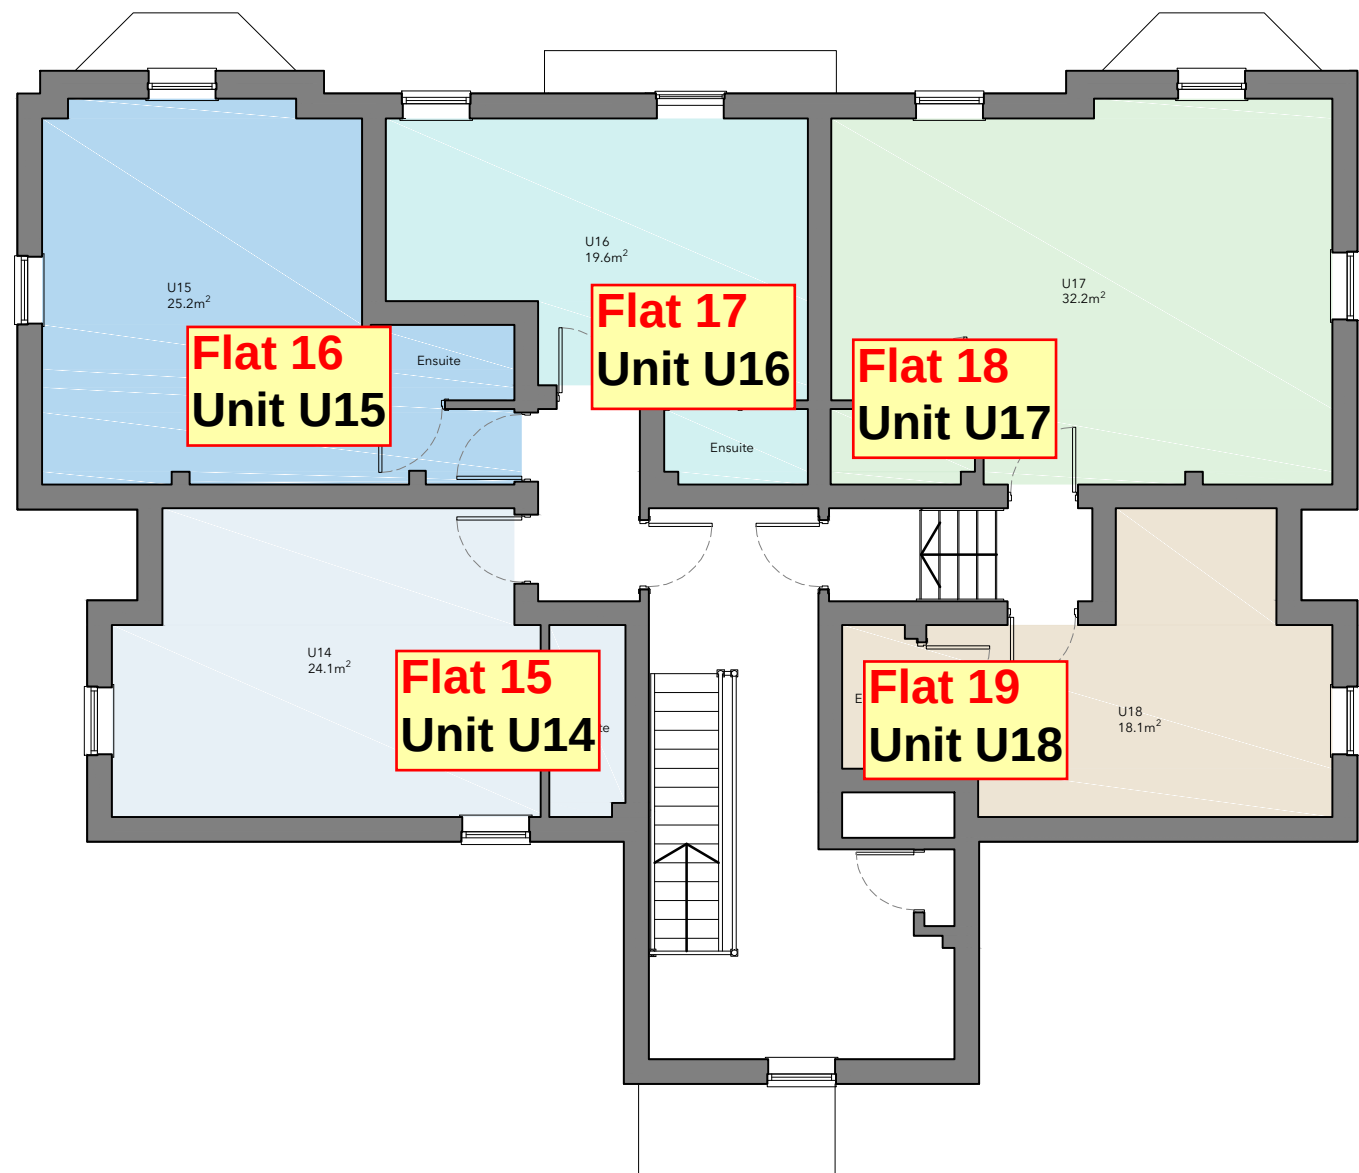

Second Floor	
Flat No	GIA/m2 (Room + Ensuite)
U14	24.1
U15	25.2
U16	19.6
U17	32.2
U18	18.1

BLOCK A
Units U1 to U18
POSTAL NUMBERS
Flats 1 to 19 (exc.13),
1, Charndon Close,
Reading.
RG2 0WL

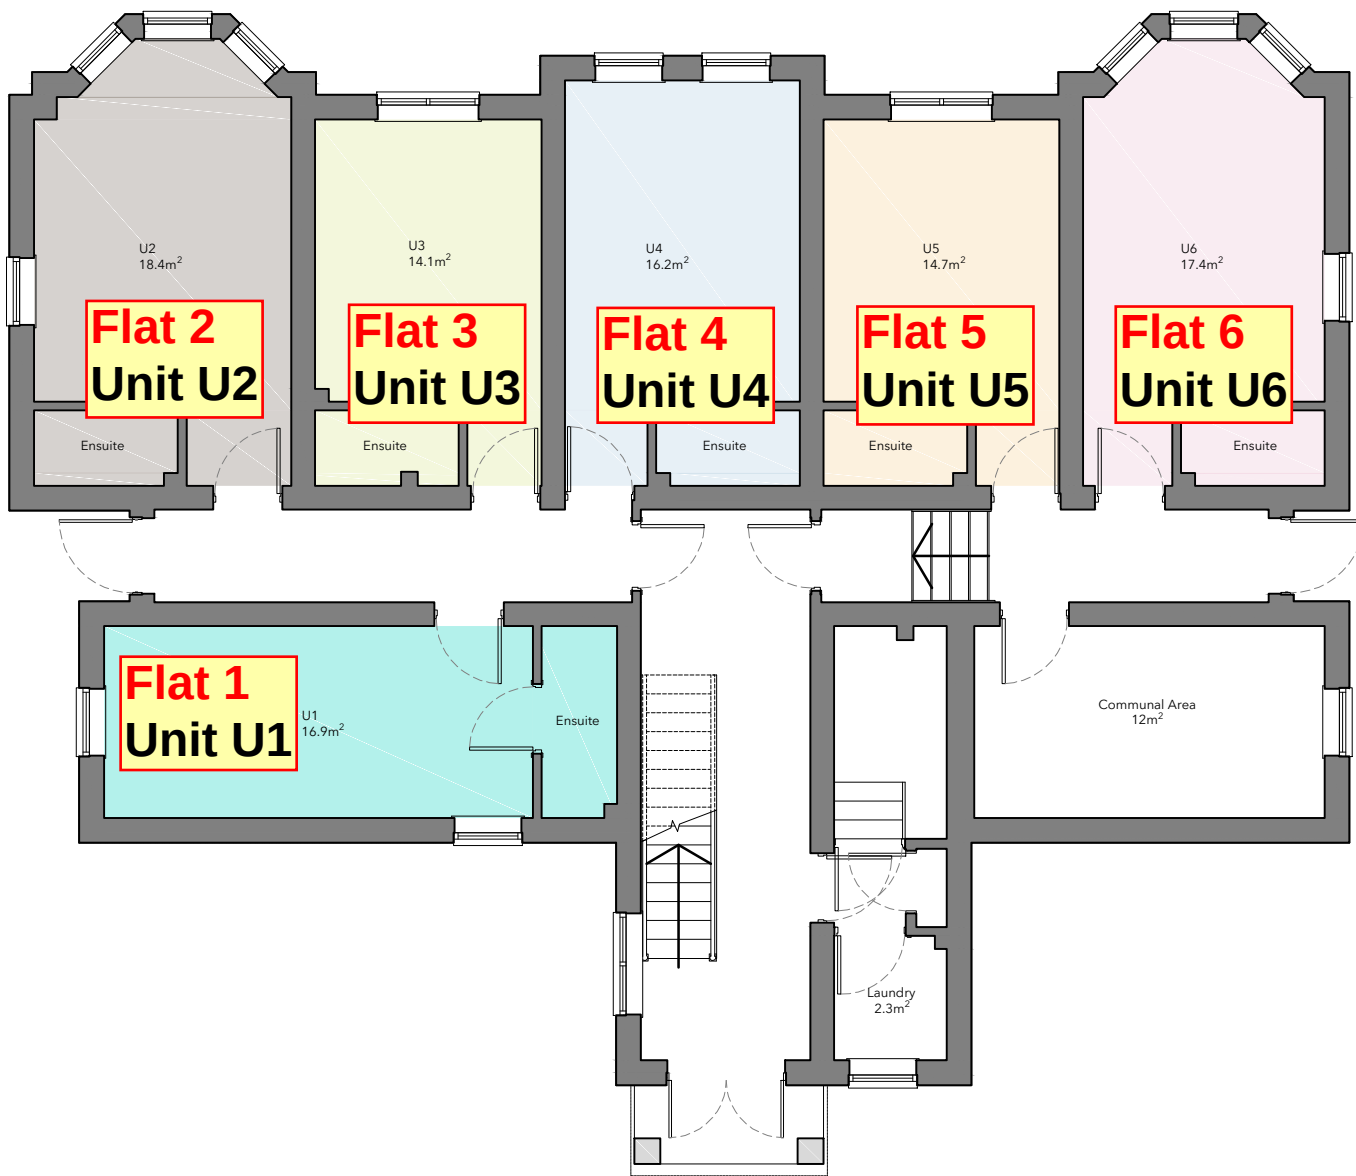

Ground Floor	
Flat No	GIA/m2 (Room + Ensuite)
U1	16.9
U2	18.4
U3	14.1
U4	16.2
U5	14.7
U6	17.4

A	General Amendments	04.07.23
No.	Description	Date

studio

t. 02382 542011
e. info@rs-studio.co.uk
w. www.rs-studio.co.uk

Drawing Title:
Floor Plan
Block A
AS BUILT

Project Title:
Woodley Arms
Waldeck Street, Reading,
RG1 2RF

Drawing No.:
1559-M-101

Date:	June 2023
Scale:	1:100
Drawn:	LM
Checked:	RS

This drawing is the copyright of the company and must not be reproduced or used without permission. Annotated dimensions are to be taken in preference to scaled dimensions and site dimensions must be checked before work is commenced