




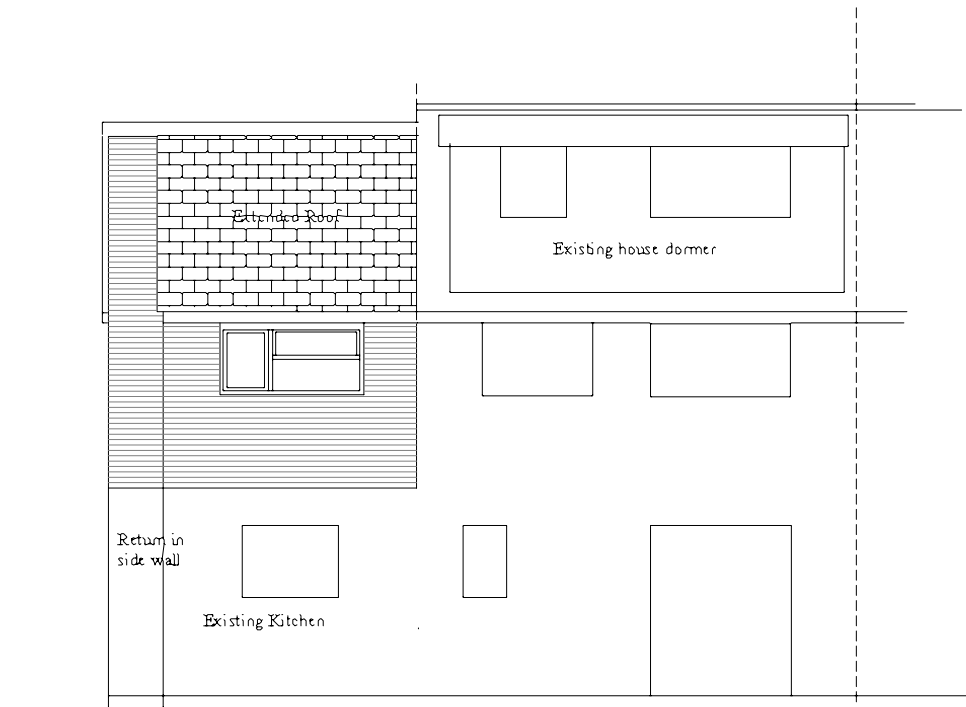

PROPOSED FRONT ELEVATION

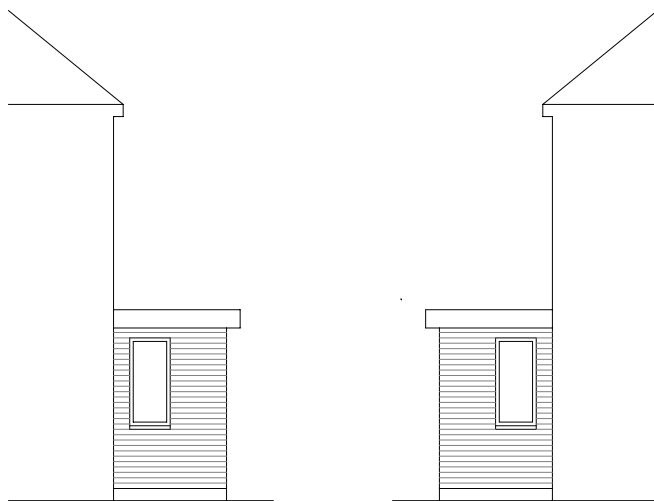

PROPOSED REAR ELEVATION

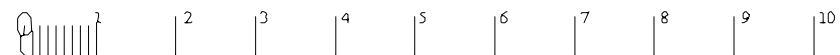

WEST

EAST

PORCH SIDE ELEVATIONS

AS BUILT DRAWING

NOVEMBER 2022

32 Ashampstead Road, RG30 3LA
Front and Rear Elevations Proposed

Scale 1:100