


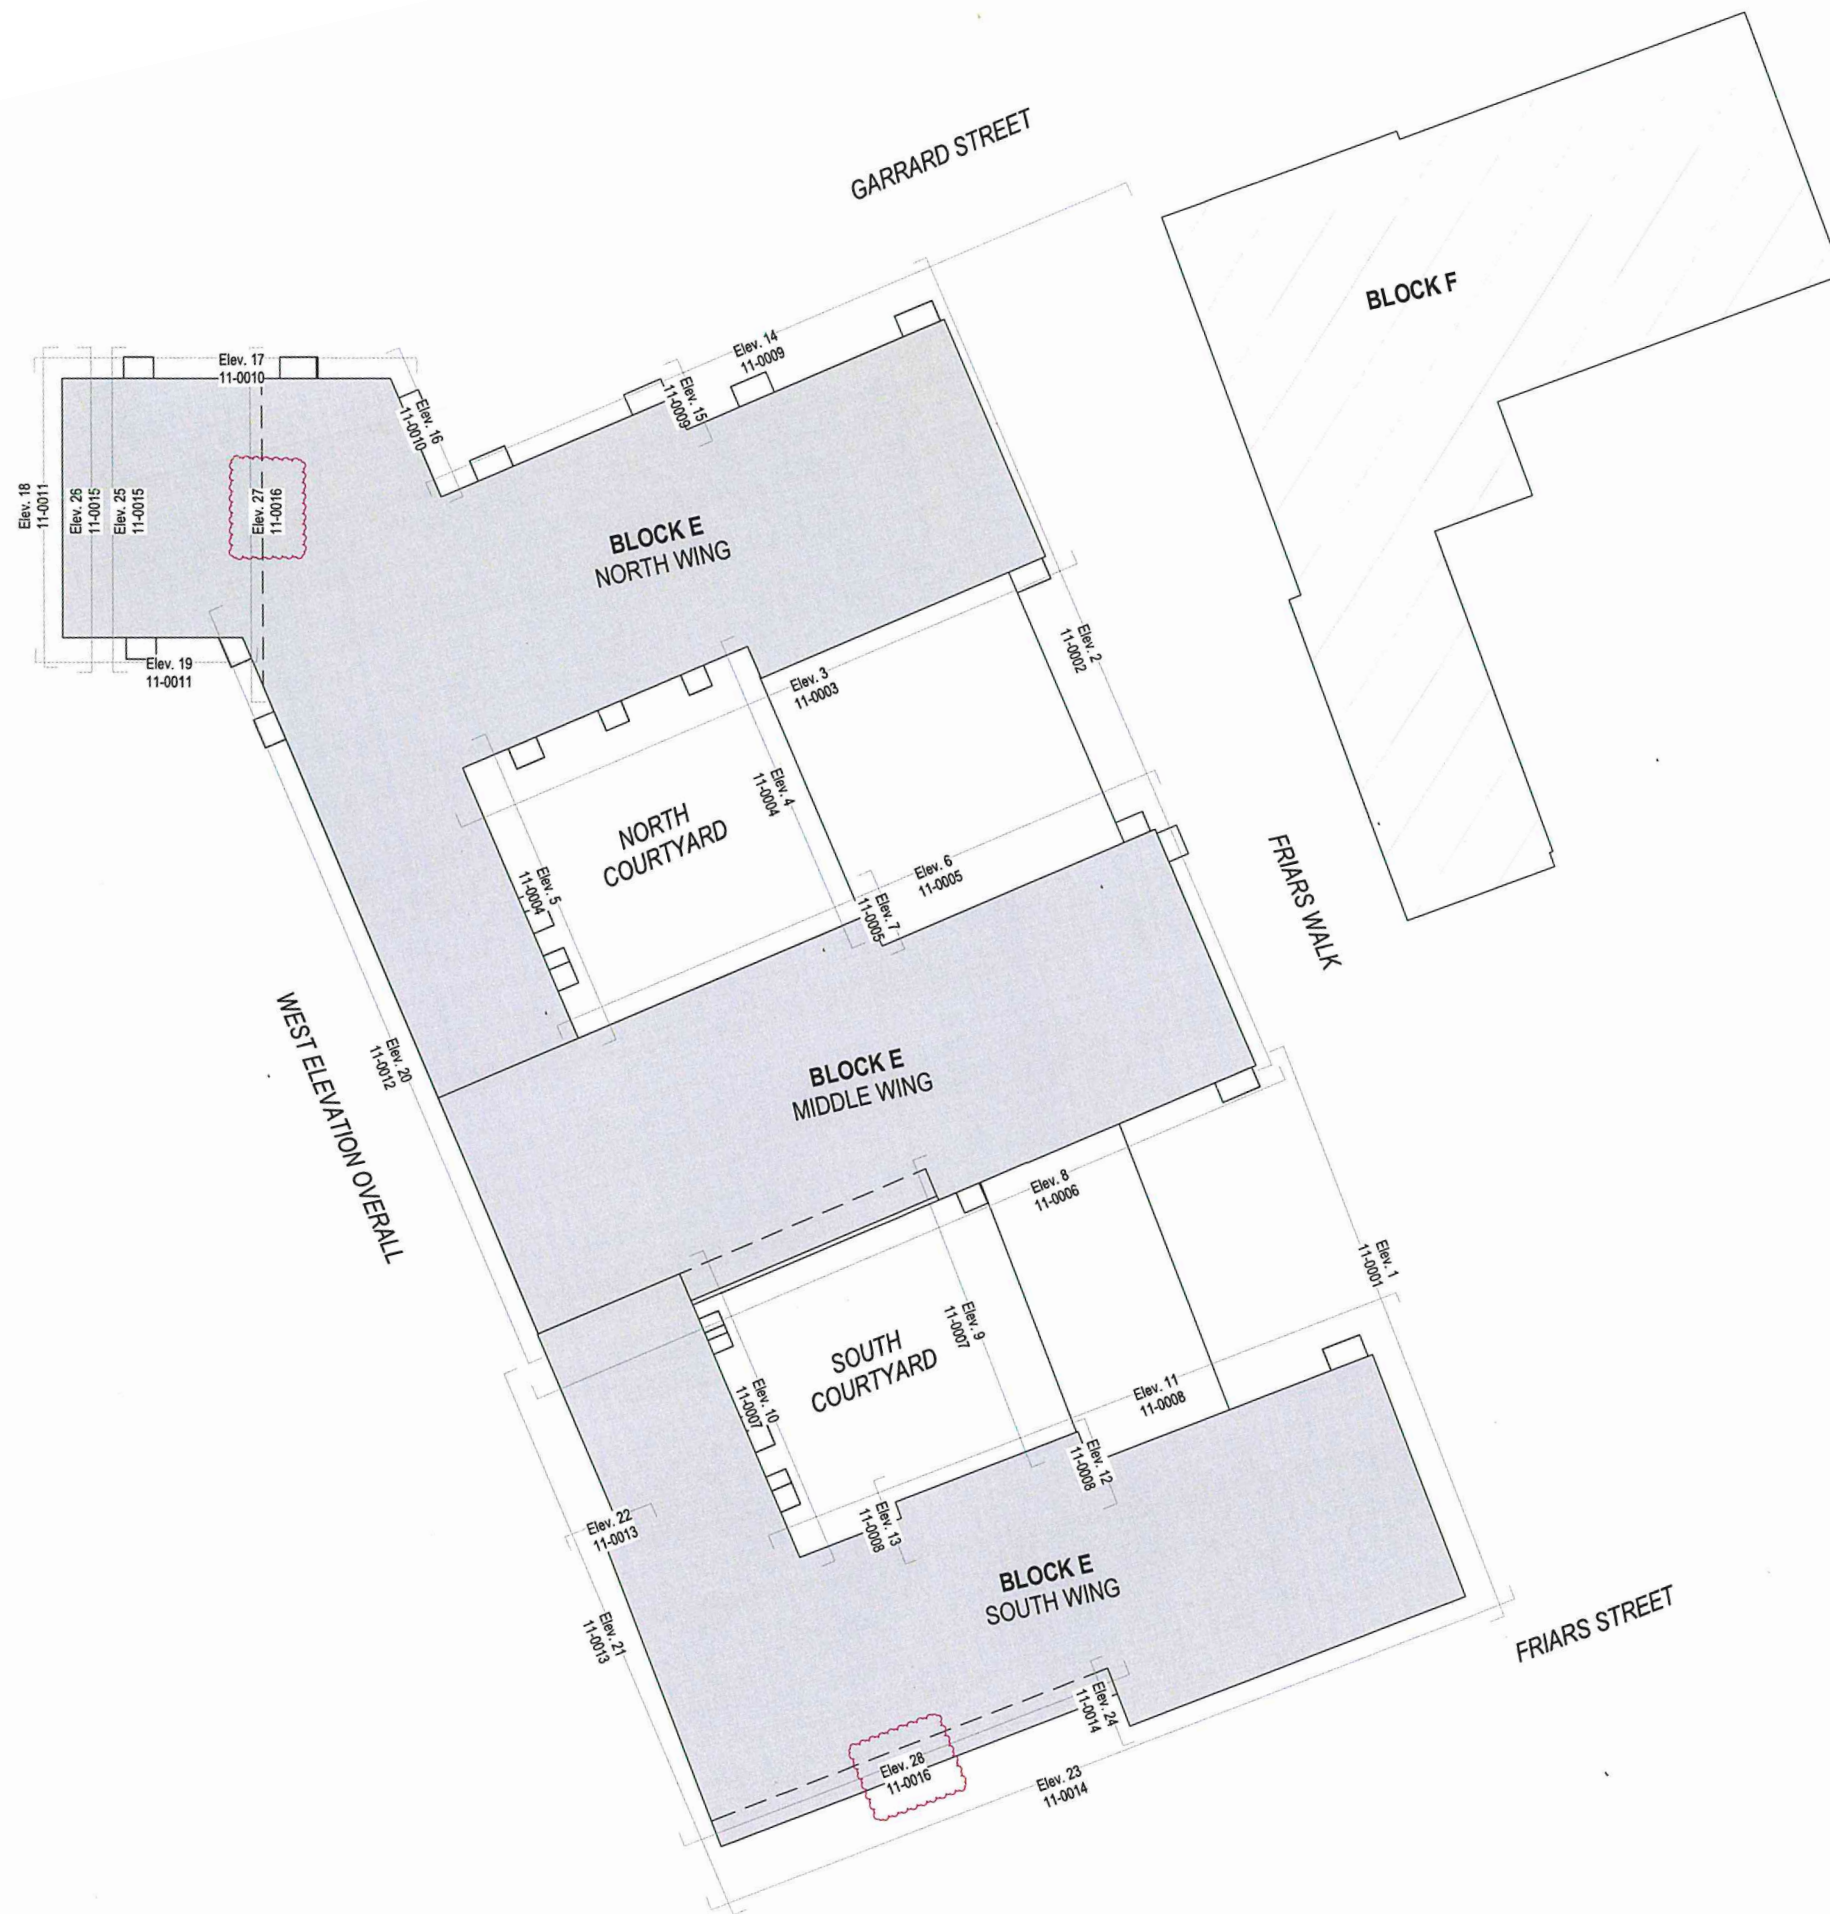

DO NOT SCALE DIMENSIONS OF THIS DRAWING.
CHECK ALL DIMENSIONS ON SITE BEFORE FABRICATION.
FINAL COORDINATION AND CHECKS ARE RESPONSIBILITY OF THE SITE TEAM.
TO SUIT CONDITIONS AND TO ENABLER TO MIDGARD LIMITED.
REPORT ALL ERRORS OR OMISSIONS TO MIDGARD LIMITED.
THIS DRAWING IS PROTECTED UNDER COPYRIGHT AND SHALL NOT BE
REPRODUCED IN PART OR WHOLE WITHOUT PRIOR EXPRESSED
PERMISSION OF MIDGARD LIMITED.



REV	BY	DATE	CHK	DESCRIPTION
C02	MP	17.05.22	SB	ELEVATIONS DRAWING NUMBERS ADDED
C01	MP	07.09.21	SB	ELEVATIONS DRAWING NUMBERS ADDED
P01	MP	14.06.21	SB	FIRST ISSUE

FOR CONSTRUCTION

CONTRACTOR
MIDGARD LTD
PROJECT
Station Hill, Reading
CLIENT
SH Reading (phase 1) Limited

DRAWING TITLE			
Block E Elevations General Key Plan			
DATE CREATED	DATE AMENDED	CHECKED	SCALE
14.06.21	17.05.22	SB	1 : 250 @ A1
DRAWN BY	AMENDED BY		
MP	MP		

DRAWING NO & REVISION
SHR-MDS-BE-ZZ-DR-A-11-0000 - C02



A diagram showing a large, irregular polygon with a cross-hatched pattern. A smaller, irregular polygon is attached to its right side. A red line segment is drawn along the bottom edge of the large polygon, labeled with the letter 'E'.



REFER TO DRAWING
BE-ZZ-DR-A-11-0002

- | | | | | |
|-----|----|----------|----|--|
| C02 | MP | 17.05.92 | SB | LOUVERE ADDED / FACADE MATERIAL, BALUSTRADES HEIGHT, TOP OF COPING, JOINTS, BALCONIES AND LEGEND UPDATED |
| C01 | MP | 07.09.21 | SB | MATERIALS AND LEGEND UPDATED / WINDOWS AND PORTAL FRAMES GENERALLY UPDATED / EXTERNAL BOXING ADDED |
| P03 | MP | 14.06.21 | SB | SECTIONS NUMBERS AND LEGENDS GENERALLY UPDATED / BALCONIES UPDATED / METAL CLADDING PANELS AND VERTICAL JOINTS ADDED |
| P02 | MP | 07.05.21 | SB | JULIETTE AND BALCONY DOORS SWING DIRECTIONS GENERALLY UPDATED / VIEWS REARRANGEMENT |
| P01 | MP | 28.04.21 | SB | FIRST ISSUE |

FOR CONSTRUCTION

MIDGARD LTD

Station Hill, Reading

SH Reading (phase 1) Limited

DRAWING TITLE
Block E
Elevations
Friars Walk Elevations 1/2

DATE CREATED 28.04.21	DATE AMENDED 17.05.22	SCALE 1 : 100 @A1
DRAWN BY MP	AMENDED BY MP	CHECKED SB

DRAWING NO & REVISION
SHR-MDS-BE-ZZ-DR-A-11-0001 - C02





JRL
MDS
Midgard Design Services

- 10MM VERTICAL MOVEMENT JOINT
 20MM VERTICAL MOVEMENT JOINT
 30MM VERTICAL MOVEMENT JOINT
 20MM HORIZONTAL MOVEMENT JOINT
 30MM HORIZONTAL MOVEMENT JOINT

- LEGEND**
- | | |
|---|--|
|  | SWIFT BIRD BOX - 16S SCHWEGLER 430 mm(W)x240 mm (H)x220 mm (D) |
|  | BIRD BOX - 1HE SCHWEGLER BRICK BOX 280 mm(L)x150 mm (H)x150 mm (D) |
|  | BAT BOX - 1 FR SCHWEGLER BAT TUBE 200 mm(L)x475 mm (H)x125 mm (D) |

FOR JOINTS IN METAL CLADDING REFER TO SERIES 12 DRAWINGS

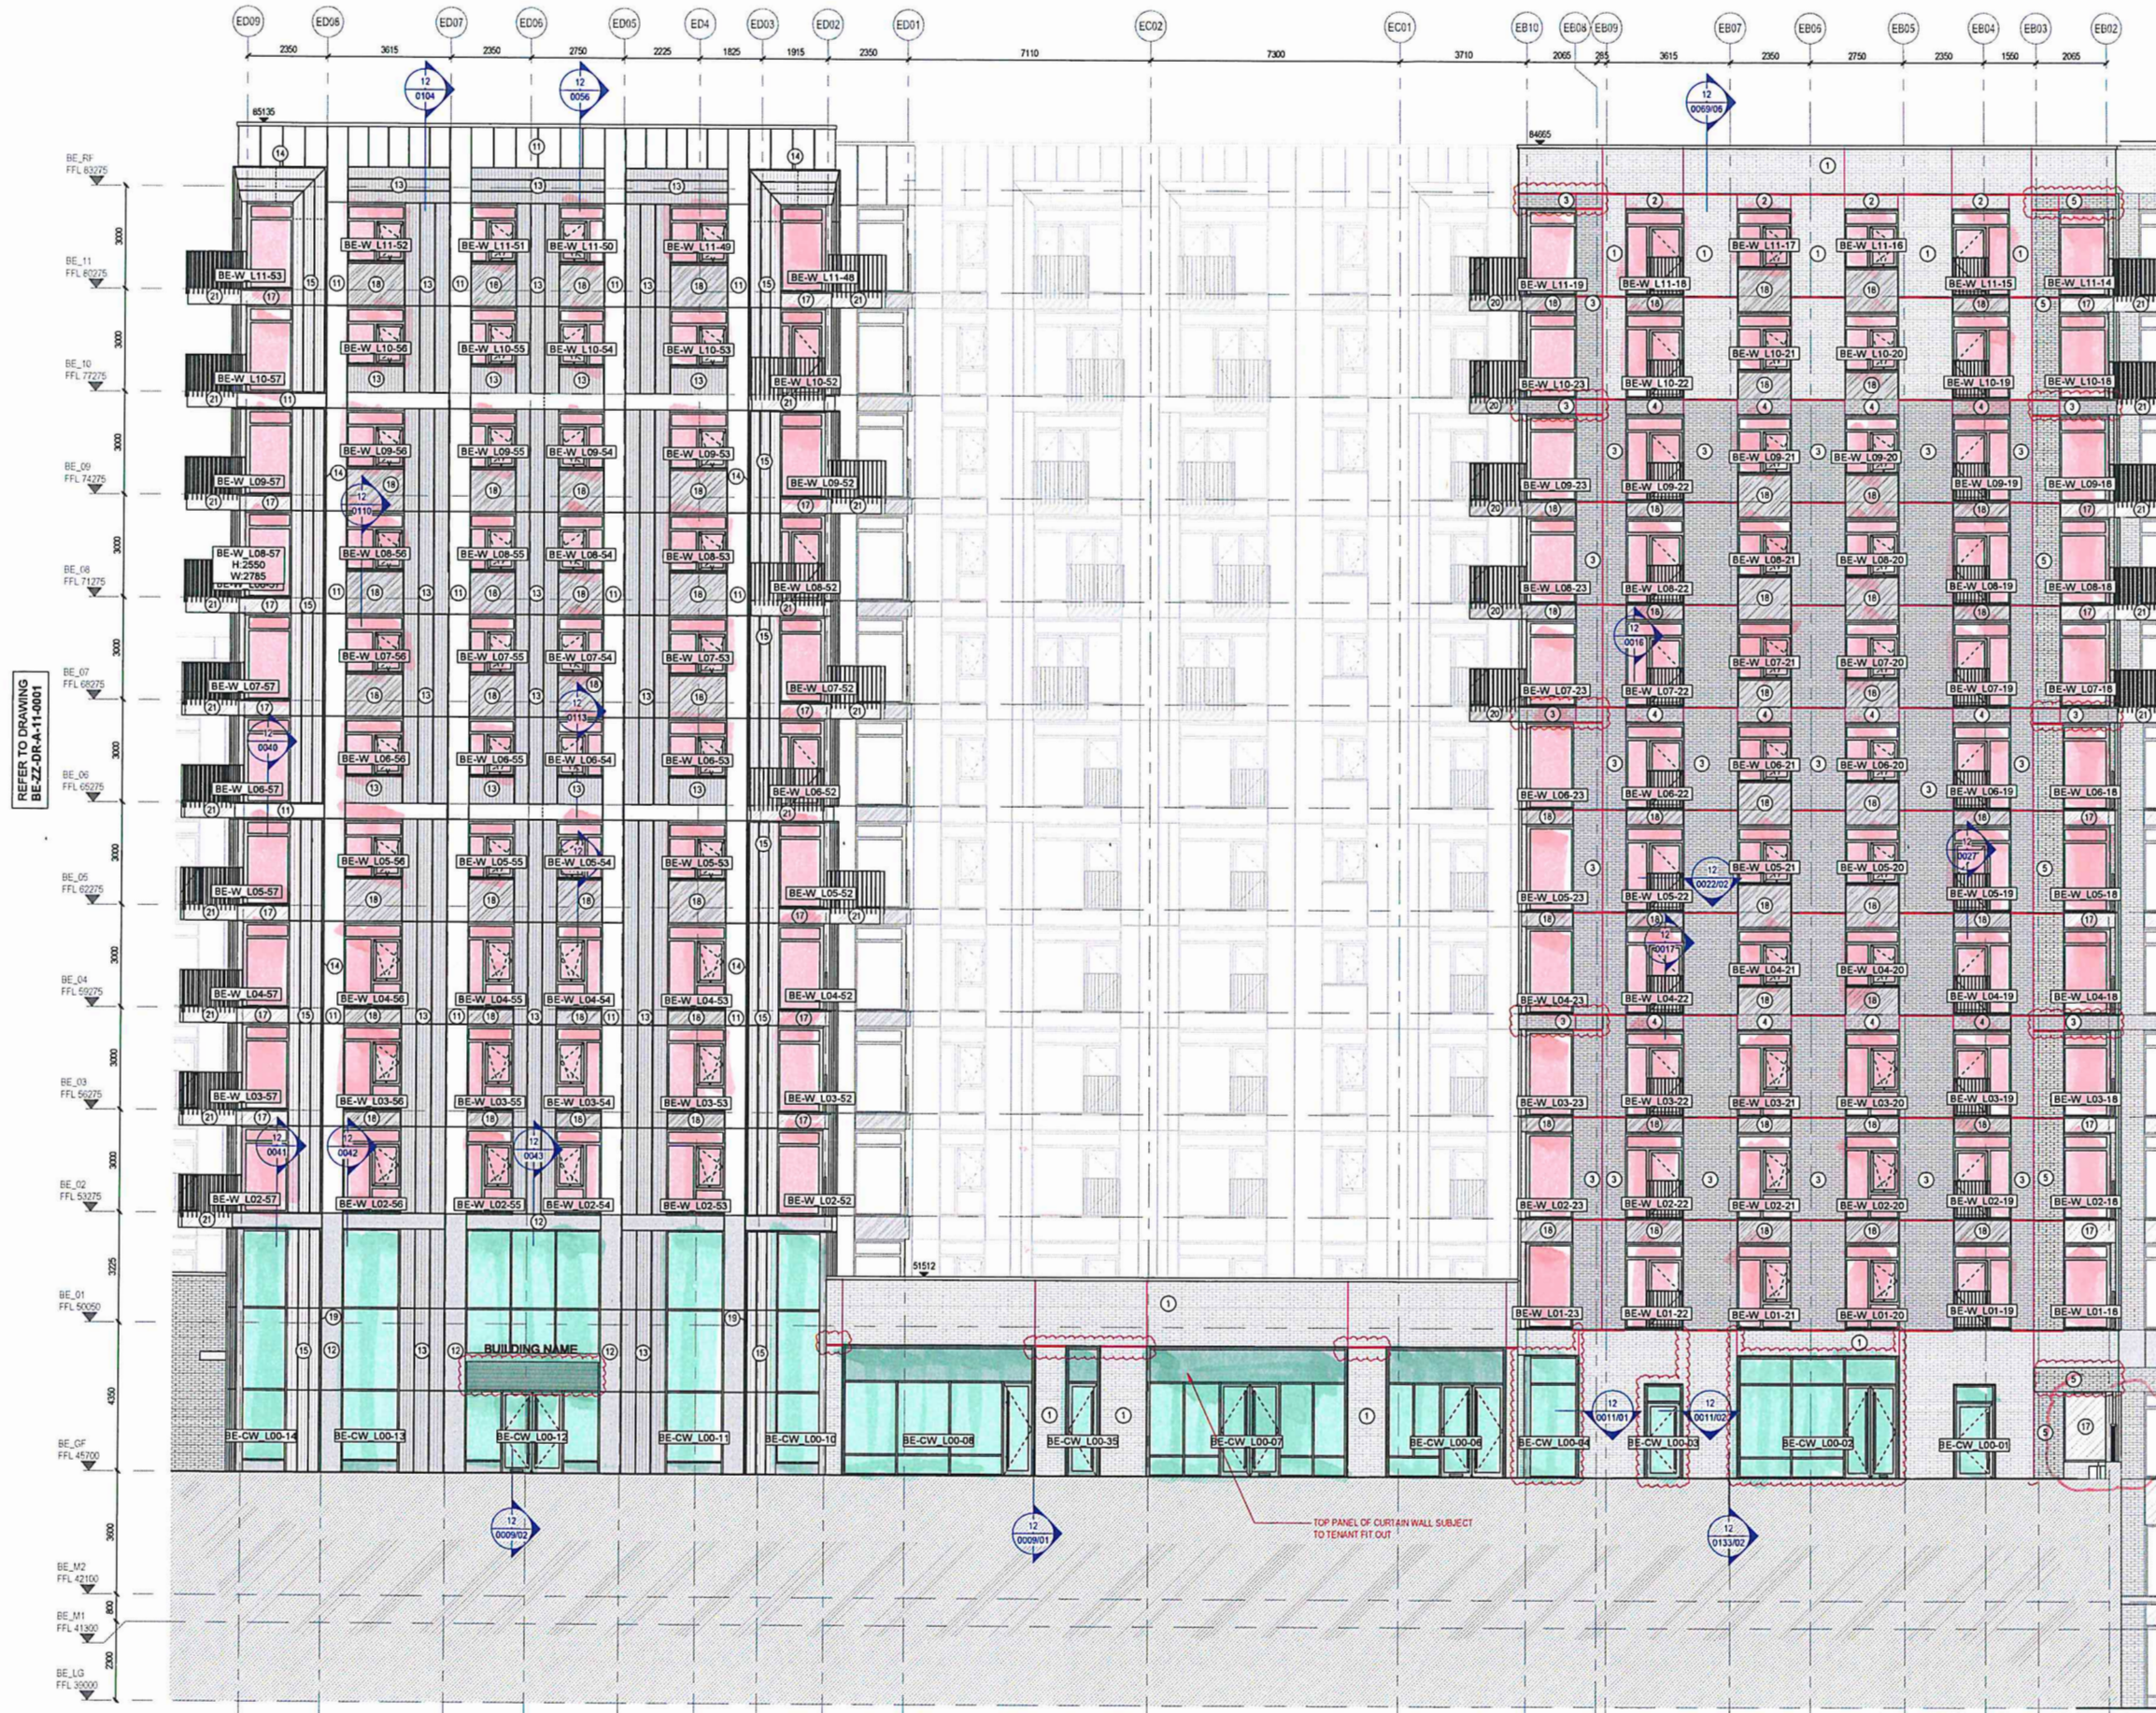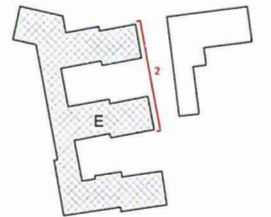

- LEGEND**
- BRICKWORK**
- TYPE 1. KARMA WHITE BRICK
 - TYPE 2. KARMA WHITE BRICK SLIP
 - TYPE 3. PAGUS GREY BRICK
 - TYPE 4. PAGUS GREY BRICK SLIP
 - TYPE 5. LEICESTER RED BRICK
 - TYPE 6. LEICESTER RED BRICK SLIP
 - TYPE 7. HIT AND MISS BRICKWORK
 - TYPE 8. SOLDIER COURSING BRICK SLIP
 - TYPE 9. LEICESTER RED BRICKWORK. PRECAST PANEL
- RAINSCREEN**
- TYPE 10. ALUMINIUM 3MM RAL 7035 LIGHT GREY TEXTURED MATT/FS
TIGER PRODUCT CODE: 02972111
 - TYPE 11. ALUMINIUM RAL 9010 PURE WHITE TEXTURED MATT/FS
TIGER PRODUCT CODE: 02910674
 - TYPE 12. ALUMINIUM 3 MM WITH ADDITIONAL STIFFENER RAL 9010
PURE WHITE
 - TYPE 13. ALUMINIUM 3 MM RAL 7031 BLUE GREY
 - TYPE 14. ALUMINIUM PORTAL FRAMES RAL 7006 BEIGE GREY PPC
 - TYPE 15. ALUMINIUM 3 MM PIGMENTO ROUGE /RED
 - TYPE 16. ALUMINIUM 3 MM WITH ADDITIONAL STIFFENER RAL 7006
BEIGE GREY
 - TYPE 17. ALUMINIUM 3 MM RAL 7006 BEIGE GREY
 - TYPE 18. ALUMINIUM 3 MM RAL 7022 UMBRA GREY
 - TYPE 19. ALUMINIUM PORTAL FRAMES RAL 7022 UMBRA GREY PPC
 - TYPE 24. ALUMINIUM 3 MM WITH ADDITIONAL STIFFENER FLAT MATT
RAL 9010 PURE WHITE
- BALCONY FASCIA**
- TYPE 20. ALUMINIUM RAL 7022 UMBRA GREY
 - TYPE 21. ALUMINIUM RAL 7006 BEIGE GREY
- GLASS**
- TYPE 22. BACK PAINTED GLASS RAL 7006 BEIGE GREY
 - TYPE 23. CLEAR GLASS BALUSTRADE - ROOF LEVEL
 - TYPE 25. BACK PAINTED GLASS RAL 7022 UMBRA GREY
- FOR WINDOWS DOORS AND LOUVRES SPECIFICATIONS PLEASE REFER TO
FACADE SPECIFICATIONS AND MDS SERIES 17 DRAWINGS.

- C03 MP 17.05.22 SB LOUVER ADDED / FACADE MATERIAL, CURTAIN
WALLS, JOINTS AND LEGEND UPDATED
- C02 MP 31.01.22 SB MATERIAL, CURTAIN WALLS, BALUSTRADES
HEIGHT, TOP OF COPING, BALCONIES AND
LEGEND UPDATED
- C01 MP 07.09.21 SB MATERIALS AND LEGEND UPDATED /
WINDOWS AND PORTAL FRAMES GENERALLY
UPDATED
- P03 MP 14.06.21 SB SECTIONS NUMBERS AND LEGENDS
GENERALLY UPDATED / BALCONIES UPDATED /
METAL CLADDING PANELS AND VERTICAL
JOINTS ADDED
- P02 MP 07.05.21 SB JULIETTE AND BALCONY DOORS SWING
DIRECTIONS GENERALLY UPDATED / VIEWS
REARRANGEMENT
- P01 MP 28.04.21 SB FIRST ISSUE

REV BY DATE CHK DESCRIPTION

STATUS

FOR CONSTRUCTION

CONTRACTOR

MIDGARD LTD

PROJECT

Station Hill, Reading

CLIENT

SH Reading (phase 1) Limited

DRAWING TITLE

Block E

Elevations

Friars Walk Elevations 2/2

DATE CREATED

28.04.21

DATE AMENDED

17.05.22

SCALE

1: 100 @A1

DRAWN BY

MP

AMENDED BY

MP

CHECKED

SB


DRAWING NO & REVISION

SHR-MDS-BE-ZZ-DR-A-11-0002 - C03



- 10MM VERTICAL MOVEMENT JOINT
- 20MM VERTICAL MOVEMENT JOINT
- 30MM VERTICAL MOVEMENT JOINT
- 20MM HORIZONTAL MOVEMENT JOINT
- 30MM HORIZONTAL MOVEMENT JOINT
- FOR JOINTS IN METAL CLADDING REFER TO SERIES 12 DRAWINGS
- LEGEND**
- SWIFT BIRD BOX - 16S SCHWEGLER 430 mm(W)x240 mm (H)x220 mm (D)
 - BIRD BOX - 1HE SCHWEGLER BRICK BOX 280 mm(L)x150 mm (H)x150 mm (D)
 - BAT BOX - 1FR SCHWEGLER BAT TUBE 200 mm(L)x475 mm (H)x125 mm (D)

DO NOT SCALE DIMENSIONS OF THIS DRAWING
CHECK ALL DIMENSIONS ON SITE BEFORE FABRICATION
FINAL COORDINATION AND CHECKS ARE RESPONSIBILITY OF THE SITE TEAM
TO SUIT CONDITIONS AND TOLERANCES BEFORE ANY INSTALLATION
REPORT ALL ERRORS OR OMISSIONS TO MIDGARD LIMITED
THIS DRAWING IS PROTECTED UNDER COPYRIGHT AND SHALL NOT BE
REPRODUCED IN PART OR WHOLE WITHOUT PRIOR EXPRESSED
PERMISSION OF MIDGARD LIMITED

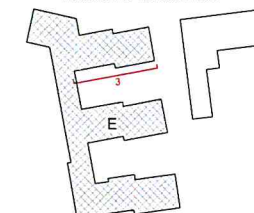

3 Elevation 3 - North Courtyard

- LEGEND**
- BRICKWORK**
- TYPE 1. KARMA WHITE BRICK
 - TYPE 2. KARMA WHITE BRICK SLIP
 - TYPE 3. PAGUS GREY BRICK
 - TYPE 4. PAGUS GREY BRICK SLIP
 - TYPE 5. LEICESTER RED BRICK
 - TYPE 6. LEICESTER RED BRICK SLIP
 - TYPE 7. HIT AND MISS BRICKWORK
 - TYPE 8. SOLDIER COURSING BRICK SLIP
 - TYPE 9. LEICESTER RED BRICKWORK, PRECAST PANEL
- RAINSCREEN**
- TYPE 10. ALUMINIUM 3MM RAL 7035 LIGHT GREY TEXTURED MATT/FS
TIGER PRODUCT CODE: 02972111
 - TYPE 11. ALUMINIUM RAL 9010 PURE WHITE TEXTURED MATT/FS
TIGER PRODUCT CODE: 02910674
 - TYPE 12. ALUMINIUM 3 MM WITH ADDITIONAL STIFFENER RAL 9010
PURE WHITE
 - TYPE 13. ALUMINIUM 3 MM RAL 7031 BLUE GREY
 - TYPE 14. ALUMINIUM PORTAL FRAMES RAL 7006 BEIGE GREY PPC
 - TYPE 15. ALUMINIUM 3 MM PIGMENTO ROUGE /RED
 - TYPE 16. ALUMINIUM 3 MM WITH ADDITIONAL STIFFENER RAL 7006
BEIGE GREY
 - TYPE 17. ALUMINIUM 3 MM RAL 7006 BEIGE GREY
 - TYPE 18. ALUMINIUM 3 MM RAL 7022 UMBRA GREY
 - TYPE 19. ALUMINIUM PORTAL FRAMES RAL 7022 UMBRA GREY PPC
 - TYPE 20. ALUMINIUM 3 MM WITH ADDITIONAL STIFFENER FLAT MATT
RAL 9010 PURE WHITE
- BALCONY FASCIA**
- TYPE 20. ALUMINIUM RAL 7022 UMBRA GREY
 - TYPE 21. ALUMINIUM RAL 7006 BEIGE GREY
- GLASS**
- TYPE 22. BACK PAINTED GLASS RAL 7006 BEIGE GREY
 - TYPE 23. CLEAR GLASS BALUSTRADE - ROOF LEVEL
 - TYPE 25. BACK PAINTED GLASS RAL 7022 UMBRA GREY
- FOR WINDOWS DOORS AND LOUVRES SPECIFICATIONS PLEASE REFER TO
FACADE SPECIFICATIONS AND MDS SERIES 17 DRAWINGS.

- C03 MP 17.05.22 SB CURTAIN WALL, TERRACE FFL, FACADE
MATERIAL, JOINTS AND LEGEND UPDATED
- C02 IM 07.02.22 SB CURTAIN WALL, BALUSTRADES HEIGHT, TOP
OF COPING, TERRACE LEVEL, BALCONIES AND
LEGEND UPDATED
- C01 MP 07.09.21 SB MATERIALS AND LEGEND UPDATED /
WINDOWS GENERALLY UPDATED
- P03 MP 14.06.21 SB SECTIONS NUMBERS AND LEGENDS
GENERALLY UPDATED / BALCONIES UPDATED /
METAL CLADDING PANELS AND VERTICAL
JOINTS ADDED
- P02 MP 07.05.21 SB JULIETTE AND BALCONY DOORS SWING
DIRECTIONS GENERALLY UPDATED / VIEWS
REARRANGEMENT
- P01 MP 28.04.21 SB FIRST ISSUE

REV BY DATE CHK DESCRIPTION
STATUS

FOR CONSTRUCTION

CONTRACTOR
MIDGARD LTD

PROJECT
Station Hill, Reading

CLIENT
SH Reading (phase 1) Limited

DRAWING TITLE
Block E
Elevations
North Courtyard Elevations 1/3


DATE CREATED 28.04.21 DATE AMENDED 17.05.22 SCALE 1:100 @A1
DRAWN BY MP AMENDED BY MP CHECKED SB

DRAWING NO & REVISION
SHR-MDS-BE-ZZ-DR-A-11-0003 - C03

- 10MM VERTICAL MOVEMENT JOINT
- 20MM VERTICAL MOVEMENT JOINT
- 30MM VERTICAL MOVEMENT JOINT
- 20MM HORIZONTAL MOVEMENT JOINT
- 30MM HORIZONTAL MOVEMENT JOINT
- FOR JOINTS IN METAL CLADDING REFER TO SERIES 12 DRAWINGS
- LEGEND**
- SWIFT BIRD BOX - 16S SCHWEGLER 430 mm(W)x240 mm (H)x220 mm (D)
 - BIRD BOX - 1HE SCHWEGLER BRICK BOX 280 mm(L)x150 mm (H)x150 mm (D)
 - BAT BOX - 1 FR SCHWEGLER BAT TUBE 200 mm(L)x475 mm (H)x125 mm (D)



DO NOT SCALE DIMENSIONS OF THIS DRAWING
CHECK ALL DIMENSIONS ON SITE BEFORE FABRICATION
FINAL COORDINATION AND CHECKS ARE RESPONSIBILITY OF THE SITE TEAM
TO SUIT CONDITIONS AND TOLERANCES BEFORE ANY INSTALLATION
REPORT ALL ERRORS OR OMISSIONS TO MIDGARD LIMITED
THIS DRAWING IS PROTECTED UNDER COPYRIGHT AND SHALL NOT BE
REPRODUCED IN PART OR WHOLE WITHOUT PRIOR EXPRESSED
PERMISSION OF MIDGARD LIMITED

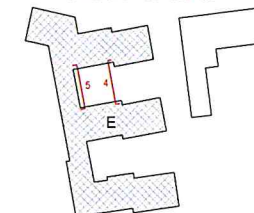

- LEGEND**
- BRICKWORK**
- TYPE 1. KARMA WHITE BRICK
 - TYPE 2. KARMA WHITE BRICK SLIP
 - TYPE 3. PAGUS GREY BRICK
 - TYPE 4. PAGUS GREY BRICK SLIP
 - TYPE 5. LEICESTER RED BRICK
 - TYPE 6. LEICESTER RED BRICK SLIP
 - TYPE 7. HIT AND MISS BRICKWORK
 - TYPE 8. SOLDIER COURSING BRICK SLIP
 - TYPE 9. LEICESTER RED BRICKWORK. PRECAST PANEL
- RAINS CREEN**
- TYPE 10. ALUMINIUM 3MM RAL 7035 LIGHT GREY TEXTURED MATT/FS
TIGER PRODUCT CODE: 02972111
 - TYPE 11. ALUMINIUM RAL 9010 PURE WHITE TEXTURED MATT/FS
TIGER PRODUCT CODE: 02910674
 - TYPE 12. ALUMINIUM 3 MM WITH ADDITIONAL STIFFENER RAL 9010
PURE WHITE
 - TYPE 13. ALUMINIUM 3 MM RAL 7031 BLUE GREY
 - TYPE 14. ALUMINIUM PORTAL FRAMES RAL 7006 BEIGE GREY PPC
 - TYPE 15. ALUMINIUM 3 MM PIGMENTO ROUGE /RED
 - TYPE 16. ALUMINIUM 3 MM WITH ADDITIONAL STIFFENER RAL 7006
BEIGE GREY
 - TYPE 17. ALUMINIUM 3 MM RAL 7006 BEIGE GREY
 - TYPE 18. ALUMINIUM 3 MM RAL 7022 UMBRA GREY
 - TYPE 19. ALUMINIUM PORTAL FRAMES RAL 7022 UMBRA GREY PPC
 - TYPE 24. ALUMINIUM 3 MM WITH ADDITIONAL STIFFENER FLAT MATT
RAL 9010 PURE WHITE
- BALCONY FASCIA**
- TYPE 20. ALUMINIUM RAL 7022 UMBRA GREY
 - TYPE 21. ALUMINIUM RAL 7006 BEIGE GREY
- GLASS**
- TYPE 22. BACK PAINTED GLASS RAL 7006 BEIGE GREY
 - TYPE 23. CLEAR GLASS BALUSTRADE - ROOF LEVEL
 - TYPE 25. BACK PAINTED GLASS RAL 7022 UMBRA GREY
- FOR WINDOWS DOORS AND LOUVRES SPECIFICATIONS PLEASE REFER TO
FACADE SPECIFICATIONS AND MDS SERIES 17 DRAWINGS.

- C03 MP 17.05.22 SB FACADE MATERIAL, JOINTS AND LEGEND
UPDATED
- C02 IM 07.02.22 SB BALUSTRADES HEIGHT, TOP OF COPING,
BALCONIES AND LEGEND UPDATED
- C01 MP 07.09.21 SB WINDOWS GENERALLY UPDATED / LEGEND
UPDATED
- P03 MP 14.06.21 SB SECTIONS NUMBERS AND LEGENDS
GENERALLY UPDATED / BALCONIES UPDATED /
METAL CLADDING PANELS AND VERTICAL
JOINTS ADDED
- P02 MP 07.05.21 SB JULIETTE AND BALCONY DOORS SWING
DIRECTIONS GENERALLY UPDATED / VIEWS
REARRANGEMENT
- P01 MP 28.04.21 SB FIRST ISSUE

REV BY DATE CHK DESCRIPTION
STATUS

FOR CONSTRUCTION

CONTRACTOR

MIDGARD LTD

PROJECT


Station Hill, Reading

CLIENT


SH Reading (phase 1) Limited

DRAWING TITLE
Block E
Elevations
North Courtyard Elevations 2/3

DATE CREATED 28.04.21	DATE AMENDED 17.05.22	SCALE 1 : 100 @A1
DRAWN BY MP	AMENDED BY MP	CHECKED SB
DRAWING NO & REVISION SHR-MDS-BE-ZZ-DR-A-11-0004 - C03		


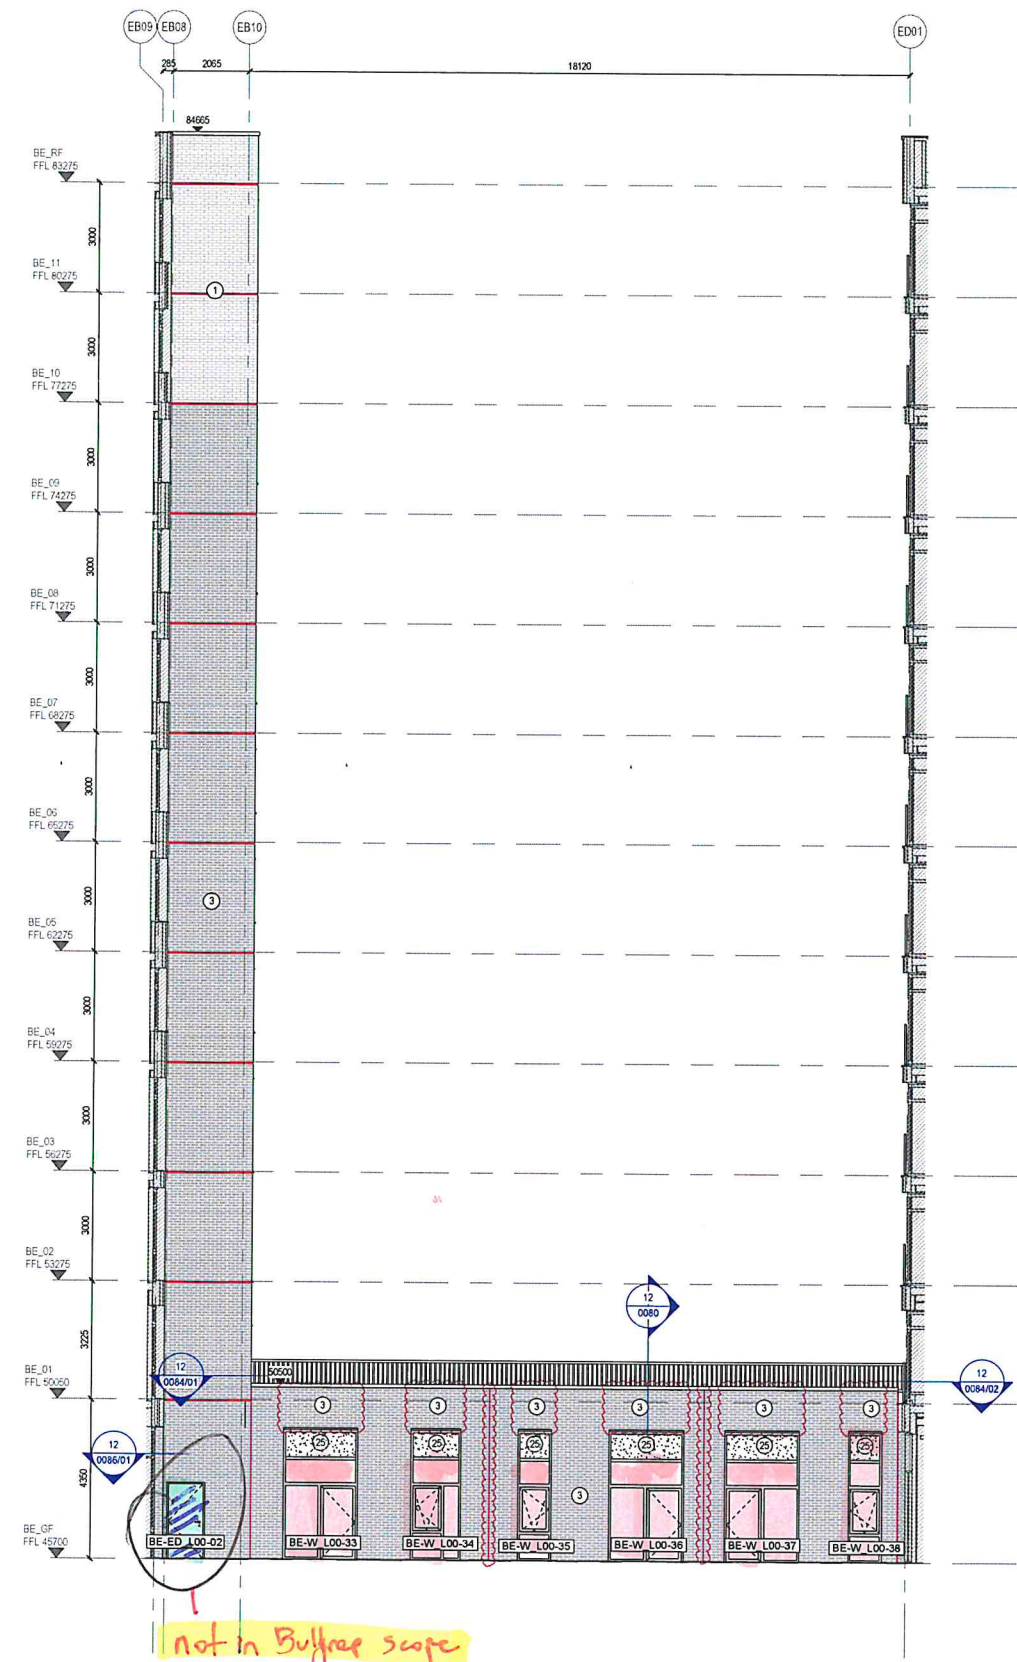


4 Elevation 4 -North Courtyard

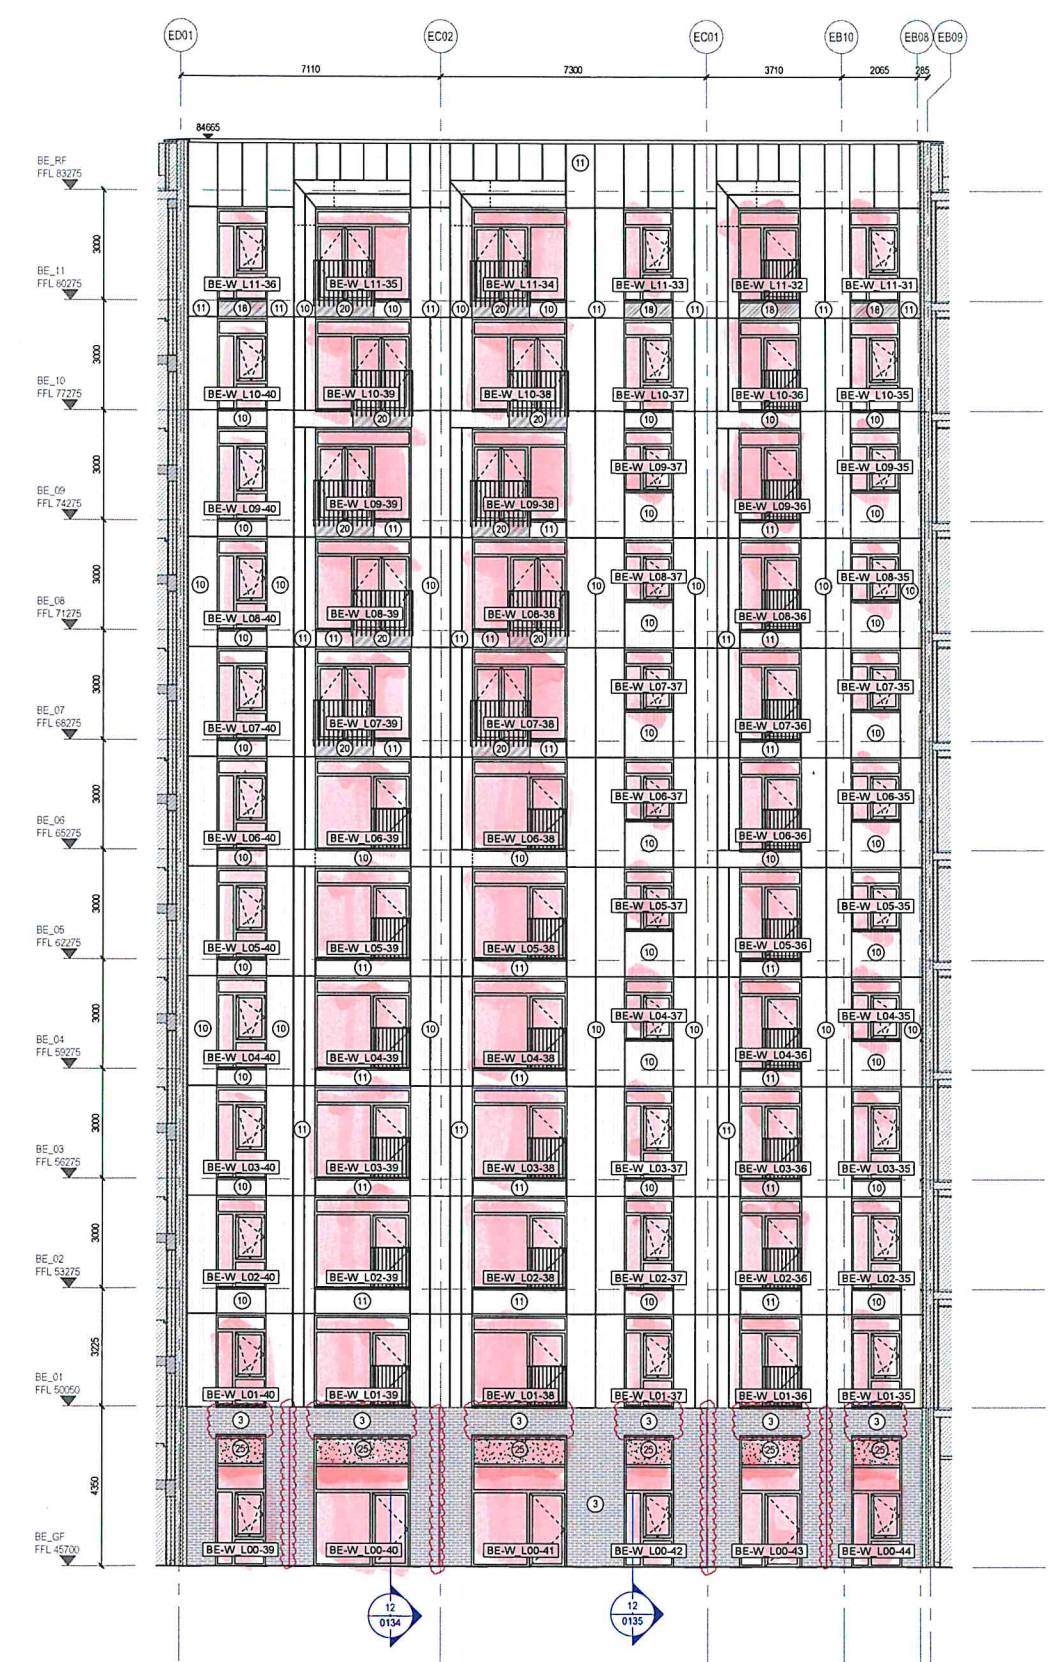


5 Elevation 5 -North Courtyard

- 10MM VERTICAL MOVEMENT JOINT
- 20MM VERTICAL MOVEMENT JOINT
- 30MM VERTICAL MOVEMENT JOINT
- 20MM HORIZONTAL MOVEMENT JOINT
- 30MM HORIZONTAL MOVEMENT JOINT
- FOR JOINTS IN METAL CLADDING REFER TO SERIES 12 DRAWINGS
- LEGEND**
- SWIFT BIRD BOX - 16S SCHWEGLER 430 mm(W)x240 mm (H)x220 mm (D)
 - BIRD BOX - THE SCHWEGLER BRICK BOX 280 mm(L)x150 mm (H)x150 mm (D)
 - BAT BOX - 1 FR SCHWEGLER BAT TUBE 200 mm(L)x475 mm (H)x125 mm (D)

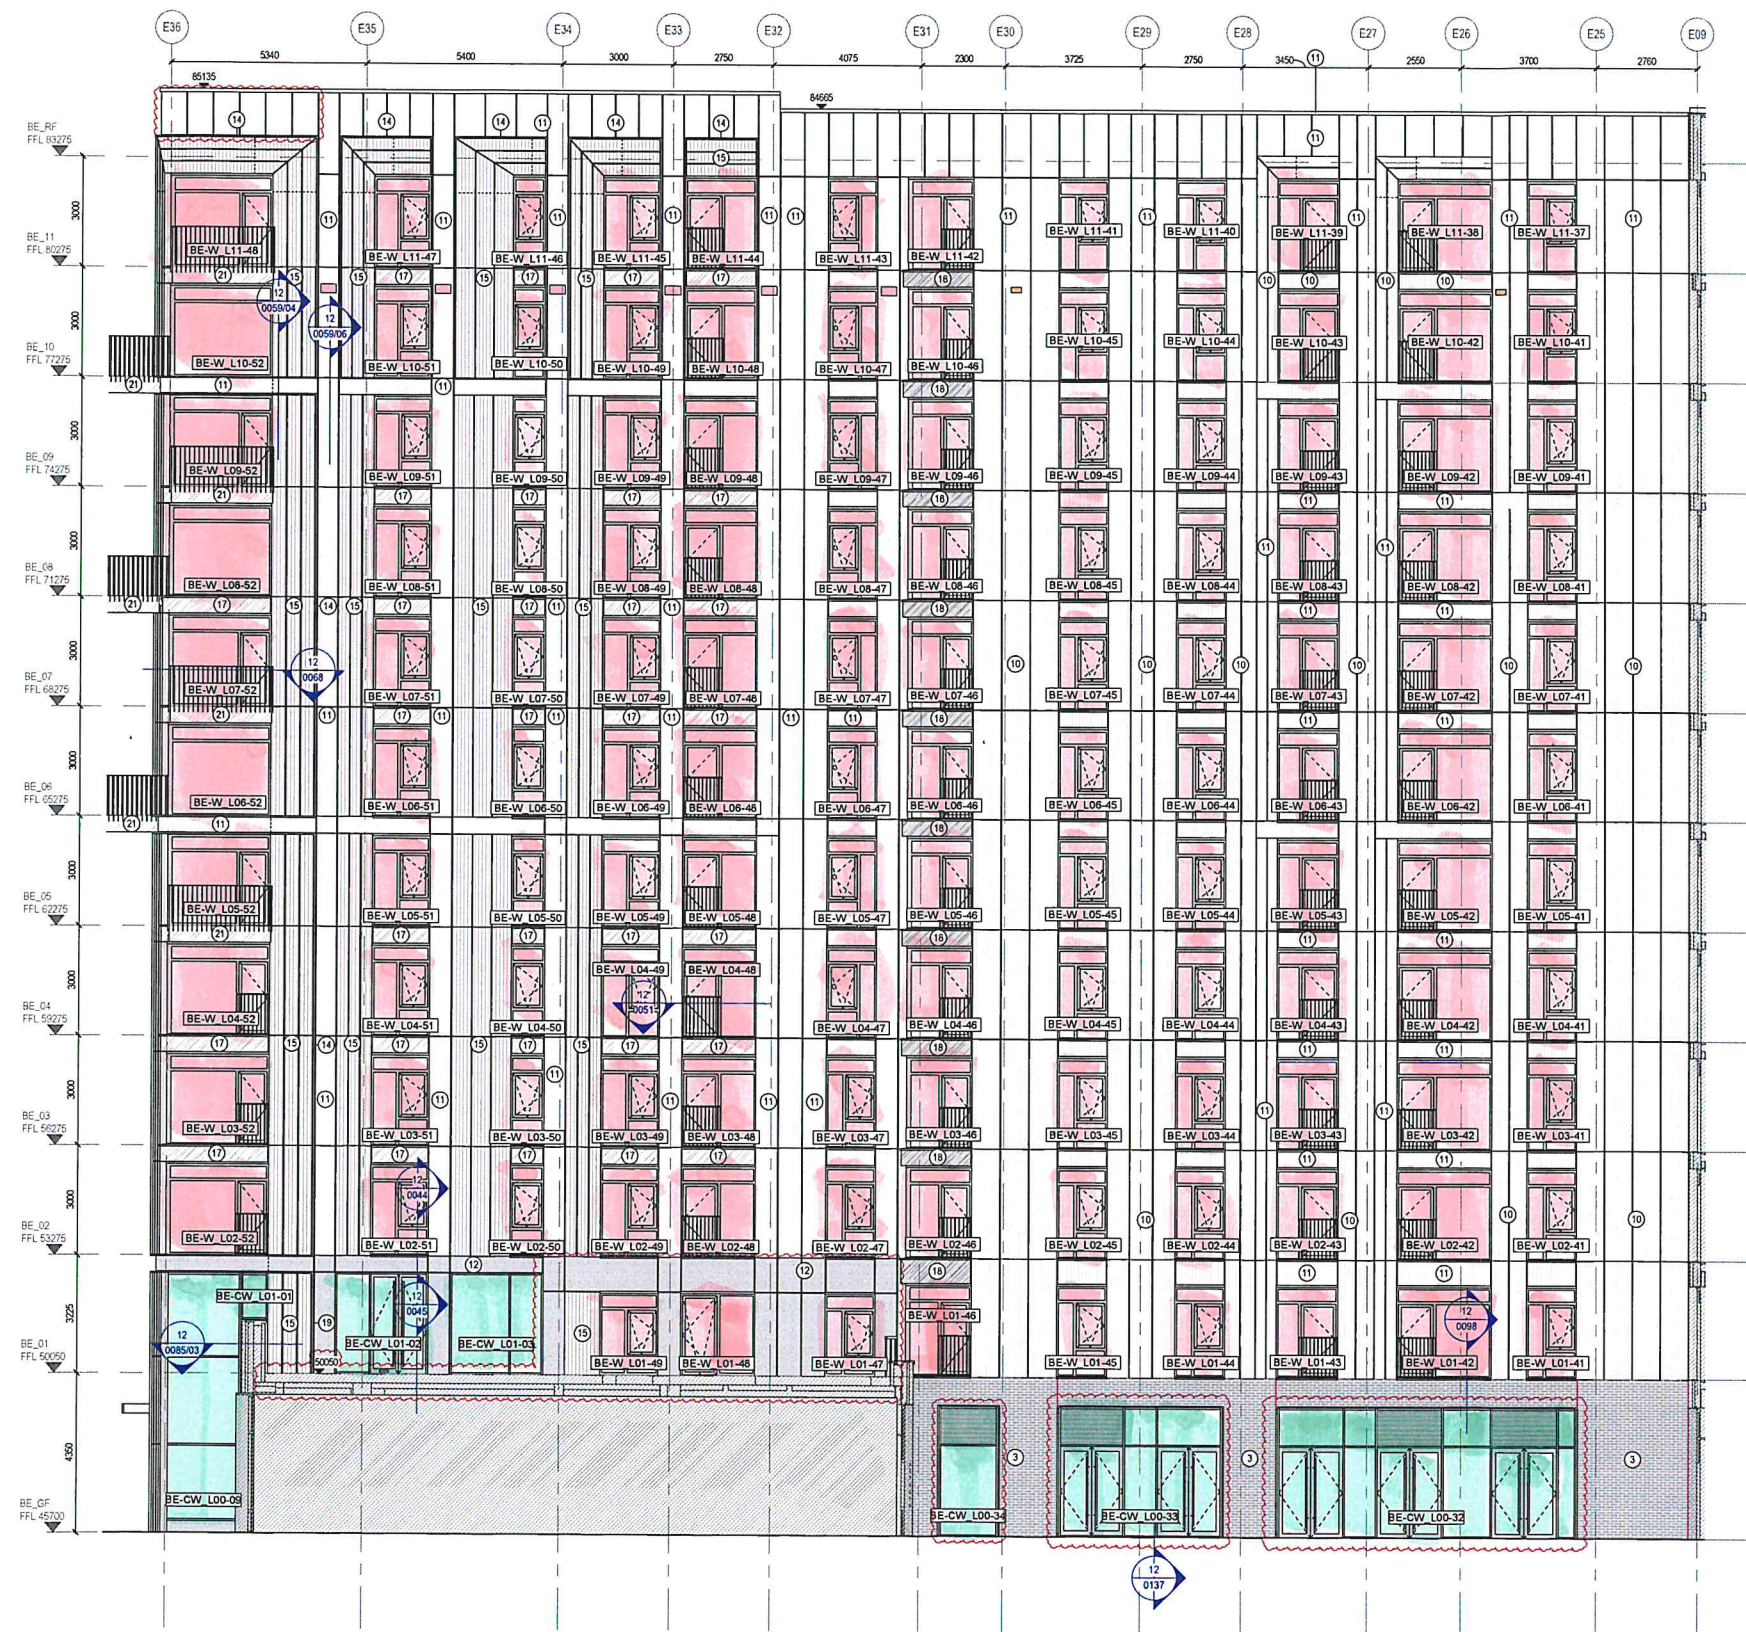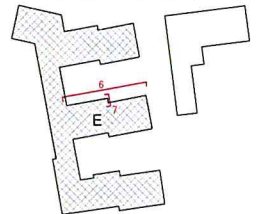

6 Elevation 6 - North Courtyard

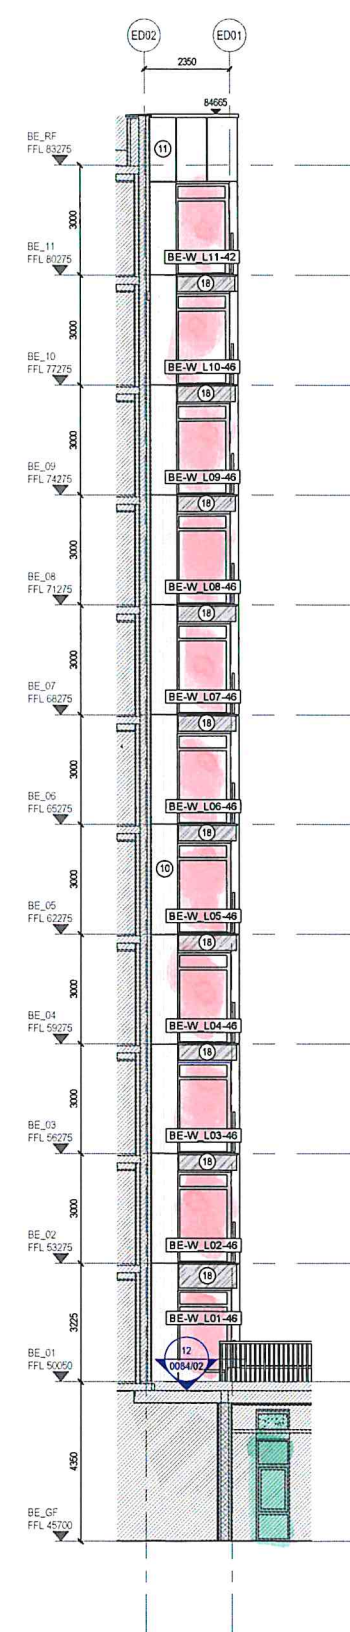

7 Elevation 7 - North Courtyard

- LEGEND**
- BRICKWORK**
- TYPE 1. KARMA WHITE BRICK
 - TYPE 2. KARMA WHITE BRICK SLIP
 - TYPE 3. PAGUS GREY BRICK
 - TYPE 4. PAGUS GREY BRICK SLIP
 - TYPE 5. LEICESTER RED BRICK
 - TYPE 6. LEICESTER RED BRICK SLIP
 - TYPE 7. HIT AND MISS BRICKWORK
 - TYPE 8. SOLDIER COURSING BRICK SLIP
 - TYPE 9. LEICESTER RED BRICKWORK. PRECAST PANEL
- RAINSCREEN**
- TYPE 10. ALUMINIUM 3MM RAL 7035 LIGHT GREY TEXTURED MATT/FS TIGER PRODUCT CODE: 02972111
 - TYPE 11. ALUMINIUM RAL 9010 PURE WHITE TEXTURED MATT/FS TIGER PRODUCT CODE: 02910674
 - TYPE 12. ALUMINIUM 3 MM WITH ADDITIONAL STIFFENER RAL 9010 PURE WHITE
 - TYPE 13. ALUMINIUM 3 MM RAL 7031 BLUE GREY
 - TYPE 14. ALUMINIUM PORTAL FRAMES RAL 7006 BEIGE GREY PPC
 - TYPE 15. ALUMINIUM 3 MM PIGMENT O ROUGE /RED
 - TYPE 16. ALUMINIUM 3 MM WITH ADDITIONAL STIFFENER RAL 7006 BEIGE GREY
 - TYPE 17. ALUMINIUM 3 MM RAL 7006 BEIGE GREY
 - TYPE 18. ALUMINIUM 3 MM RAL 7022 UMBRA GREY
 - TYPE 19. ALUMINIUM PORTAL FRAMES RAL 7022 UMBRA GREY PPC
 - TYPE 24. ALUMINIUM 3 MM WITH ADDITIONAL STIFFENER FLAT MATT RAL 9010 PURE WHITE
- BALCONY FASCIA**
- TYPE 20. ALUMINIUM RAL 7022 UMBRA GREY
 - TYPE 21. ALUMINIUM RAL 7006 BEIGE GREY
- GLASS**
- TYPE 22. BACK PAINTED GLASS RAL 7006 BEIGE GREY
 - TYPE 23. CLEAR GLASS BALUSTRADE - ROOF LEVEL
 - TYPE 25. BACK PAINTED GLASS RAL 7022 UMBRA GREY
- FOR WINDOWS DOORS AND LOUVRES SPECIFICATIONS PLEASE REFER TO FACADE SPECIFICATIONS AND MDS SERIES 17 DRAWINGS.

- C03 MP 17.05.22 SB LOUVRE ADDED / CURTAIN WALLS, TERRACE FFL, ALUMINIUM PANELS AND LEGEND UPDATED
- C02 MP 14.02.22 SB BALUSTRADES HEIGHT, TOP OF COPING, TERRACES LEVEL, BALCONIES AND LEGEND UPDATED
- C01 MP 07.09.21 SB BIRD & BAT BOXES ADDED / LEGEND UPDATED / WINDOWS AND PORTAL FRAMES GENERALLY UPDATED
- P03 MP 14.08.21 SB SECTIONS NUMBERS AND LEGENDS GENERALLY UPDATED / BALCONIES UPDATED / METAL CLADDING PANELS AND VERTICAL JOINTS ADDED
- P02 MP 07.05.21 SB JULIETTE AND BALCONY DOORS SWING DIRECTIONS GENERALLY UPDATED / VIEWS REARRANGEMENT
- P01 MP 28.04.21 SB FIRST ISSUE

REV BY DATE CHK DESCRIPTION
STATUS

FOR CONSTRUCTION

CONTRACTOR

MIDGARD LTD

PROJECT

Station Hill, Reading

CLIENT

SH Reading (phase 1) Limited

DRAWING TITLE

Block E
Elevations
North Courtyard Elevations 3/3

DATE CREATED 28.04.21	DATE AMENDED 17.05.22	SCALE 1 : 100 @A1
DRAWN BY MP	AMENDED BY MP	CHECKED SB

DRAWING NO & REVISION
SHR-MDS-BE-ZZ-DR-A-11-0005 - C03


- 10MM VERTICAL MOVEMENT JOINT
- 20MM VERTICAL MOVEMENT JOINT
- 30MM VERTICAL MOVEMENT JOINT
- 20MM HORIZONTAL MOVEMENT JOINT
- 30MM HORIZONTAL MOVEMENT JOINT

FOR JOINTS IN METAL CLADDING REFER TO SERIES 12 DRAWINGS

LEGEND

- SWIFT BIRD BOX - 16S SCHWEGLER 430 mm(W)x240 mm (H)x220 mm (D)
- BIRD BOX - 1HE SCHWEGLER BRICK BOX 280 mm(L)x150 mm (H)x150 mm (D)
- BAT BOX - 1 FR SCHWEGLER BAT TUBE 200 mm(L)x475 mm (H)x125 mm (D)

DO NOT SCALE DIMENSIONS OF THIS DRAWING
CHECK ALL DIMENSIONS ON SITE BEFORE FABRICATION
FINAL COORDINATION AND CHECKS ARE RESPONSIBILITY OF THE SITE TEAM
TO SUIT CONDITIONS AND TOLERANCES BEFORE ANY INSTALLATION
REPORT ALL ERRORS OR OMISSIONS TO MIDGARD LIMITED
THIS DRAWING IS PROTECTED UNDER COPYRIGHT AND SHALL NOT BE
REPRODUCED IN PART OR WHOLE WITHOUT PRIOR EXPRESSED
PERMISSION OF MIDGARD LIMITED

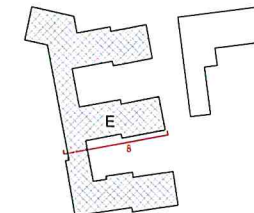

- LEGEND**
- BRICKWORK**
- TYPE 1. KARMA WHITE BRICK
 - TYPE 2. KARMA WHITE BRICK SLIP
 - TYPE 3. PAGUS GREY BRICK
 - TYPE 4. PAGUS GREY BRICK SLIP
 - TYPE 5. LEICESTER RED BRICK
 - TYPE 6. LEICESTER RED BRICK SLIP
 - TYPE 7. HIT AND MISS BRICKWORK
 - TYPE 8. SOLDIER COURSING BRICK SLIP
 - TYPE 9. LEICESTER RED BRICKWORK, PRECAST PANEL
- RAINSCREEN**
- TYPE 10. ALUMINIUM 3MM RAL 7035 LIGHT GREY TEXTURED MATT/FS
TIGER PRODUCT CODE: 02972111
 - TYPE 11. ALUMINIUM RAL 9010 PURE WHITE TEXTURED MATT/FS
TIGER PRODUCT CODE: 02910674
 - TYPE 12. ALUMINIUM 3 MM WITH ADDITIONAL STIFFENER RAL 9010
PURE WHITE
 - TYPE 13. ALUMINIUM 3 MM RAL 7031 BLUE GREY
 - TYPE 14. ALUMINIUM PORTAL FRAMES RAL 7006 BEIGE GREY PPC
 - TYPE 15. ALUMINIUM 3 MM PIGMENTO ROUGE /RED
 - TYPE 16. ALUMINIUM 3 MM WITH ADDITIONAL STIFFENER RAL 7006
BEIGE GREY
 - TYPE 17. ALUMINIUM 3 MM RAL 7006 BEIGE GREY
 - TYPE 18. ALUMINIUM 3 MM RAL 7022 UMBRA GREY
 - TYPE 19. ALUMINIUM PORTAL FRAMES RAL 7022 UMBRA GREY PPC
 - TYPE 24. ALUMINIUM 3 MM WITH ADDITIONAL STIFFENER FLAT MATT
RAL 9010 PURE WHITE
- BALCONY FASCIA**
- TYPE 20. ALUMINIUM RAL 7022 UMBRA GREY
 - TYPE 21. ALUMINIUM RAL 7006 BEIGE GREY
- GLASS**
- TYPE 22. BACK PAINTED GLASS RAL 7006 BEIGE GREY
 - TYPE 23. CLEAR GLASS BALUSTRADE - ROOF LEVEL
 - TYPE 25. BACK PAINTED GLASS RAL 7022 UMBRA GREY
- FOR WINDOWS DOORS AND LOUNRES SPECIFICATIONS PLEASE REFER TO
FACADE SPECIFICATIONS AND MDS SERIES 17 DRAWINGS.

- C03 MP 17.05.22 SB TERRACE FFL, FACADE MATERIAL, JOINTS AND
LEGEND UPDATED
- C02 MP 14.02.22 SB WINDOW SWING, TYPE, BALUSTRADES
HEIGHT, TOP OF COPING, TERRACE LEVEL,
BALCONIES, MATERIALS & LEGEND UPDATED
- C01 MP 07.09.21 SB BIRD&BAT BOXES ADDED / MATERIALS AND
LEGEND UPDATED / WINDOWS AND PORTAL
FRAMES GENERALLY UPDATED
- P03 MP 14.06.21 SB SECTIONS NUMBERS AND LEGENDS
GENERALLY UPDATED / WINDOWS TYPES
UPDATED / BALCONIES UPDATED / METAL
CLADDING PANELS AND VERTICAL JOINTS
ADDED
- P02 MP 07.05.21 SB JULIETTE AND BALCONY DOORS SWING
DIRECTIONS GENERALLY UPDATED / VIEWS
REARRANGEMENT
- P01 MP 28.04.21 SB FIRST ISSUE

REV BY DATE CHK DESCRIPTION
STATUS

FOR CONSTRUCTION

CONTRACTOR

MIDGARD LTD

PROJECT

Station Hill, Reading

CLIENT

SH Reading (phase 1) Limited

DRAWING TITLE

Block E

Elevations

South Courtyard Elevations 1/3

DATE CREATED

28.04.21

DRAWN BY

MP

DRAWING NO & REVISION

SHR-MDS-BE-ZZ-DR-A-11-0006 - C03

DATE AMENDED

17.05.22

AMENDED BY

MP

CHECKED

SB


SCALE

1 : 100 @A1

JRL

MDS

Midgard Design Services

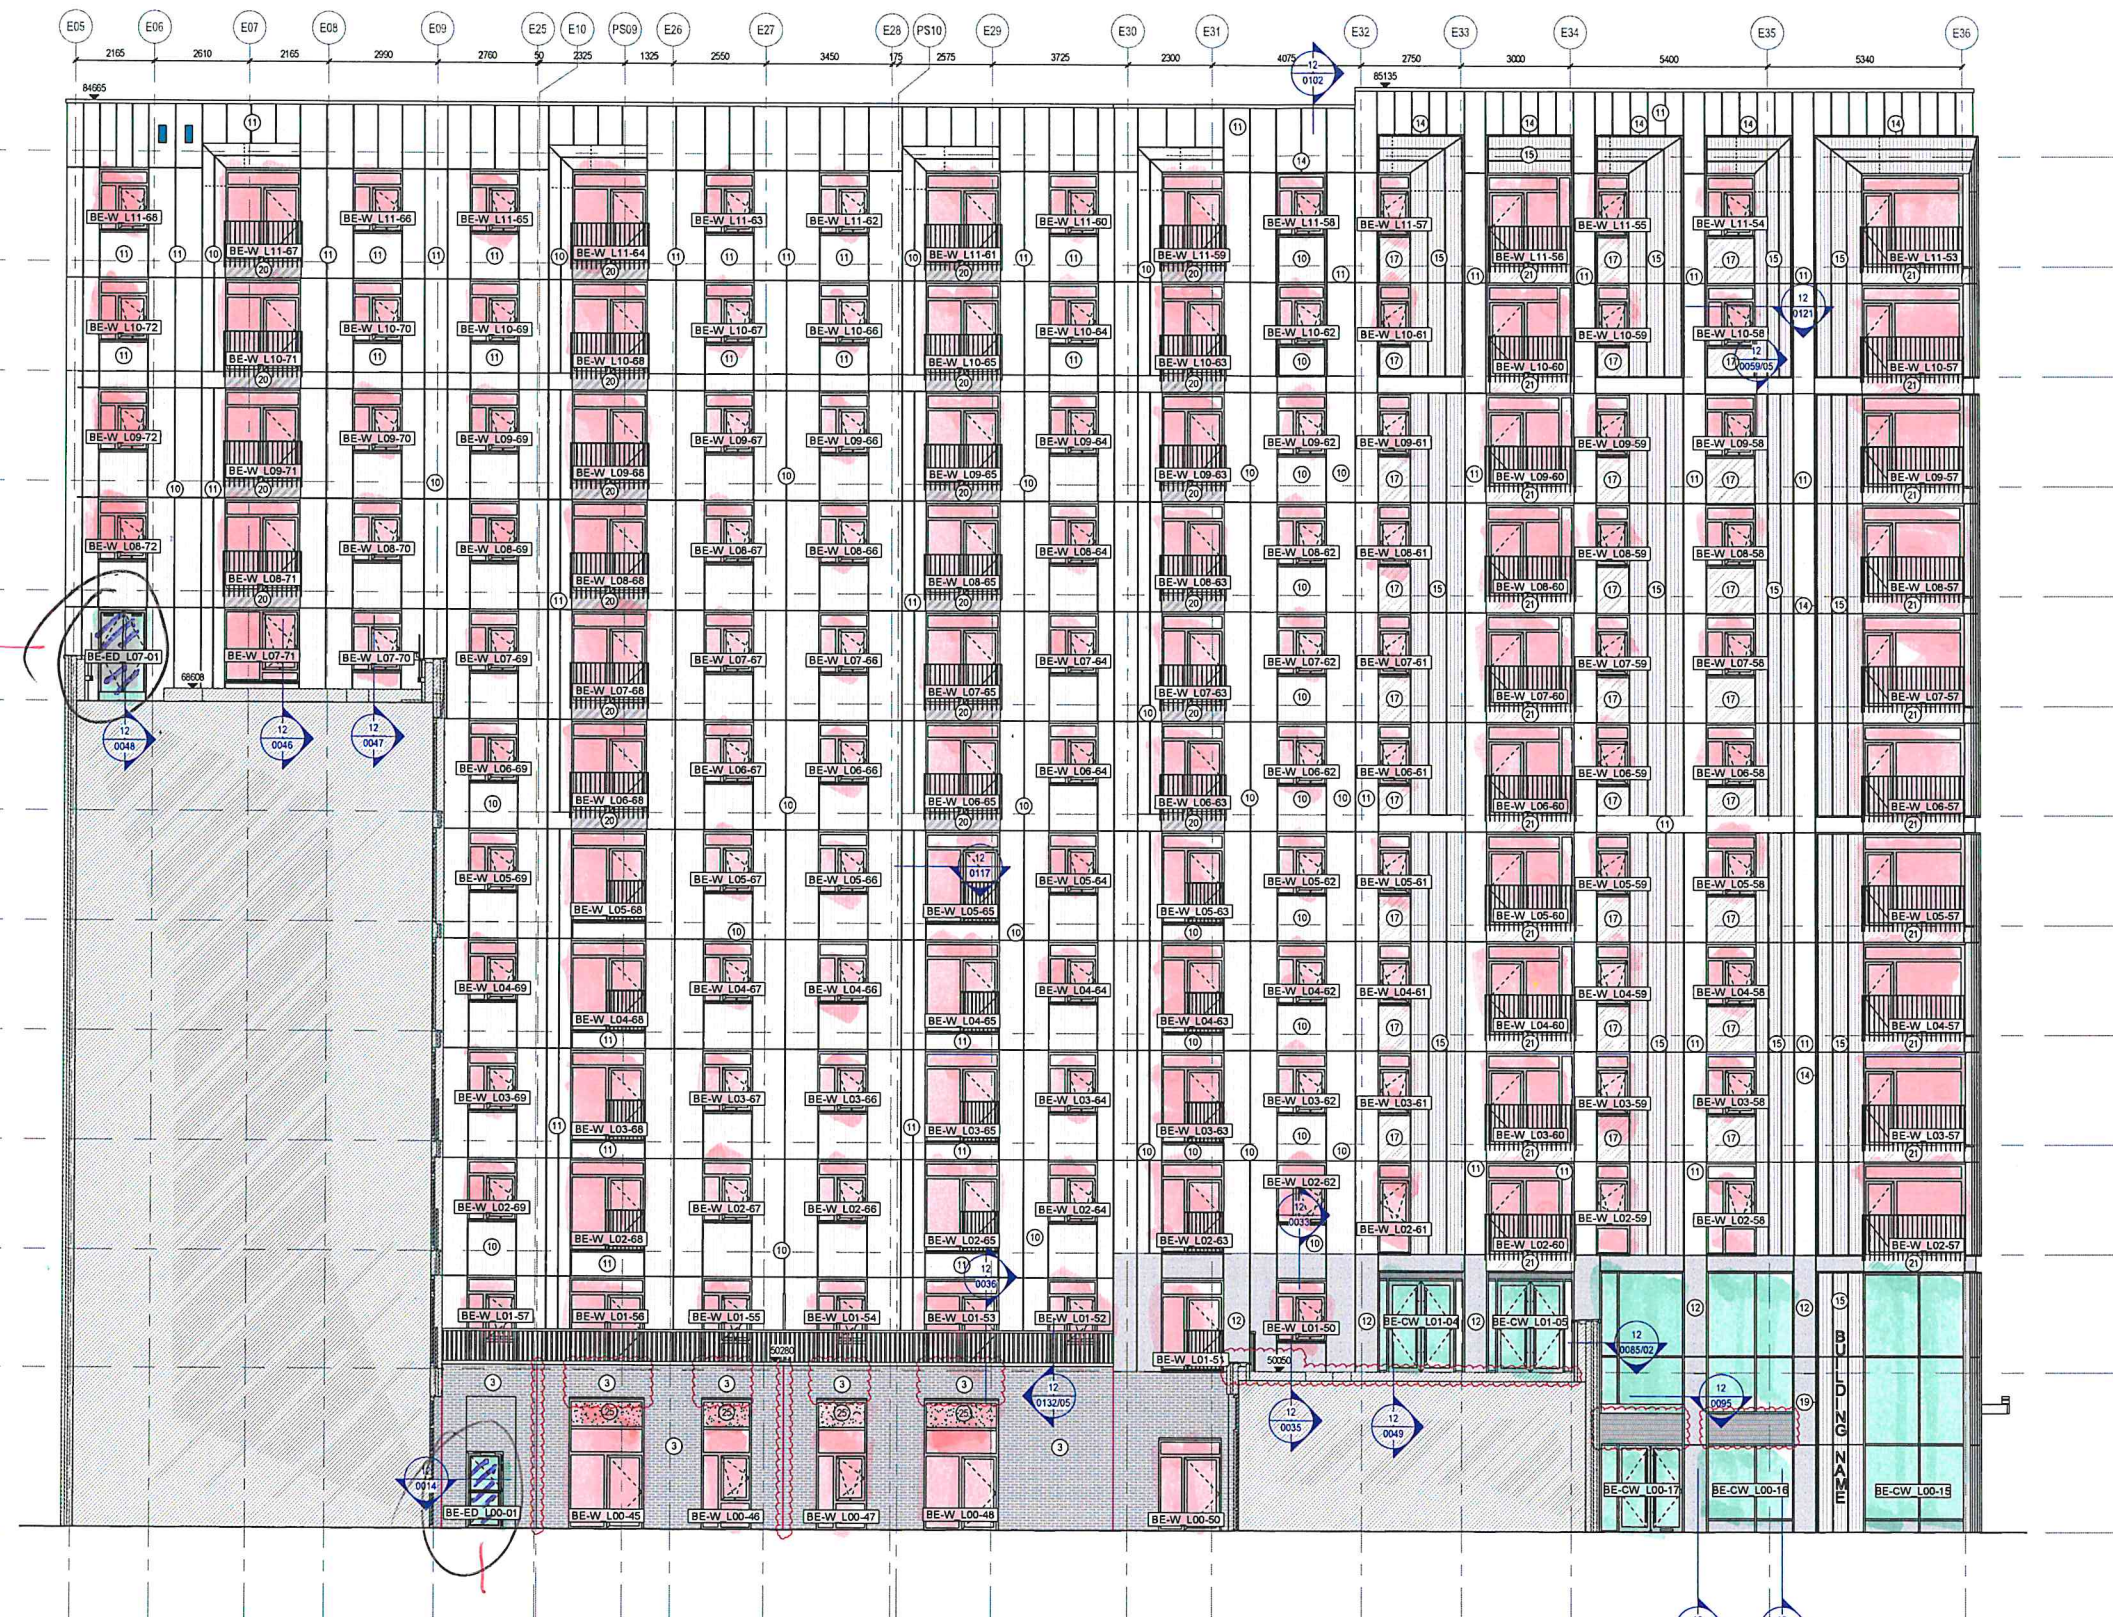

8 Elevation 8 - South Courtyard

not in Bulgaria
scope

- 10MM VERTICAL MOVEMENT JOINT
- 20MM VERTICAL MOVEMENT JOINT
- 30MM VERTICAL MOVEMENT JOINT
- 20MM HORIZONTAL MOVEMENT JOINT
- 30MM HORIZONTAL MOVEMENT JOINT
- FOR JOINTS IN METAL CLADDING REFER TO SERIES 12 DRAWINGS
- LEGEND**
- SWIFT BIRD BOX - 16S SCHWEGLER 430 mm(W)x240 mm (H)x220 mm (D)
 - BIRD BOX - THE SCHWEGLER BRICK BOX 280 mm(L)x150 mm (H)x150 mm (D)
 - BAT BOX - 1 FR SCHWEGLER BAT TUBE 200 mm(L)x475 mm (H)x125 mm (D)