



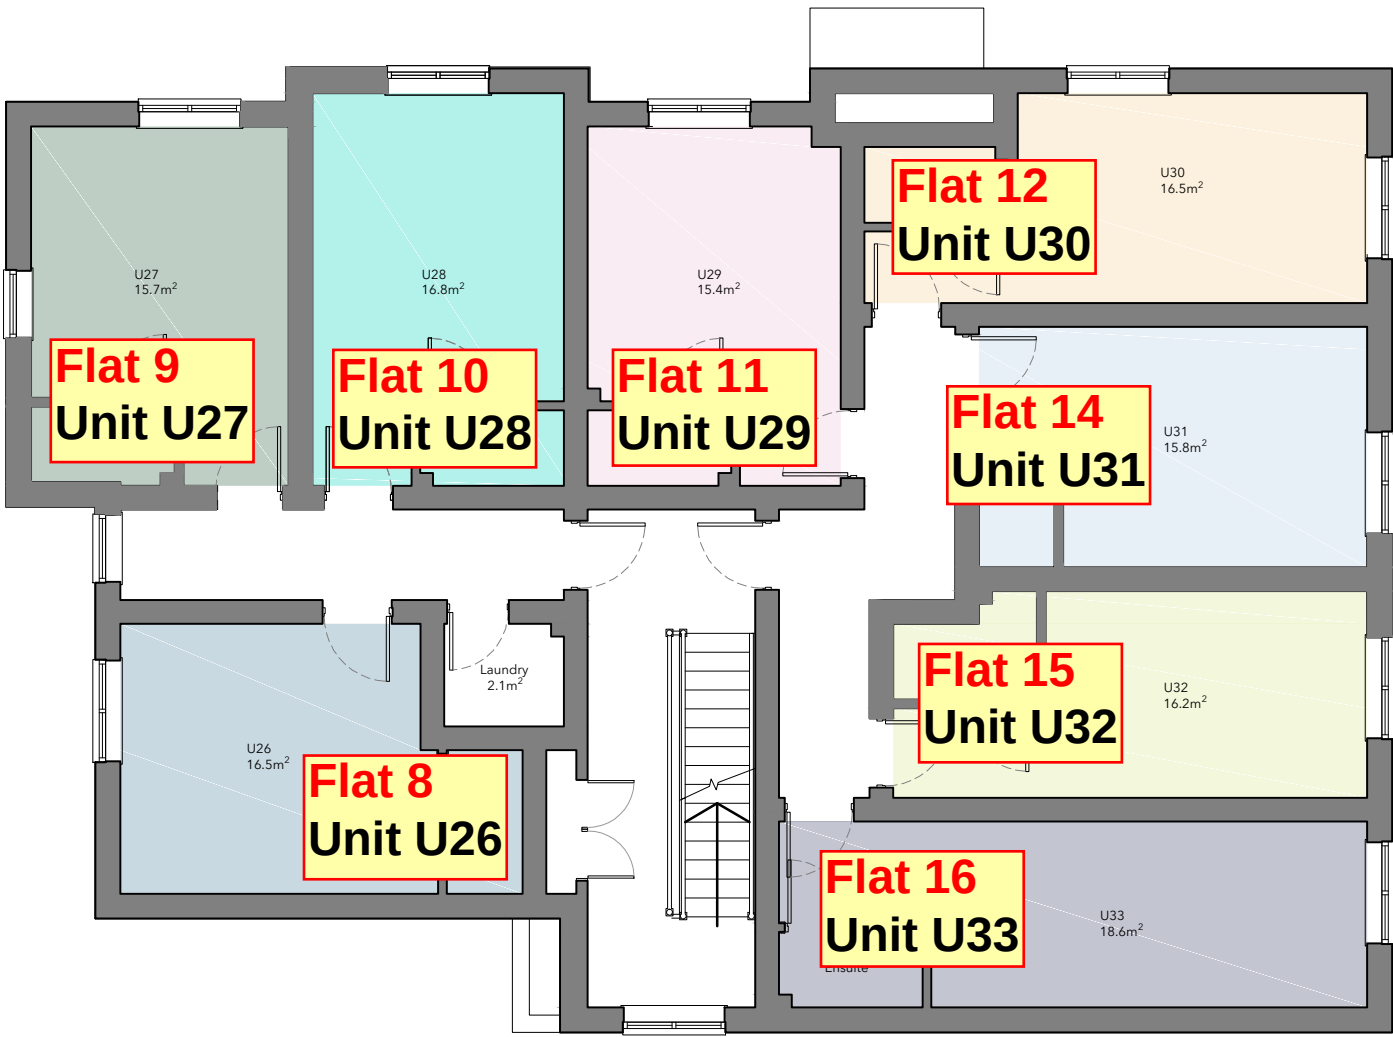

First Floor


Flat No	GIA/m2 (Room + Ensuite)
U26	16.5
U27	15.7
U28	16.8
U29	15.4
U30	16.5
U31	15.8
U32	16.2
U33	18.6

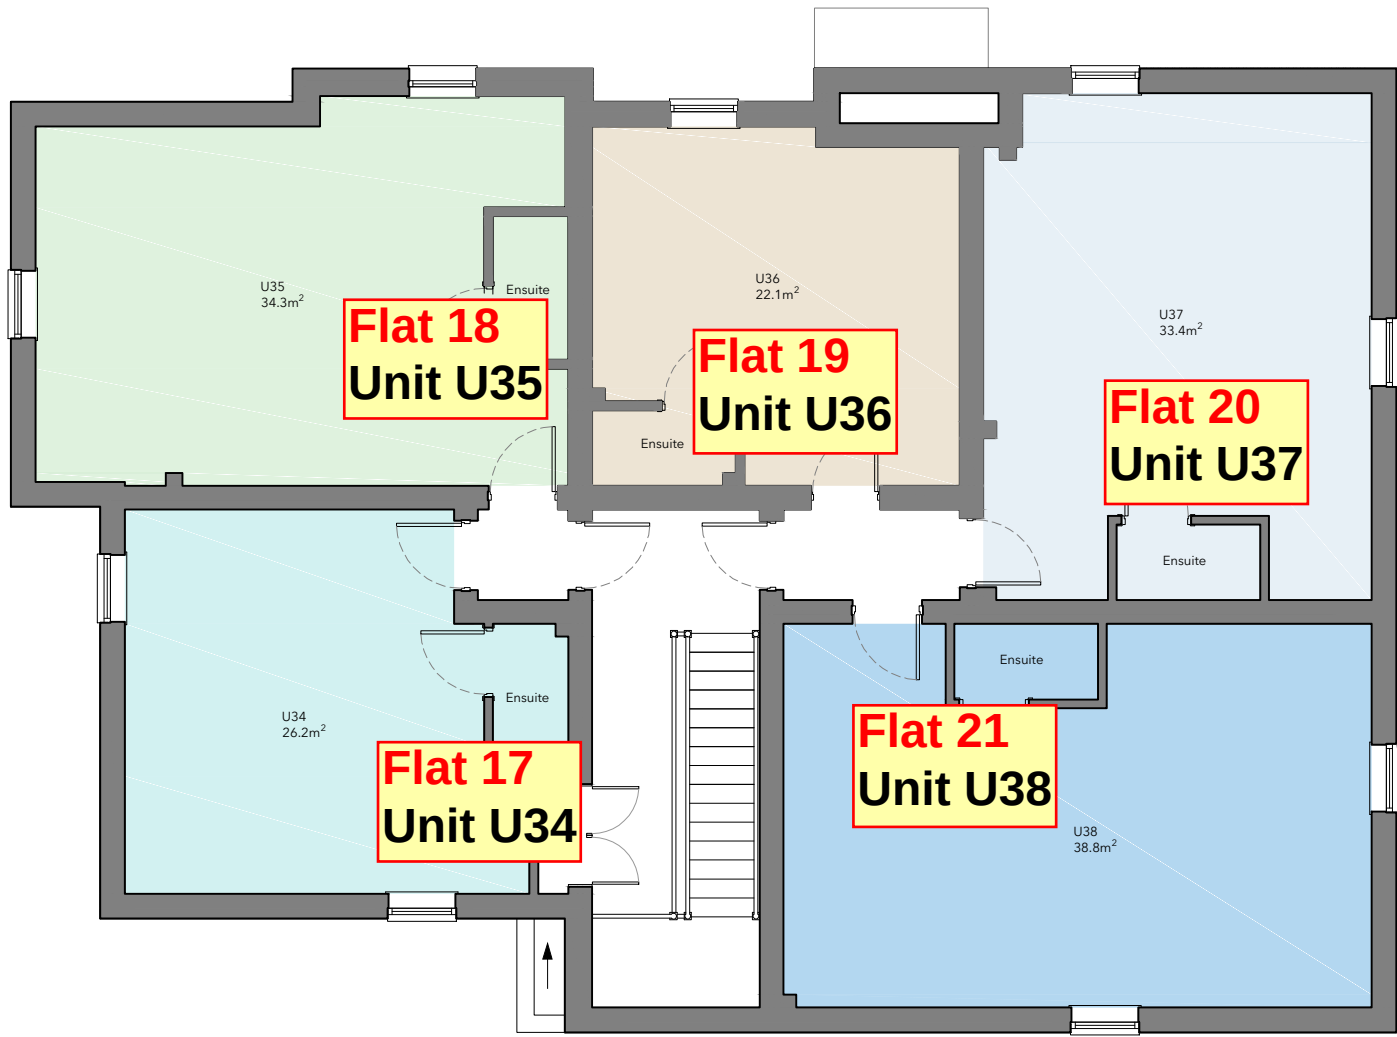

Second Floor

Flat No	GIA/m2 (Room + Ensuite)
U34	26.2
U35	34.3
U36	22.1
U37	33.4
U38	38.8

BLOCK B
Units U19 to U38
POSTAL NUMBERS
Flats 1 to 21 (exc.13),
3, Charndon Close,
Reading.
RG2 0WP

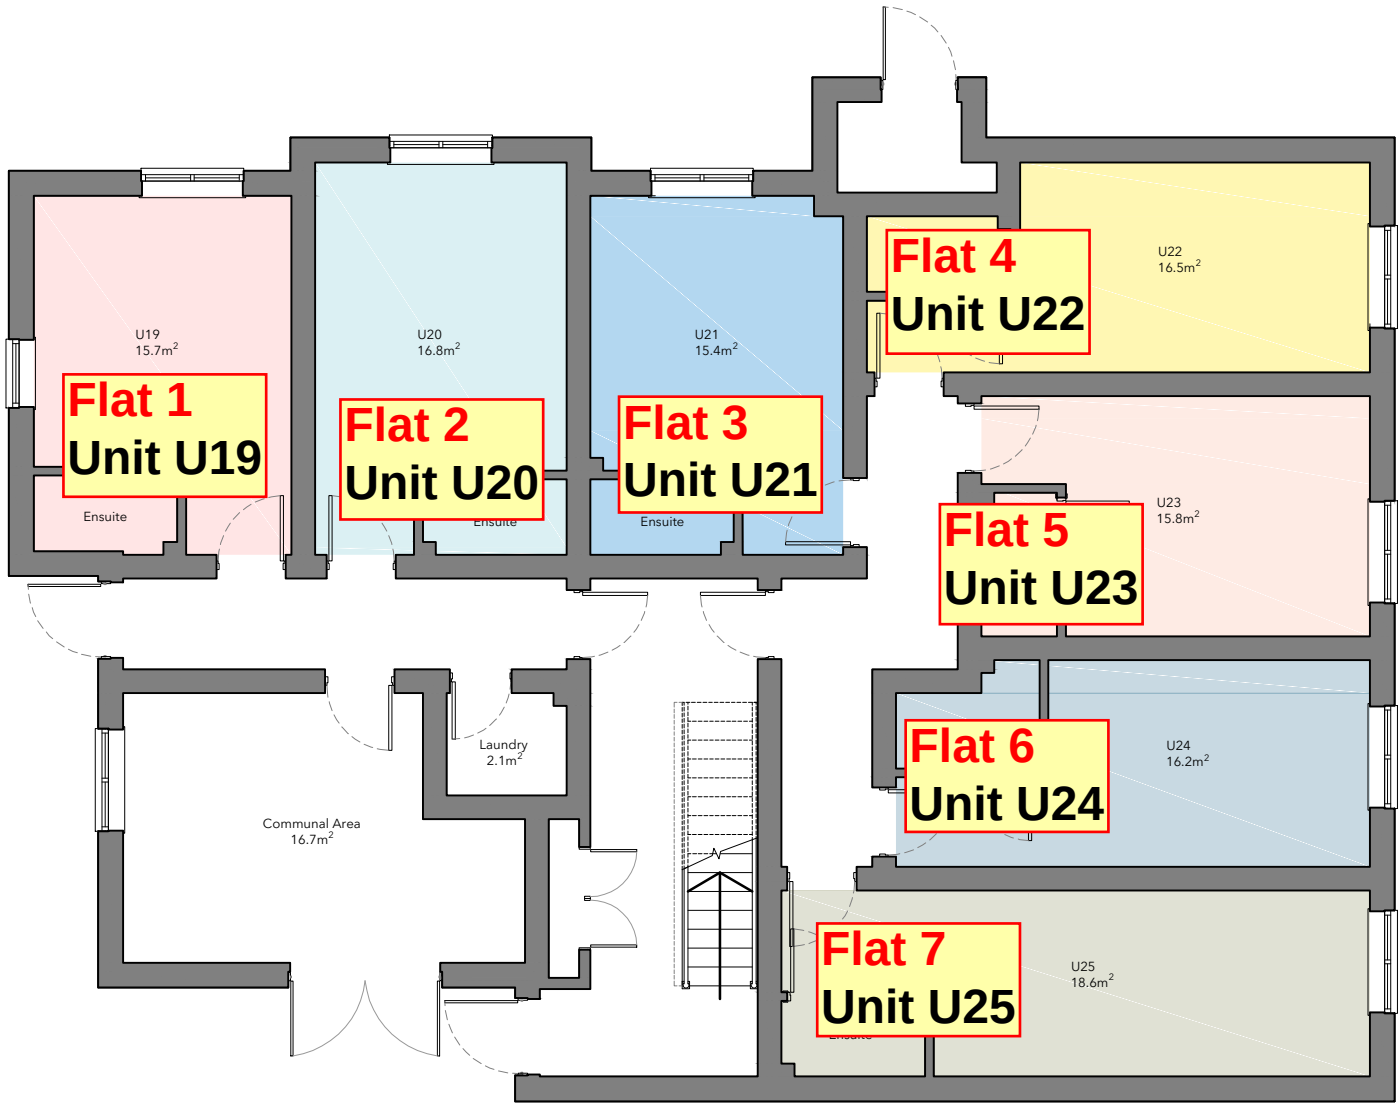

Ground Floor

Flat No	GIA/m2 (Room + Ensuite)
U19	15.7
U20	16.8
U21	15.4
U22	16.5
U23	15.8
U24	16.2
U25	18.6

A	General Amendments	04.07.23
No.	Description	Date



t. 02382 542011
e. info@rs-studio.co.uk
w. www.rs-studio.co.uk

Drawing Title:
Floor Plan
Block B
AS BUILT

Project Title:
Woodley Arms
Waldeck Street, Reading,
RG1 2RF

Drawing No.:
1559-M-201

Date:	June 2023
Scale:	1:100
Drawn:	LM
Checked:	RS

This drawing is the copyright of the company and must not be reproduced or used without permission. Annotated dimensions are to be taken in preference to scaled dimensions and site dimensions must be checked before work is commenced