


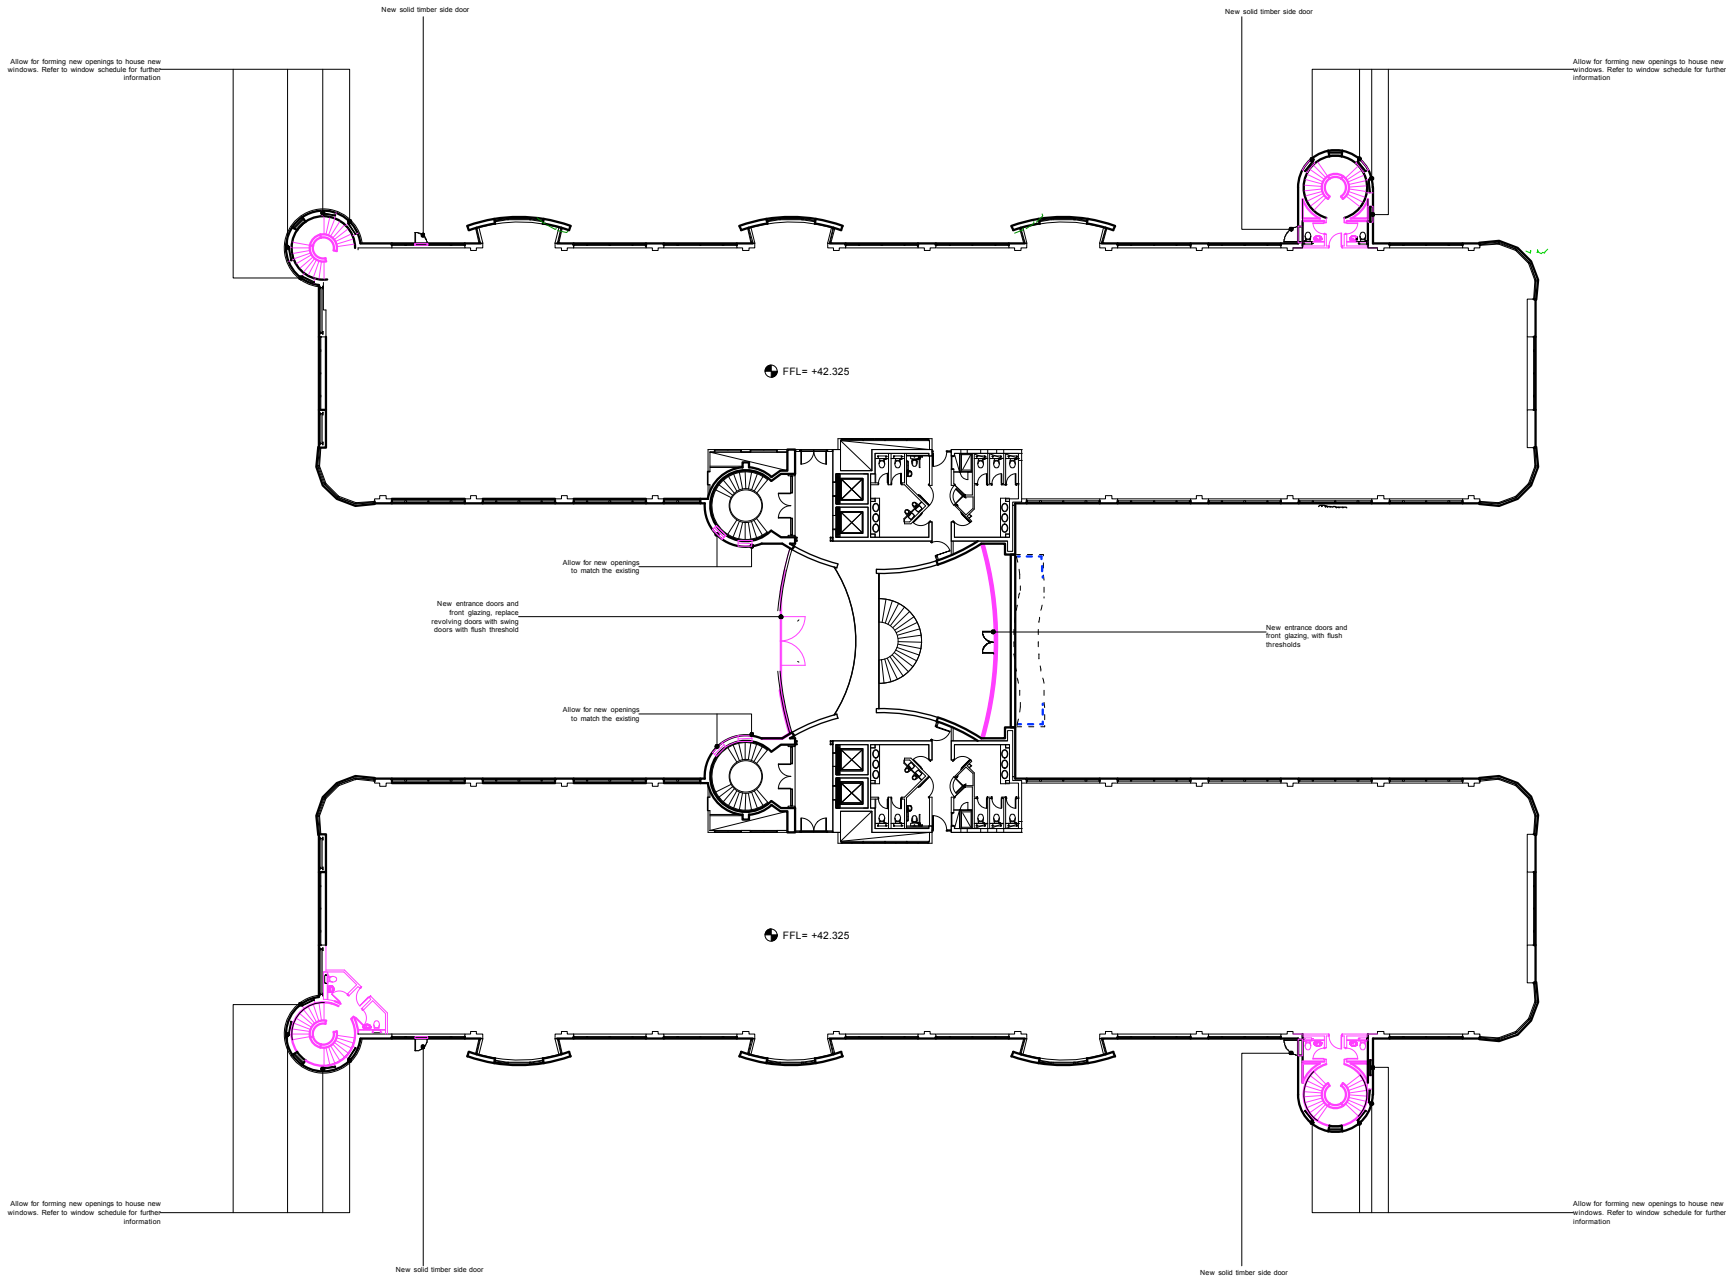

KEY

OSmap background used under licence. Ordnance Survey, (c) Crown Copyright 2019. All rights reserved

Redline property line as shown on HM Land Registry sheet SU71745W, title no BK7390



Exterior of building not altered, outline on plan as per survey

Landscape not altered, layout shown as per topographical survey

UNIT KEY

- 1 Bedroom flat
- 2 Bedroom flat
- 3 Bedroom flat

*Refer to Area Schedule for full breakdown

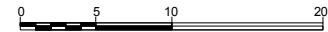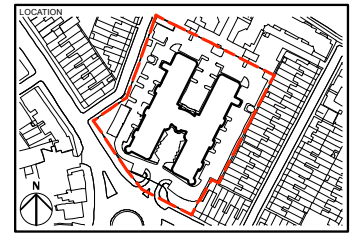

20.04	-	First Issue		VP
DATE:	REVISION:	REVISION COMMENTS:	AUTHOR:	CHECKED:

GREAT BRIGHAMS MEAD

DRAWING NAME:
PROPOSED GROUND FLOOR PLAN

PROJECT NO: P1048 DRAWING NO: PL300 REVISION: A SCALE @ SIZE: 1:500 @ A3

START DATE: 04.2022 FIRST AUTHOR: VP 1:250 @ A1

PEEK

Architecture
+ Design Ltd

Address: 12-13 Poland Street, London, W1F 8GB
Web www.peekarchitecture.co.uk | Email georgina@peekarchitecture.co.uk | Tel 0207 734 3094