

Copyright in design and this drawing is the property of Resi.

Reproduction in whole or in part is forbidden without written sanction of Resi.

All dimensions to be cross-checked on site prior to completing a Building Regulations package, structural engineering, the party wall process and construction.

Print to scale (as actual size)

NOTES

MATERIALS:

Brickwork / Walls - Red brick, painted brick and white painted render

Pitched Roof - Slate tiles

Flat Roof - Felt

Windows - White uPVC casement windows

Doors - White uPVC glazed single door and brown painted timber glazed door

RWP / Gutters / Fascia - Black uPVC guttering, downpipes and white fascias

Revision

Rev	Notes	Date
-	Planning Issue	04/07/2022

KEY

	Boundary lines
	Proposed walls
	Existing walls
	Existing removed
	Proposed rooflight
	Proposed beam
	Proposed drainage
	1.8m head height
	1.5m head height

JOB TITLE

Change of use from 2 no. one-bedroom flats to 1 no. single dwelling house and all associated works at 34 Prince of Wales, RG30 2UH

STATUS

Planning

DRAWING TITLE

As-Built Elevations

CLIENT

David Gilbert

SCALE

1:100 at A3

DRAWN

CH


DATE

July 2022

CHECKED


CZ

DRAWING NO. 127258 - PR - 201

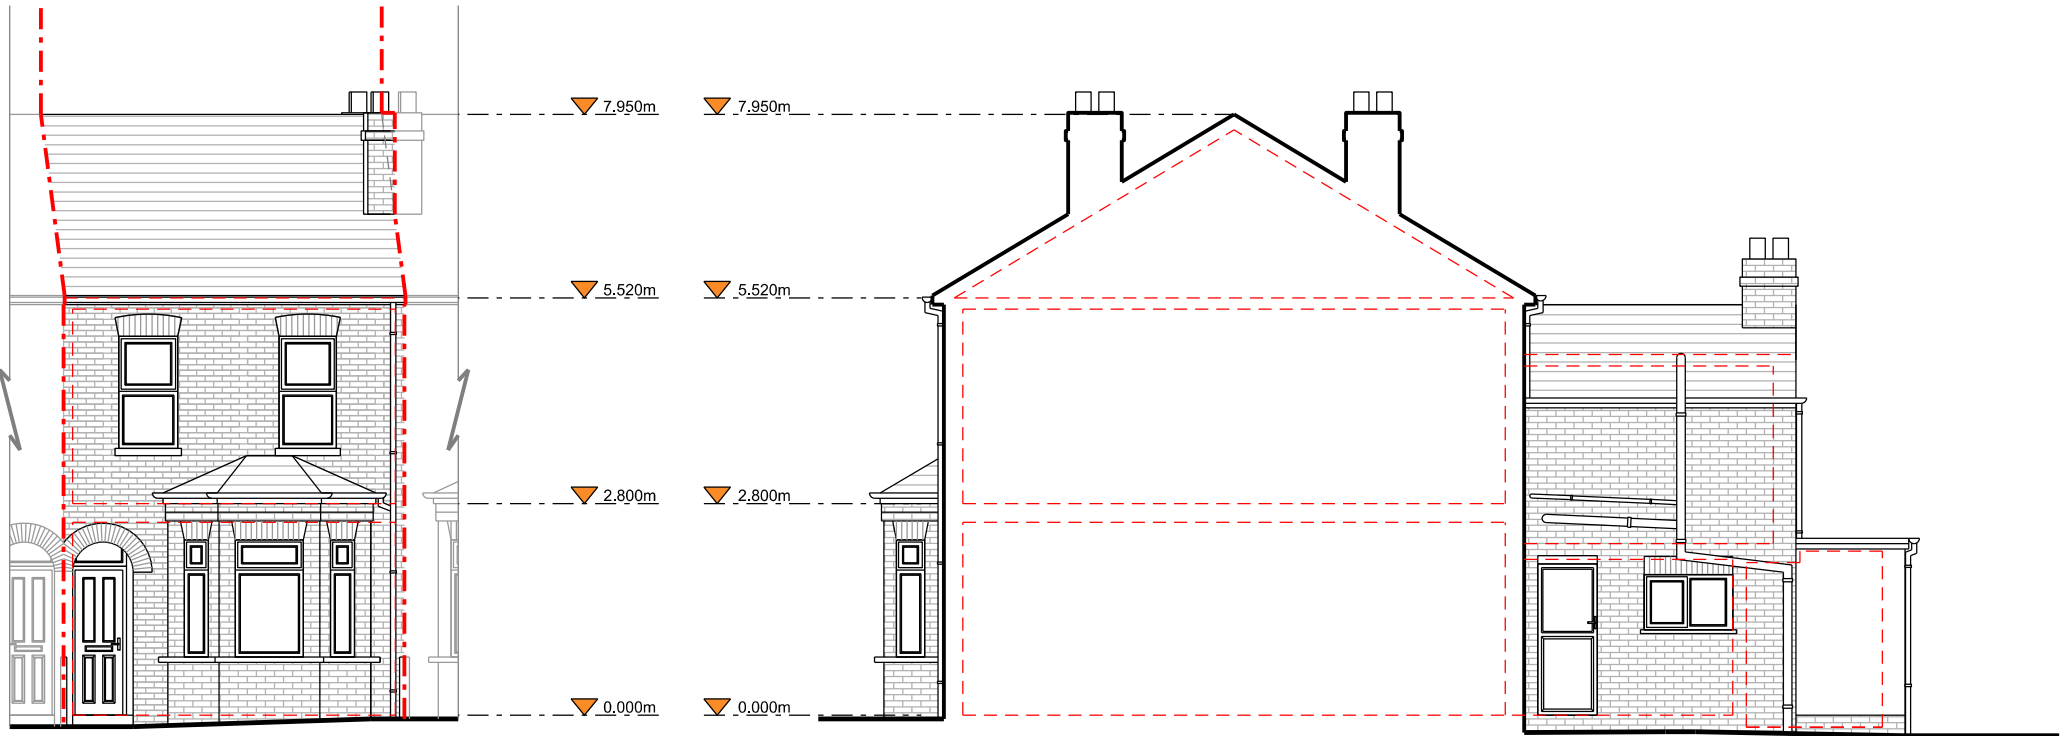

Front Elevation

Right Side Elevation

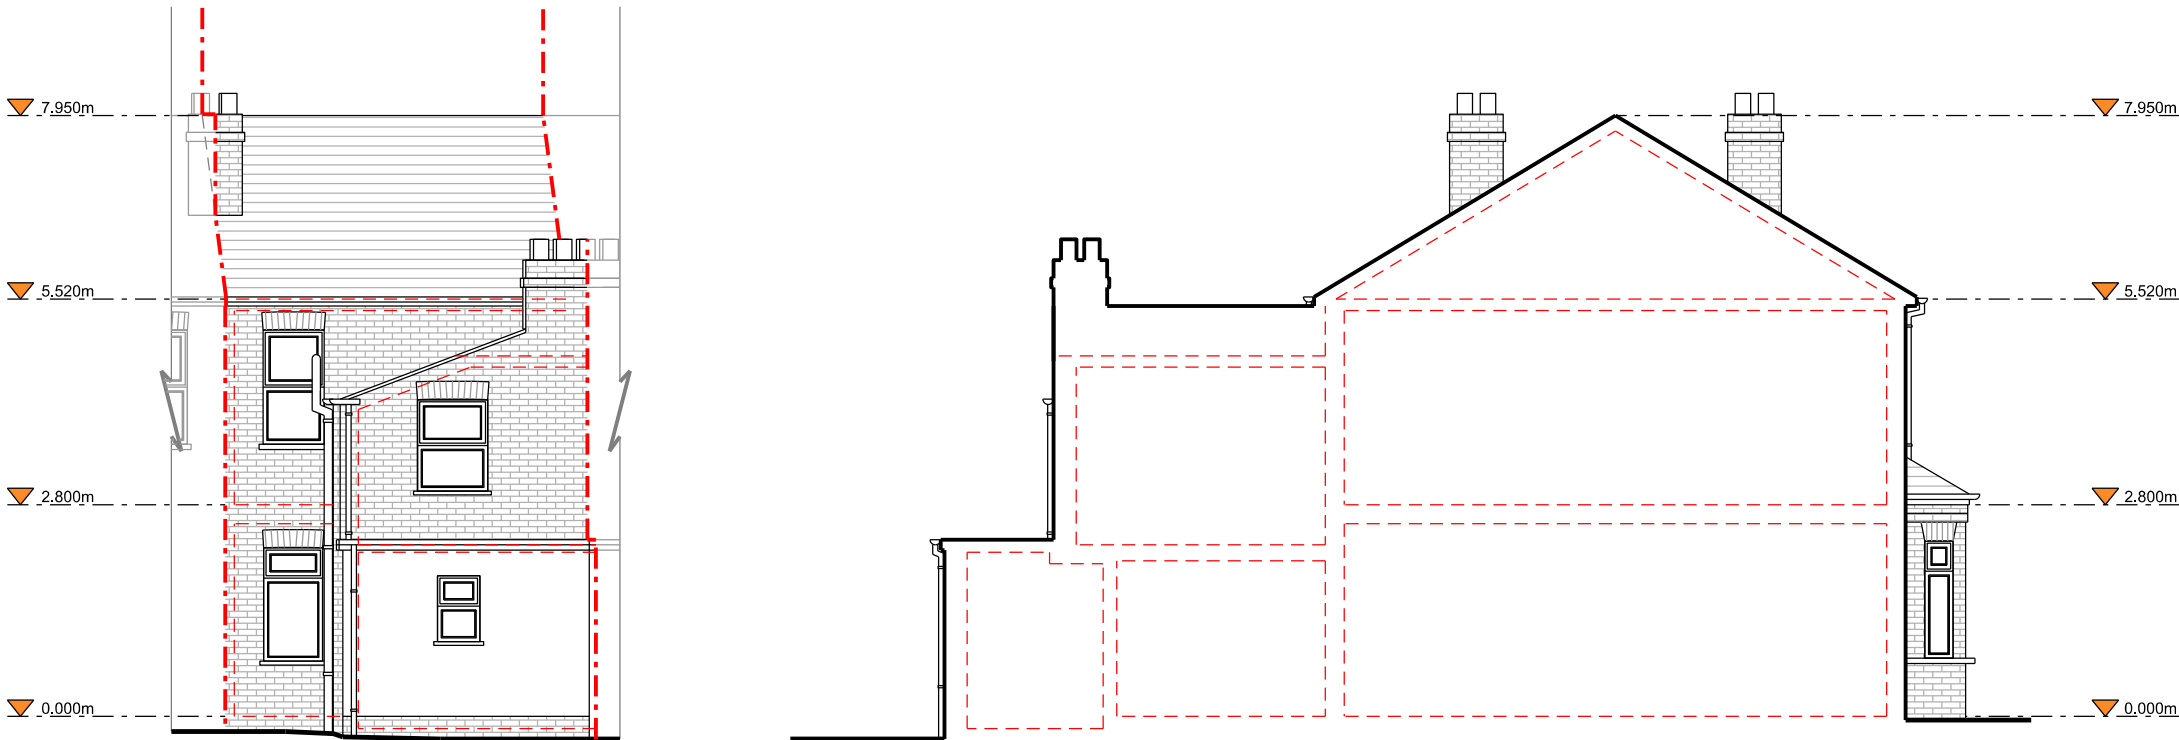

Rear Elevation

Left Side Elevation

