


GROUND FLOOR

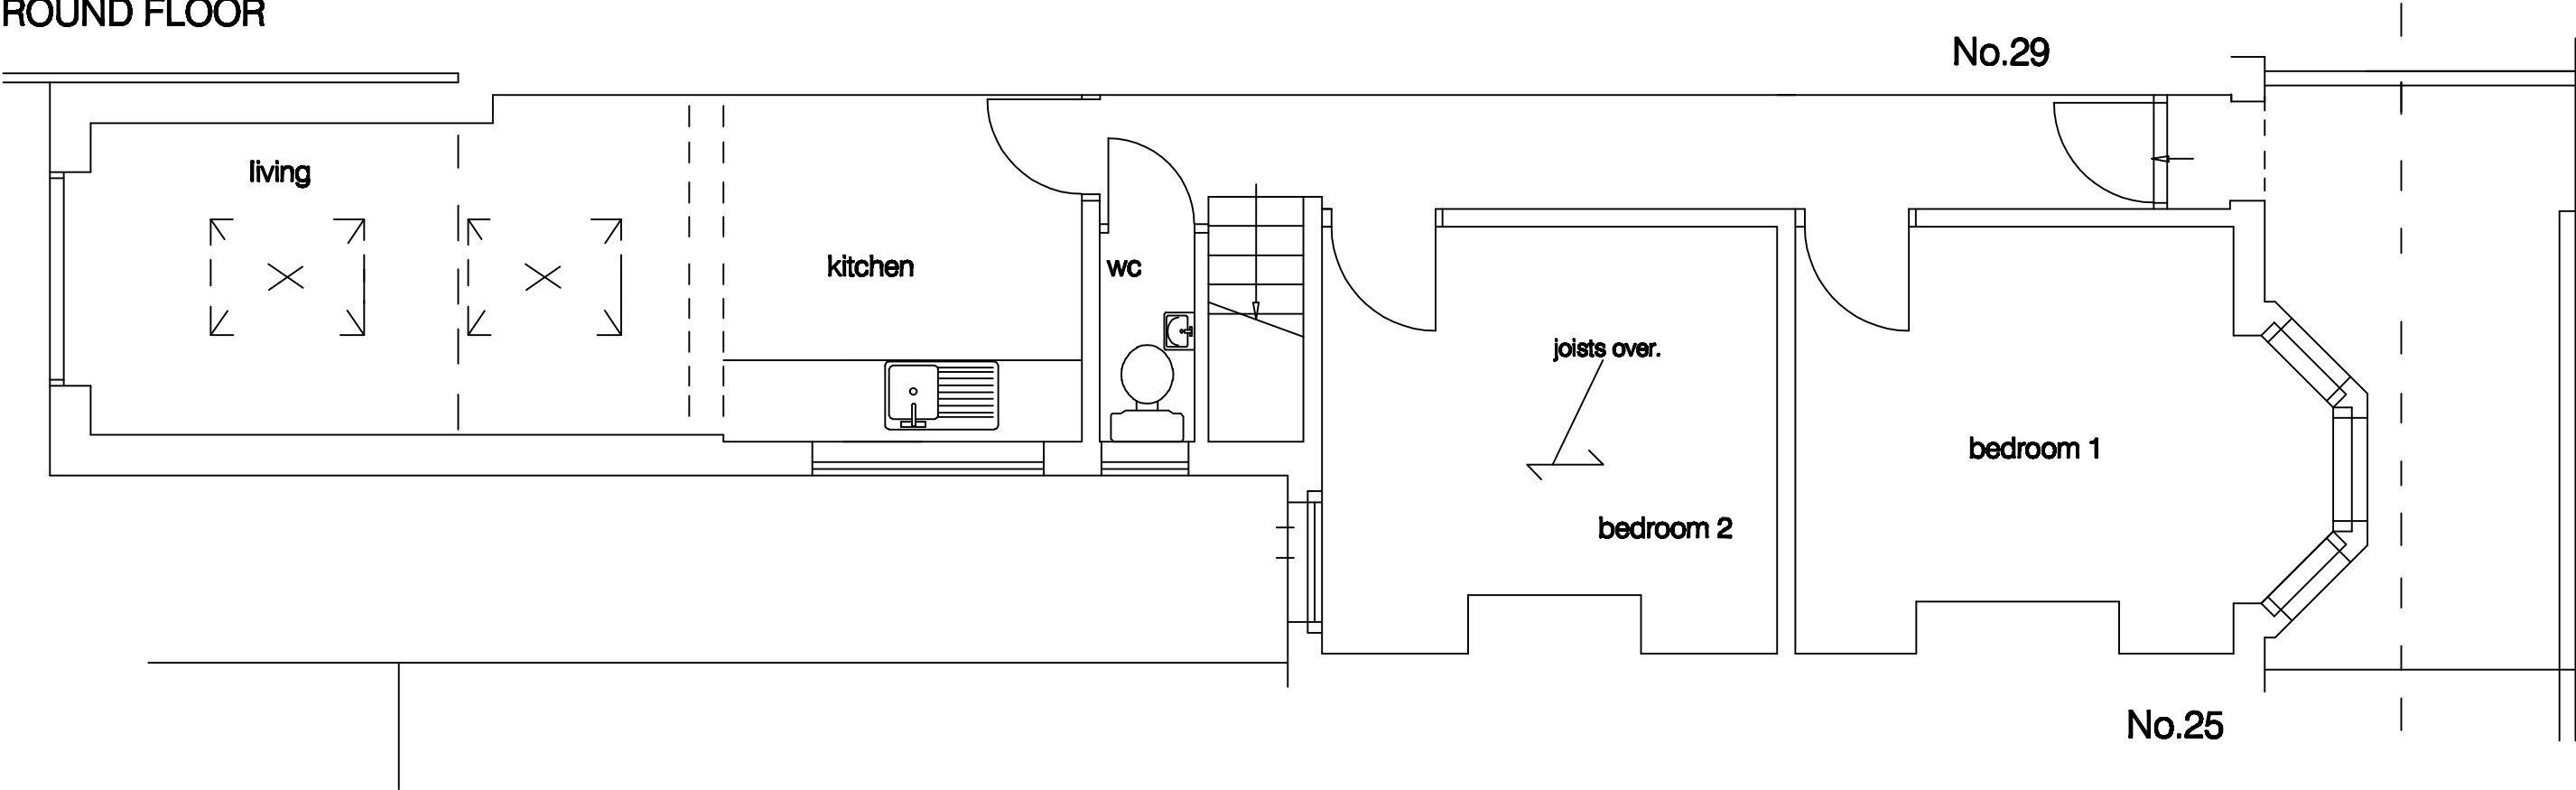

project
for
title

27 St Edwards Road
Reading, Berkshire

Mr M Iqbal

1:50 Ground Floor & Rear Elevations as Built


Drawing no: 969 / 11 /

M D Howlett
architectural consultant


11 Prospect Street, Caversham, Reading
Berkshire RG4 8JB; Tel: (0118) 947 7117
Email: pmaarc@globalnet.co.uk

Date: May 2022

1 2 3 4 m (1:50 @ A2)

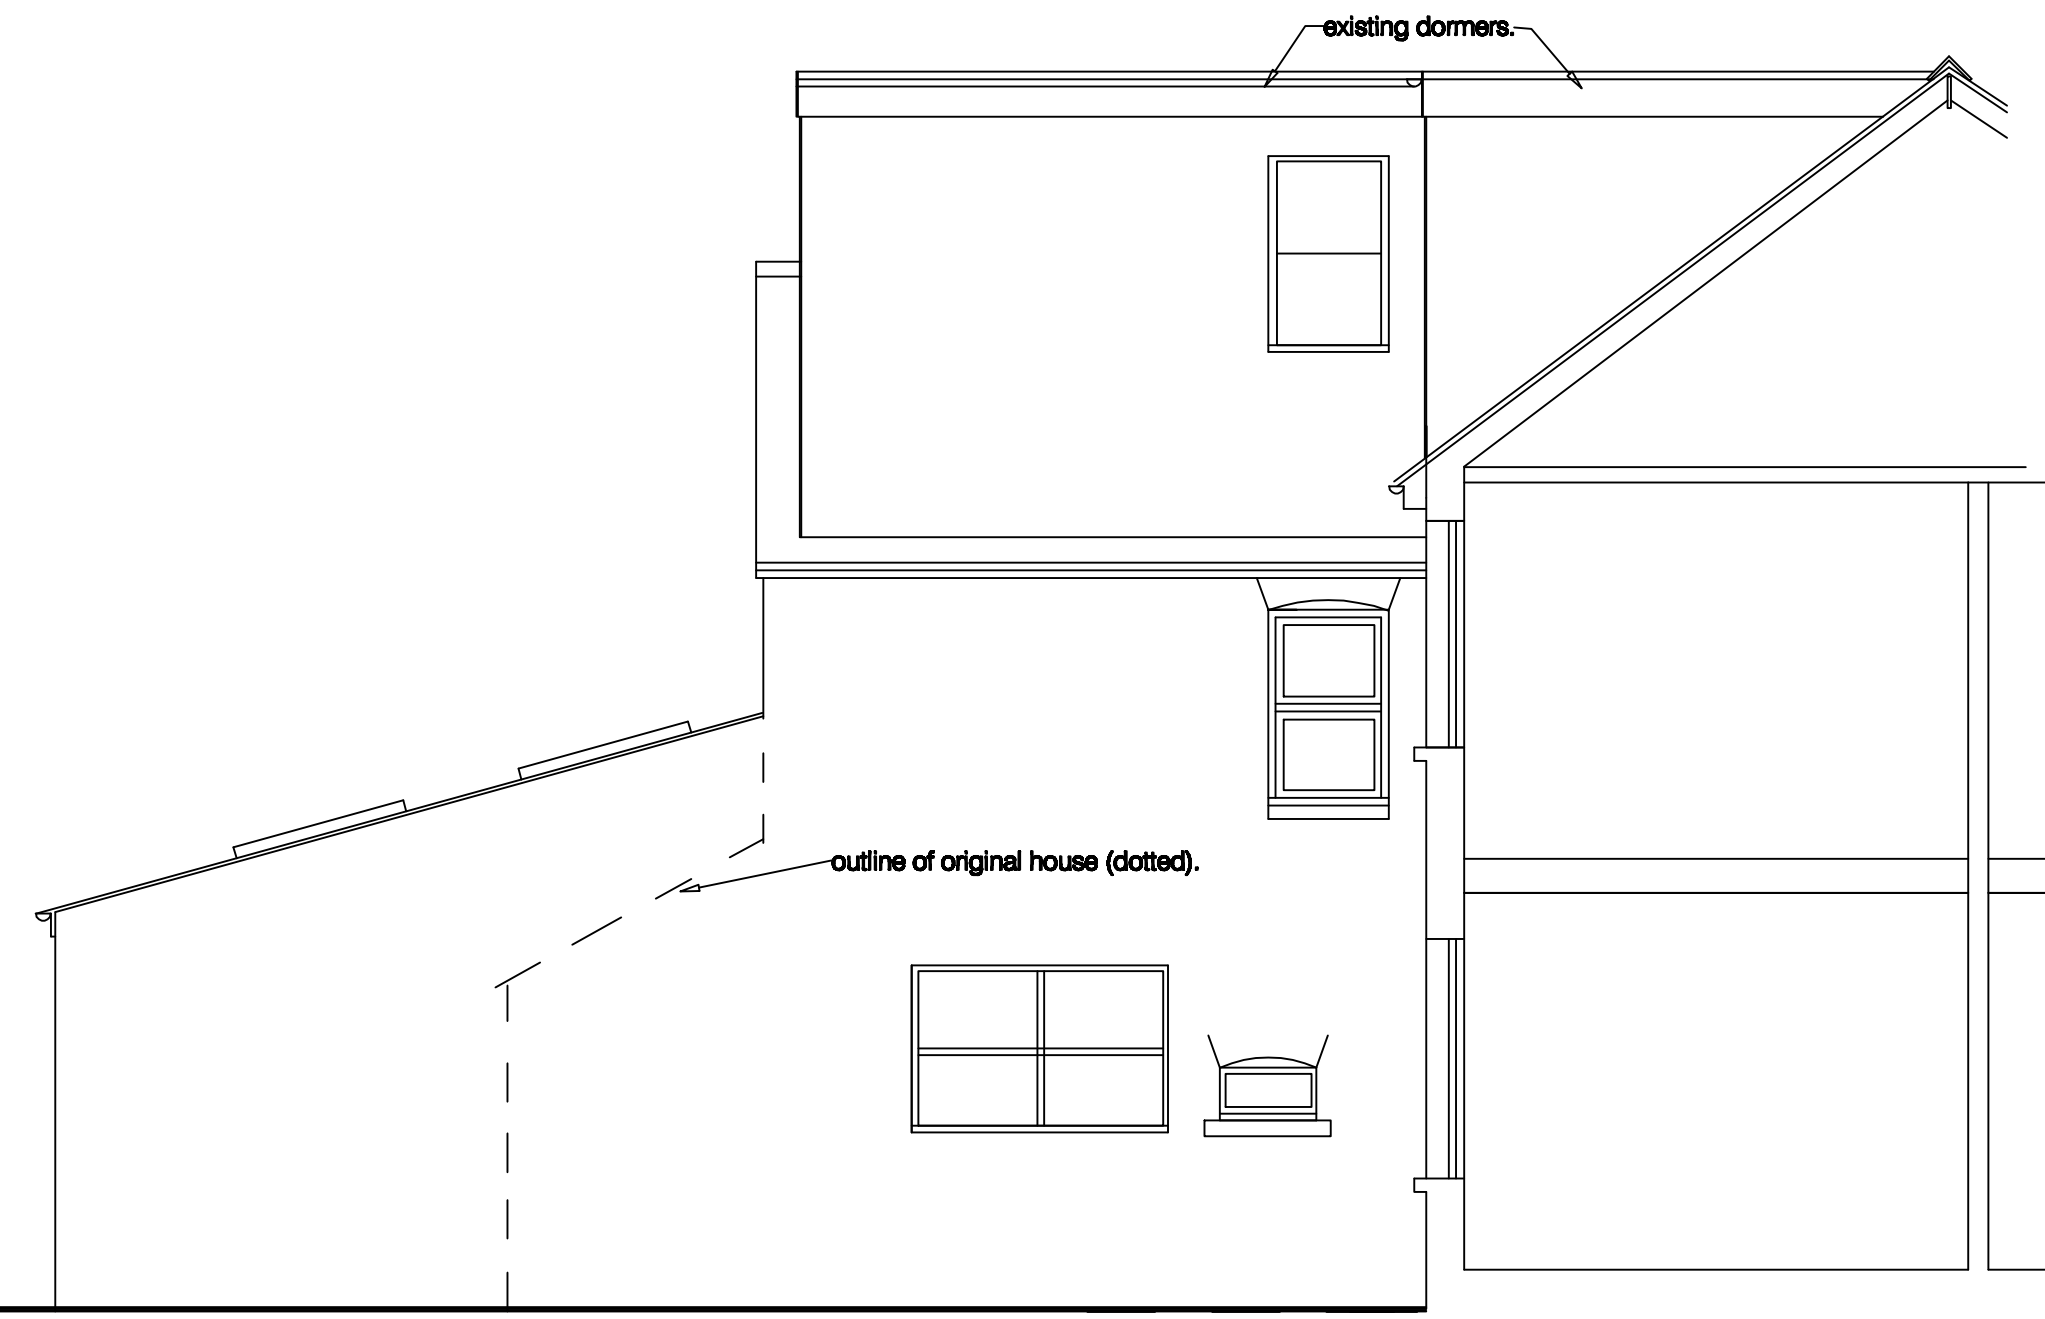

SIDE ELEVATION

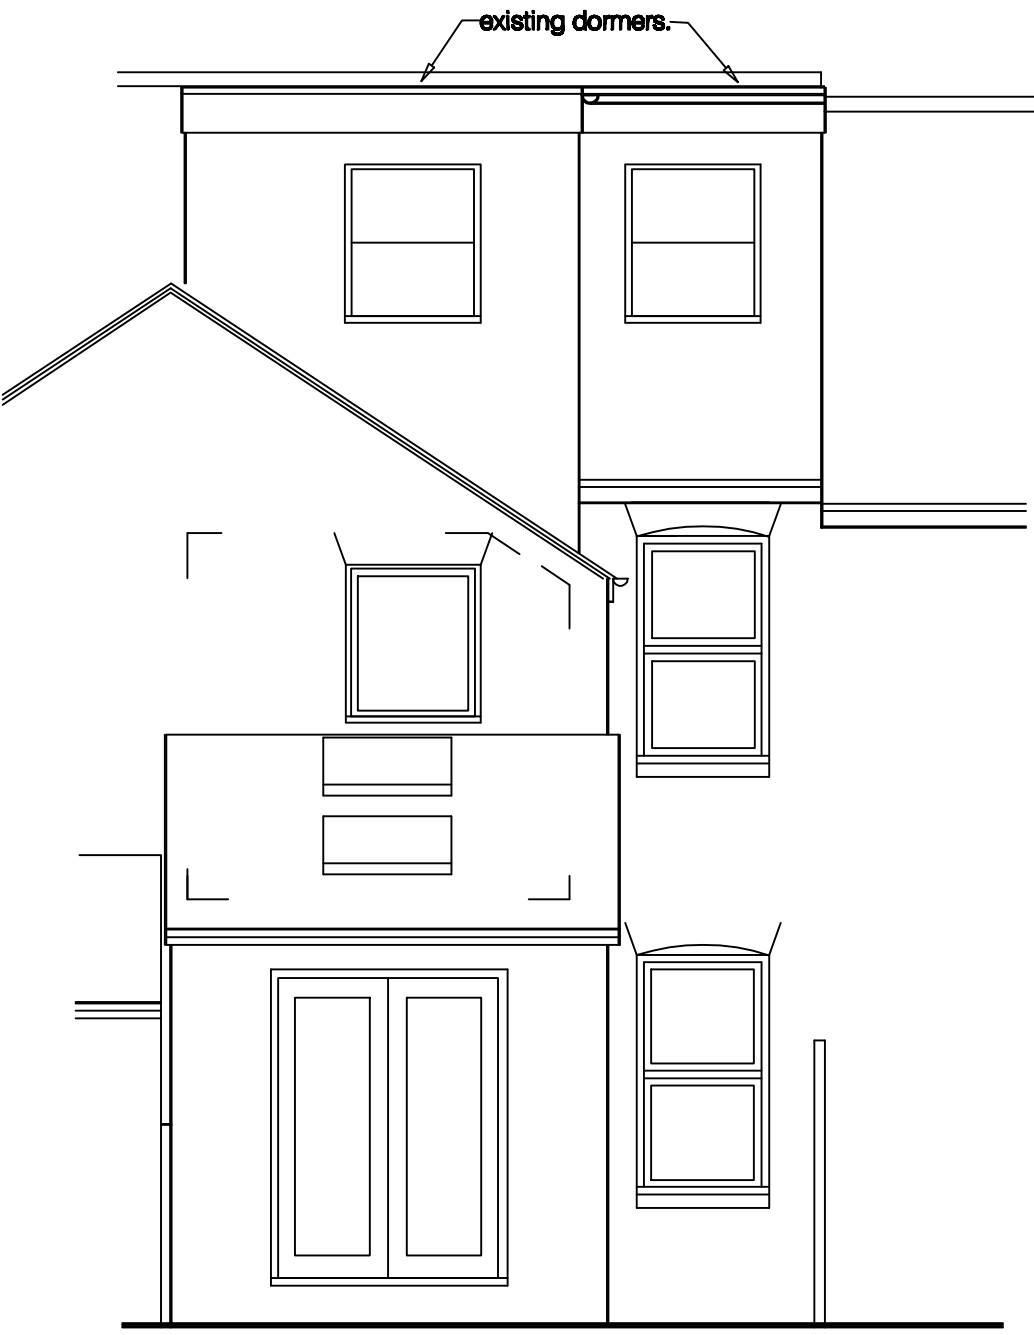

REAR ELEVATION