



Design & Access Statement

E04759

APPENDIX G

Levels Survey & Utilities Information




Notes

1. The survey was carried out in January 2020.
2. The survey is based on Ordnance Survey grid and datum established using GPS observations. Survey control set at station S2 and scale factor has been removed.
3. All values are displayed in metres.
4. At the time of survey some areas of site were overgrown or had recently undergone demolition works. These areas should be verified as some services/features may not have been visible.

Survey Key

AV	AIR VALVE	VR	IRON RAIL
BH	BORE HOLE	VO	KEYS OUTLET
BR	BOLLARD	VB	LETTER BOX
BM	BENCH MARK	LP	LAKE POOL
BE	BEACON	LS	LANDSLIDE
BT	BRITISH TELECOM COVER	LM	MANHOLE
BT	BRITISH TELECOM COVER	ML	MANHOLE POST
CB	CONTROL BOX	MP	MANHOLE POST
CC	CONCRETE CRACK	PM	NAME PLATE
CL	COVER LEVEL	PP	PARKING METER
CG	CONCRETE GROUND	PD	POST AND MAIL
CH	CHAIN LINK	PW	POST AND WIRE
CH	CHAIN LINK	PP	POSSIBLE
CNC	CONCRETE PAVING SLABS	RD	ROAD SIGN
CP	CONCRETE PAVING	RP	RUNNING PIPE
CNP	CHESTNUT PAULING	RF	ROOF FLOOR
CT	CABLE TIE	SR	SOFT SPOT
CT	CABLE TIE	ST	STEEL TRAILING
CT	CABLE LINK DIAMETER	ST	STOP VALVE
DD	DOWN PIPE	SV	STOP VALVE
EE	ELECTRICITY BOX	TAC	TANK PURCHASE WATER
EE	ELECTRICITY BOX	TE	TELEPHONE CALL BOX
ER	EARTH ROAD	TL	TRAFFIC LIGHT
ER	EARTH ROAD	TLC	TRAFFIC LIGHT SERVICE WATER
FI	FI-FIRE HYDRANT	TR	TRUCK TO GO W/ LEVEL
FI	FI-FIRE HYDRANT	UN	UNKNOWN W/ LEVEL
GL	GROUND LEVEL	VC	VENT PIPE
GP	GATE POST	WCL	WINDOWN HEAD COVER
GS	GATE VALVE	WD	WATER LEVEL
GY	GALLY	WD	WATER LEVEL
IN	INSPECTION COVER	WM	WASH OUT WATER
INV	DITCH/VERT LEVEL	WO	WASH OUT WATER

Sheet Layout

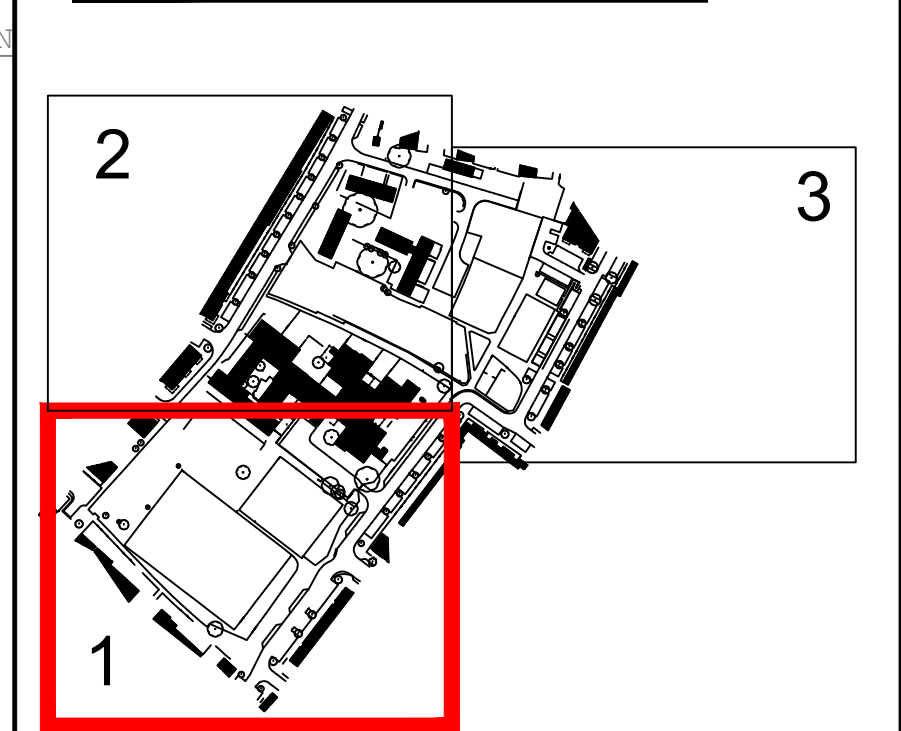


Survey Station Co-ordinates

Station	Easting	Northing	Level
S1	468317.585	173626.657	55.865
S2	468346.680	173658.495	57.030
S3	468364.772	173687.308	57.472
S4	468388.473	173725.775	57.094
S5	468429.964	173722.577	53.604
S6	468493.362	173702.019	50.359
S7	468486.687	173674.059	50.666
S8	468452.646	173607.926	52.296
S9	468406.352	173557.569	55.505
S10	468382.801	173511.842	56.758
S11	468330.033	173485.587	60.166
S12	468291.418	173507.766	60.033
S13	468252.705	173545.636	58.749
S14	468294.434	173593.006	56.460
S15	468295.039	173587.774	56.437
S52	468325.758	173623.507	54.682
S54	468388.890	173835.411	54.211
S56	468376.055	173580.339	54.648
S57	468401.331	173565.633	55.223
S58	468418.569	173585.406	54.463
S503	468434.205	173607.104	53.303
S504	468406.199	173622.446	53.644

ISSUE/ REVISION _____

	B	06/04/20	Survey grid and level updated	CE	BS
			to relate to Ordnance Survey		

Rev	Date	Status/ Amendment	Drawn	Checked
-----	------	-------------------	-------	---------

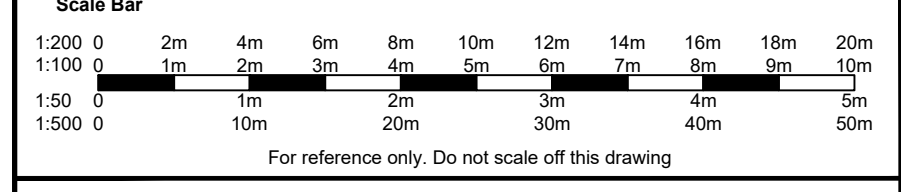

Client: **Catalyst Housing Limited**

Project: **Dee Park - Ranikhet Academy**
Spey Rd, Reading RG30 4ED

Title: **Topographical Survey**
Sheet Number: **1 of 3**

Status: **For Approval** Checked: **CE**
 Drawn: **KH** Date: **07/02/2020** Scale: **1:200 @ A0**

Project No: **BES19292** Drg No: **1** Rev: **B**

TOPOGRAPHICAL SURVEYS GPS MEASURED BUILDING SURVEYS
3D LASER SCANNING AS-BUILT SURVEYS AREA MEASUREMENTS



The survey was carried out in January 2020.

The survey is based on Ordnance Survey grid and datum established using GPS observations. Survey control set at station S2 and scale factor has been removed.

All values are displayed in metres.

At the time of survey some areas of site were overgrown or had recently undergone demolition works. These areas should be verified as some services/features may not have been visible.

[illegible]

Station	Easting	Northing	Level
S1	468317.585	173626.67	55.865
S2	468346.680	173656.49	57.030
S3	468364.772	173687.30	57.472
S4	468388.473	173725.775	57.094
S5	468429.964	173722.577	53.504
S6	468493.362	173702.019	55.869
S7	468486.687	173674.059	50.666
S8	468452.646	173607.926	52.206
S9	468460.352	173557.569	55.505
S10	468382.601	173511.642	56.758
S11	468336.033	173465.587	60.166
S12	468291.418	173507.766	60.033
S13	468252.705	173545.636	58.749
S14	468294.434	173593.096	56.460
S51	468256.039	173587.774	56.437
S52	468325.759	173623.507	54.682
S53	468368.890	173635.411	54.641
S500	468376.055	173580.339	54.218
S501	468401.331	173565.653	55.253
S502	468418.569	173585.406	54.423
S503	468434.205	173607.104	53.306
S504	468406.199	173622.446	53.644


B	06/04/20	Survey grid and level updated to relate to Ordnance Survey	CE	




Project: **Dee Park - Ranikhet Academy**
Spey Rd, Reading RG30 4ED
 Title: **Topographical Survey**
 Sheet Number: **2 of 3**
 Status: **For Approval** Checked: **CE**
 Drawn: **KH** Date: **07/02/2020** Scale: **1:200**

Project No: **BES19292** Dwg No: **2** Rev: **B**

TOPOGRAPHICAL SURVEYS GPS MEASURED BUILDING SURVEYS
LASER SCANNING AS-BUILT SURVEYS AREA MEASUREMENTS

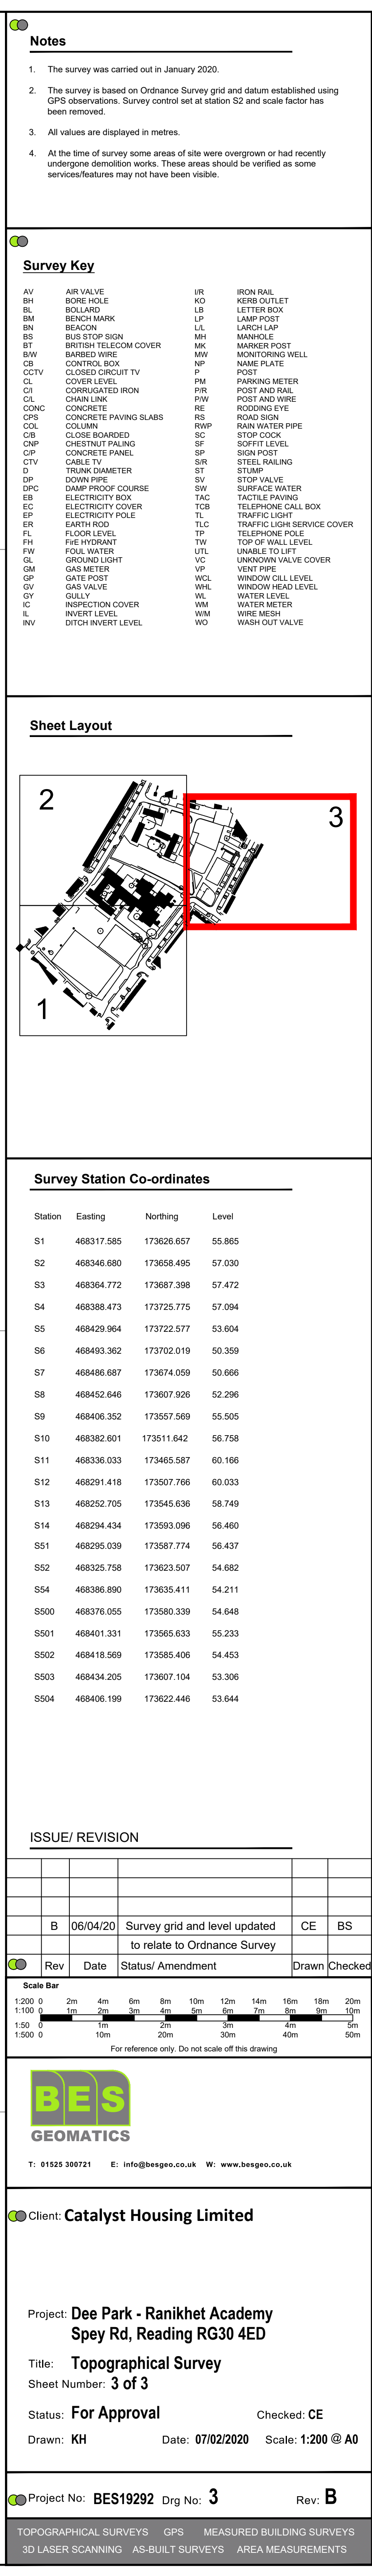

TOPOGRAPHICAL SURVEYS GPS MEASURED BUILDING SURVEYS
3D LASER SCANNING AS-BUILT SURVEYS AREA MEASUREMENTS

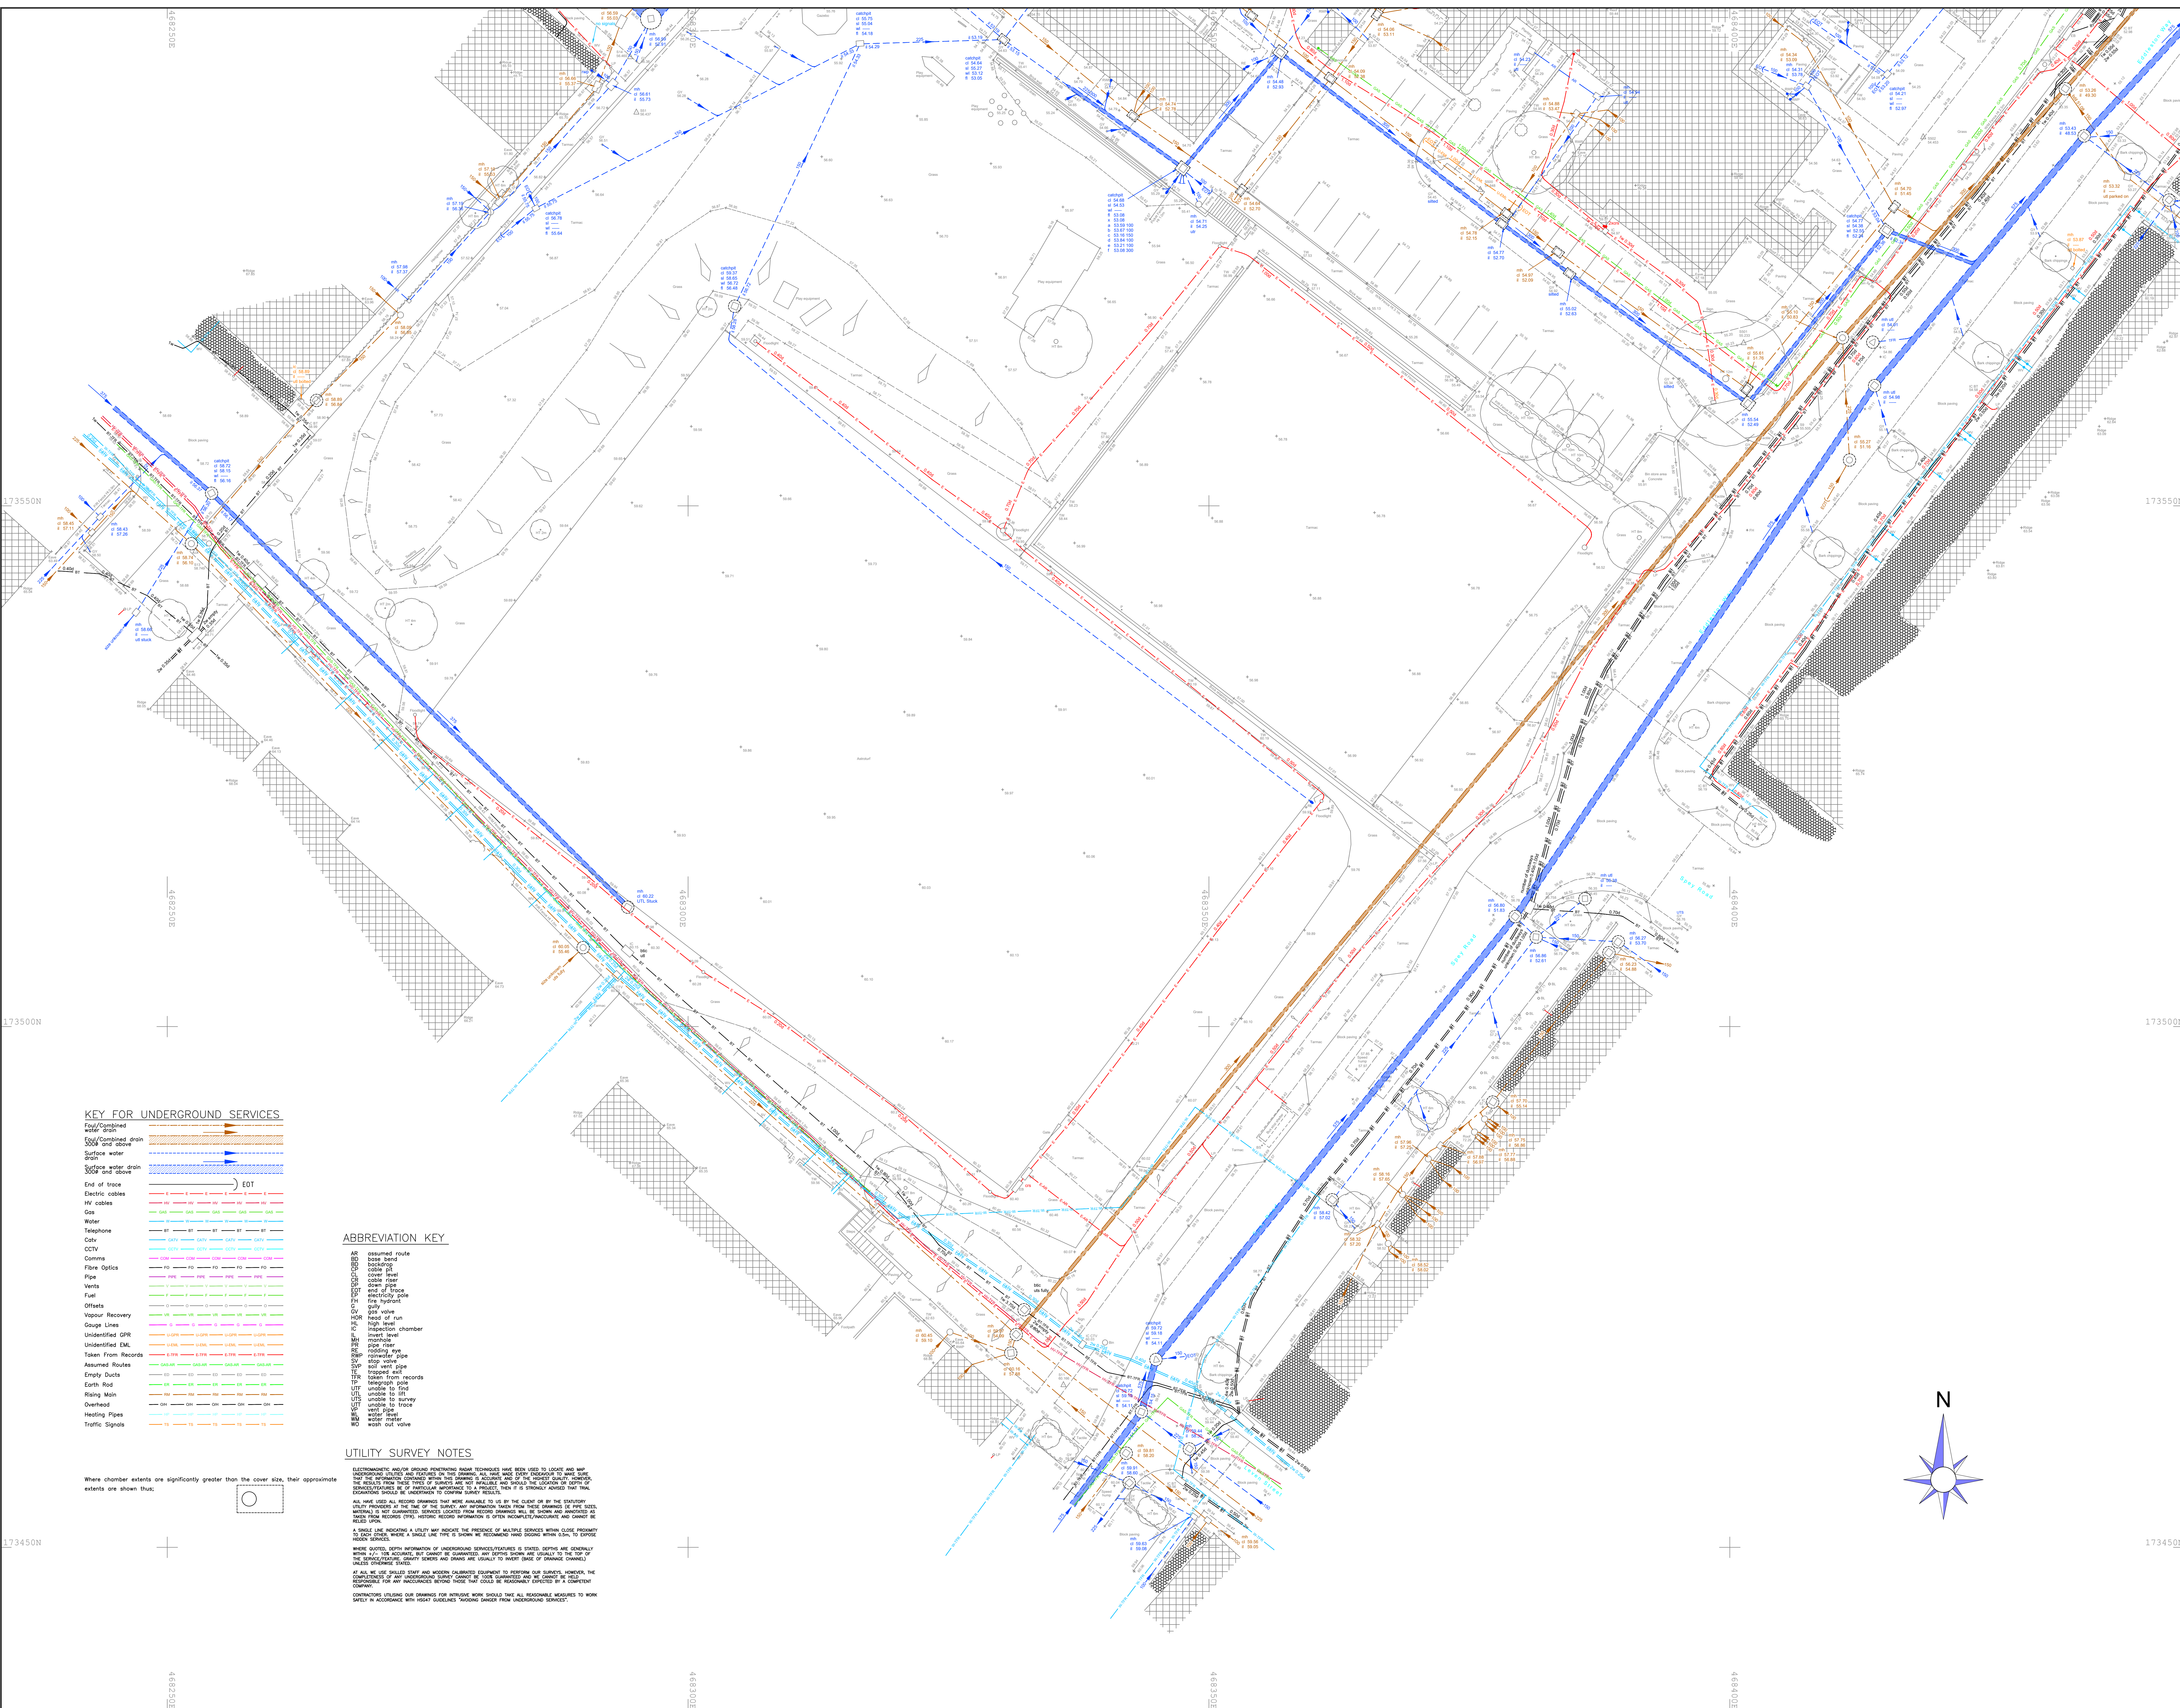


Notes

1. The survey was carried out in January 2020.
2. The survey is based on Ordnance Survey grid and datum established using GPS observations. Survey control set at station S2 and scale factor has been removed.
3. All values are displayed in metres.
4. At the time of survey some areas of site were overgrown or had recently undergone demolition works. These areas should be verified as some services/features may not have been visible.

Survey Key

AV	ARB VEHICLE	BR	IRON RAIL
BA	BAR	BU	BULLET
BC	BLOCK	BU	UNDER
BD	BLOCK	BU	LAMP POST
BE	BEAN	BU	MANHOLE
BF	BEST FLOOR ELEVATION COVER	BU	MARKER POST
BG	BEST FLOOR ELEVATION COVER	BU	MANHOLE
BH	BEST FLOOR ELEVATION COVER	BU	MANHOLE
CA	CABLE	BU	MANHOLE
CB	CABLE	BU	MANHOLE
CC	CABLE	BU	MANHOLE
CD	CABLE	BU	MANHOLE
CE	CABLE	BU	MANHOLE
CF	CABLE	BU	MANHOLE
CG	CABLE	BU	MANHOLE
CH	CABLE	BU	MANHOLE
CI	CABLE	BU	MANHOLE
CJ	CABLE	BU	MANHOLE
CK	CABLE	BU	MANHOLE
CL	CABLE	BU	MANHOLE
CM	CABLE	BU	MANHOLE
CN	CABLE	BU	MANHOLE
CO	CABLE	BU	MANHOLE
CP	CABLE	BU	MANHOLE
CQ	CABLE	BU	MANHOLE
CR	CABLE	BU	MANHOLE
CS	CABLE	BU	MANHOLE
CT	CABLE	BU	MANHOLE
CU	CABLE	BU	MANHOLE
CV	CABLE	BU	MANHOLE
CW	CABLE	BU	MANHOLE
CX	CABLE	BU	MANHOLE
CY	CABLE	BU	MANHOLE
CZ	CABLE	BU	MANHOLE
DA	DAMP	BU	MANHOLE
DB	DAMP	BU	MANHOLE
DC	DAMP	BU	MANHOLE
DD	DAMP	BU	MANHOLE
DE	DAMP	BU	MANHOLE
DF	DAMP	BU	MANHOLE
DG	DAMP	BU	MANHOLE
DH	DAMP	BU	MANHOLE
DI	DAMP	BU	MANHOLE
DJ	DAMP	BU	MANHOLE
DK	DAMP	BU	MANHOLE
DL	DAMP	BU	MANHOLE
DM	DAMP	BU	MANHOLE
DN	DAMP	BU	MANHOLE
DO	DAMP	BU	MANHOLE
DP	DAMP	BU	MANHOLE
FF	FALL	BU	MANHOLE
FG	FALL	BU	MANHOLE
FH	FALL	BU	MANHOLE
FI	FALL	BU	MANHOLE
FJ	FALL	BU	MANHOLE
FK	FALL	BU	MANHOLE
FL	FALL	BU	MANHOLE
FM	FALL	BU	MANHOLE
FN	FALL	BU	MANHOLE
FO	FALL	BU	MANHOLE
FP	FALL	BU	MANHOLE
FQ	FALL	BU	MANHOLE
FR	FALL	BU	MANHOLE
FS	FALL	BU	MANHOLE

Sheet Layout

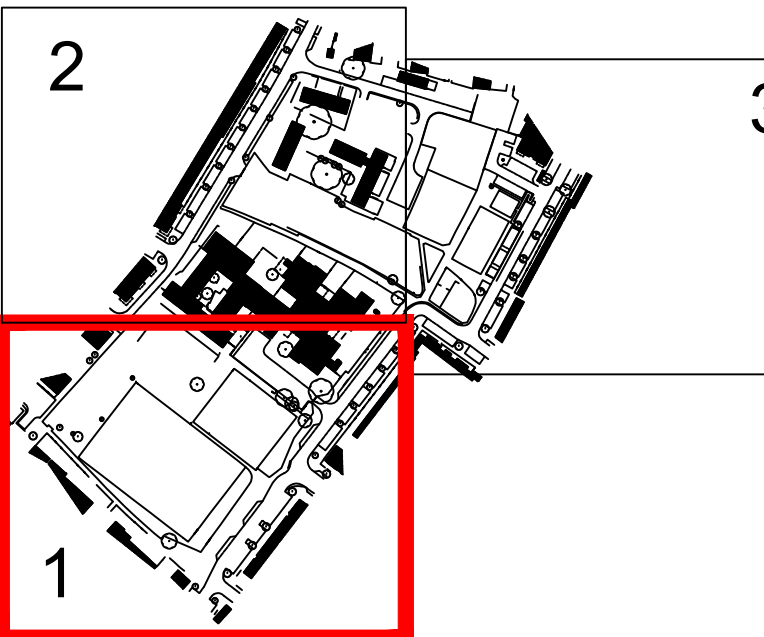


Survey Station Co-ordinates

Station	Easting	Northing	Level
S1	46831.7585	173626.657	55.865
S2	46834.6846	173658.456	57.030
S3	46834.4772	173687.308	57.472
S4	46838.4723	173725.775	57.094
S5	46842.9642	173722.577	53.604
S6	46849.3361	173702.019	50.359
S7	46848.6887	173874.059	50.666
S8	46842.6465	173807.826	52.256
S9	46840.3352	173557.669	55.905
S10	46832.6621	173511.642	56.758
S11	46833.033	173465.587	60.166
S12	46820.1418	173507.766	60.033
S13	46822.705	173545.636	59.749
S14	46824.434	173593.096	56.460
S15	46825.039	173587.774	56.437
S16	46832.7578	173623.507	54.682
S54	46838.890	173635.411	54.211
S500	46837.655	173980.539	54.648
S501	46840.133	173985.633	55.233
S502	46841.959	173985.406	54.453
S503	46844.205	173807.104	53.306
S504	46846.199	173822.446	53.644

ISSUE/ REVISION

	C	12/06/20	Utilities Survey added	AU	
	B	06/04/20	Survey grid and level updated	CF	

			to relate to Ordnance Survey	
	Rev	Date	Status/ Amendment	Drawn C

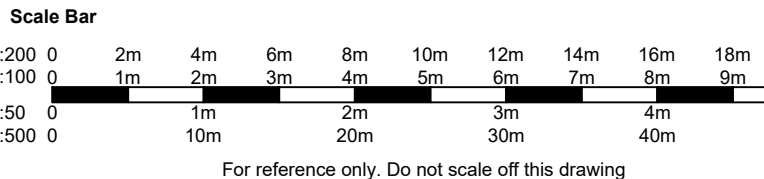

T: 01525 310721 E: info@besgeo.co.uk W: www.besgeo.co.uk

Client: Catalyst Housing Limited

Project: **Dee Park - Ranikhet Academy**
Spey Rd, Reading RG30 4ED

Title: **Topographical Survey**

Sheet Number: 1 of 3


Status: **For Approval**

Status: **For Approval** Checked: **CE**

Project No: **BES19292** Drg No: **1**


Rev: C

3D LASER SCANNING AS-BUILT SURVEYS AREA MEASUREMENT

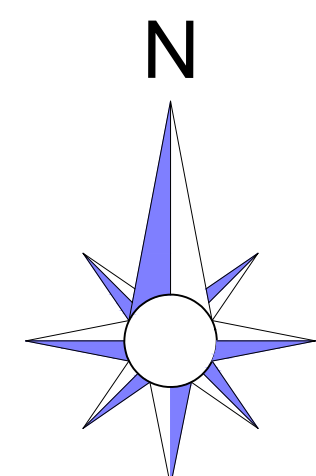

KEY FOR UNDERGROUND SERVICES

Gas	100mm	150mm	200mm	250mm	300mm	350mm	400mm	450mm	500mm	600mm	750mm	900mm	1050mm	1200mm	1350mm	1500mm	1650mm	1800mm	2000mm	2250mm	2400mm	2550mm	161850mm	162000mm</
-----	-------	-------	-------	-------	-------	-------	-------	-------	-------	-------	-------	-------	--------	--------	---------	---------	----------	----------	------------

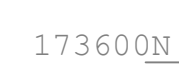

TOPOGRAPHICAL SURVEYS	GPS	MEASURED BUILDING SURVEYS
3D LASER SCANNING	AS-BUILT SURVEYS	AREA MEASUREMENTS

- | | | |
|-----------------------|------------------|---------------------------|
| TOPOGRAPHICAL SURVEYS | GPS | MEASURED BUILDING SURVEYS |
| 3D LASER SCANNING | AS-BUILT SURVEYS | AREA MEASUREMENTS |