






front

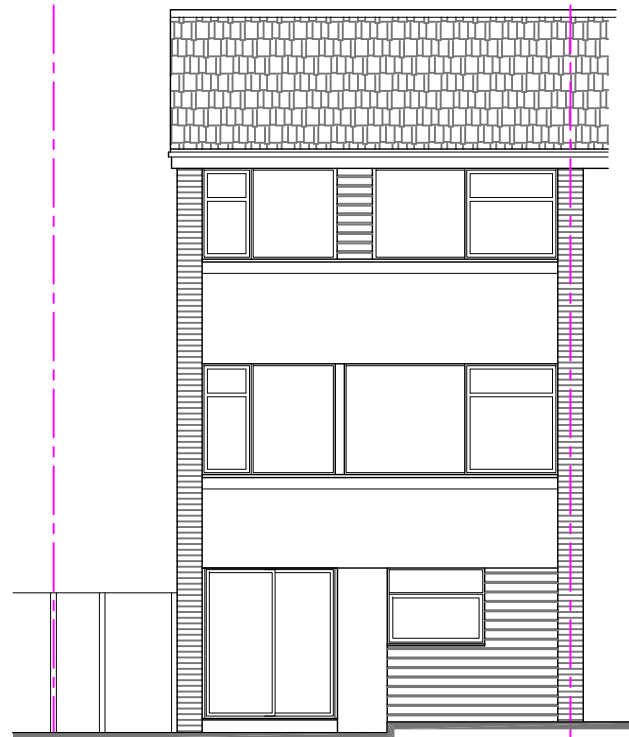

side

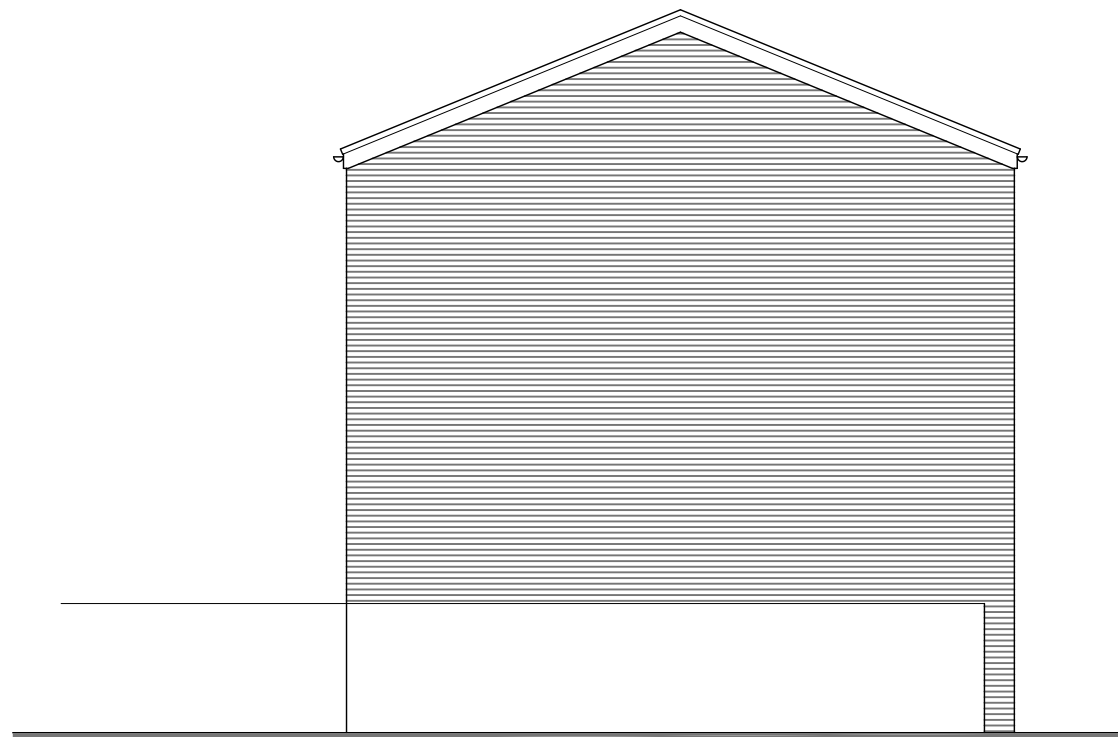


rear

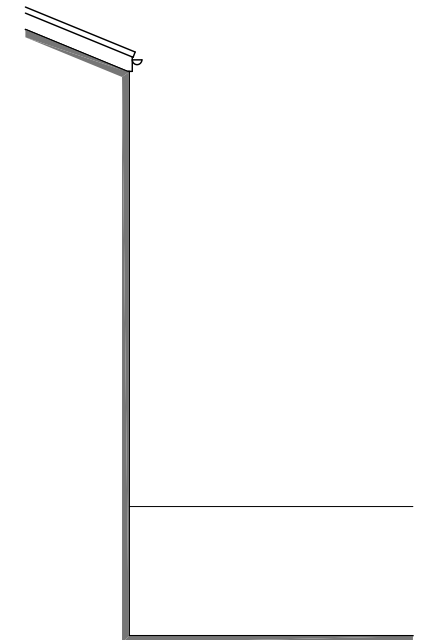


side


ELEVATIONS (Pre-EXISTING)

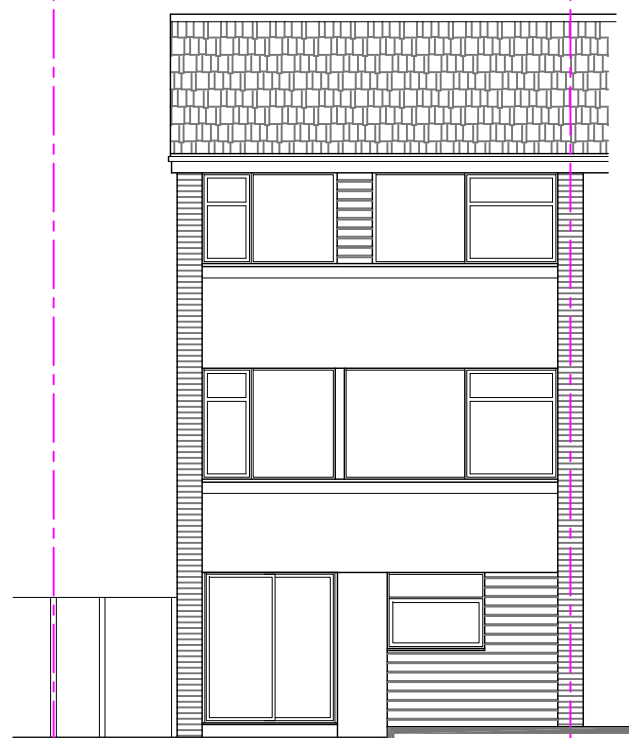


front

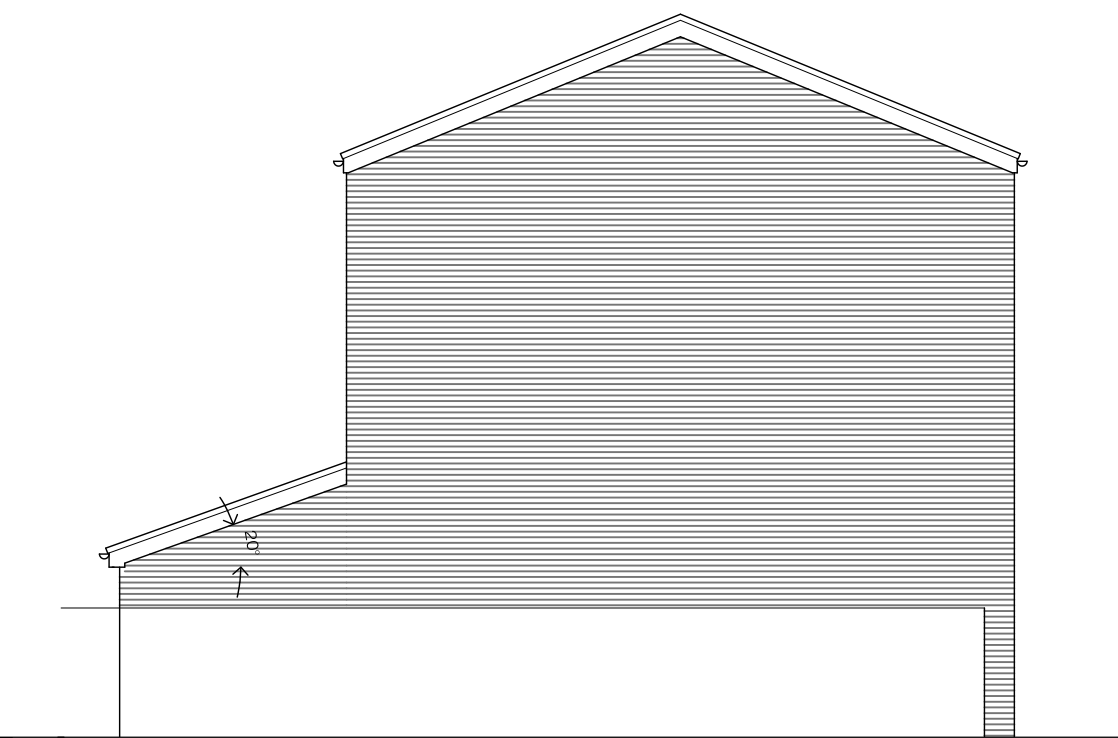

side

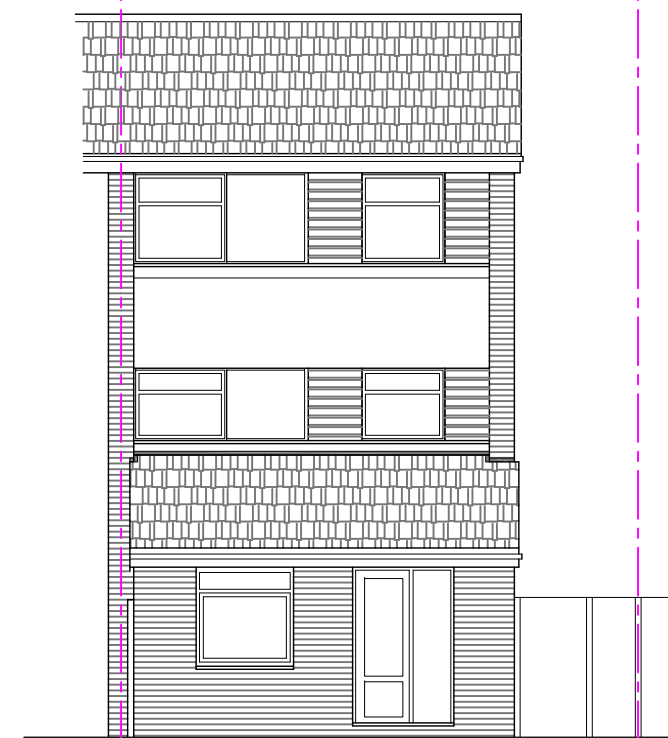

rear

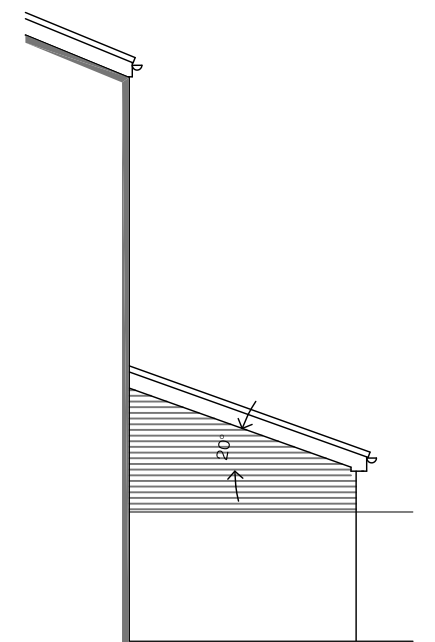


side

ELEVATIONS (As Built)



RAMMURTI DESIGN LTD
ARCHITECTURAL & PLANNING SERVICES
268 TILEHURST ROAD, READING RG30 2NE
TEL/FAX:01189510628 MOB:07799883574

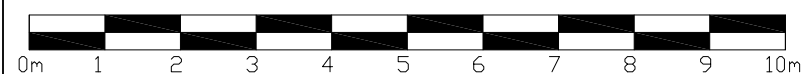

Proposed conversion of existing dwelling to 1No 1bed
ground floor apartments and 1No 3bedroom upper floor
duplex apartment at No 20 Combe Road RG30 4NE

for Mr Muso Myftari

Pre-Existing & As Built Elevations

Scale: 1/100

Date: April 2021

CR:014 Rev -