






GROUND FLOOR PLAN

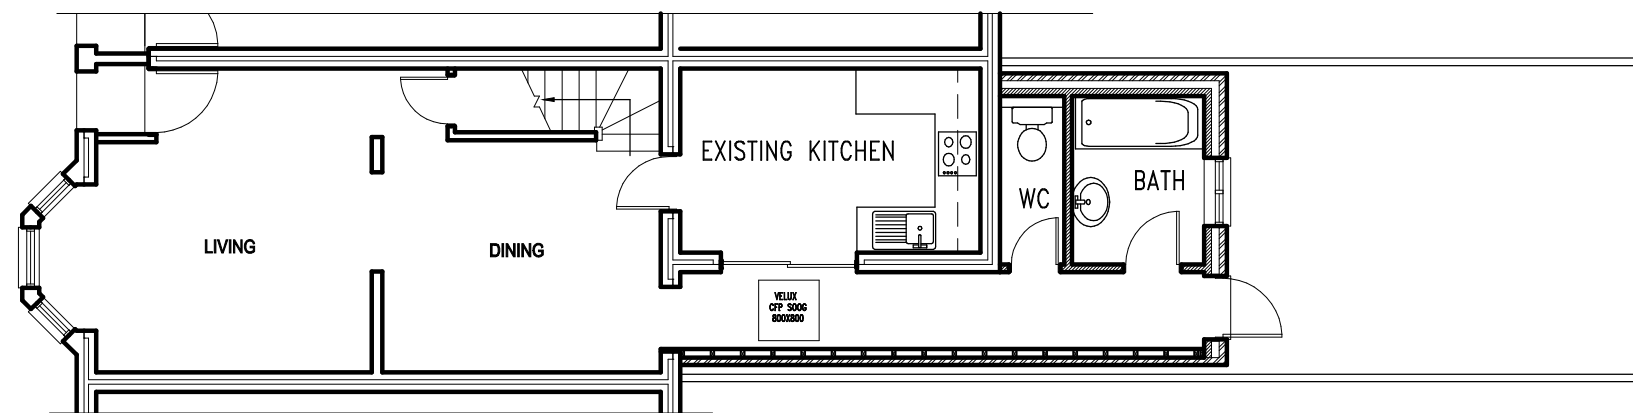

REAR ELEVATION

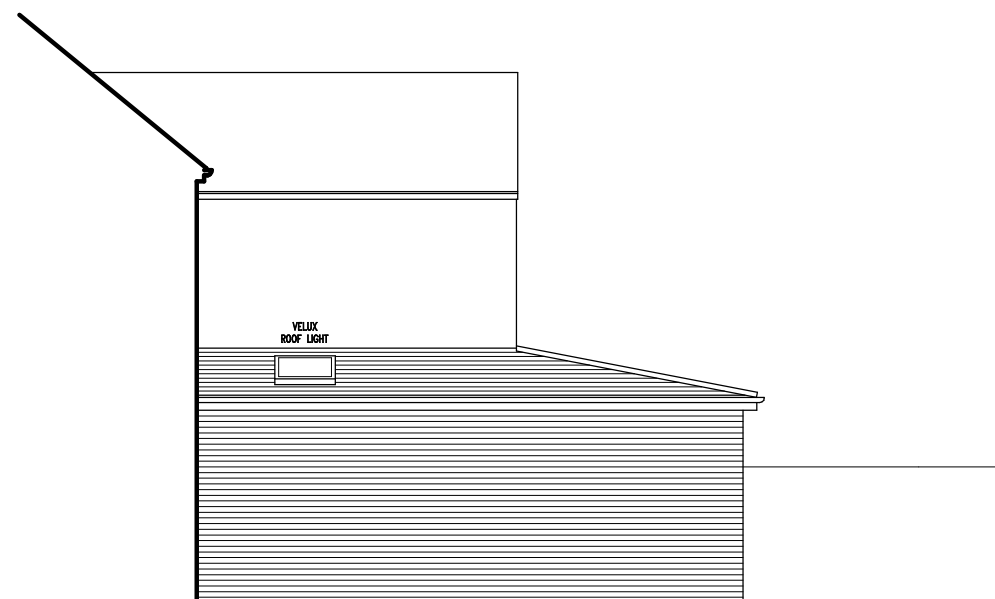

SIDE ELEVATION

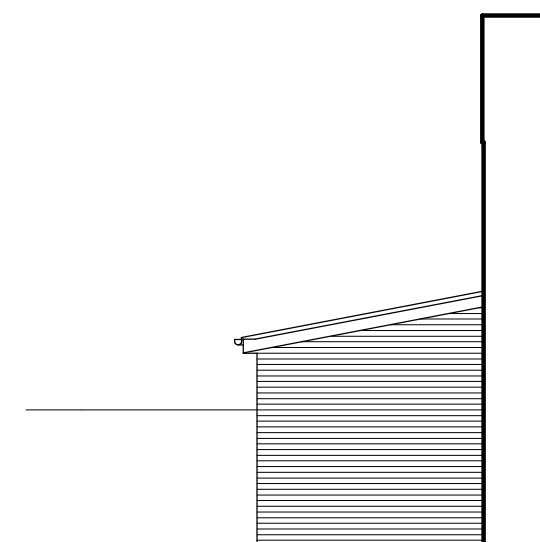

SIDE ELEVATION



AS BUILT EXTENSION

Job SINGLE STOREY EXTENSION 30 ADDISON ROAD READING			pioneer designs ltd 17 Kingswood Court, Reading RG30 2AU 01183475590 / 07725338742 pioneerdesignsltd@gmail.com
Client MRS R TAMANG			
Drawing AS BUILT FLOOR PLAN & ELEVATIONS			
Date NOVEMBER 2019	Scale 1:100	Dwg. No. 191101-4	
Date			Revisions