



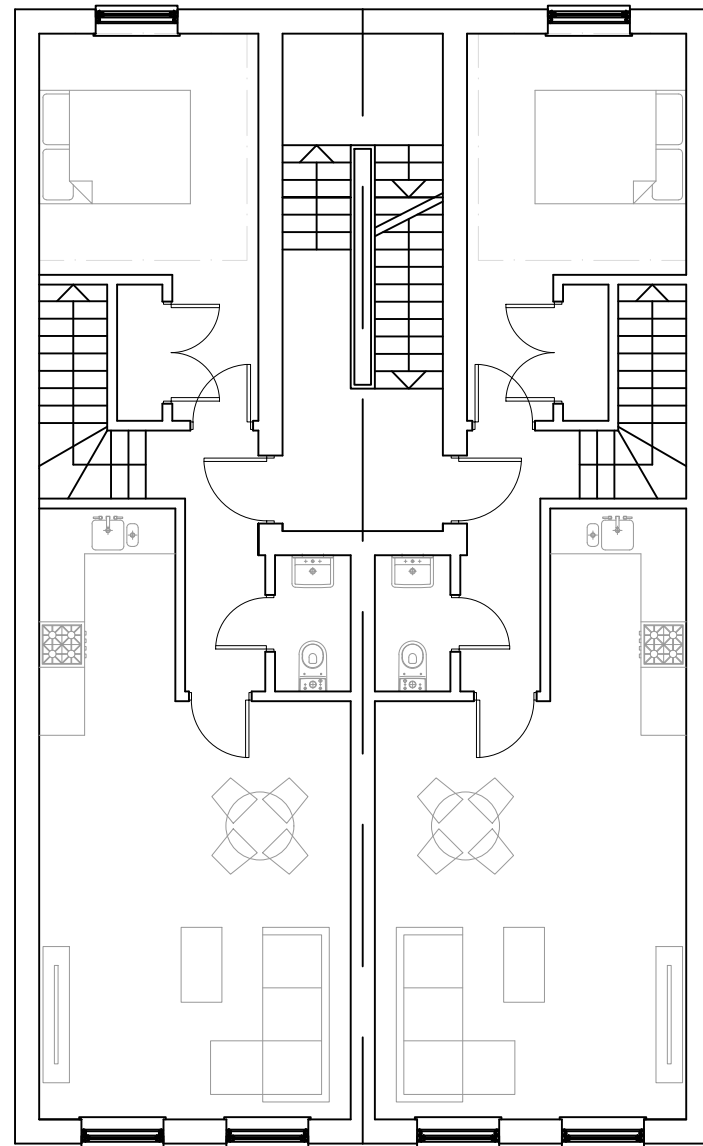

FIRST FLOOR PLAN -
AS BUILT (UNCHANGED)

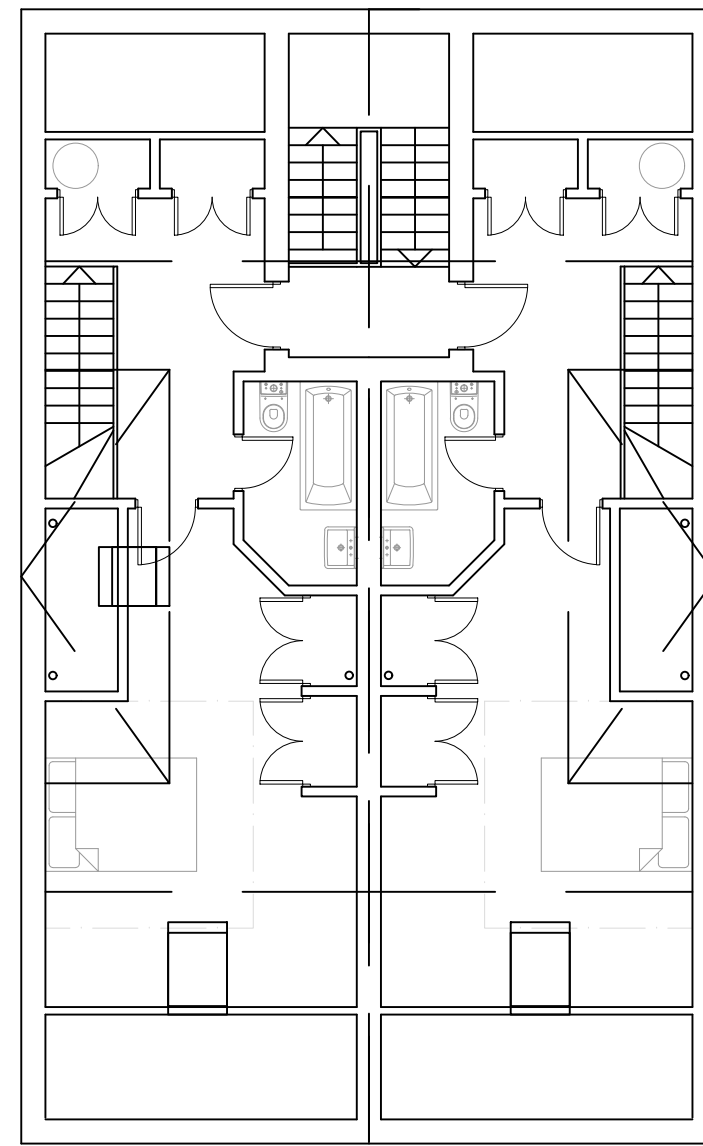

SECOND FLOOR PLAN -
AS BUILT (UNCHANGED)

This drawing is protected under Copyright and at no time should any portion of this drawing be reproduced or copied without the permission of the Architect. (Design Copyright Act 1968)

This drawings must not be used for purposes other than that for which it is provided. It is supplied without liability for any errors or omissions.

Do not scale from this drawing, all dimensions to be checked on site. All drawings subject to Statutory Authority Approval.

[illegible]