


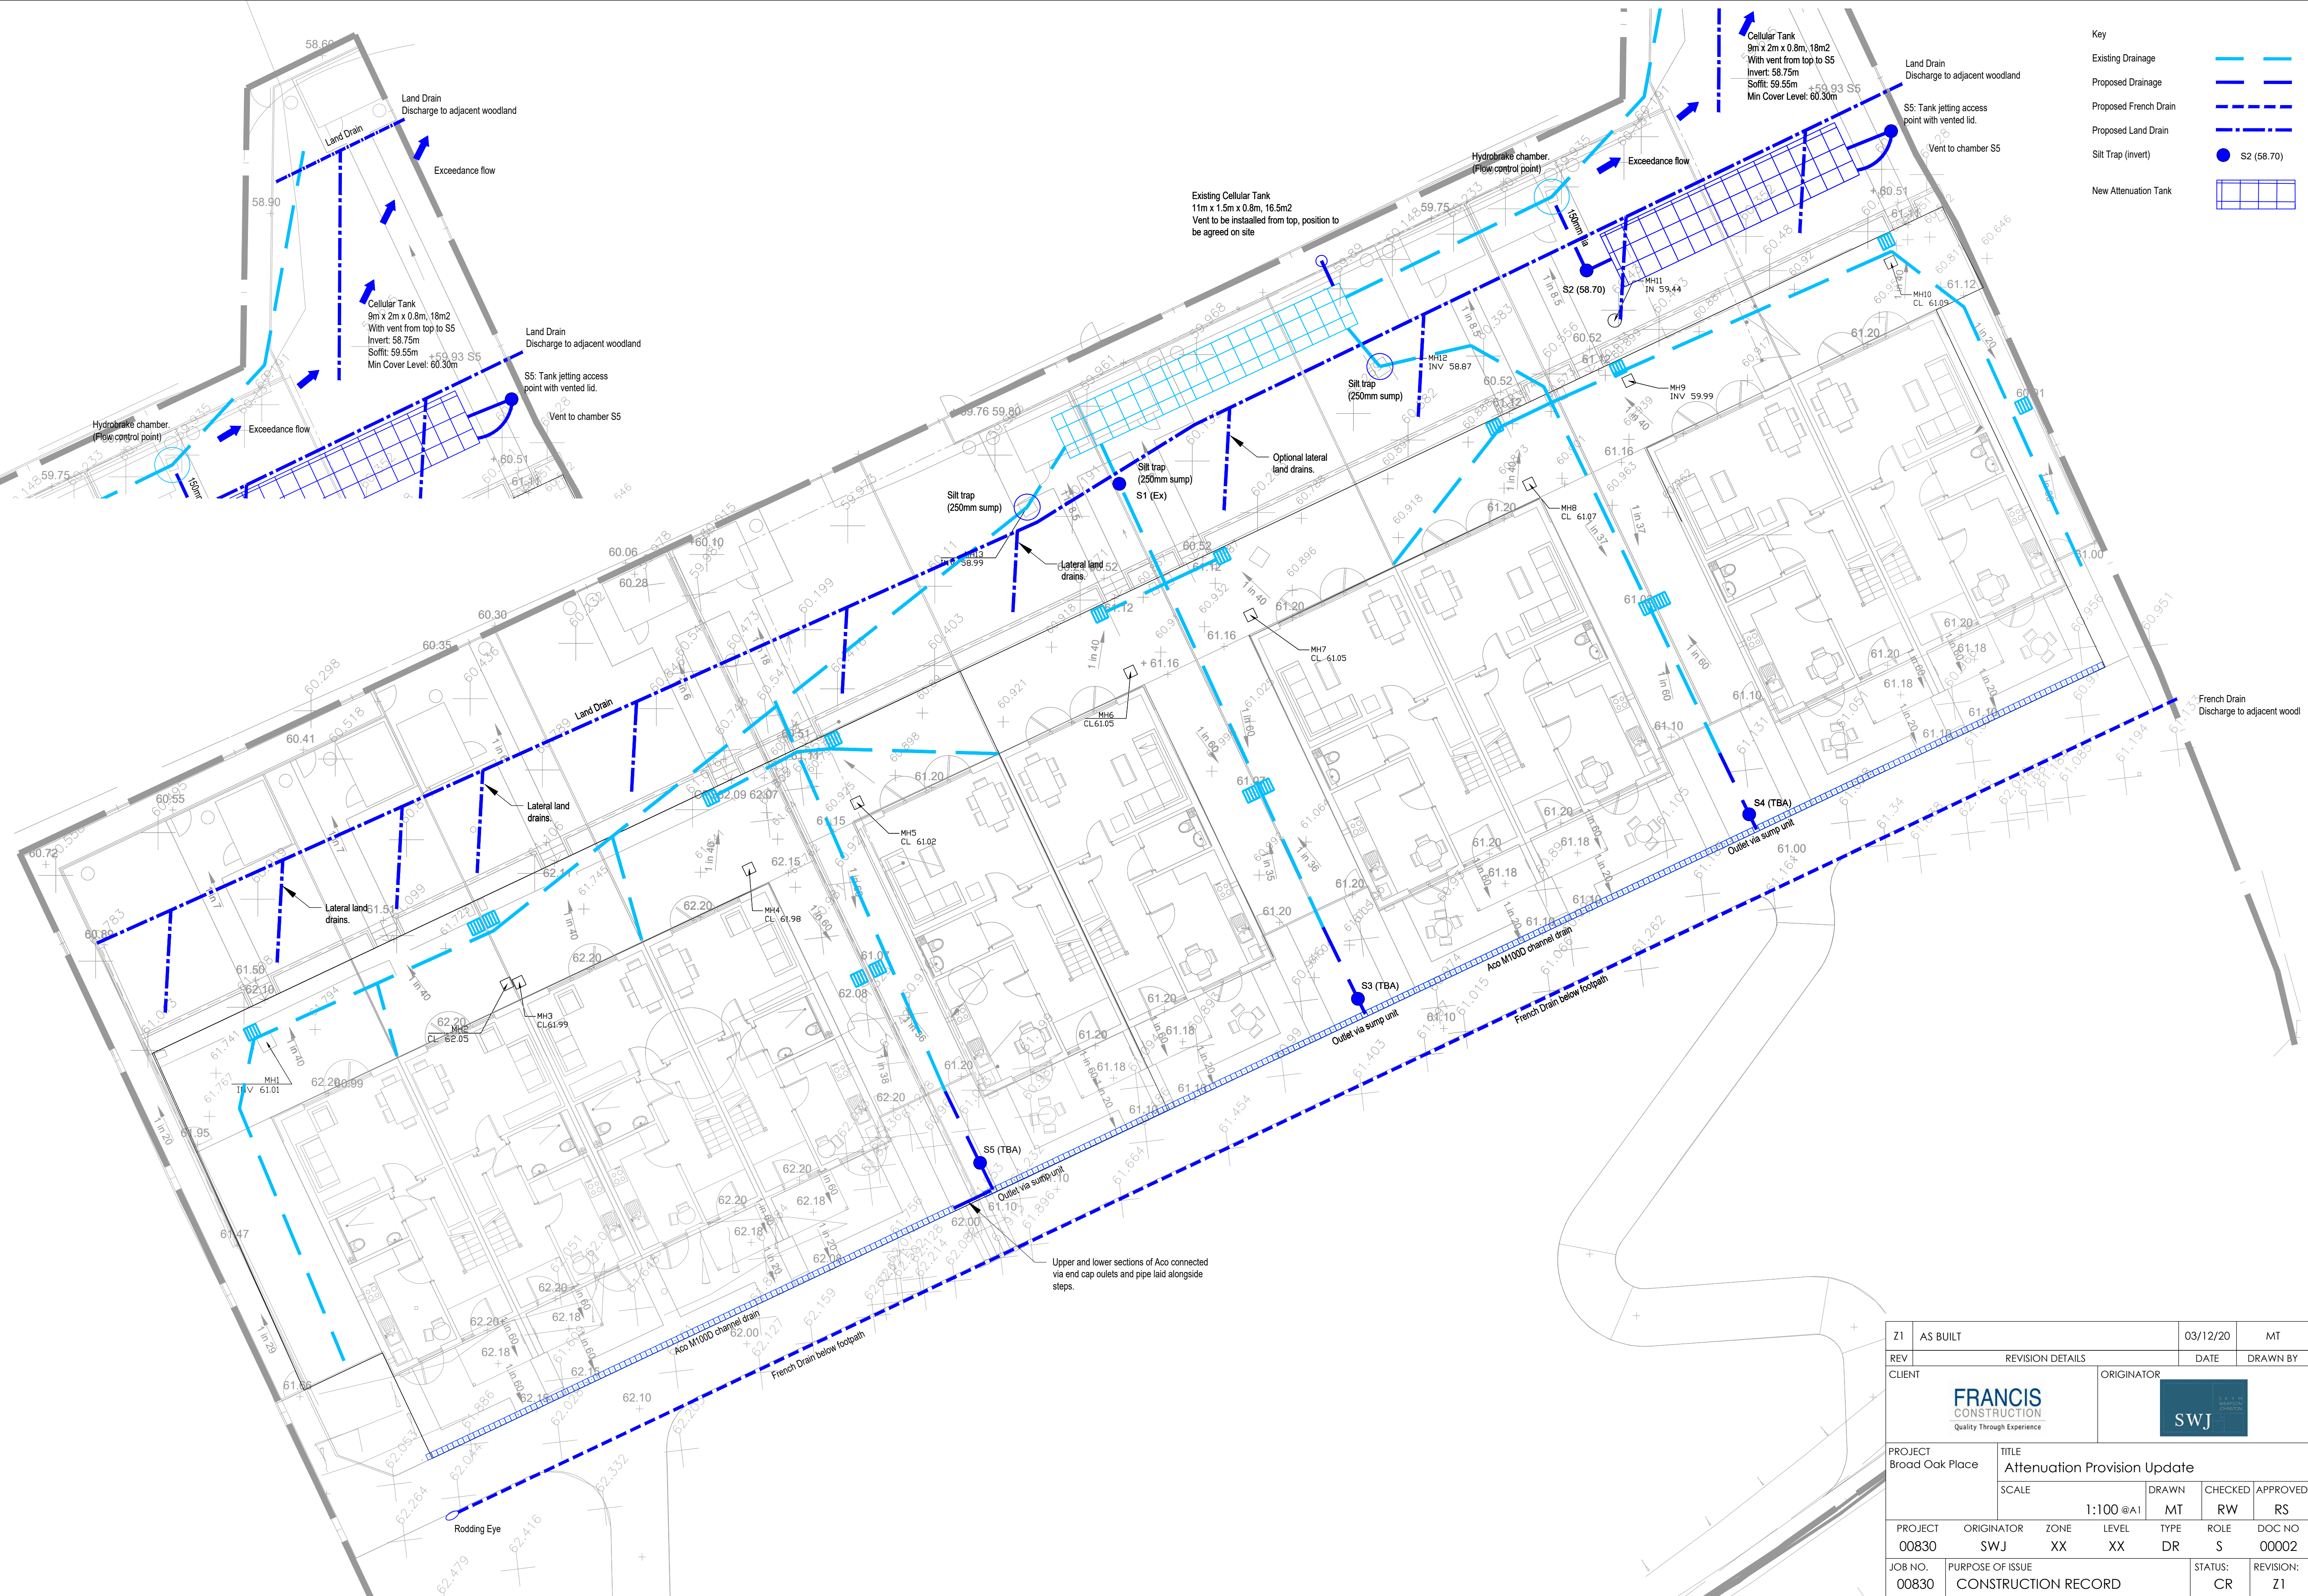

Z1	AS BUILT				03/12/20		MT		
REV	REVISION DETAILS					DATE		DRAWN BY	
CLIENT					ORIGINATOR				
FRANCIS CONSTRUCTION Quality Through Experience					SWJ				
PROJECT Broad Oak Place		TITLE Attenuation Provision Update							
		SCALE 1:100 @A1		DRAWN MT		CHECKED RW		APPROVED RS	
PROJECT 00830	ORIGINATOR SWJ	ZONE XX	LEVEL XX	TYPE DR	ROLE S	DOC NO 00002			
JOB NO. 00830	PURPOSE OF ISSUE CONSTRUCTION RECORD				STATUS: CR		REVISION: Z1		