


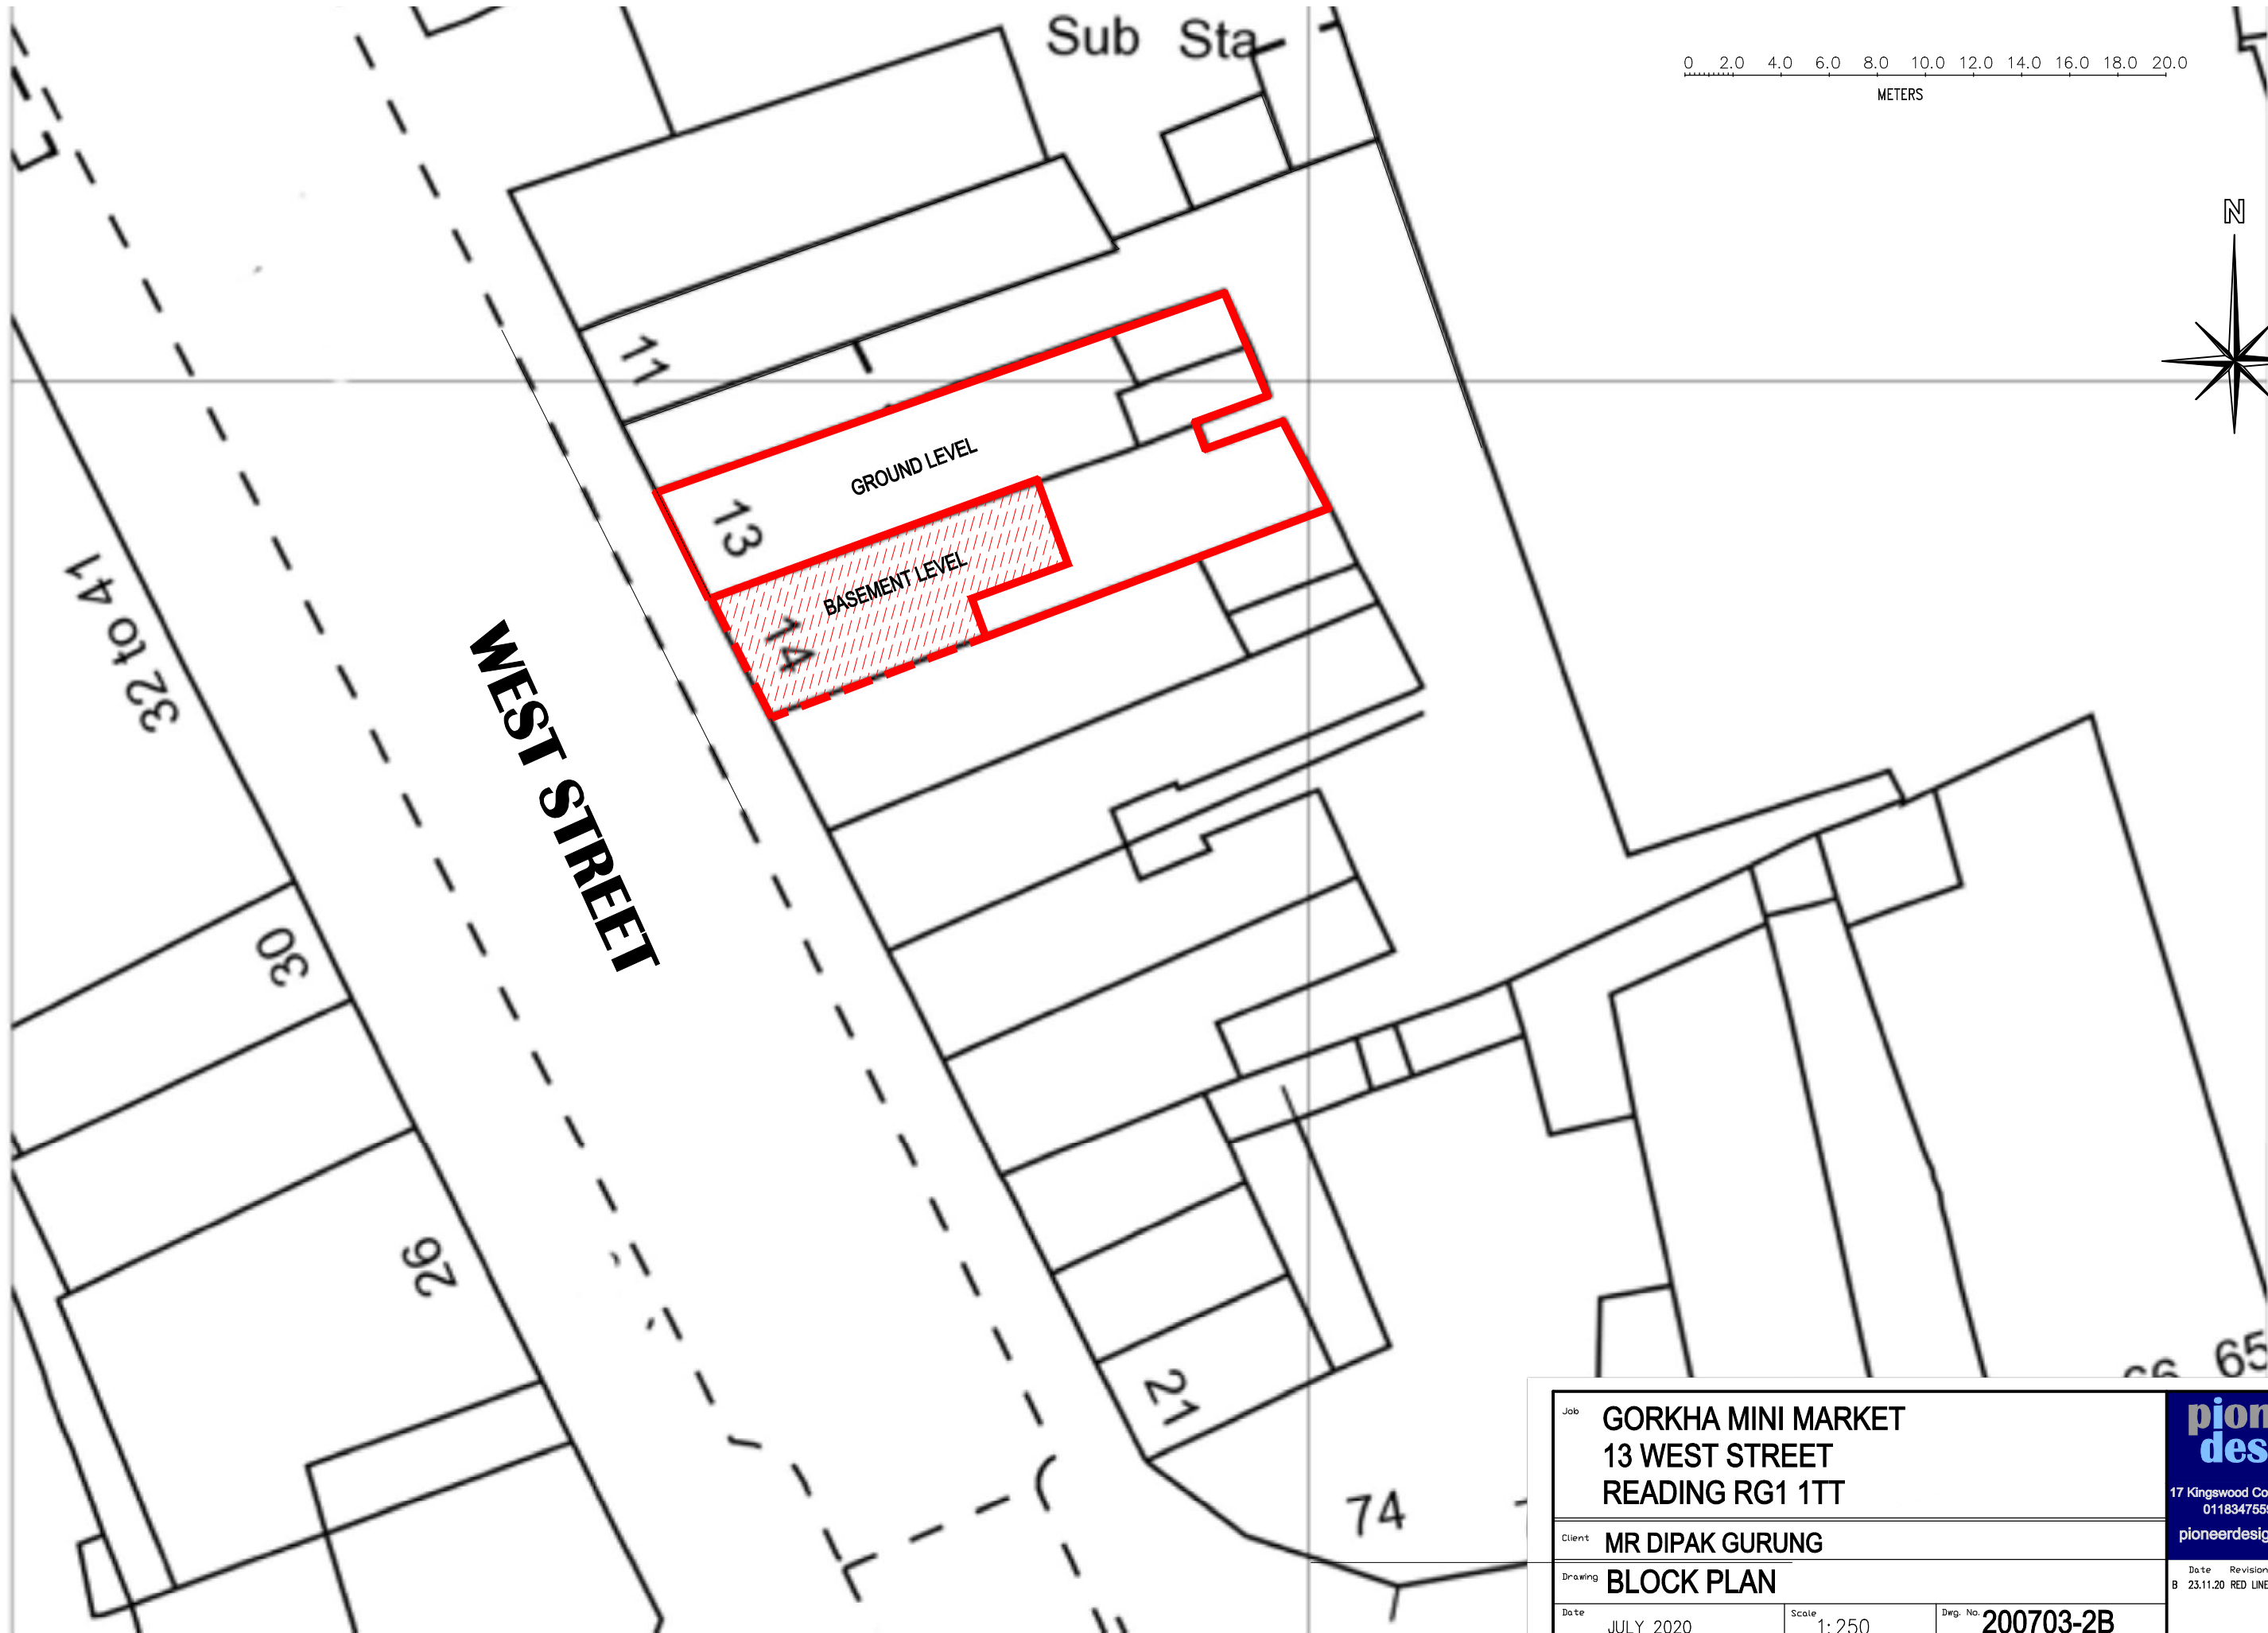

Job GORKHA MINI MARKET 13 WEST STREET READING RG1 1TT			pioneer designs ltd	
Client MR DIPAK GURUNG			17 Kingswood Court, Reading RG30 2AU 01183475590 / 07725338742 pioneerdesignsltd@gmail.com	
Drawing BLOCK PLAN			Date Revisions B 23.11.20 RED LINE MODIFIED	
Date JULY 2020	Scale 1:250	Dwg. No. 200703-2B		