


SITE LAYOUT PLAN - AS BUILT
1:250@A3

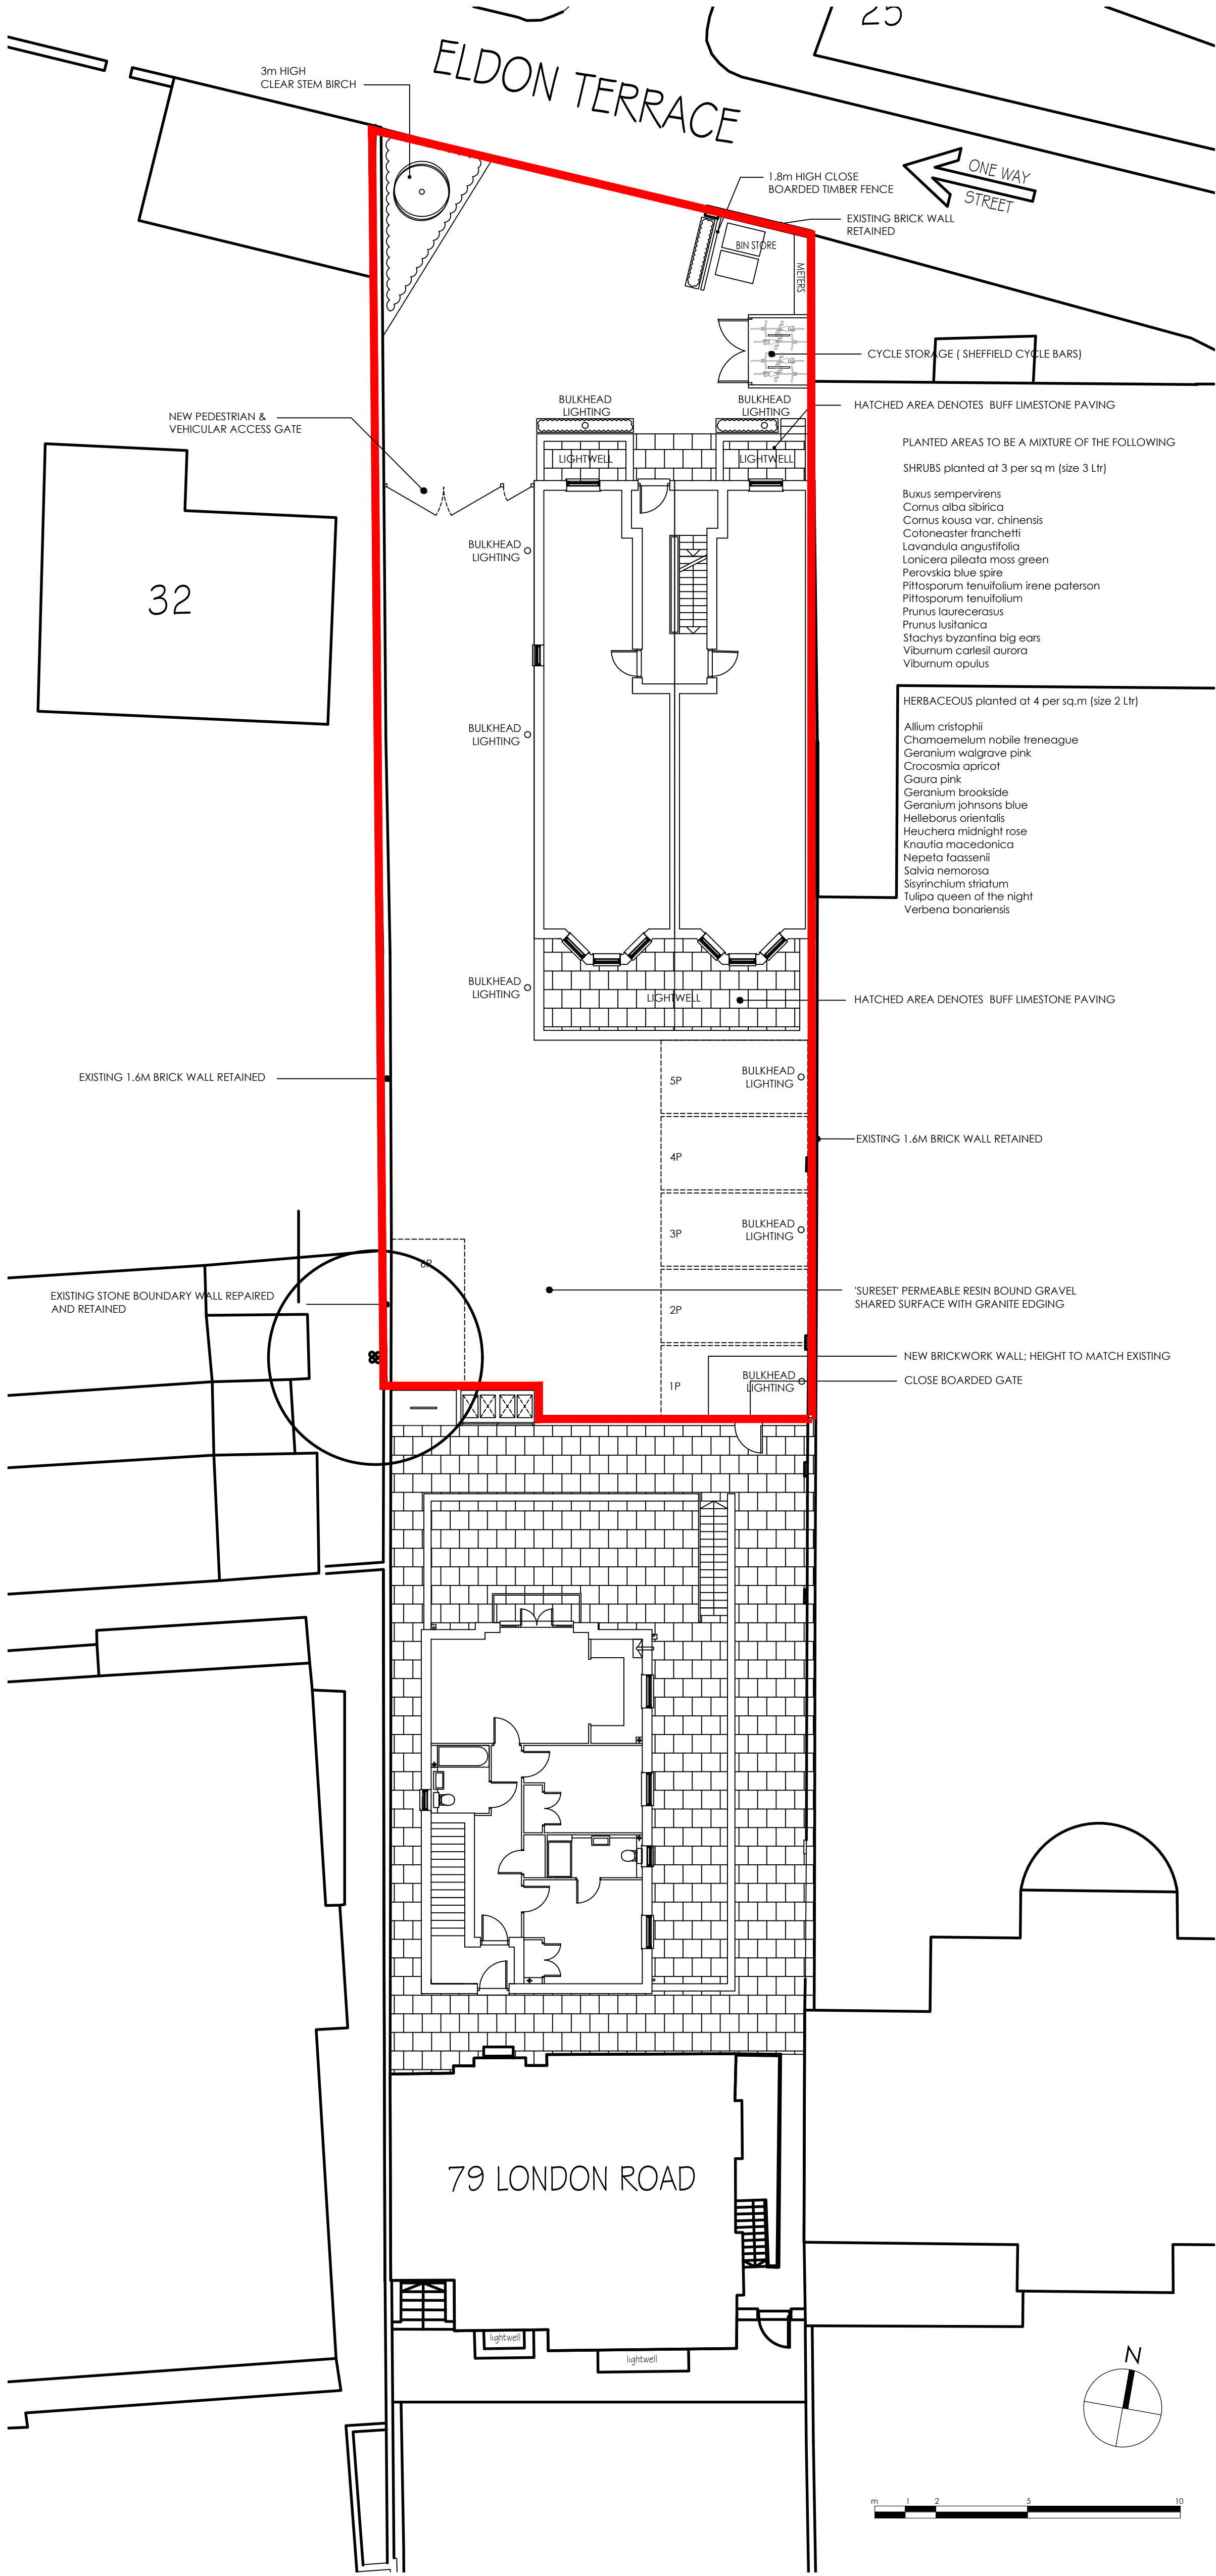

Do not scale from this drawing, all dimensions to be checked on site. All drawings subject to Statutory Authority Approval. This drawing is protected under Copyright and no line should any portion of this drawing be reproduced or copied without the permission of the Architect. (Design Copyright Act 1988) The drawings must not be used for purposes other than that for which it is provided. It is supplied without liability for any errors or omissions.										notes:									
status: PLANNING										no: rev: date:									
Spence ARCHITECTS 201 Abchurch Buildings 61 Grogan Road London SE1 3BD Tel : + 4 4 (0) 7 5 9 5 5 4 7 5 0 4 o c c o r n @ s p e n c e a r c h i t e c t s . c o . u k date: 10.01.19 scale: 1:250@A3										drawing title: dwg no: project: SITE LAYOUT PLAN - AS BUILT 1522-PR-201 34 ELDON TERRACE READING RG1 4DX rev no: 0									