



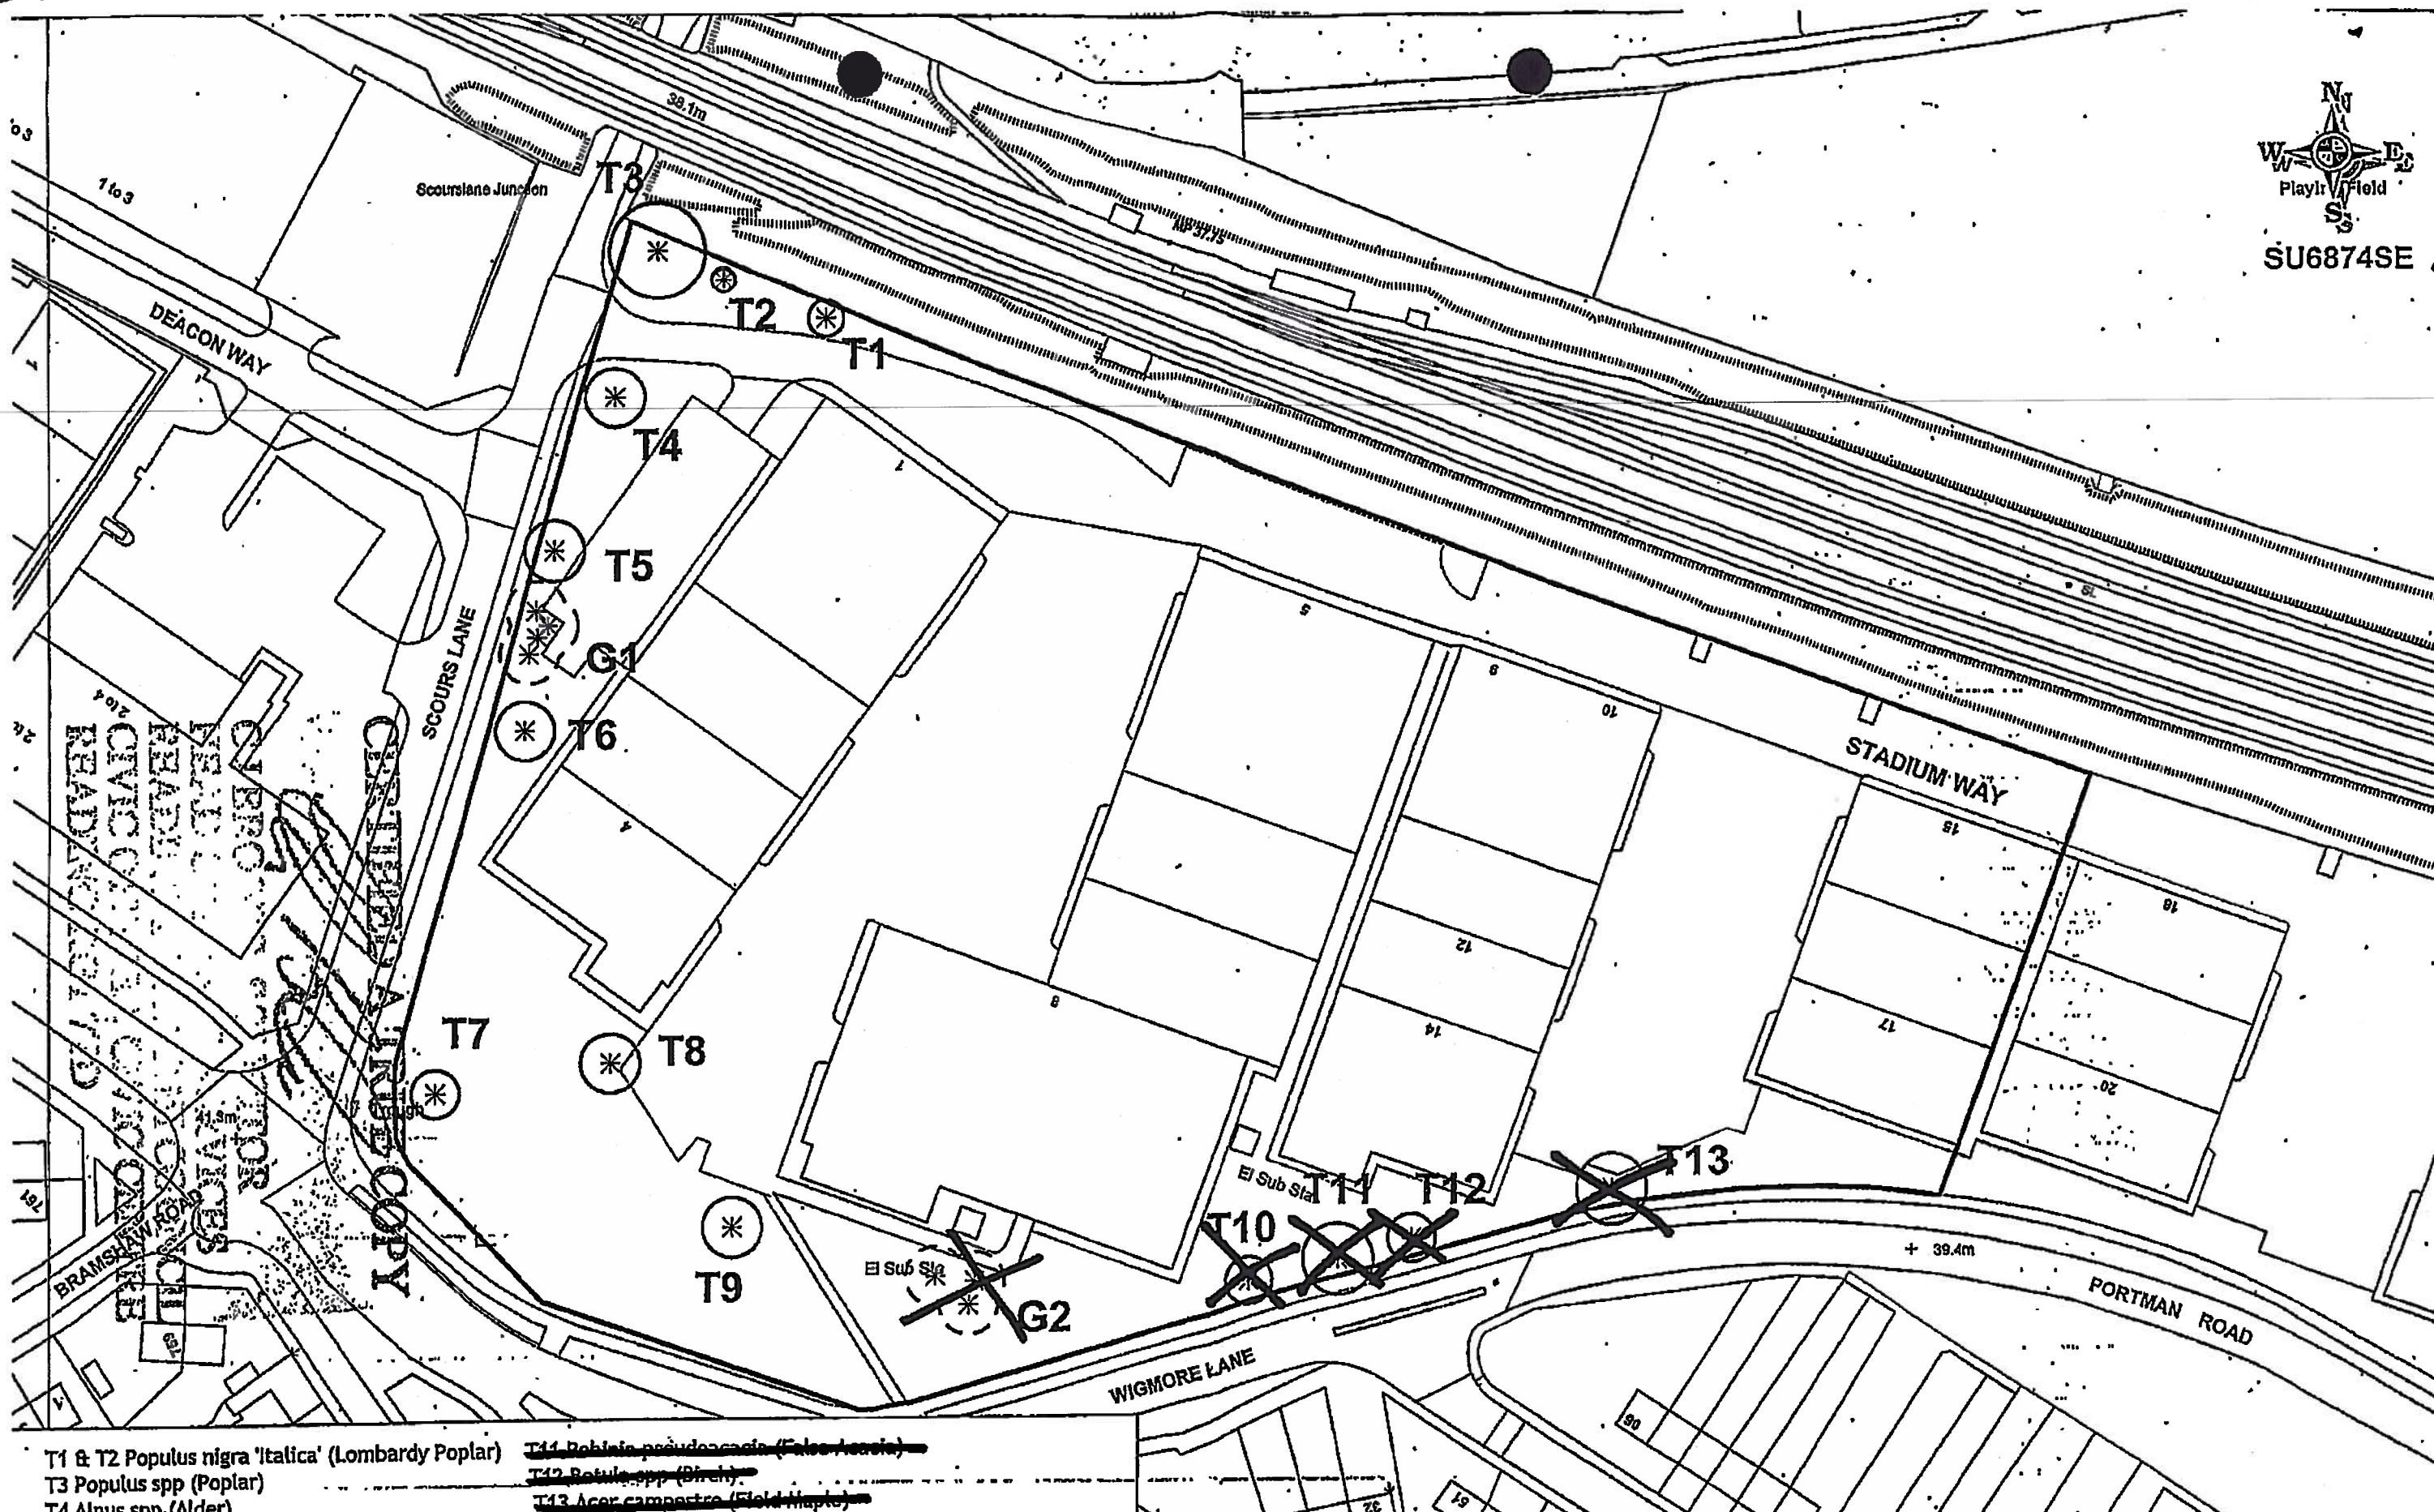

- T1 & T2 Populus nigra 'Italica' (Lombardy Poplar)
- T3 Populus spp (Poplar)
- T4 Alnus spp. (Alder)
- T5 Pinus sylvestris (Scots Pine)
- T6 Pinus spp (Pine)
- T7 Platanus spp (Plane)
- T8 Cupressus leylandii (Leyland Cypress)
- T9 Cedrus atlantica Glauca (Blue Atlas Cedar)
- ~~T10 Cupressus lusitanica (Mediterranean Cypress)~~

- ~~T11 Robinia pseudoacacia (False Acacia)~~
- ~~T12 Betula spp (Birch)~~
- ~~T13 Acer campestre (Field Maple)~~
- G1 4 no. Cupressus leylandii (Leyland Cypress)
- ~~G2 2 no. Acer platanoides (Norway Maple)~~

TITLE		TREE PRESERVATION ORDER: STADIUM WAY INDUSTRIAL ESTATE, STADIUM WAY, READING	
DRG NO	D1904	DATE	OCT 2010
DRAWN BY	KR	SCALE	1:1000
© Crown Copyright. All Rights Reserved. Reading Borough Council. Account Number 100018672			

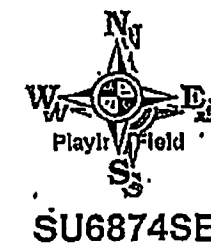

Reading
BOROUGH COUNCIL
PLANNING SUPPORT TEAM