



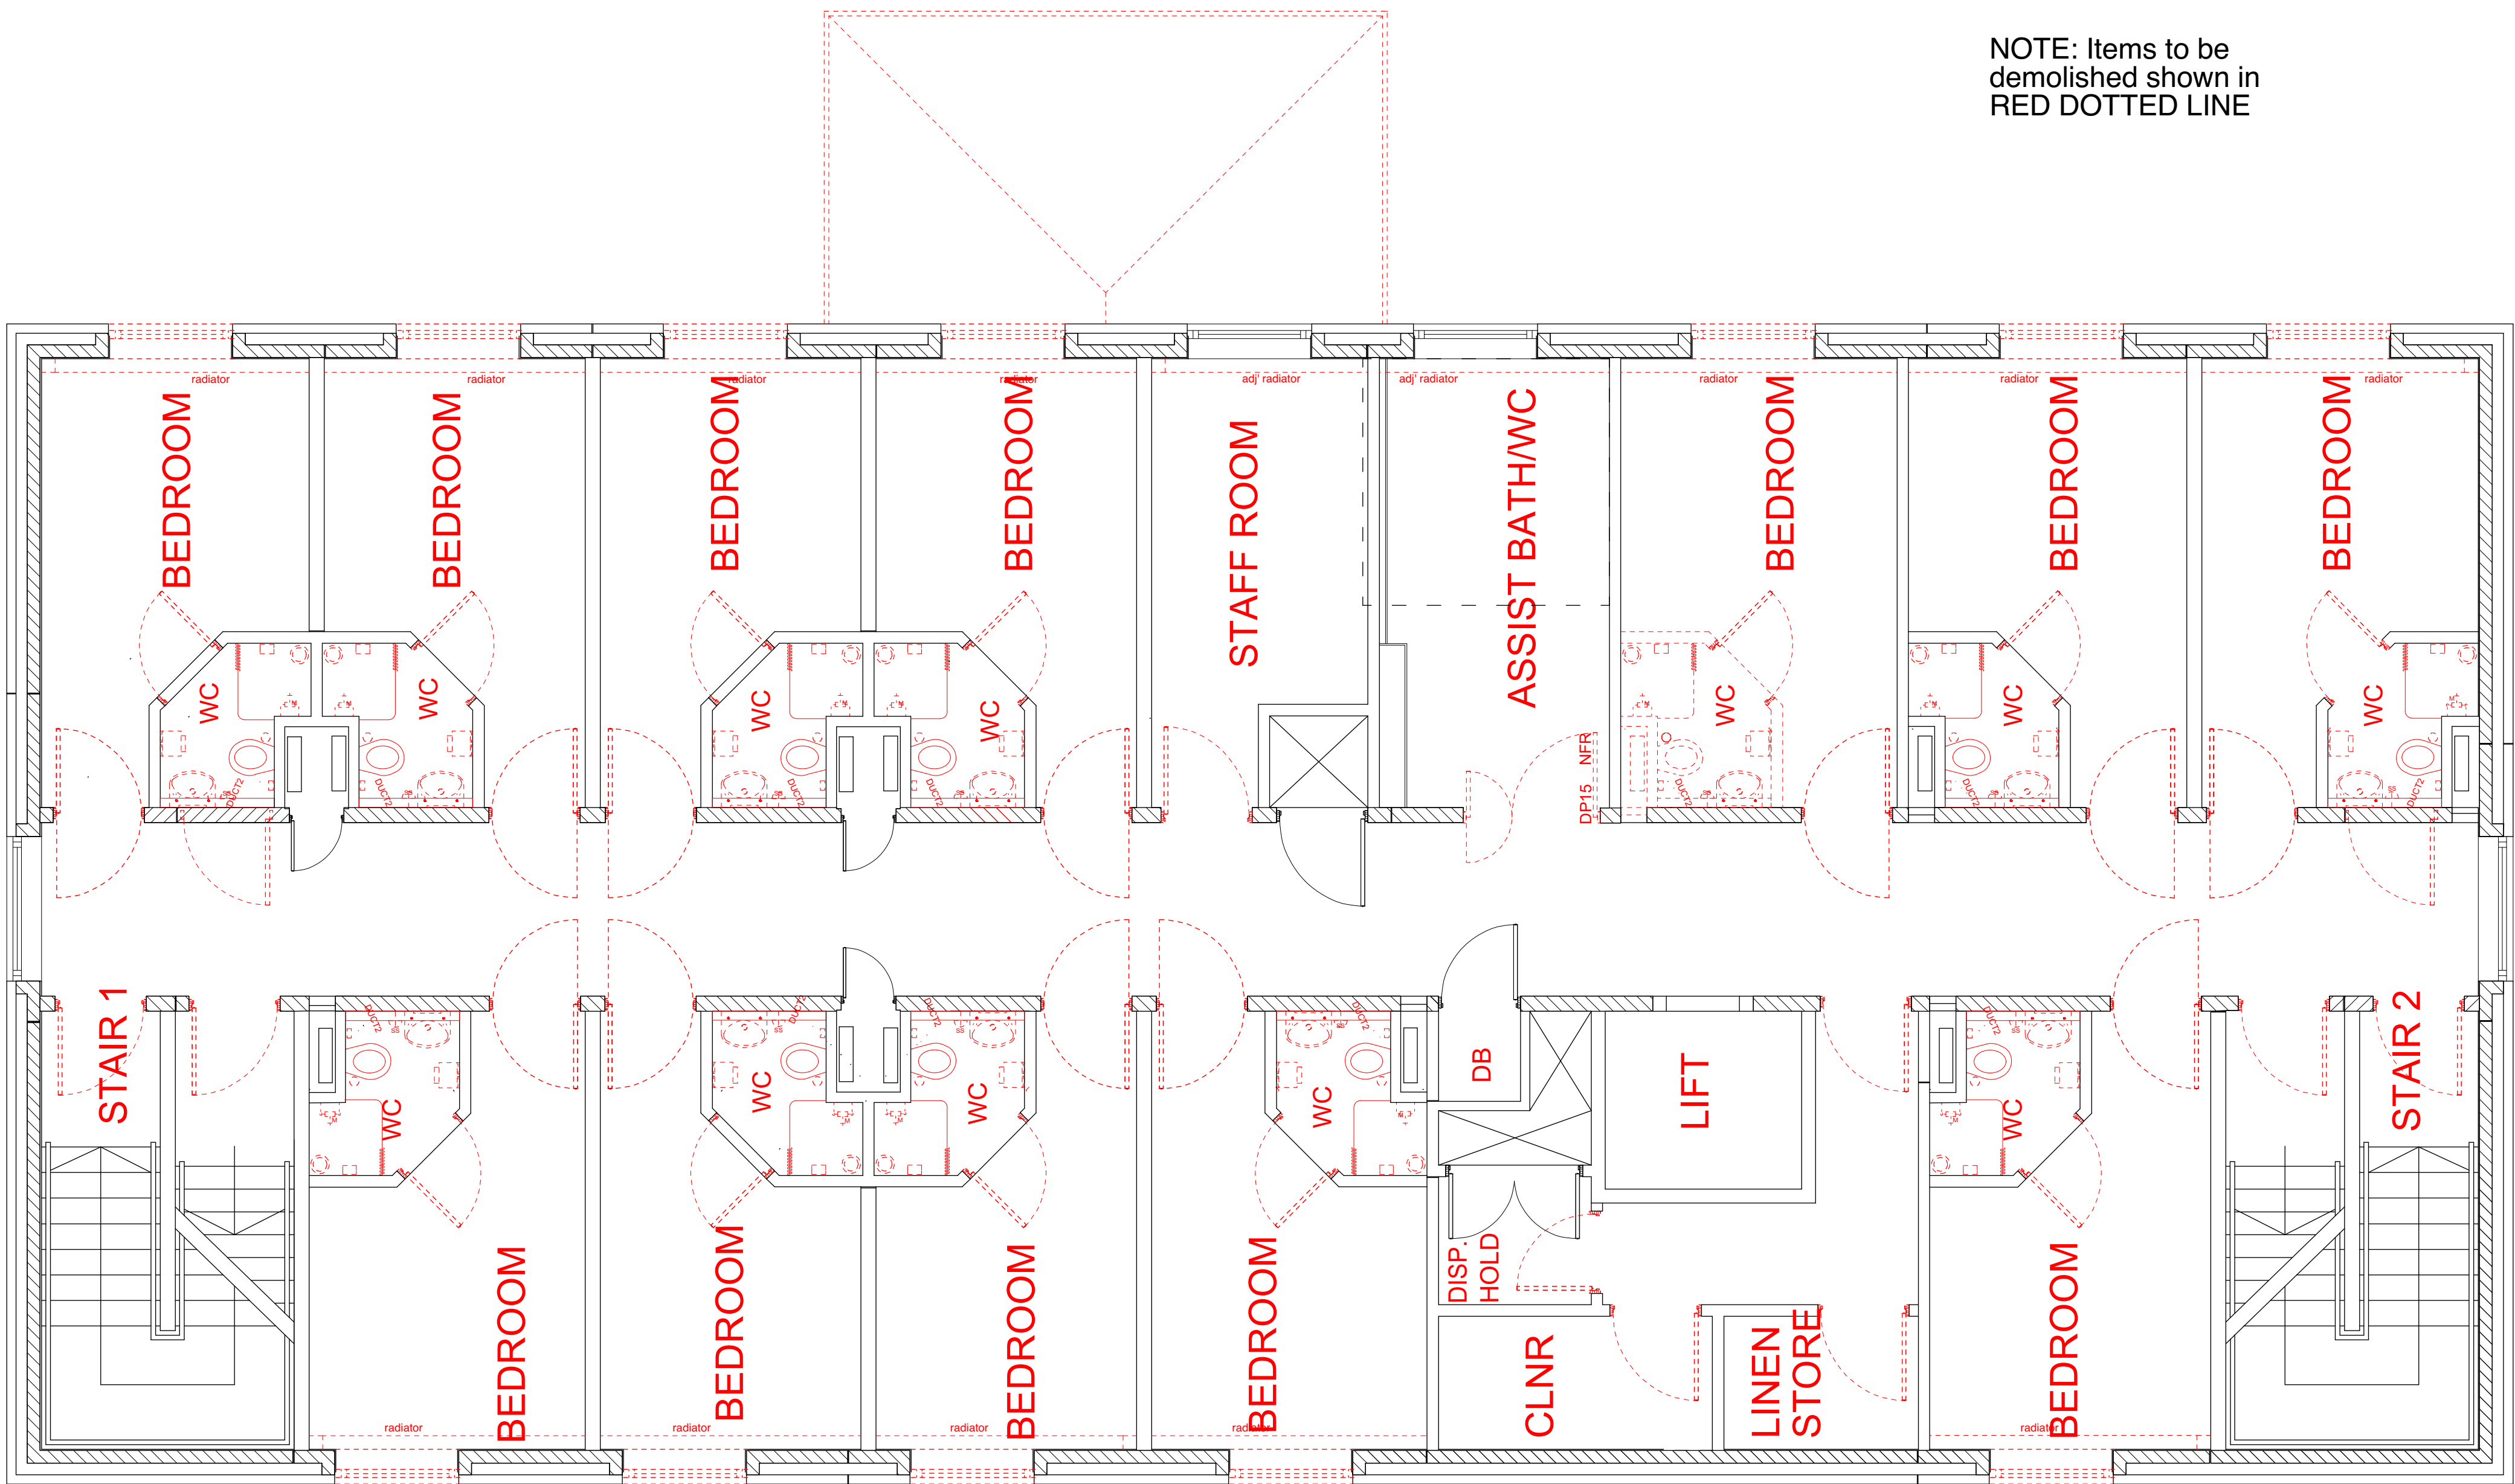

NOTE: Items to be demolished shown in RED DOTTED LINE

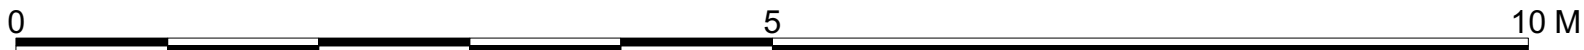

Chartered Architects
Chartered Building Surveyors
Interior Designers
CDM Services

Glentworth Court, Lime Kiln Close
Stoke Gifford, Bristol BS34 8SR
+44 (0)117 931 2082
www.kendallkingscott.co.uk

Project
Campion & Hazelwood
Client
Berkshire Healthcare NHS Foundation
Scale
1:50
Paper Size
A1
Filename
190000 MASTER
© Copyright
Do not scale this drawing

Rev Date By Ap Note

Drawing Title
HW Ex FF / Demo

Project Number
Drawing Number
Revision

190000-504

Date
7/3/19
Drawn
RW
Checked
SW
Status
Planning

One to be used on the site for which designed. The electronic transmission of design information contained in this drawing is carried out entirely at the user's risk and Kendall Kingscott Ltd. will have no liability for any errors or inaccuracies arising therefrom. The production of amended or updated information from the said design information by the user is entirely the responsibility of the user and Kendall Kingscott Ltd. shall have no responsibility in respect thereof whatsoever.