



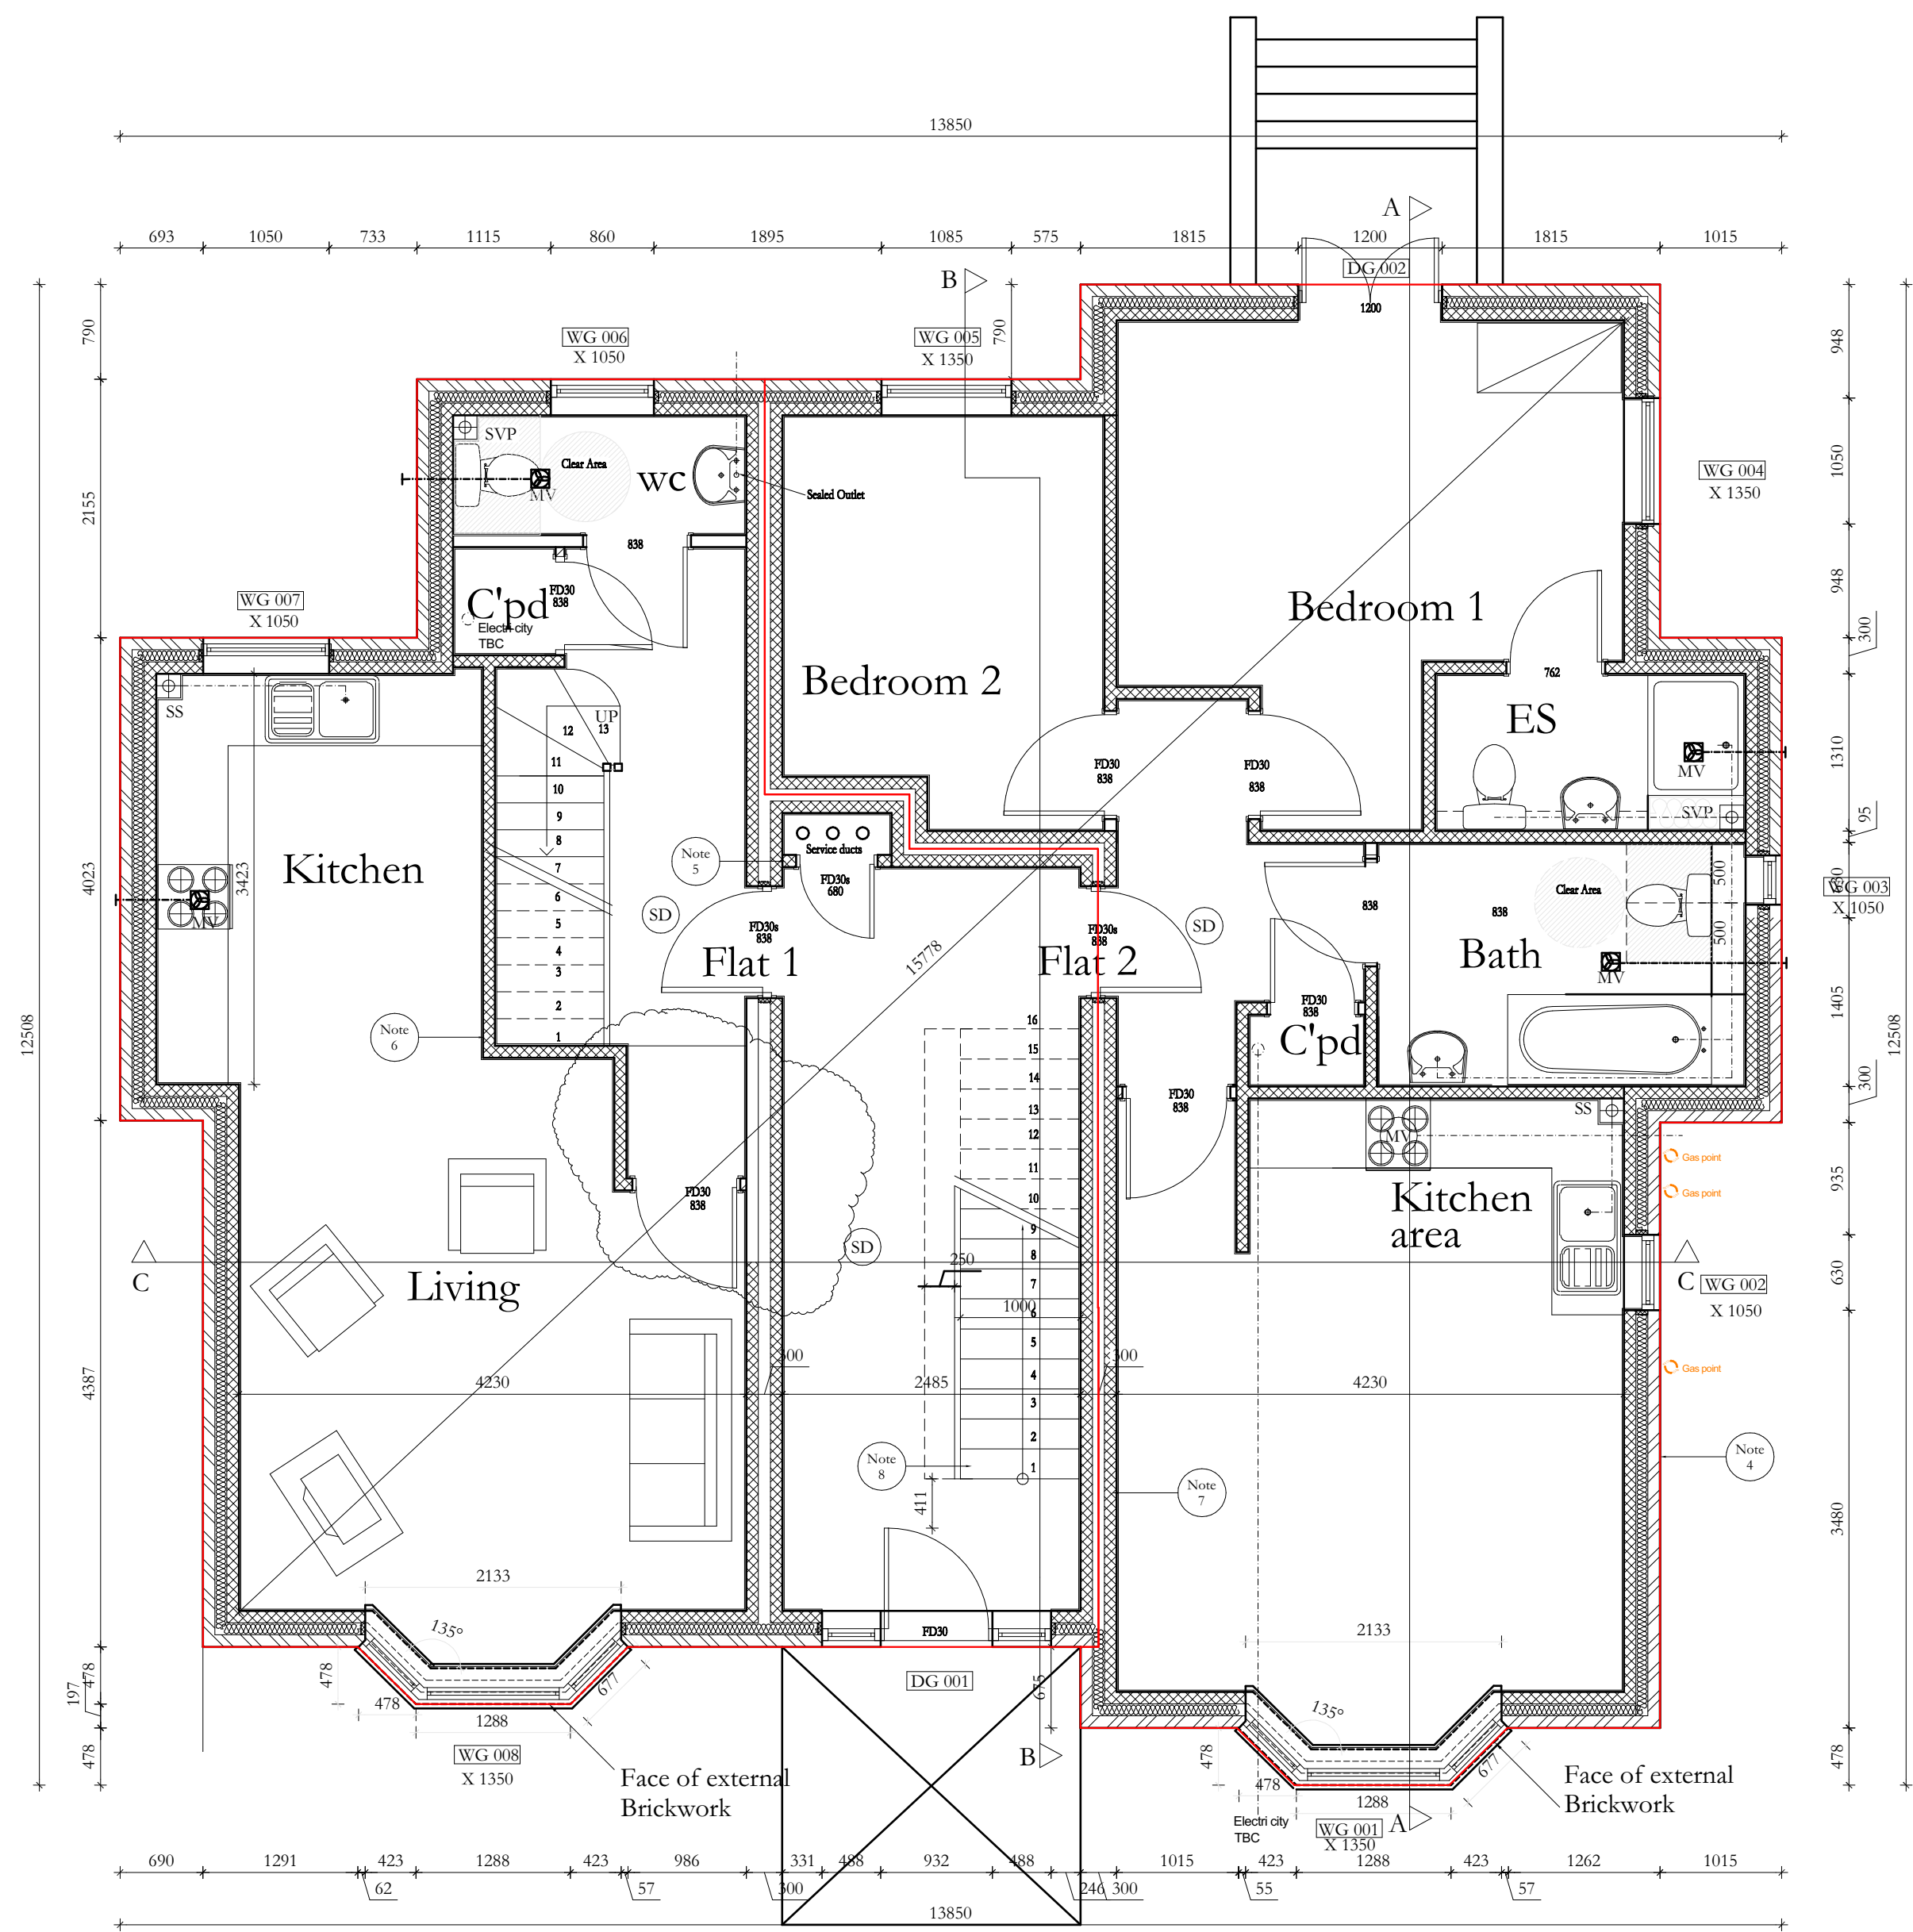

1:50

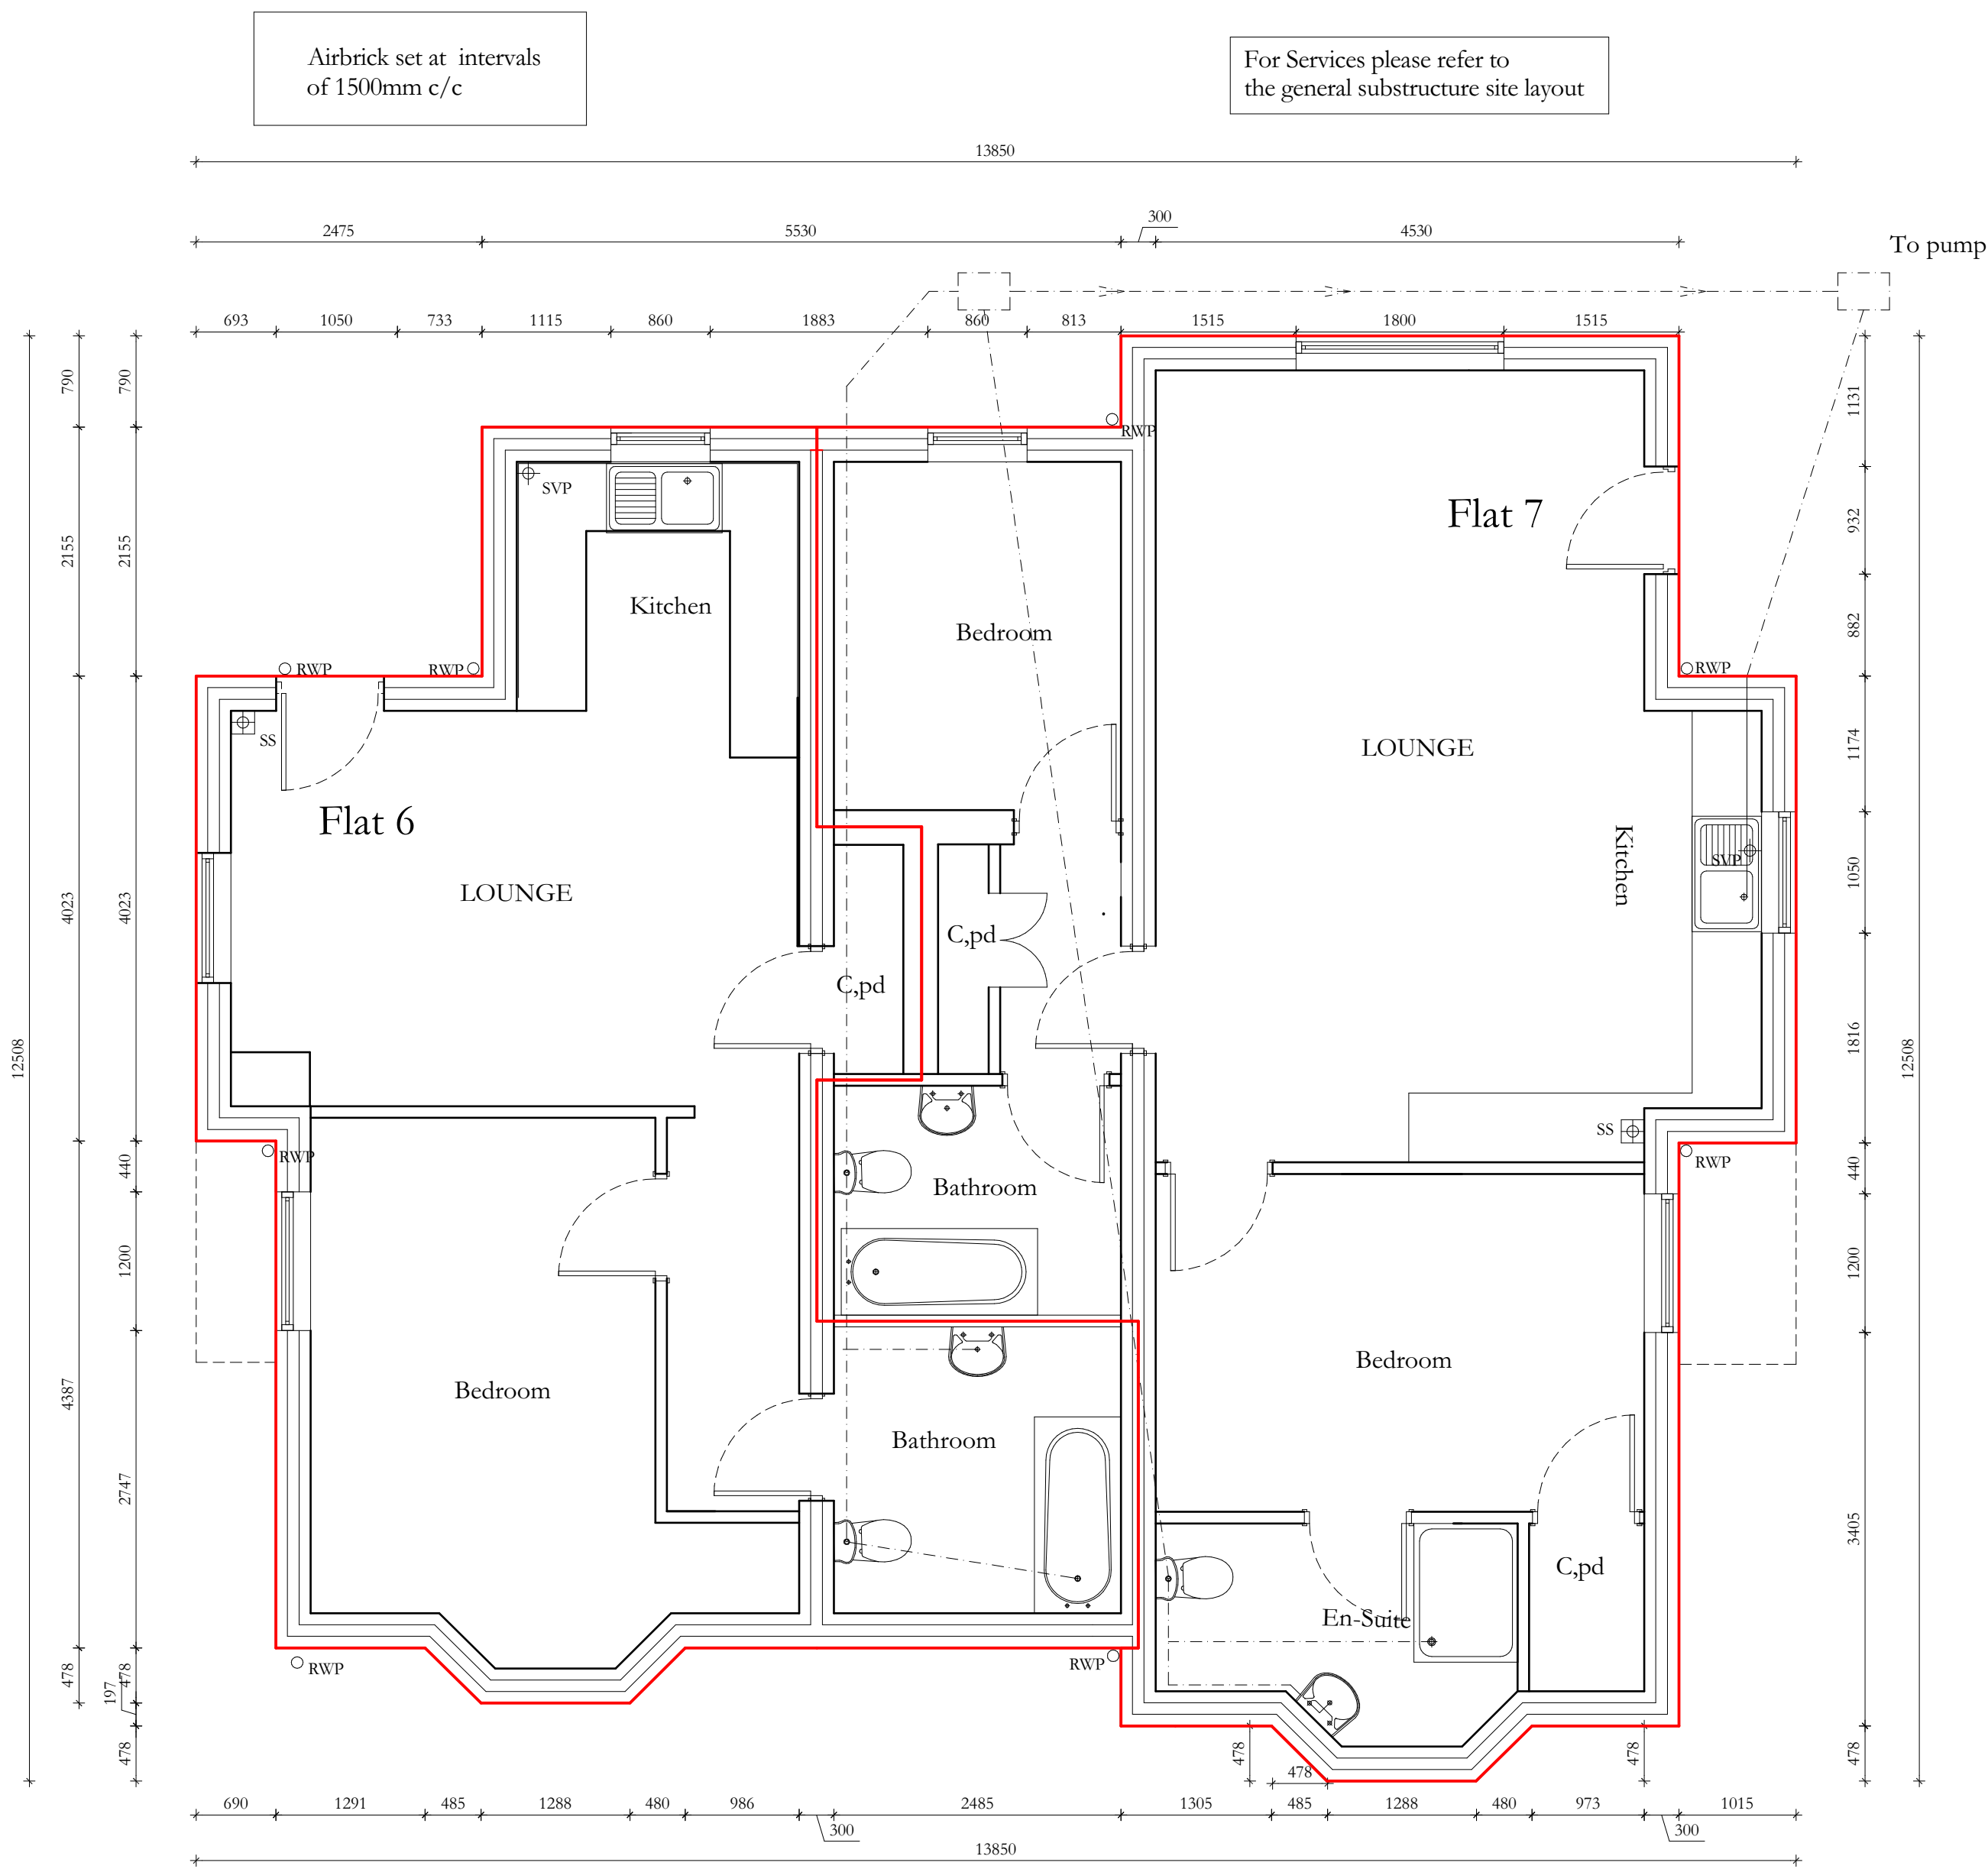

Rev	Comment	By	Date
B	Basement detail added	DM	14-10-2014
A	Stud wall design shown	DM	27-04-2011

THE KEEN PARTNERSHIP

The Courtyard
Edinburgh Road
Reading
RG30 2UA
Tel: 0118 9510 855
Fax: 0118 9510 866
Email: info@keenpartnership.co.uk

Client:
Mr S. Saunders

Job Title:
Development at 27/29
Highgrove Street, Reading
RG1 5EJ

Drawing Title:
Ground & Substructure

Status:
AS BUILT

Date Drawn: 20-12-18
Drawn By: CP
Scale: 1:50 @ A1

Job No: 7932
Drg No: 7932-AS-04
Rev: B