

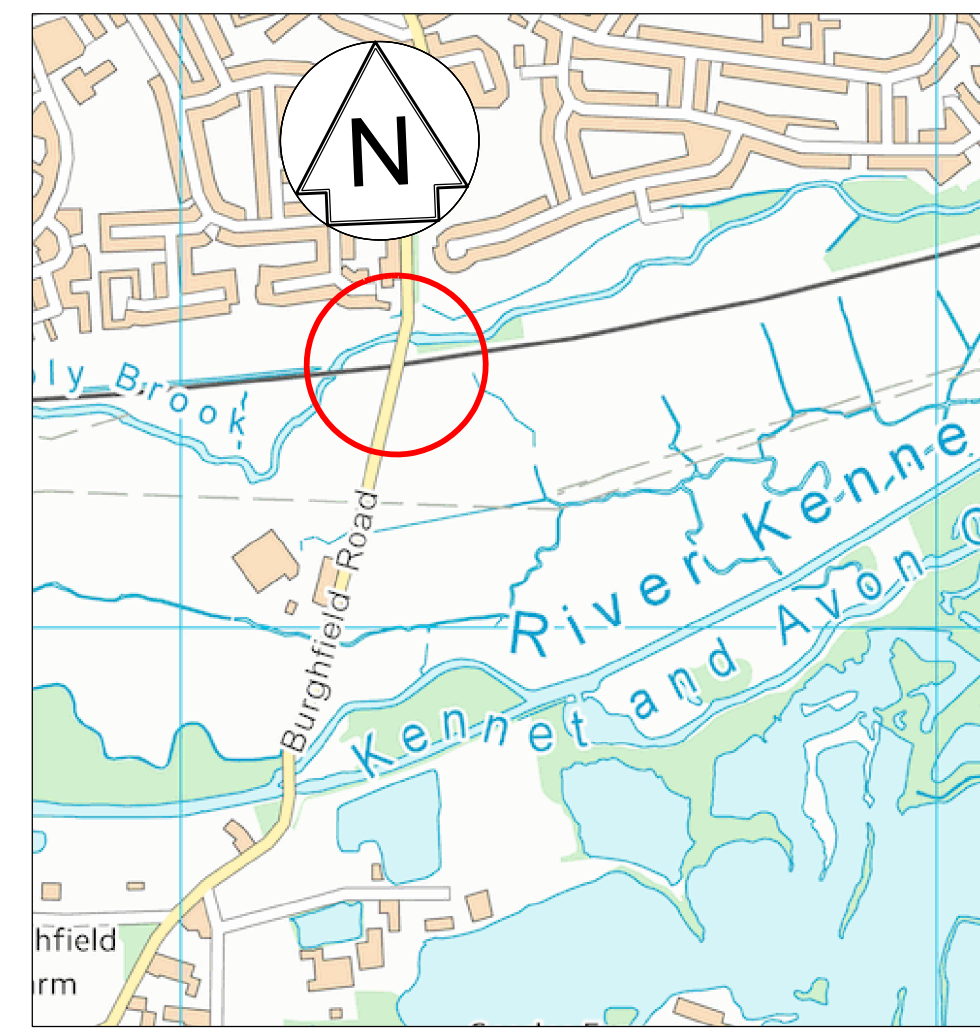
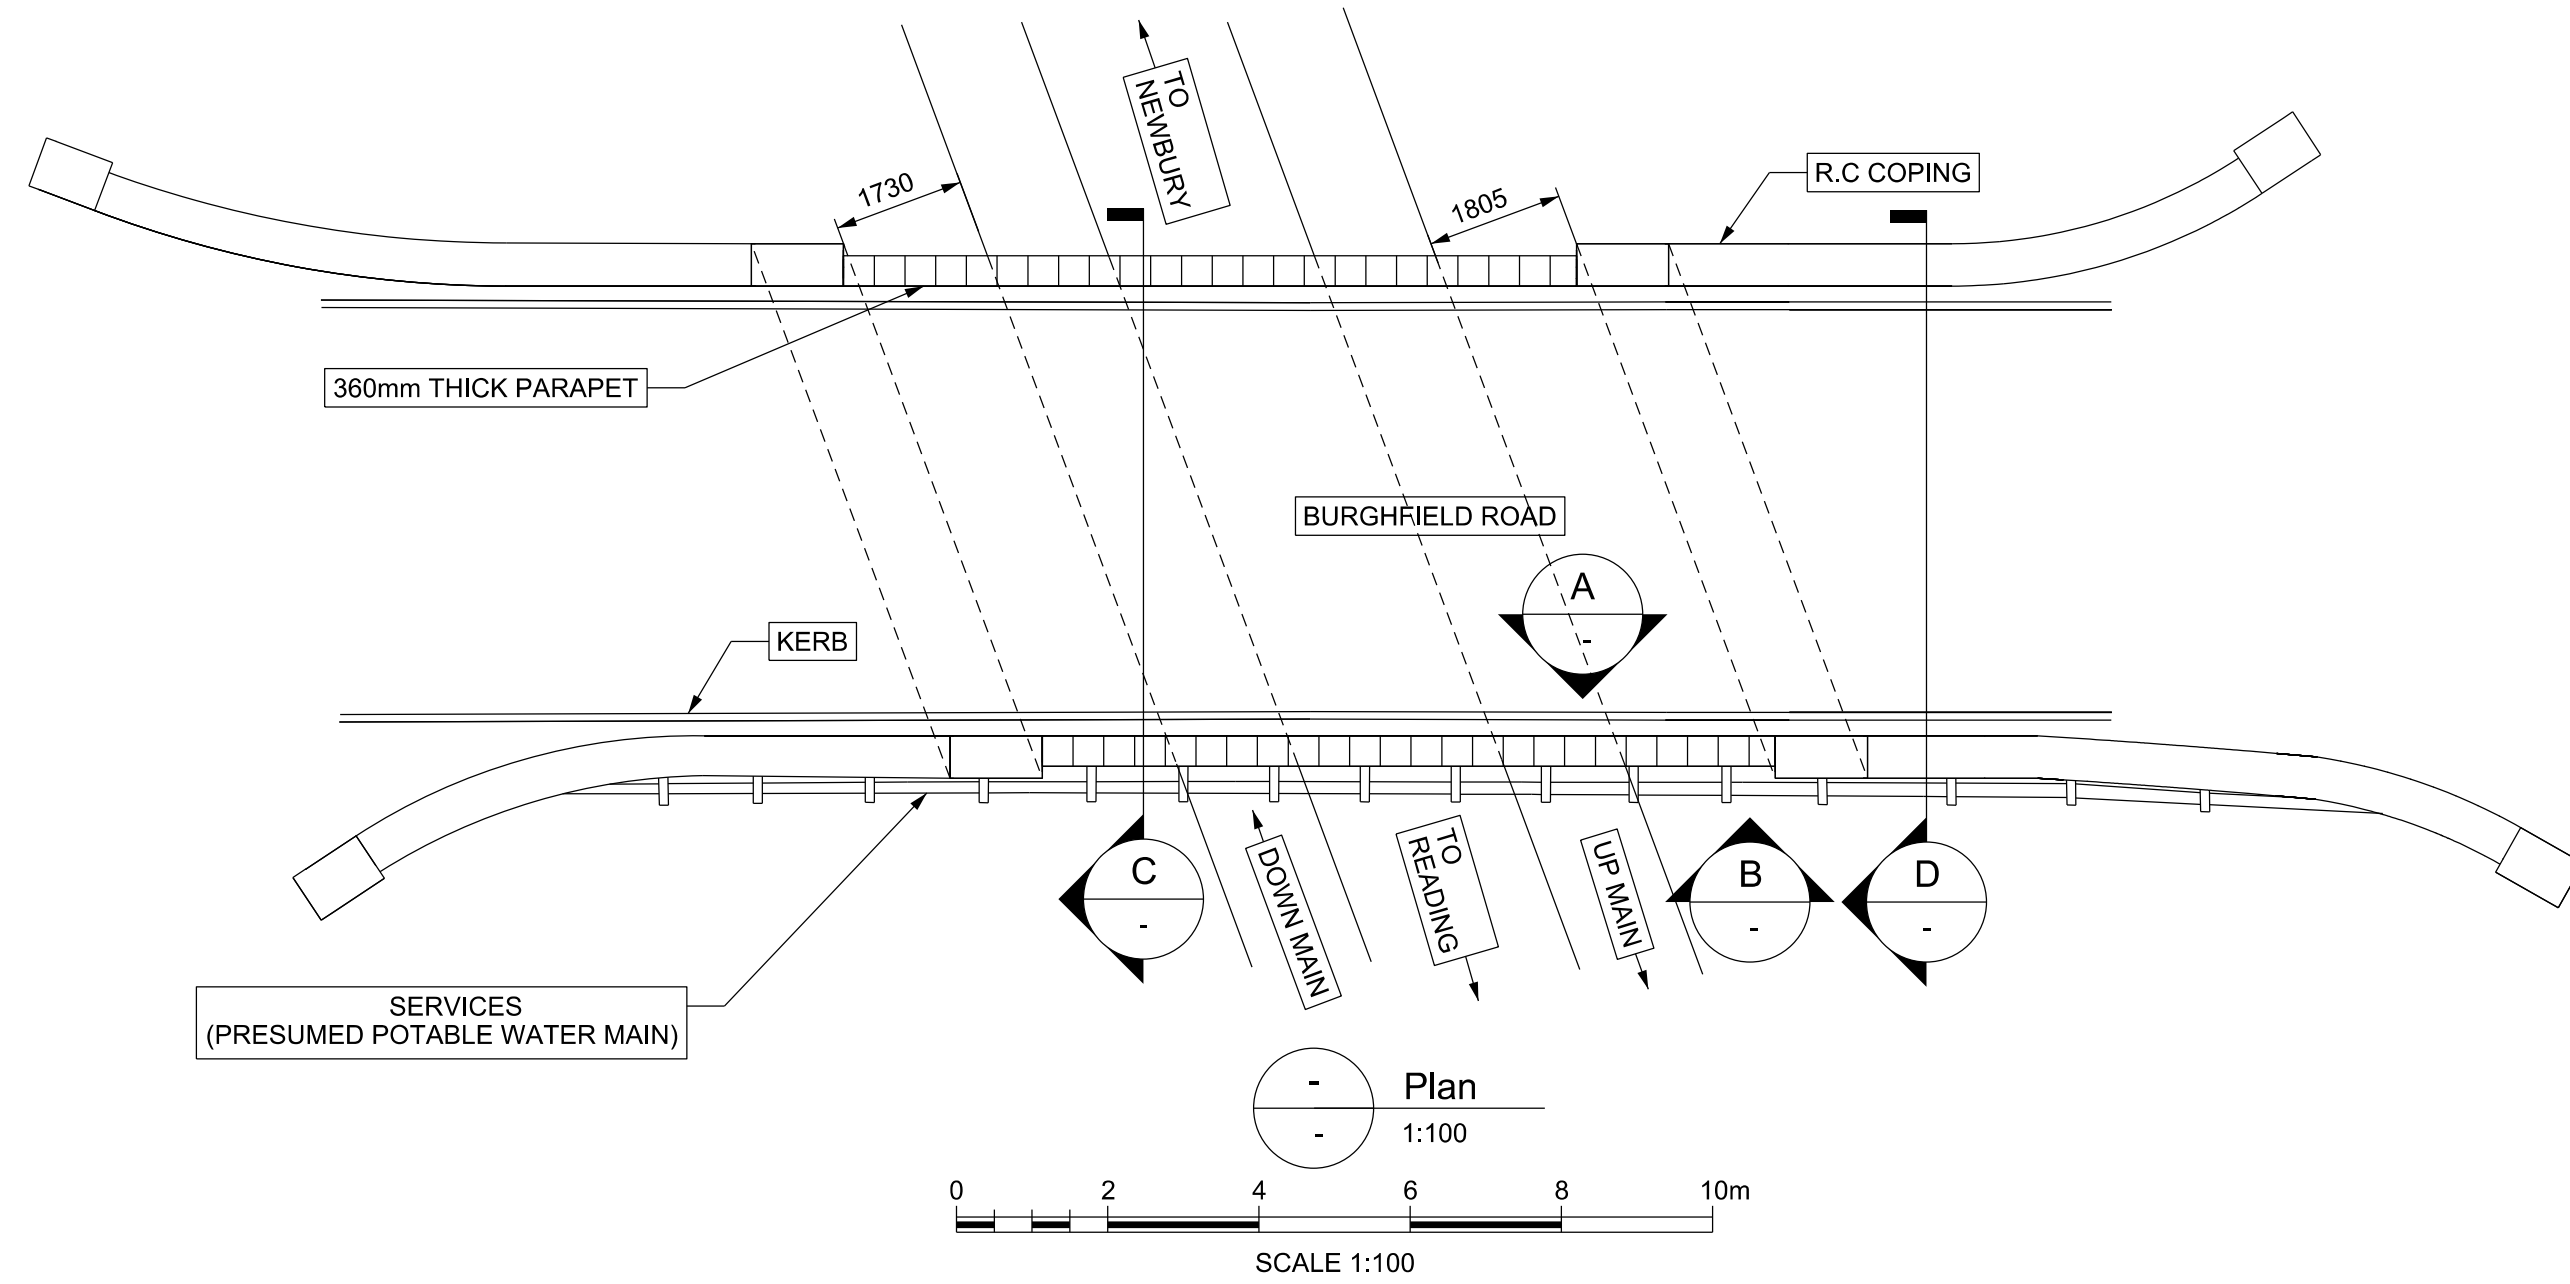
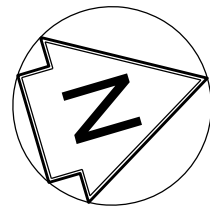
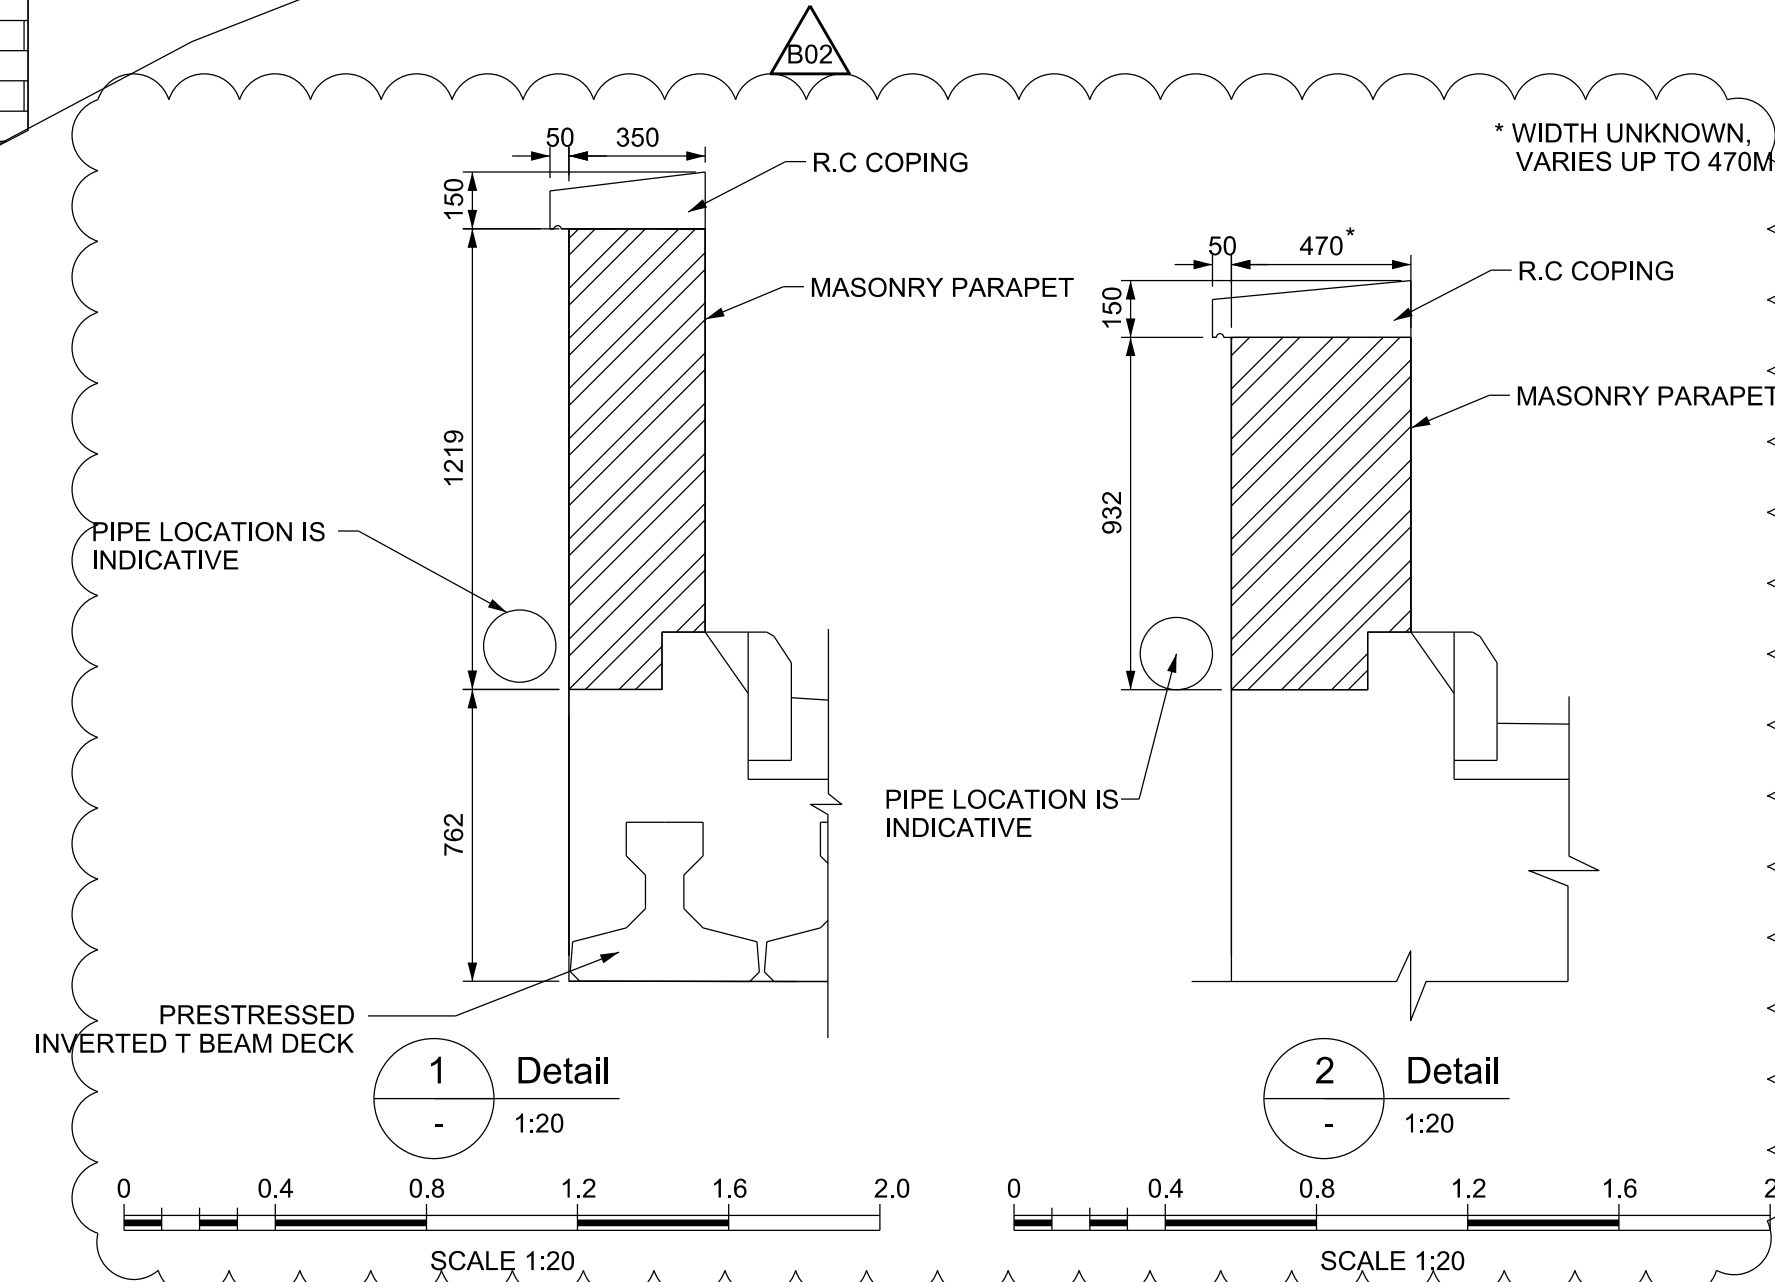
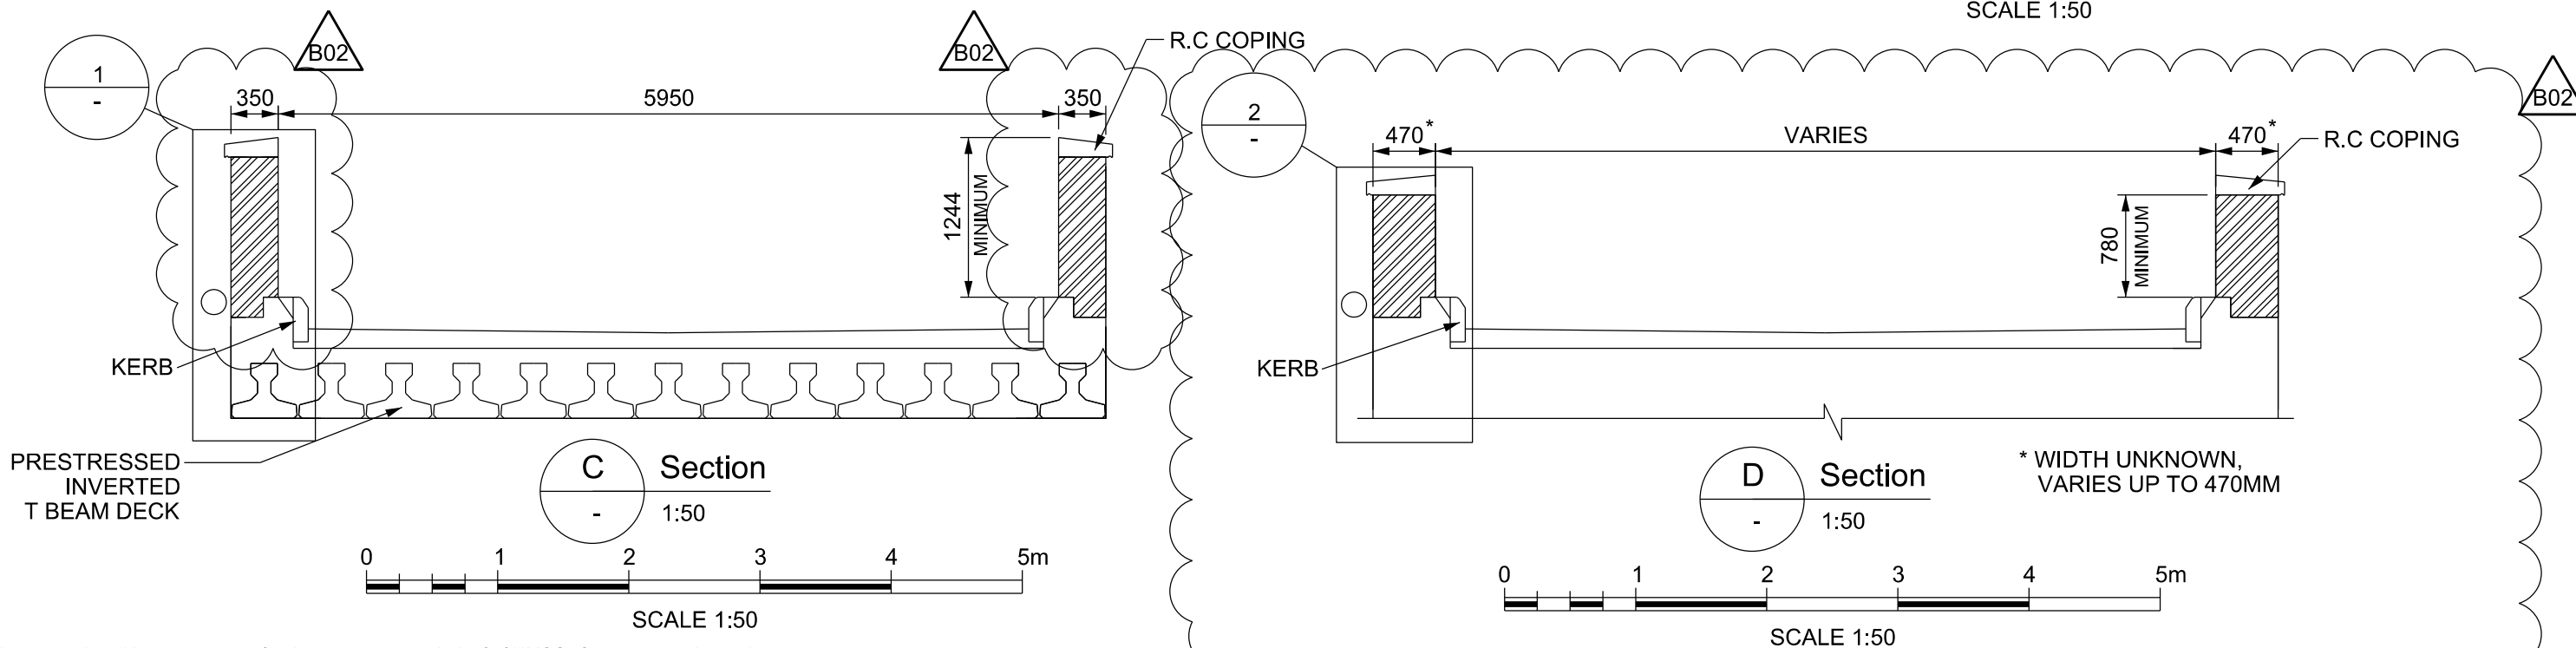


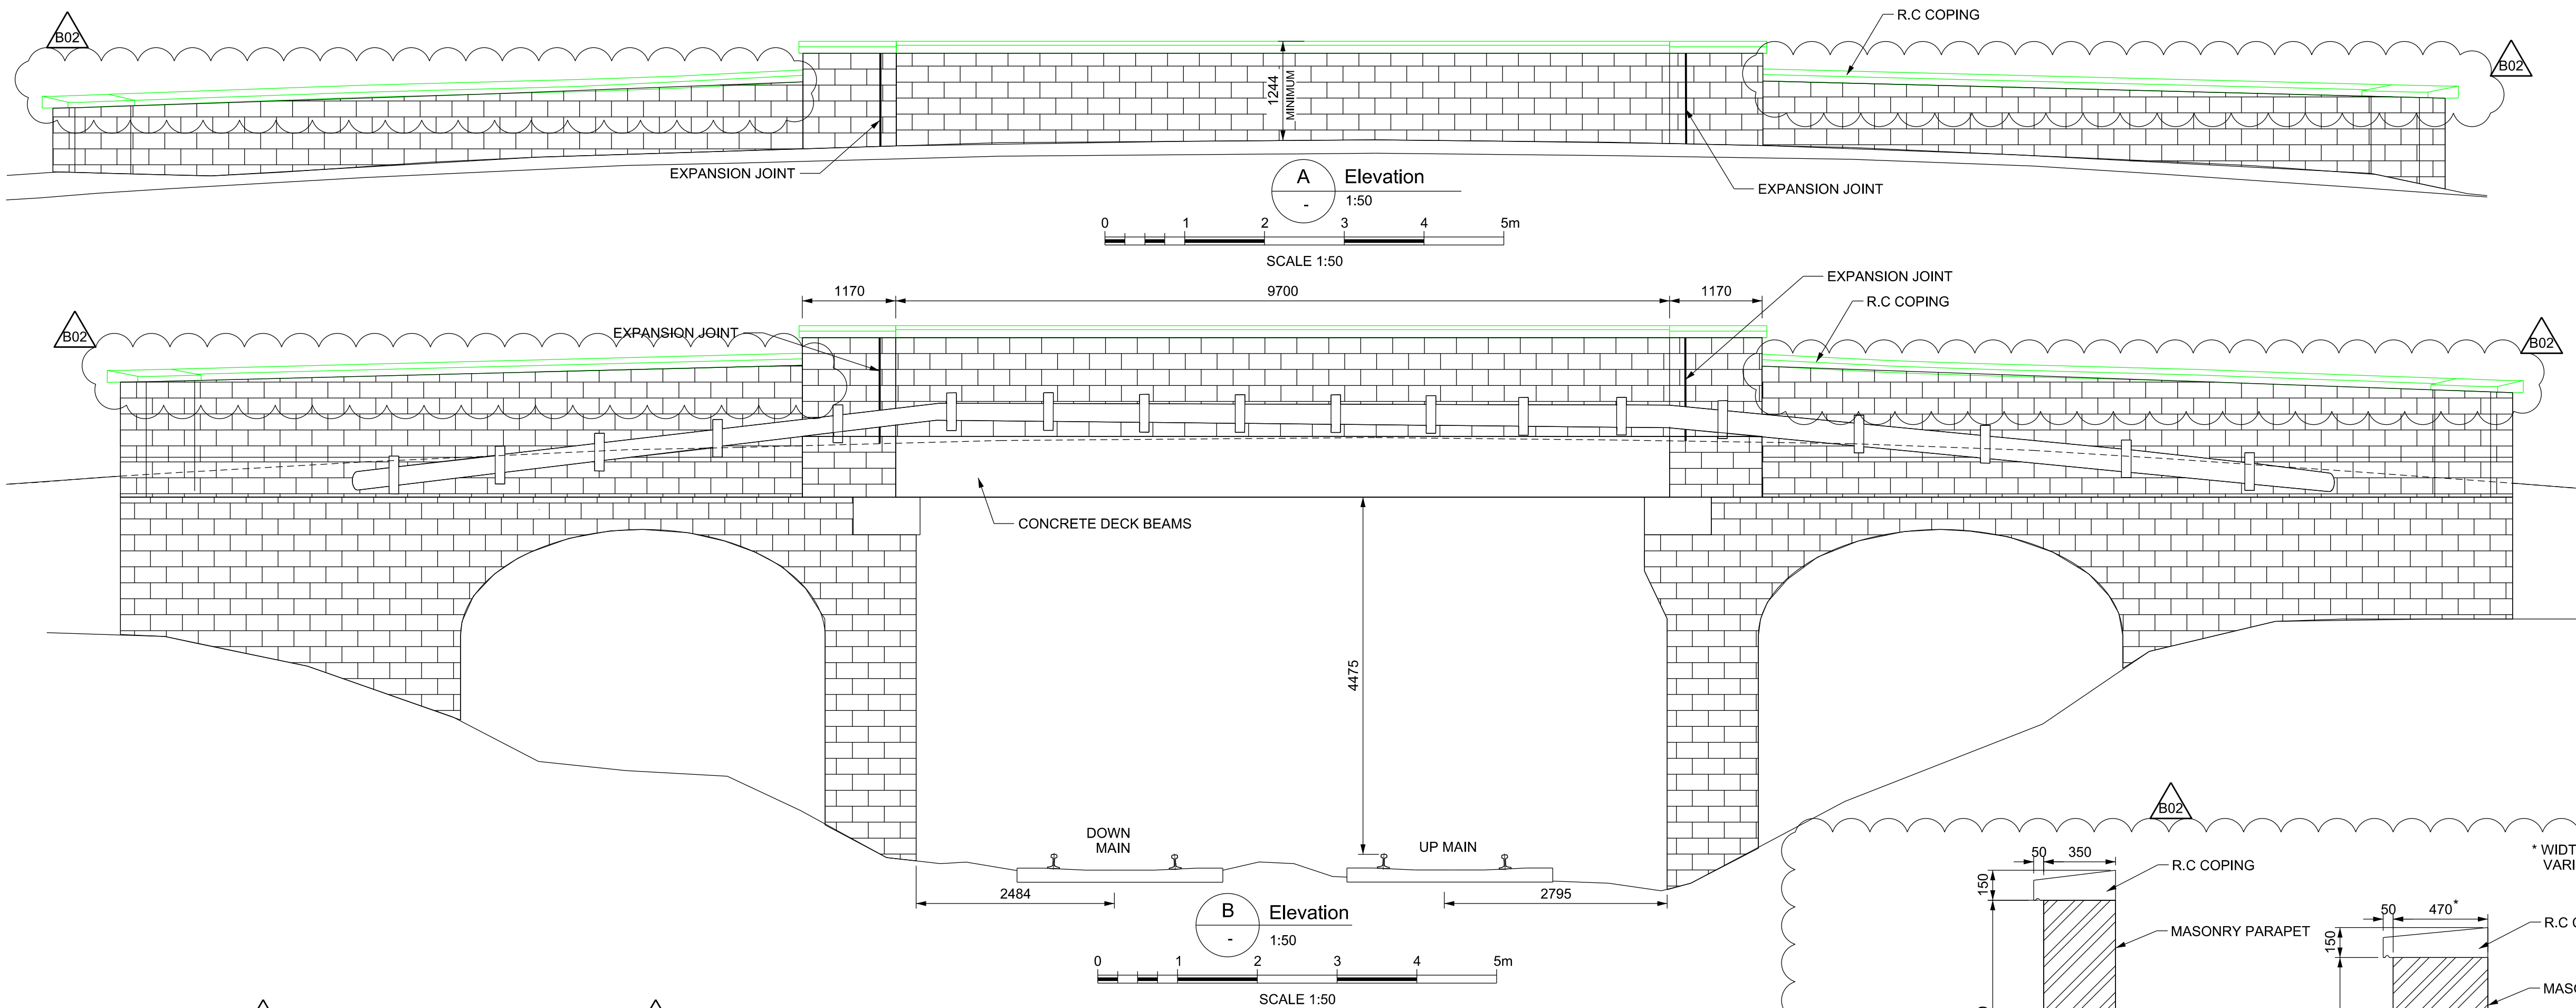

LOCATION PLAN

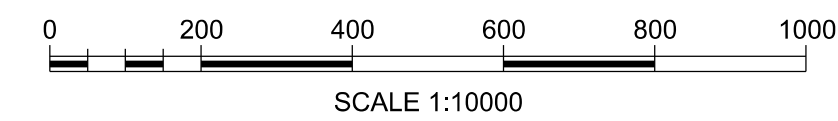

- Legend/Notes
1. ALL DIMENSIONS ARE IN MILLIMETRES UNLESS NOTED OTHERWISE.
 2. DO NOT SCALE ANY ITEMS OR INFORMATION FROM THIS DRAWING.
 3. ALL LEVELS ARE IN METRES ABOVE ORDNANCE DATUM NEWLYN.
 4. THIS DRAWING SHALL BE READ IN CONJUNCTION WITH DRAWING No. W1047B-AMR-DRG-ECV-172001, 172002 & 172003, ALL OTHER CONTRACT DRAWINGS, AND THE WORKS SPECIFICATION DOCUMENT No. W1047B-AMR-SPE-ECV-000001.
 5. THIS DRAWING HAS BEEN PREPARED USING THE FOLLOWING INFORMATION:
FUGRO LIDAR TRACK MODEL (OSGB36); 118049-FGS-MOD-ETR-000101
FUGRO AERIAL POINT CLOUD: g46800_17100
AMCO POINT CLOUD - BURGHFIELD
VARIOUS AS-BUILT DRAWINGS
 6. LOCATION OS GRID REF.: SU683713
 7. REFER TO HAZARD LOG, REF.: W1047B-AMR-RAR-EST-170036

Rev	Date	Description of Revisions	Drawn	Chkd	Appr
B02	06/09/16	WING WALL PARAPET EXTENSION ADDED	M.N	D.W	C.B
B01	02/11/15	DETAILED DESIGN	M.N	R.P	C.B

FOR APPROVAL



Contractor(s)
GWEP D&B PARAPET & ANTI CLIMB WORKS
145157 - PARAPETS PACKAGE 17
OVERLINE STRUCTURES
PARAPET COMPLIANCE

Drawing Title
BURGHFIELD ROAD
BHL 38m 71chs (BRIDGE NO.3871)
EXISTING GENERAL ARRANGEMENT

Designed	C KENNEDY	Signed	C.K	Date	02/11/15
Drawn	M NIRAIMATHI	Signed	M.N	Date	02/11/15
Checked	R PARKER	Signed	R.P	Date	04/02/16
Approved	C BISHOP	Signed	C.B	Date	04/02/16

Scale(s)
1:50
ELR & Mileage
BHL 38m 71chs

Alternative Reference
NOT APPLICABLE
Drawing Number
W1047B-AMR-DRG-ECV-171001

Sheet
1 of 1
Revision
B02