



Carpark bay 35 works

Breakthrough existing structure where required for M&E

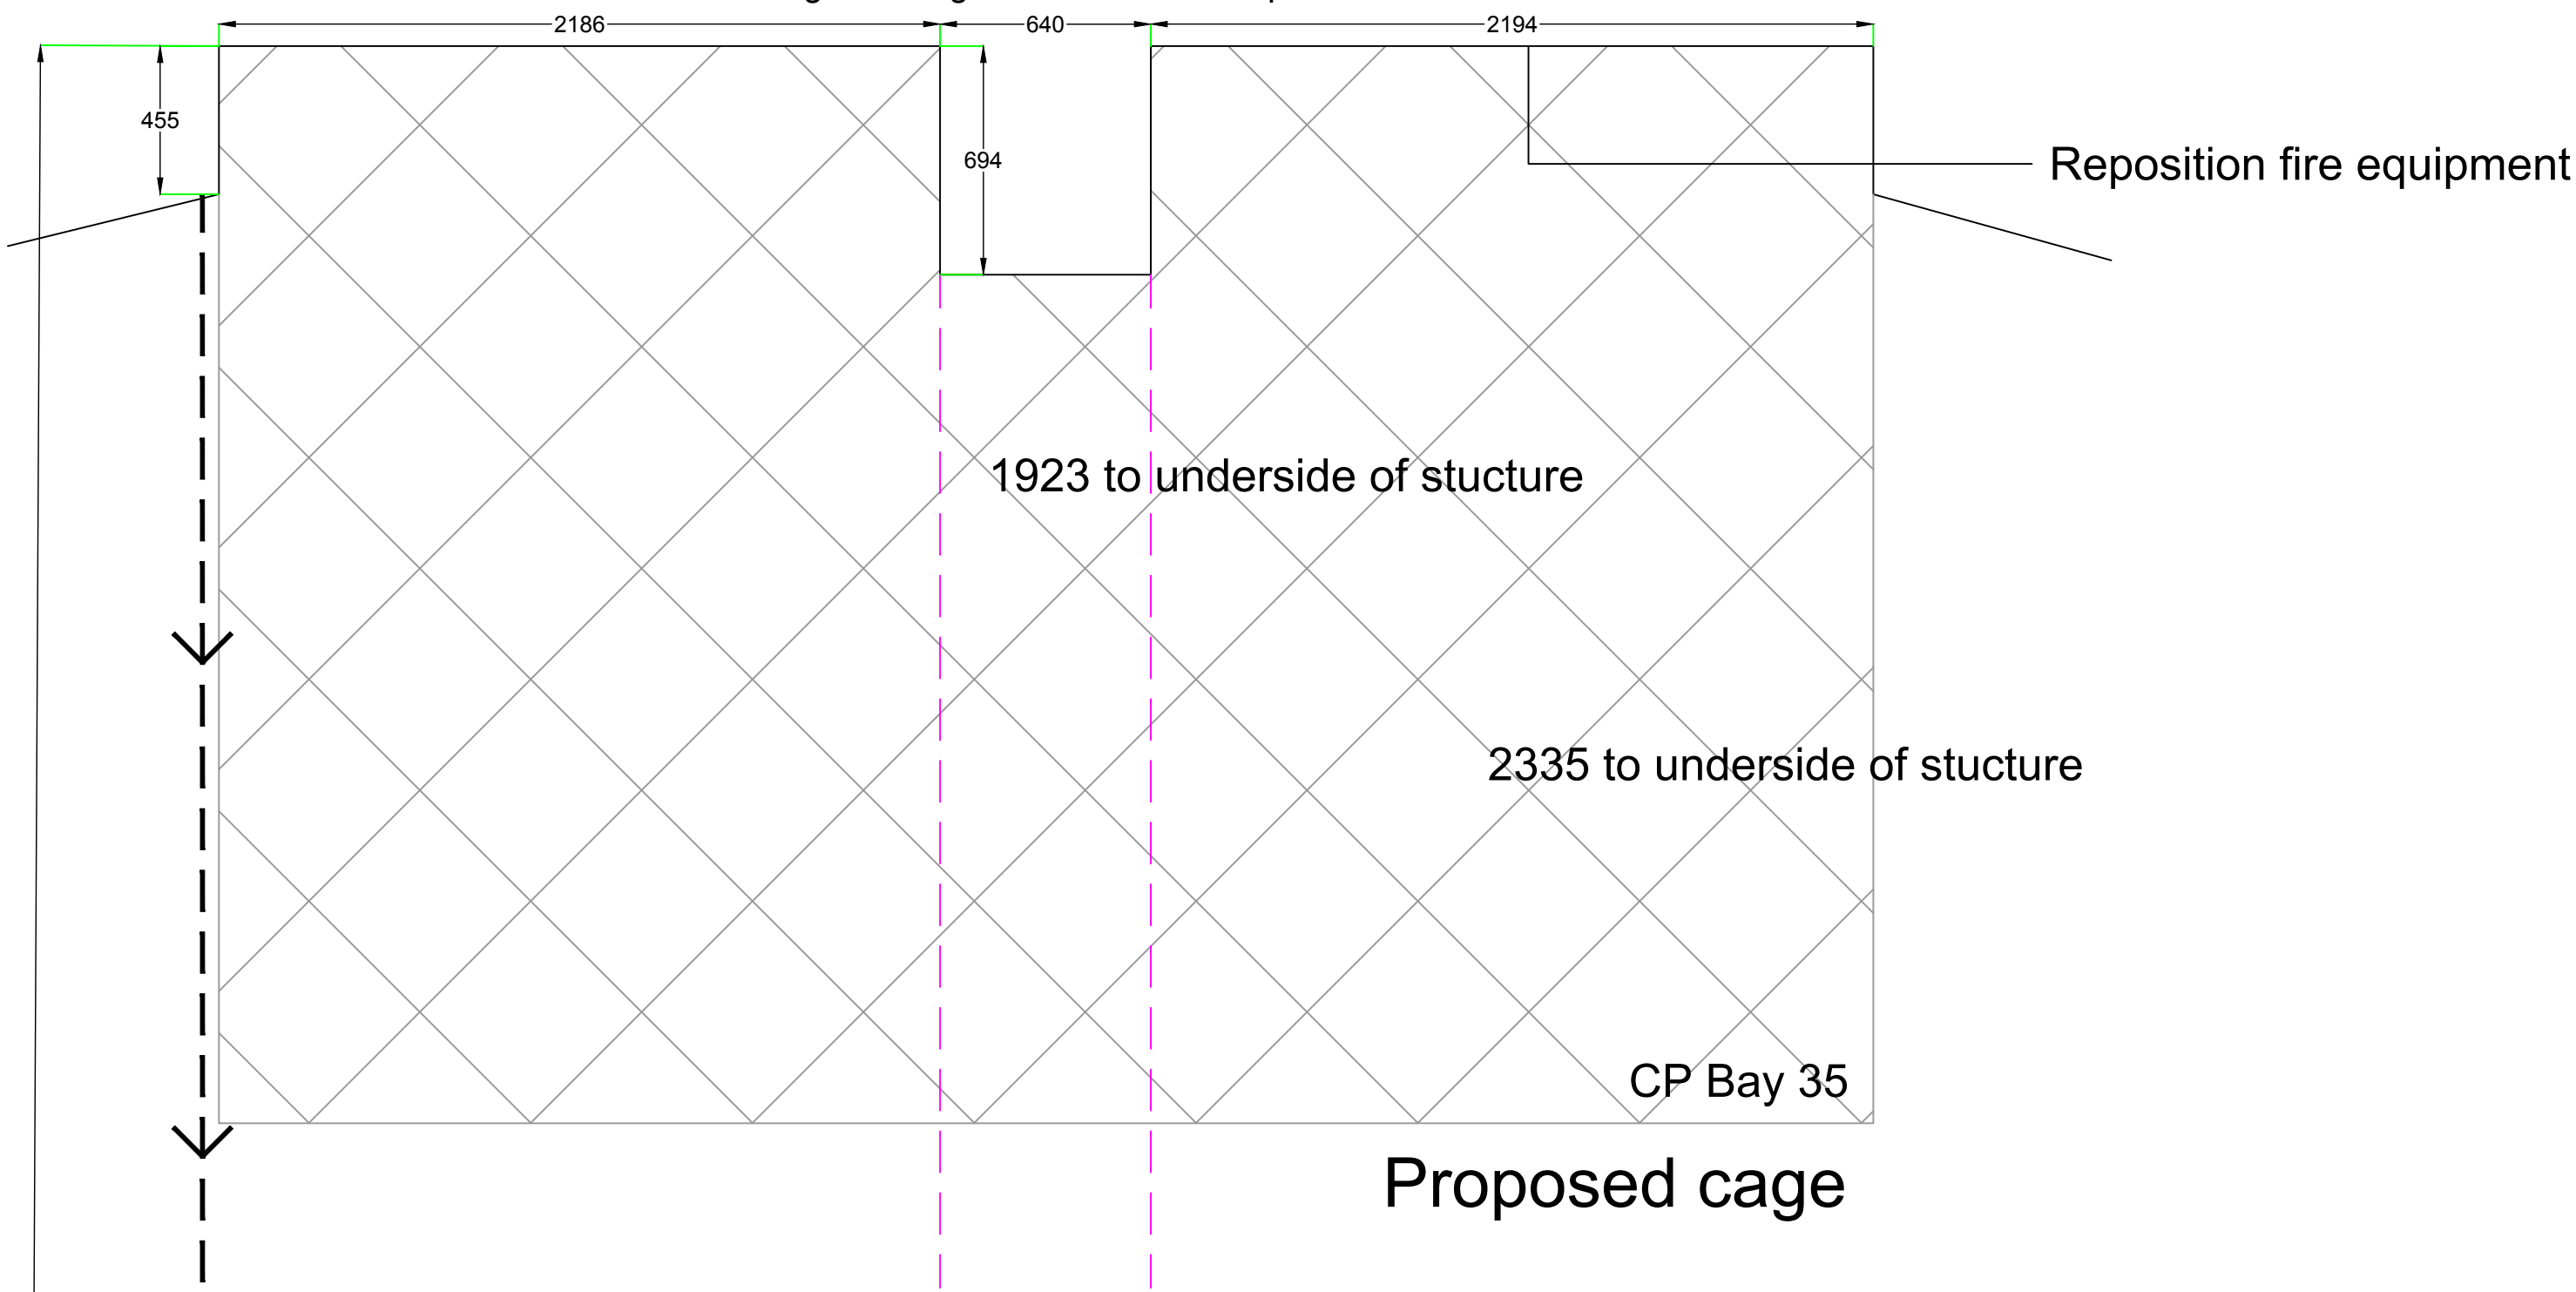


Carpark bay 108 works

Breakthrough existing structure where required for M&E

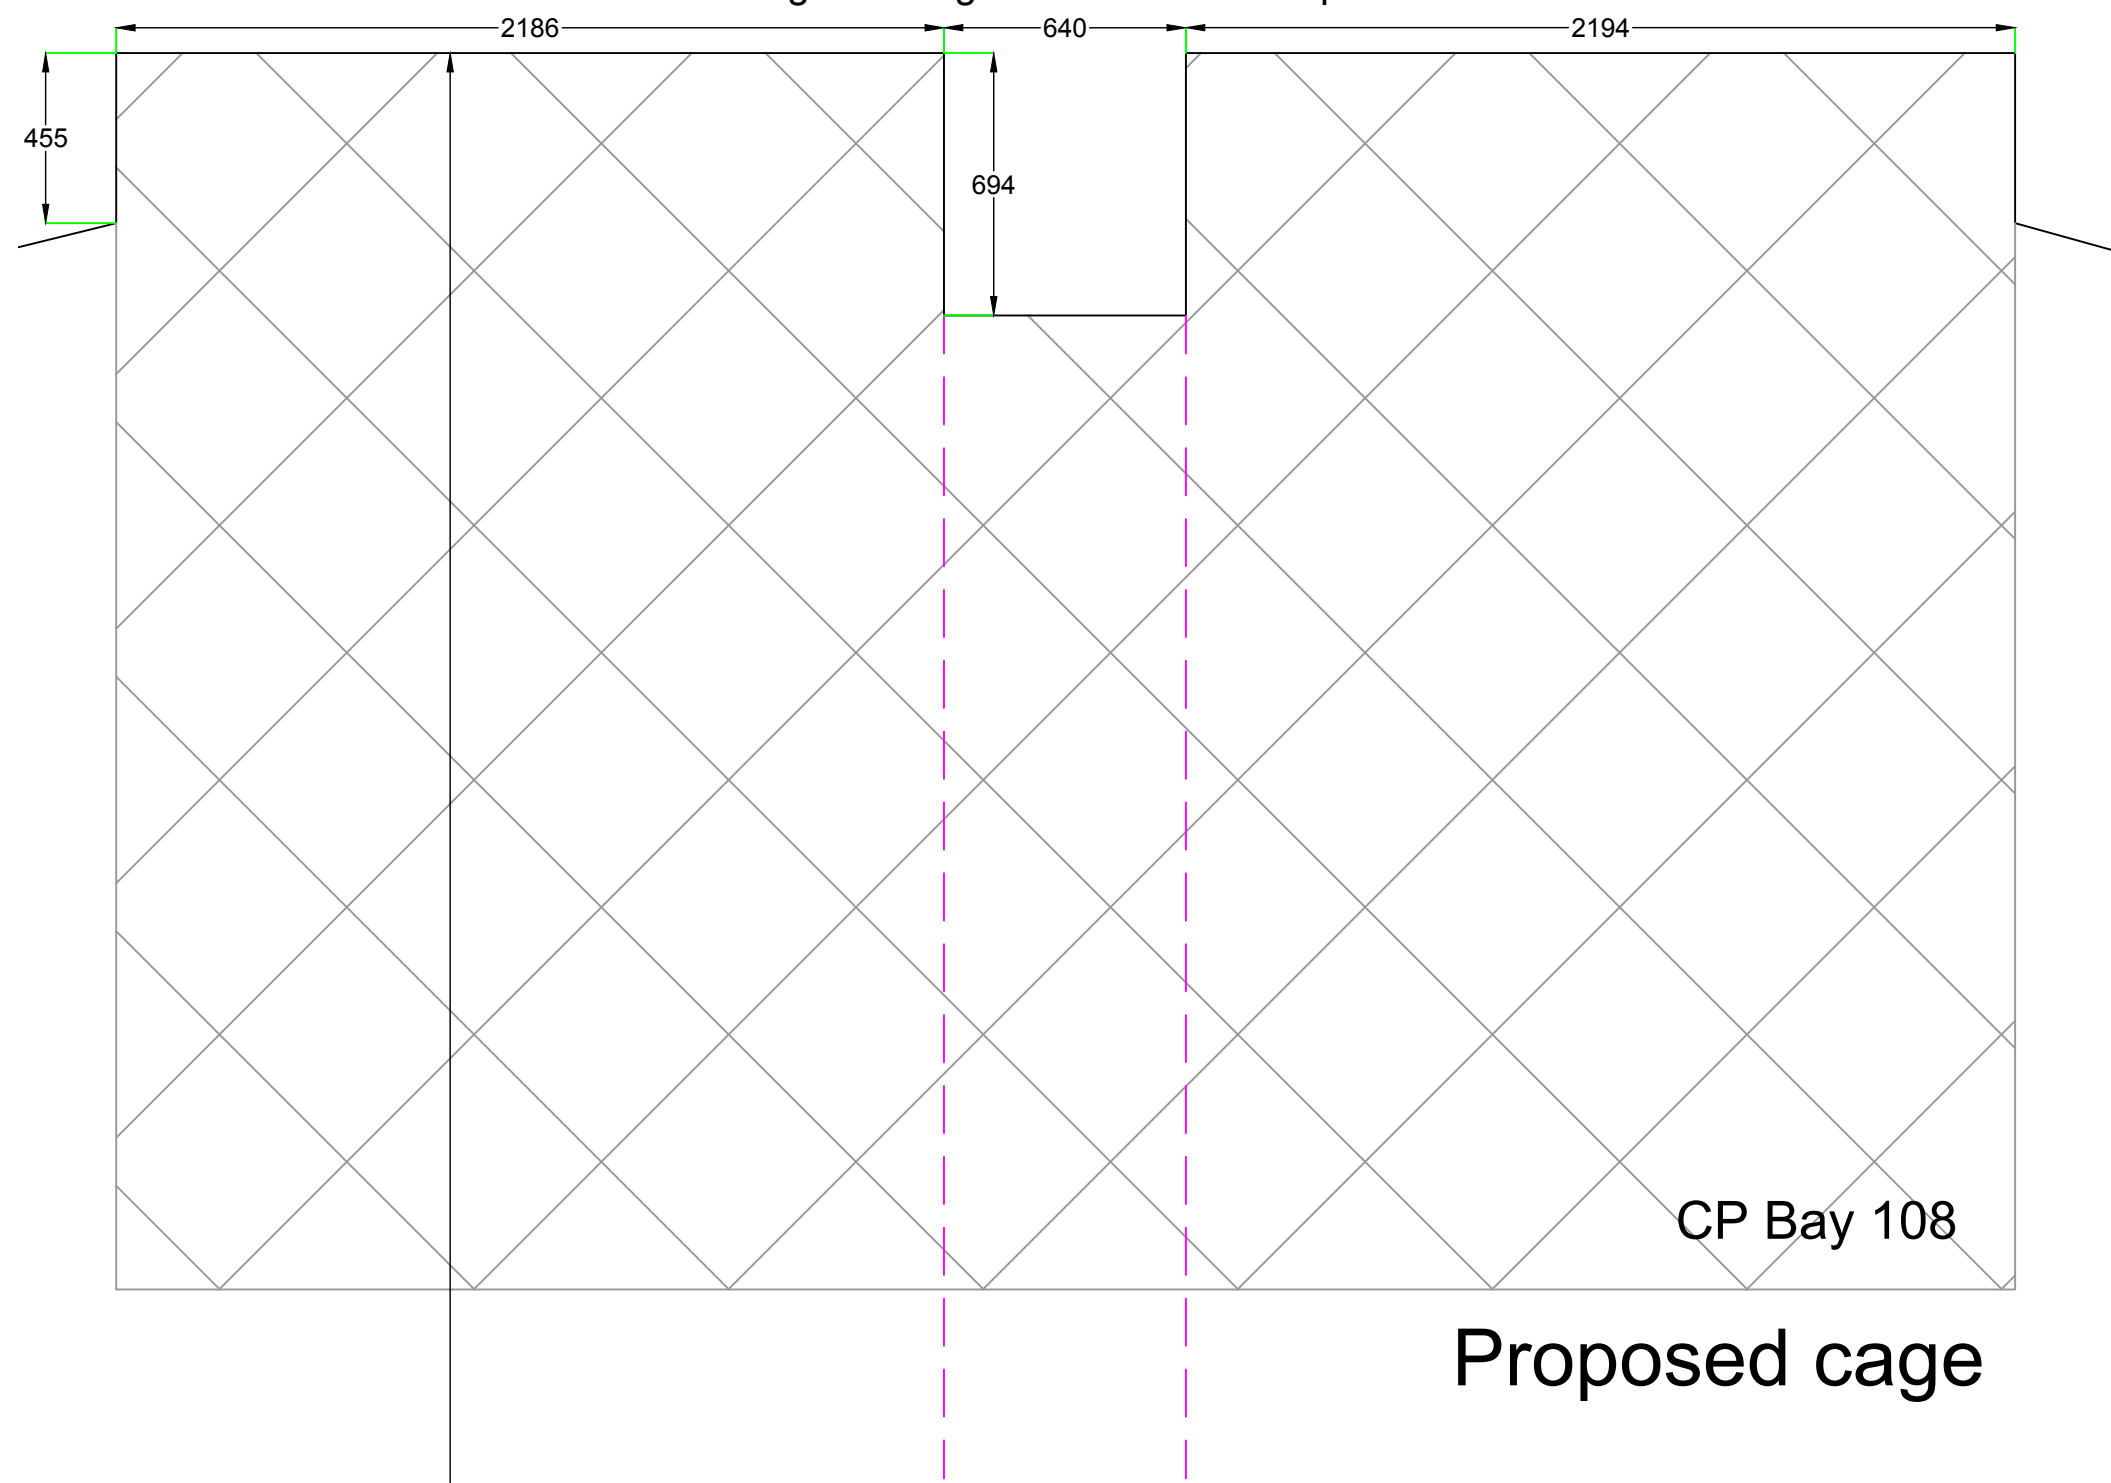

Existing cage works

Breakthrough existing structure for M&E

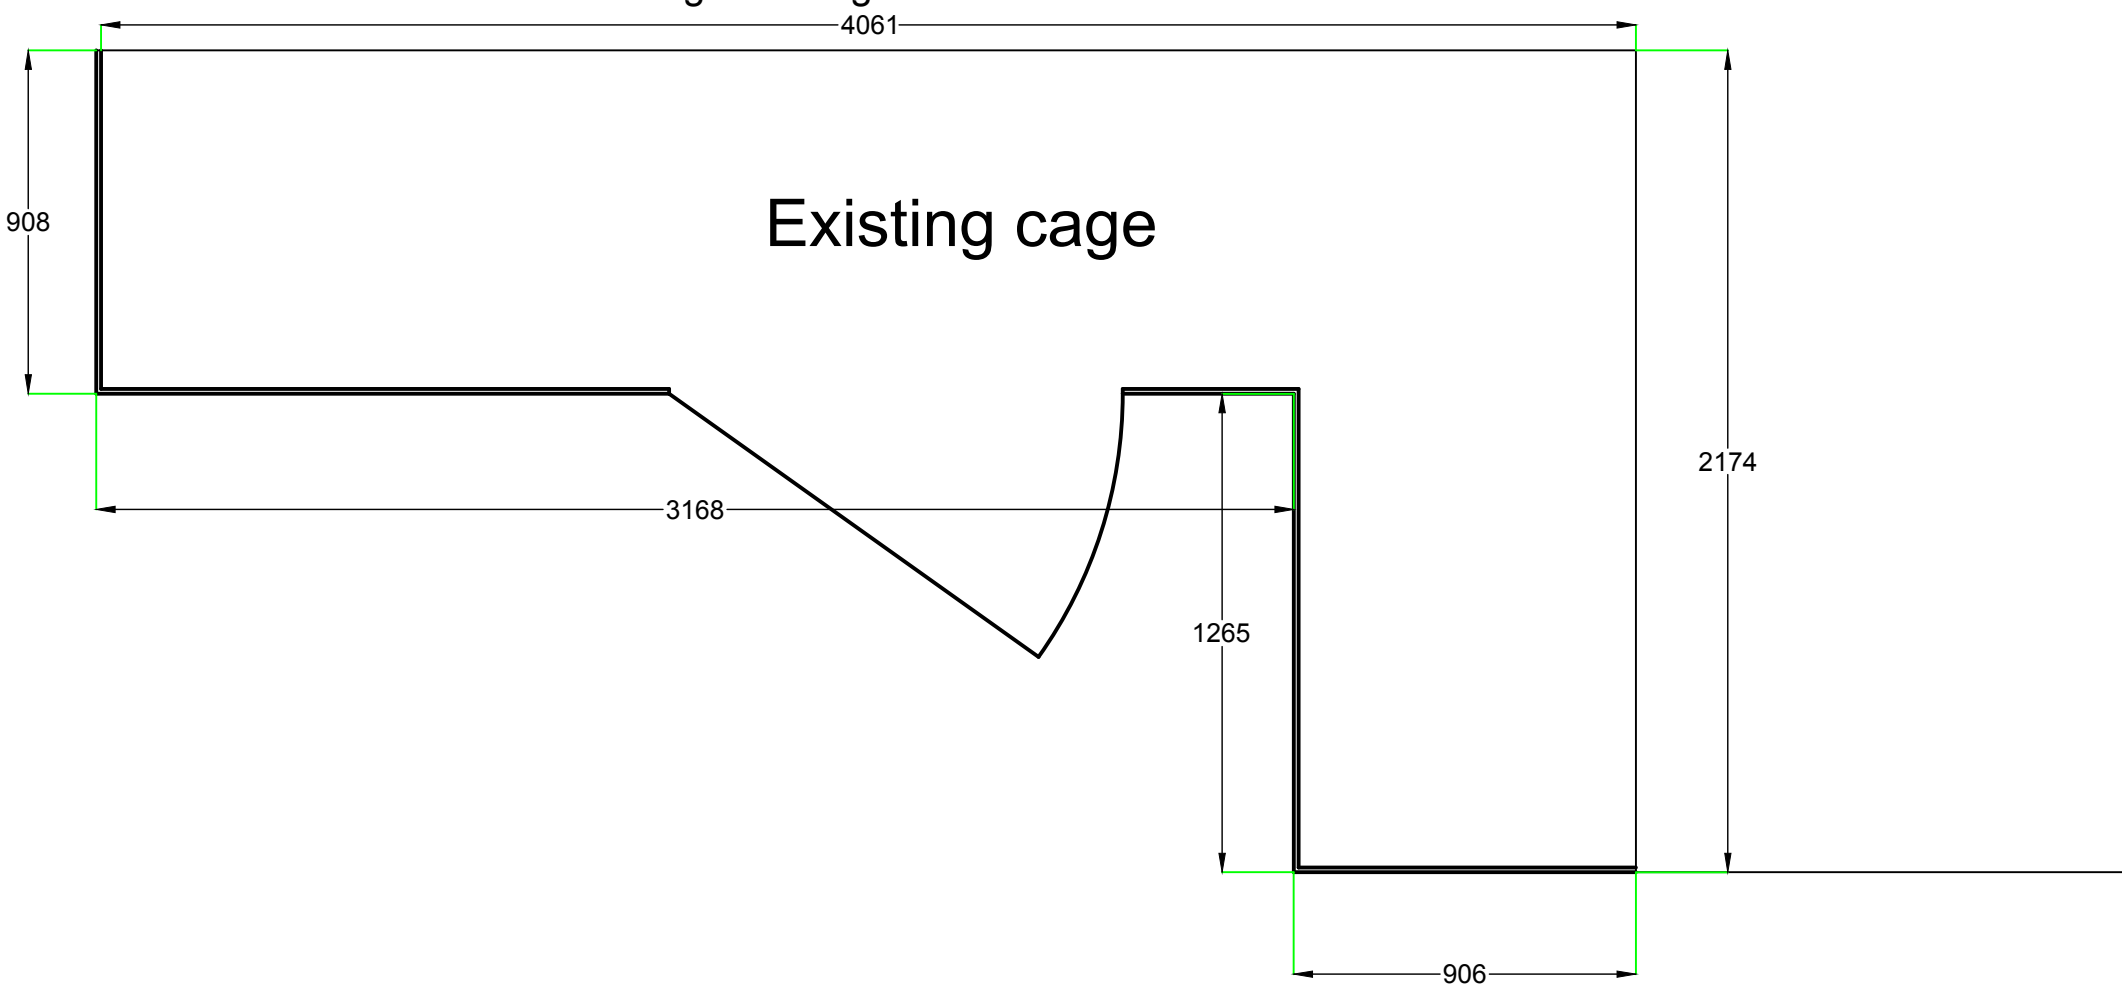

Drain run

Carpark bay 35 (Carpark level external)



8366 To existing cage

Column

Existing cage
12914mm L 2617mm W

AS BUILT 19.06.15

A	Drawing revised to AS BUILT status.	19-06-15	MT
REV	DESCRIPTION	DATE	NAME

Working in Partnership with

paragon
interiors group plc

Paragon House, Orchard Place, Nottingham Business Park, Nottingham, NG8 6PX. 0115 951 9512

DRWS No. 14-404-00-13	REV A	DATE 25/11/2014	SCALE 1:20 @ A1
DRAWN BY: MT	INTERNAL AUTHORISATION AS	CLIENT AUTHORISATION ***	
CLIENT CAPITA			
PROJECT / ADDRESS Bridge House Reading			
TITLE External Works drawing			