




Site Plan
Scale 1:1250

Crown Copyright 2009
Reproduction in whole or in part is prohibited
without the prior permission of Ordnance Survey.

'Reproduced from Ordnance Survey Product SIMDTCUST by Permission of
Ordnance Survey on Behalf of the Controller of Her Majesty's Stationery
Office. Crown Copyright 2009. All rights reserved. Reference Number
001084597 Supplied by : Maps @ John E Wright

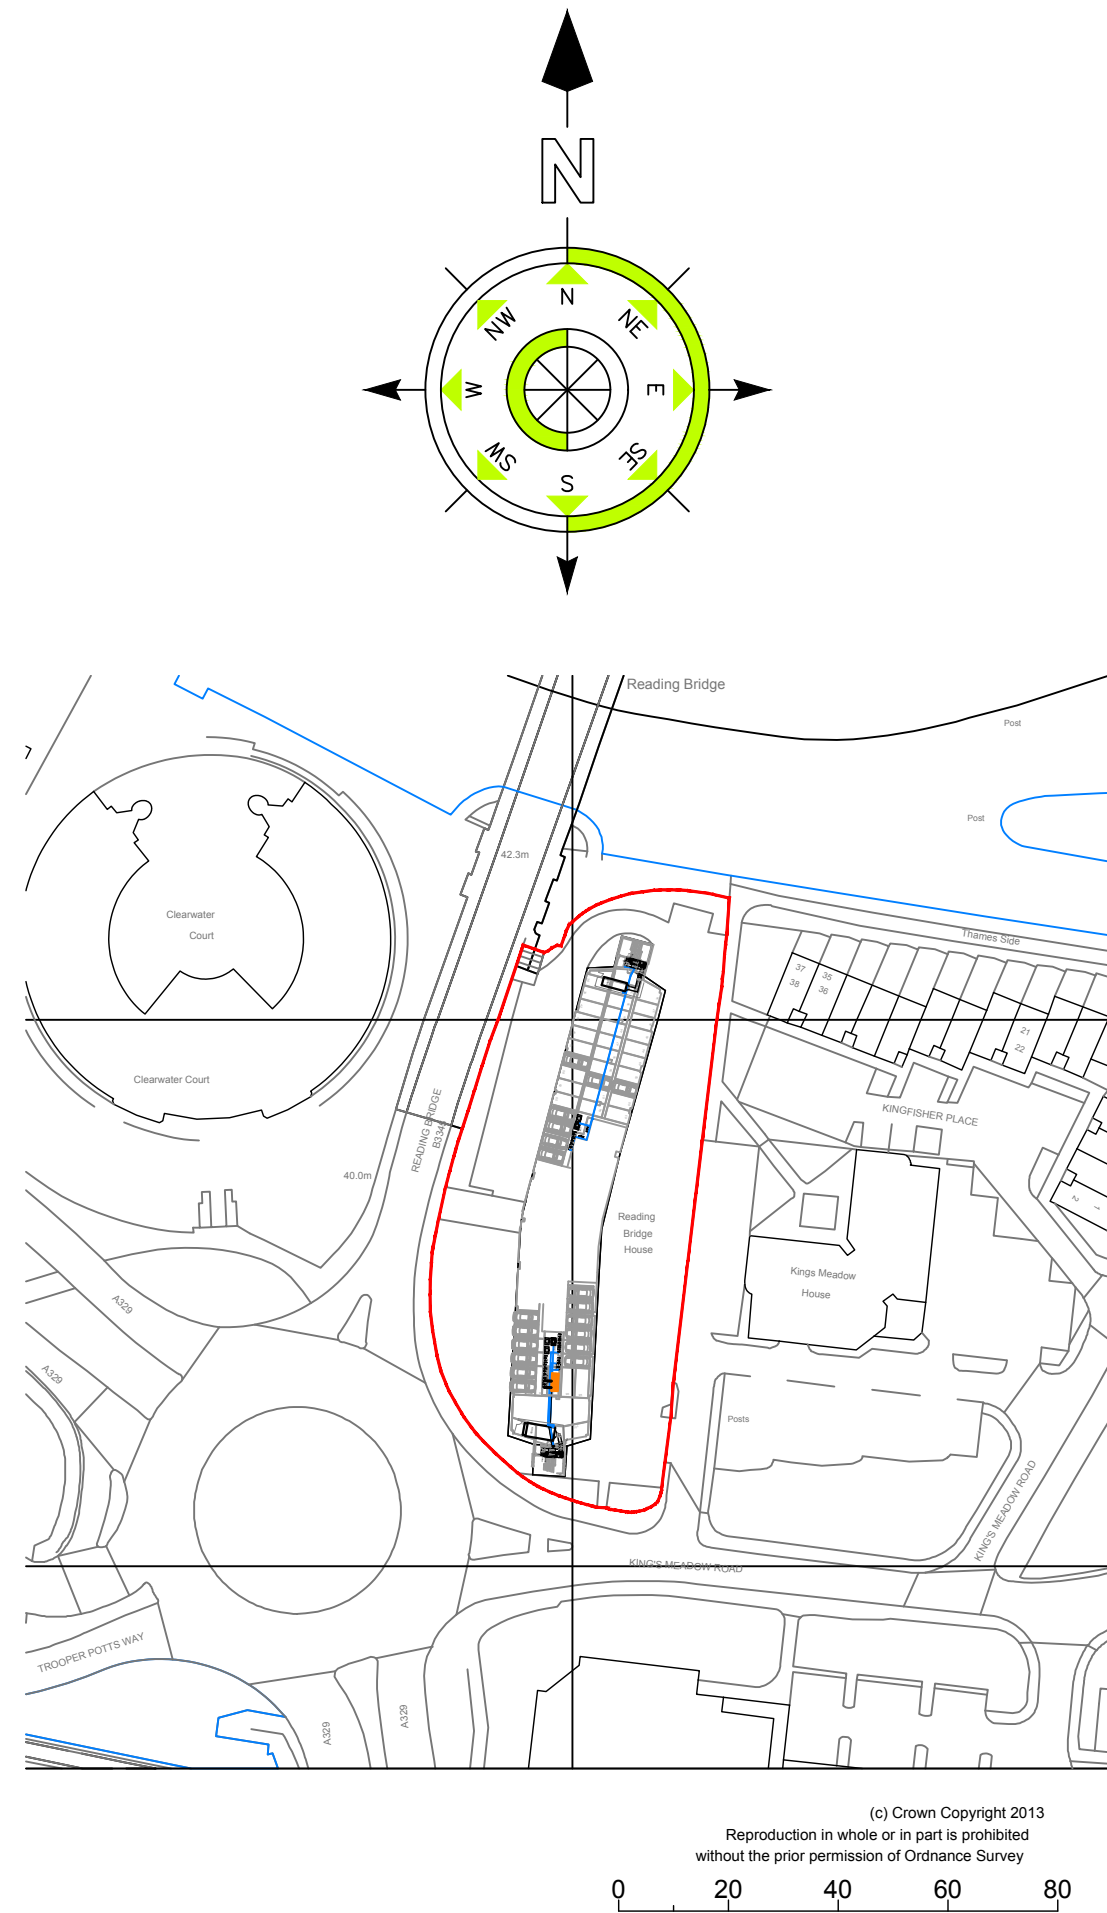

Block Plan
Scale 1:500

(c) Crown Copyright 2013
Reproduction in whole or in part is prohibited
without the prior permission of Ordnance Survey



LEGEND

A

Drawing revised to AS BUILT status.

19-06-15

MT

REV	DESCRIPTION	DATE	NAME

Working in Partnership with

paragon

interiors group plc

Paragon House, Orchard Place, Nottingham Business Park, Nottingham, NG8 6PX. E:0113 951 9512

DRWS No.	REV	DATE	SCALE
14-404-00-14.1	A	02/02/2015	As shown @ A1
DRAWN BY:	INTERNAL AUTHORISATION	CLIENT AUTHORISATION	
MT	AS	***	
CLIENT			
CAPITA			
PROJECT / ADDRESS			
Bridge House			
Reading			
TITLE			
Ordnance Survey Map			
Site Plans			