




Ordnance Survey (c) Crown Copyright 2024
All rights reserved. Licence number 100035207

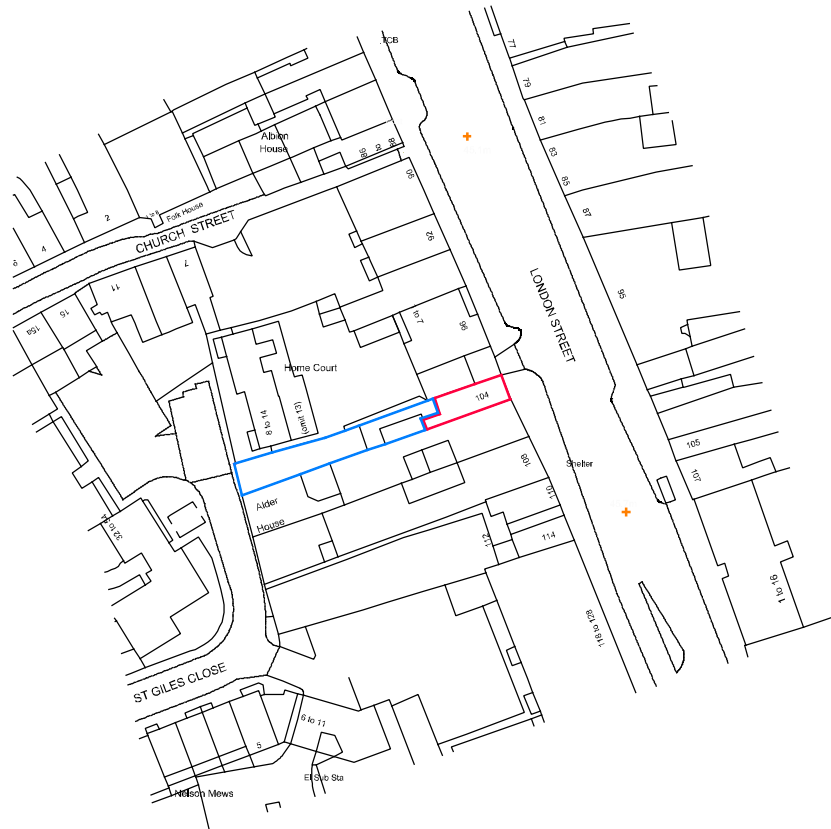

A4
Original

0 10 20 30 40m
Scale 1:1250

Revision A May 2024
Red line adjustment

Scale: 1:1250
Date: May 2024

104 London Street
Reading

Proposed Change of Use
Location Plan

Architectural Services

17 Wessex Court, Clarence Street, Swindon SN1 2DQ
Tel: 07948 872810

Drawing No.
241527/01 A

Copyright