

STATION HILL READING

AMENDMENTS TO RMA REF:
201537/REM PLOT E

NMA 08

MARCH 2024

CALLISON|RTKL
A DESIGN CONSULTANCY OF ARCADIS

INTRODUCTION

NMA 08

Architectural Statement

This NMA relates to commercial units E01-E04 located on friar street and friars walk, specifically to minor amendments of the curtain walling for the shopfronts to these units. The proposal is to change high level vision panels within this curtain wall at ground level from clear glazing to solid aluminium and louvred panels.

The objective is to suit the requirements of this commercial tenants branding objectives, as well as their mechanical requirements. The proposal ensures these changes do not adversely affect the buildings aesthetic, with the proposed material matching the as-built colour and finish.

CONTENTS

Introduction	Page 2
1.0 Elevations	Page 4

1

ELEVATIONS

GENERAL NOTES
All rights reserved.

All drawings and written material appearing here, constitute original and unpublished work of the Architect and may not be duplicated, used or disclosed without written consent of the Architect.

Notes and material designations are typical for similar conditions unless otherwise indicated.


APPROVED

Building Parameter

Retail frontages are indicative only.

P52	2022-05-16	NMA 05 Submission	AR
P51	2021-05-26	NMA 03 Submission	AR
P50	2019-03-15	Issued for Planning	CL
REV No.	DATE	DESCRIPTION	DWN CHK

KEY PLAN

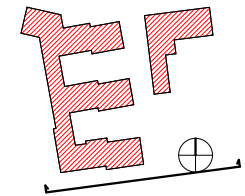

PROJECT

Station Hill, Reading

CLIENT

SH Reading Master
LLP

CALLISONRTKL
A DESIGN CONSULTANCY OF ARCADIS

CallisonRTKL - UK Ltd.
25 Farringdon Street, 10th Floor
London EC4A 4AB
T+44(0)20 7306 0404

SHEET IDENTIFICATION
TITLE

Site - Friar Street
Elevation Plot E

STATUS

PLANNING

PROJECT NUMBER
050-170073

DATE DRAWN
18/02/19

SCALE @ A1
1:250


DRAWN BY
TP

CHECKED BY
AR

PROJECT	ORIGINATOR	ZONE	LEVEL	TYPE
SHR - CRL	SB - ZZ	PL		
ROLE	NUMBER	REVISION		
A	200-002	P52		

© 2018 CallisonRTKL - UK Ltd.

03/09/2022 15:46:50

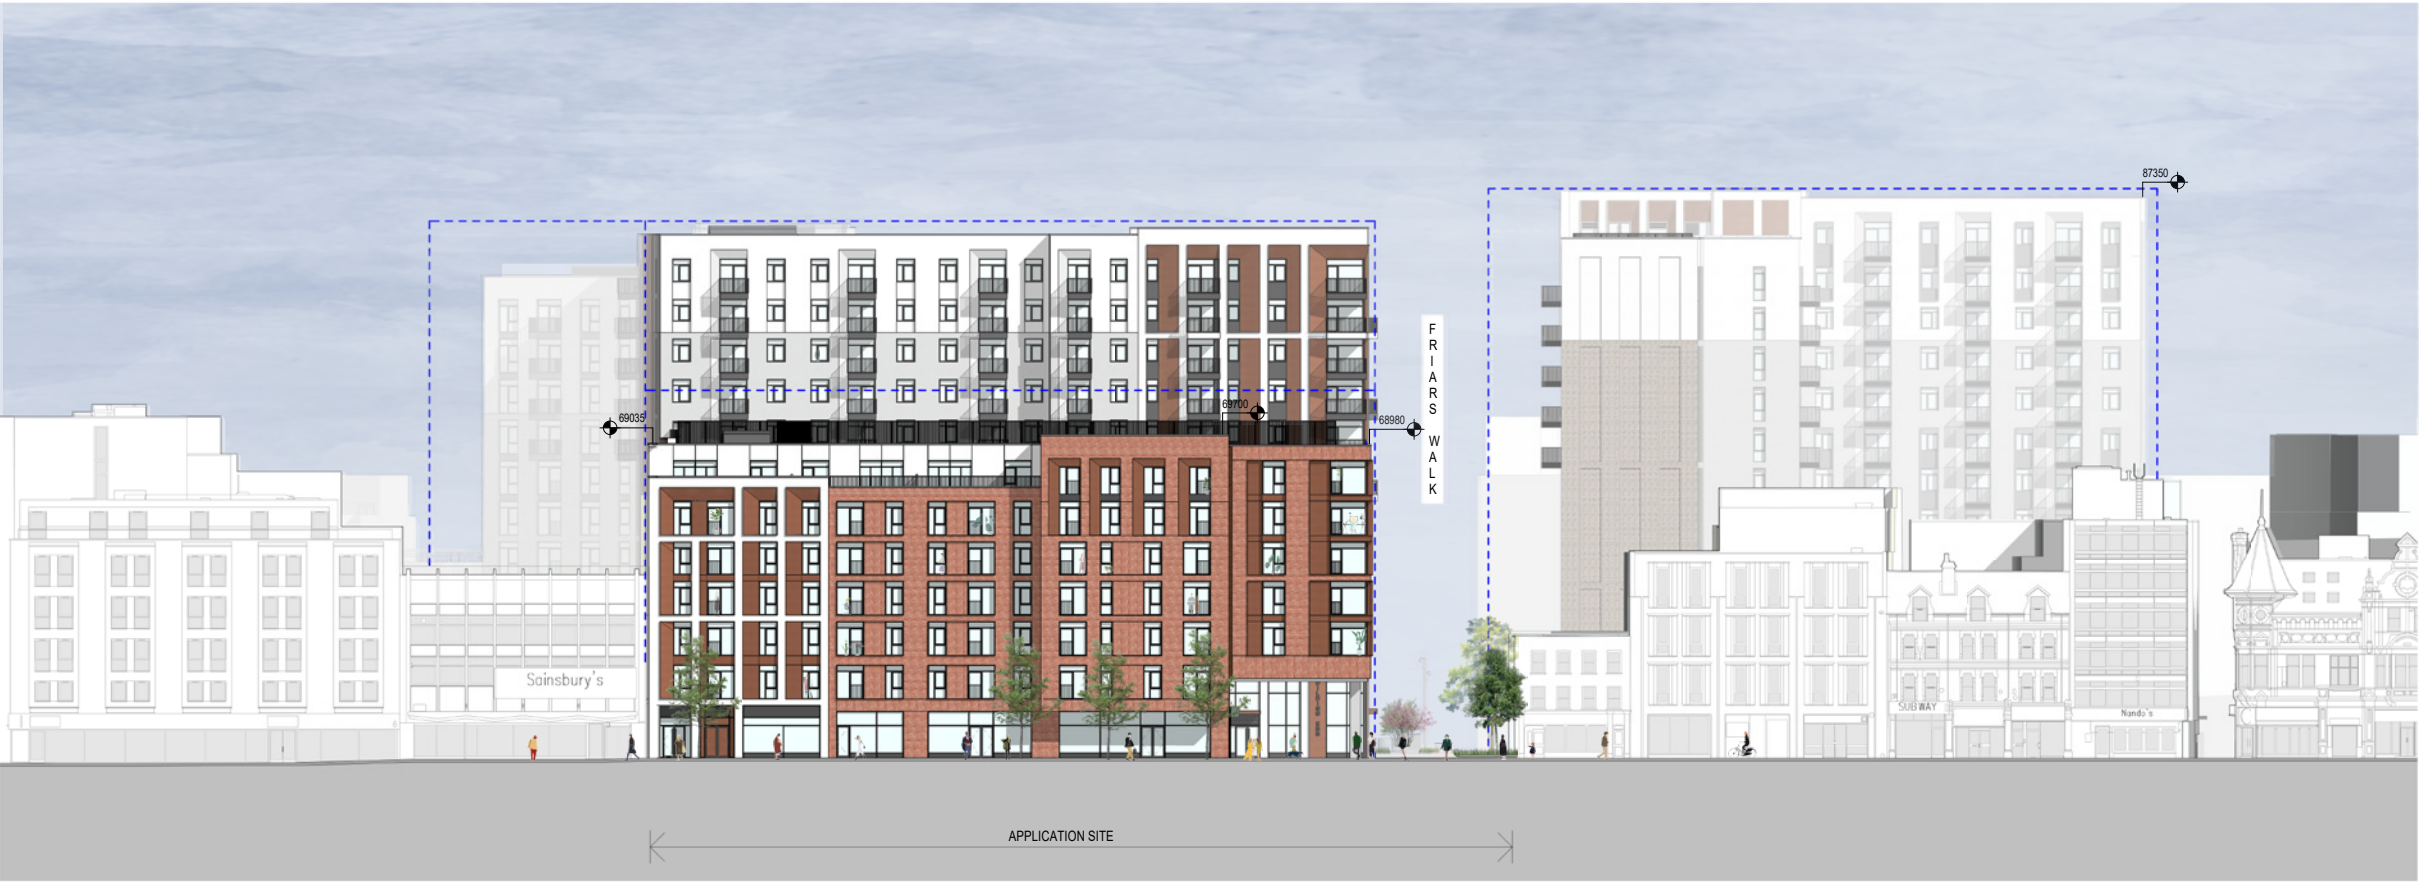

1 Site - Friars Street Elevation Plot E
1:250



BM 300 (CRL) EMELK 050-170073 Station Hill - South Site -
Reading SHR-CRL-MA-ZZ-M3-A-00001-StreetFile-SB-Optimisation.rvt

03/08/2022 15:46:50

01 No base build changes - advertisement application to follow

02 Aluminium panel to be replaced with Z profile louvres, metal with RAL to match curtain wall framing

REV	No.	DATE	DESCRIPTION	DWN	CHK
P53	2024-0304	NMA 08 Submission		JP	
P52	2022-0916	NMA 05 Submission		AR	
P51	2021-0528	NMA 03 Submission		AR	
P50	2019-0315	Issued for Planning		CL	

Station Hill, Reading

**SH Reading Master
LLP**

Title
Site - Friar Street
Elevation Plot E


PLANNING

28/03/2024 10:55:34





1 Site - Friars Walk East Elevation Plot E
1:250

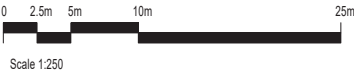

BM 360\J\CRTH\EMELUK-000-170073-Station Hill -South Site-
Reading\SHR-CRL-AA-ZZ-M3-A-000001-SheetFile-SB-Optimisation.rvt

22/09/2022 12:54:36


GENERAL NOTES
All rights reserved.
All drawings and written material appearing here, constitute original and unpublished work of the Architect and may not be duplicated, used or disclosed without written consent of the Architect.
Notes and material designations are typical for similar conditions unless otherwise indicated.

Building Parameter

Retail frontages are indicative only.

REV No.	DATE	DESCRIPTION	OWN	CHK
P53	2022-05-16	NMA 05 Submission	AR	
P52	2021-10-25	NMA 04 Submission	AR	
P51	2021-05-26	NMA 03 Submission	AR	
P50	2020-09-30	Issued for Planning	CL	

KEY PLAN

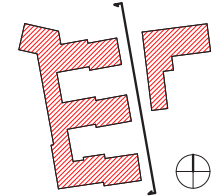

PROJECT

Station Hill, Reading

CLIENT

SH Reading Master
LLP

CALLISONRTKL
A DESIGN CONSULTANCY OF ARCADIS

CallisonRTKL - UK Ltd.
25 Farringdon Street, 10th Floor
London EC4A 4AB

T: +44(0)20 7306 0404

SHEET IDENTIFICATION

TITLE

Site - Friars Walk East
Elevation Plot E

STATUS

PLANNING

PROJECT NUMBER
050-170073

DATE DRAWN
10/02/18

SCALE @ A1
1:250

DRAWN BY
TP

CHECKED BY
AR


PROJECT	ORIGINATOR	ZONE	LEVEL	TYPE
SHR	CRL	SB	ZZ	PL
ROLE	NUMBER	REVISION		
A	200-003	P53		

© 2018 CallisonRTKL - UK Ltd.

22/09/2022 12:54:36

01
Aluminium panel to replace
glass vision panel - separate
advertisement application to follow

02
Aluminium panels to be replaced
with Z profile louvres, metal
with RAL to match curtain wall
framing

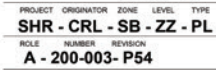

BIM 360://CRTL-EMEUK-050-170073-Station Hill -South Site-
Reading/SHR-CRL-MA-ZZ-M3-A-000001-SheetFile-SB-Optimisation.rvt 3/4/2024 4:48:31 PM

