






1 FRONT ELEVATION
1 : 75

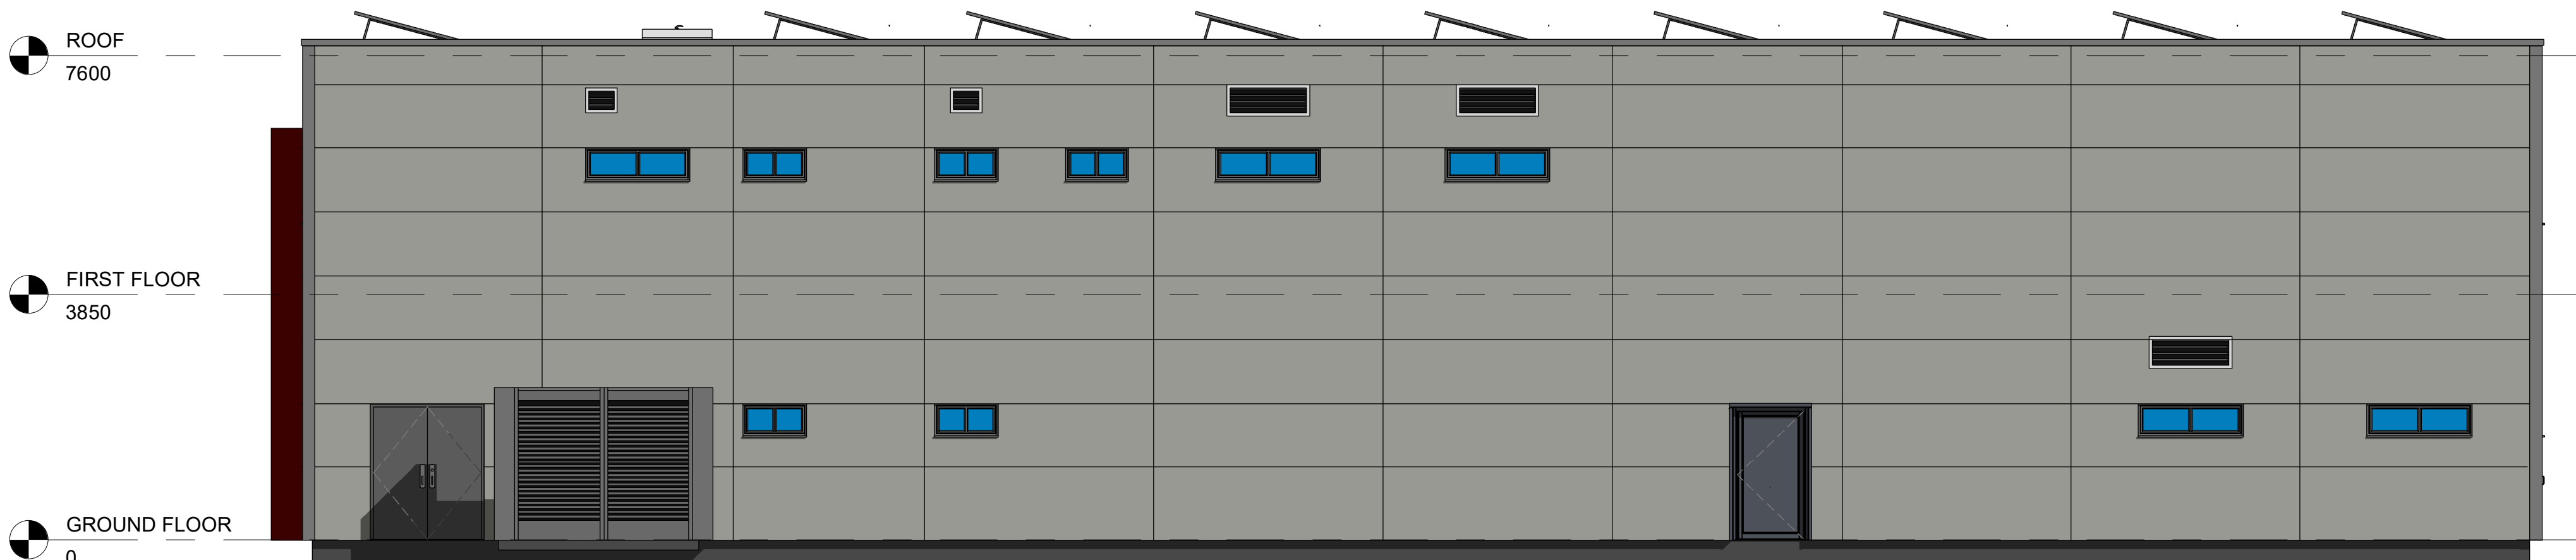

2 BACK ELEVATION
1 : 75

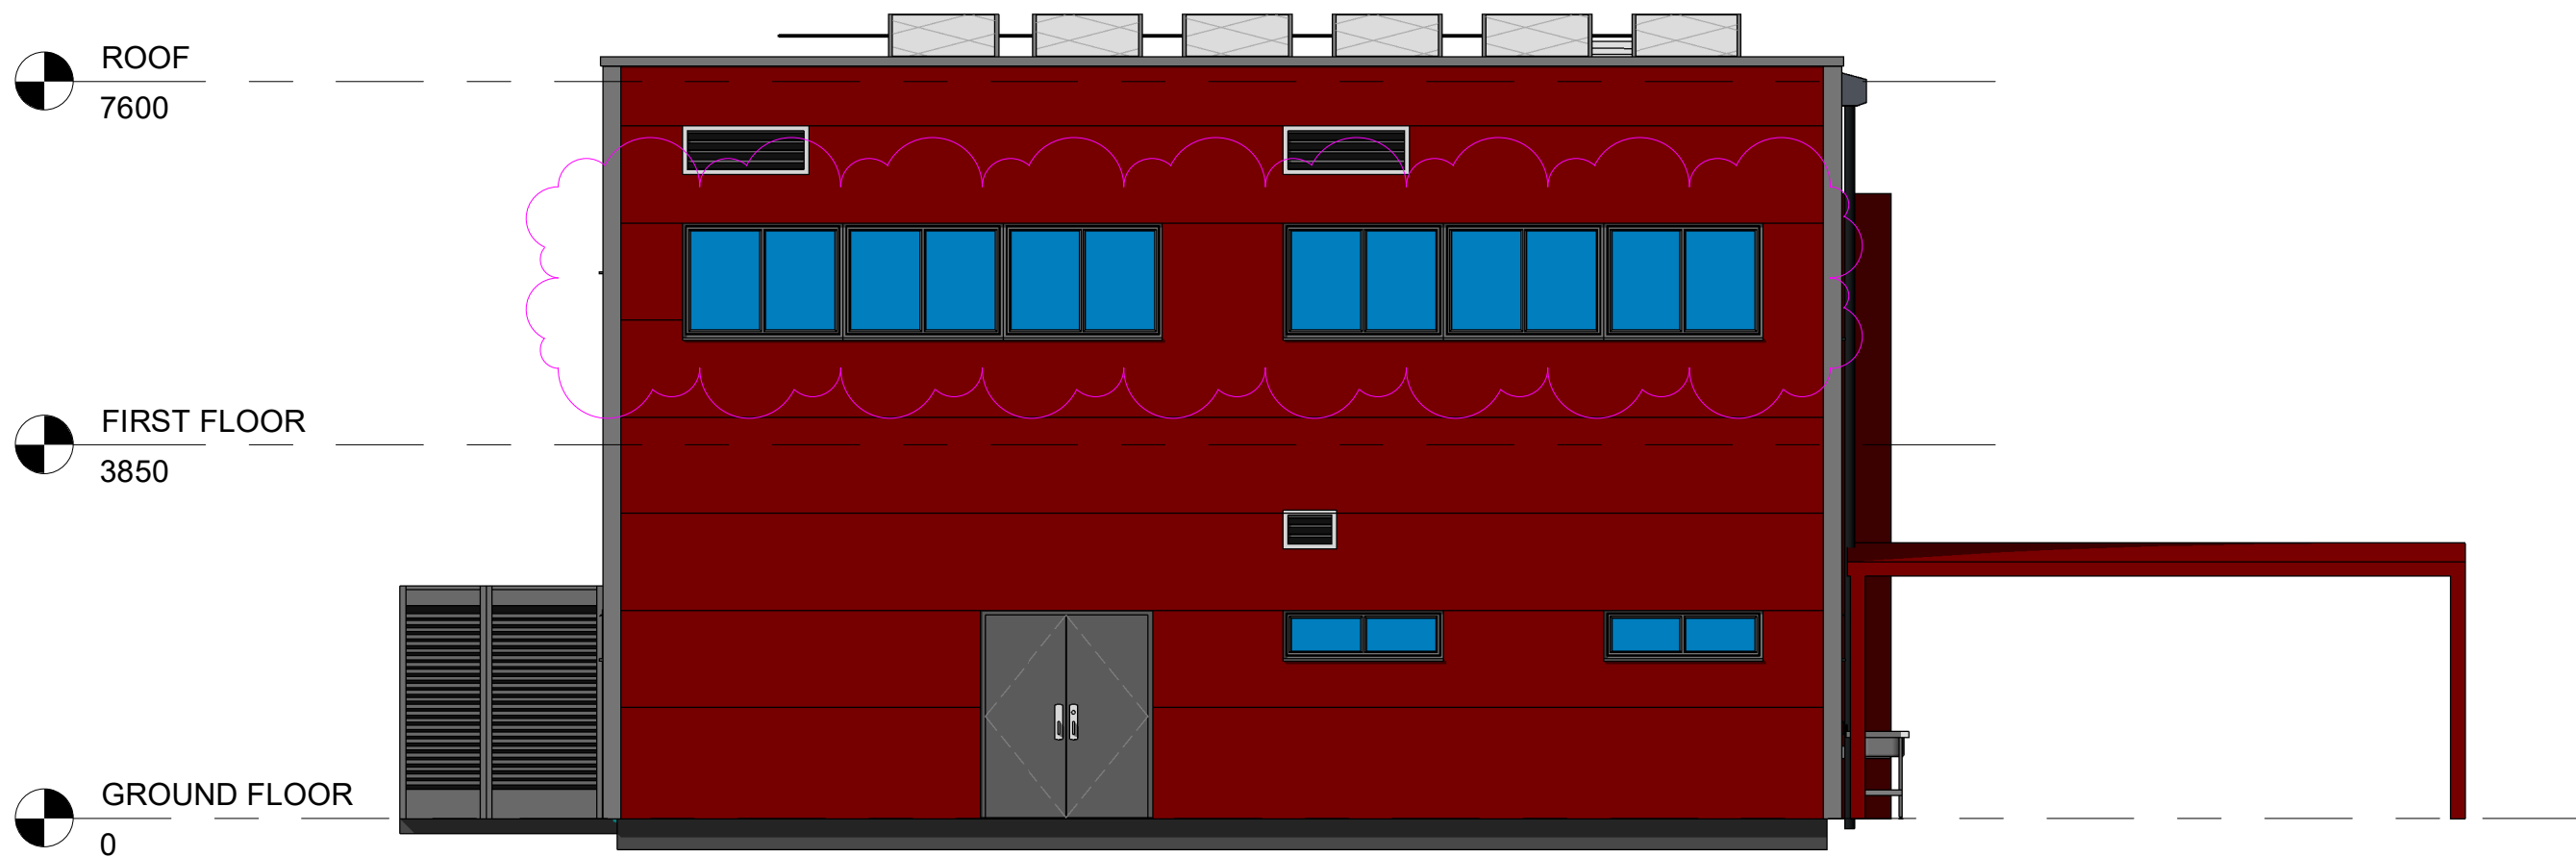

3 LEFT ELEVATION
1 : 75

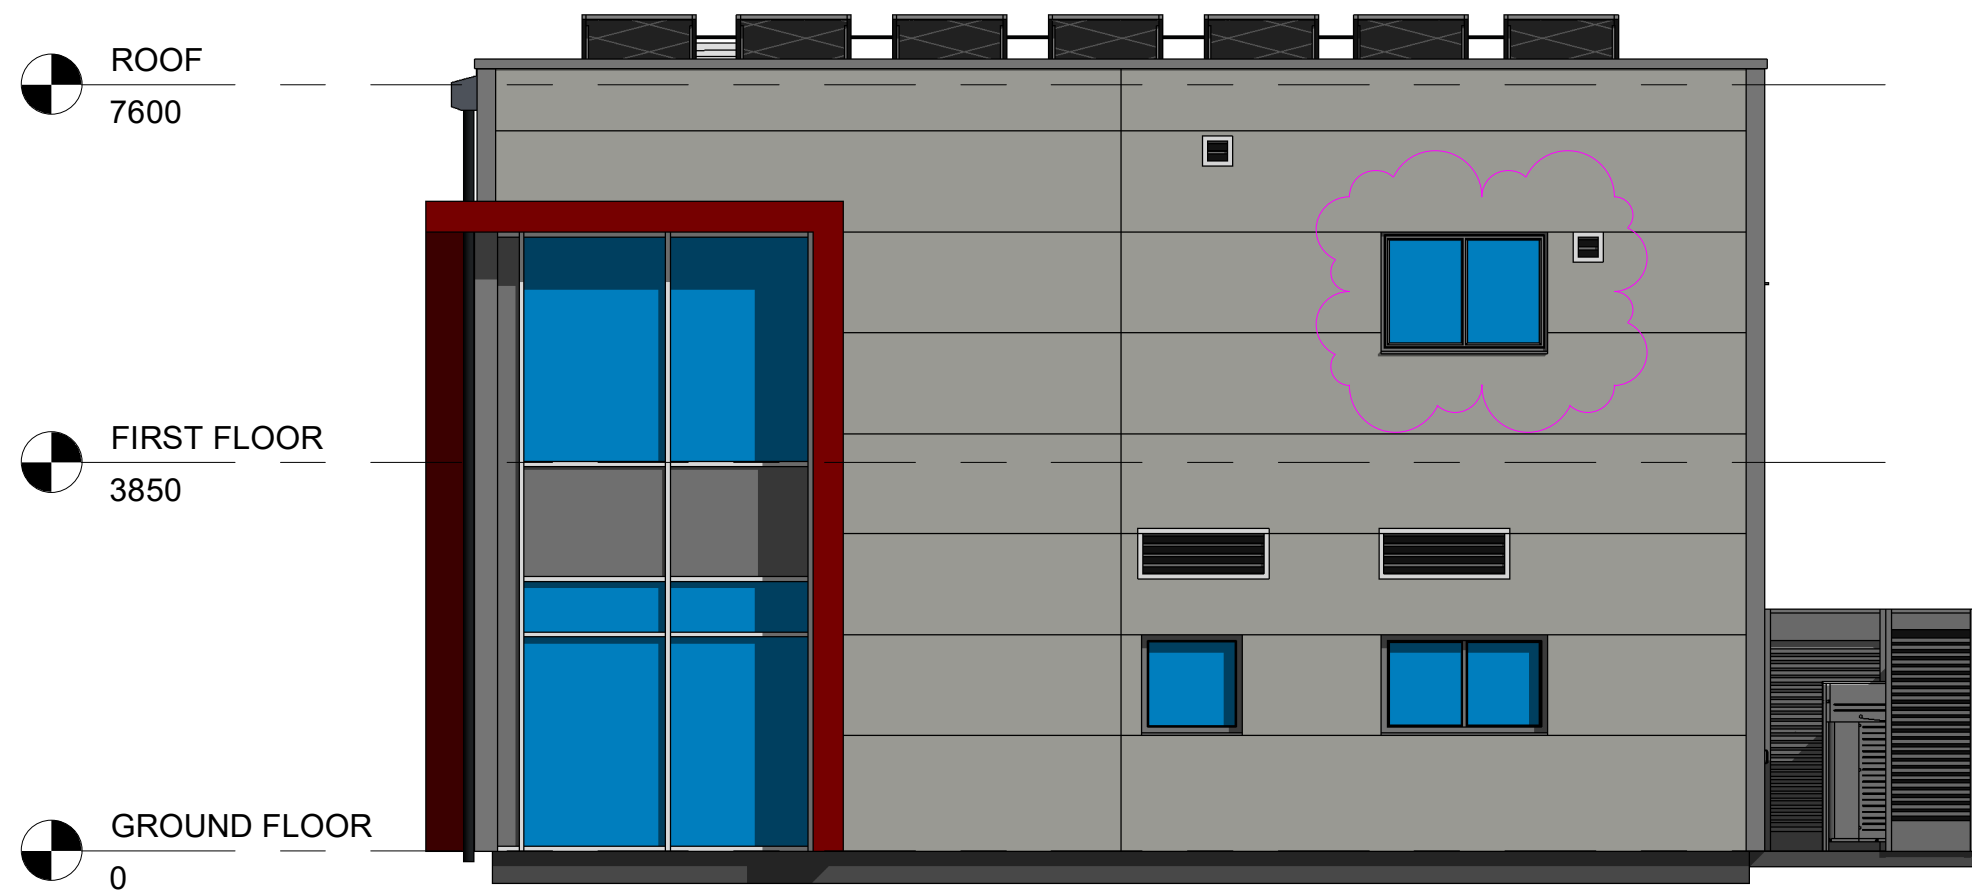

4 RIGHT ELEVATION
1 : 75

UNLESS STATED OTHERWISE, THE DESIGNS SHOWN ARE SUBJECT TO DETAIL SITE SURVEY AND INVESTIGATIONS AND/OR APPROVAL OF THE RELEVANT VARIOUS LOCAL AUTHORITY OFFICERS, STATUTORY UNDERTAKING, FIRE OFFICERS AND ENGINEERS. THEY ARE PROJECT AND SITE SPECIFIC.

THIS DRAWING SHOULD NOT BE SCALED FROM.

ALL DIMENSIONS SHOULD BE CHECKED ON SITE.

ANY DRAWING ERRORS OR DISCREPANCIES SHOULD BE REPORTED TO VAUGHAN ARCHITECTURE LTD

THIS DRAWING IS THE COPYRIGHT OF VAUGHAN ARCHITECTURE LTD

A	REVISED TO SUIT CLIENT MEETING HELD ON 23.10.23	25.10.23	DRP	NV
B	CLADDING REVISED TO RED ON THE LEFT ELEVATION	06.11.23	DRP	NV
C	EXTERNAL GUTTER, RWP'S AND PV PANELS ADDED	06.12.23	DRP	NV
D	WINDOW LOCATIONS REVISED BY 50mm & WIDTH OF CW REDUCED BY 50mm	20.02.24	DRP	NV
E	SLOPE OF ROOF REVISED AND RWP LOCATIONS UPDATED AS PHIL EMAIL COMMENTS	21.02.24	DRP	NV
F	WINDOWS REVISED AS CLIENT MARK-UP (RECEIVED 23.02.24)	23.02.24	DRP	NV
G	ADDITIONAL WINDOWS ADDED TO FIRST FLOOR MEETING ROOMS	26.02.24	DRP	NV
H	EXTERNAL PLANT REVISED	19.03.24	DRP	NV
I	REVISED TO CLIENT STAGE 4 REVIEW & COMMENTS TRACKER	09.04.24	DRP	NV
J	WINDOWS TO FIRST FLOOR STAFF AREAS INCREASED IN HEIGHT AND CELL LOWERED	15.05.24	DRP	NV

WHITLEY WOOD STATION

PREMIER
MODULAR

DRAWING STATUS
DRAWN BY:
SCALE: 1 : 75 @A1
DATE: 17/07/2023

Leicester Office:

Vaughan Architecture Ltd
Rutland House
23-25 Friar Lane
Leicester
LE1 5QQ
0116 328 8905



Latest Projects

CLIENT RIDGE & PARTNERS LLP
PROJECT TITLE WHITLEY WOOD STATION
DRAWING TITLE PROPOSED ELEVATIONS
PROJECT NO. VAD.23.28
DRAWING NO. 36087-PML-ZZ-DR-A-0002
REVISION J
STATUS S3

VAUGHAN
ARCHITECTURE

Vaughan Architecture Ltd
No 2
Infirmary Street
Leeds, West Yorkshire LS1 2JP
0113 493 1055
www.vaughanarchitecture.co.uk