


© Copyright. Drawings not to be reproduced or used without prior written consent

Notes
Levels based on floor level. Arbitrary value 50.00m

Abbreviations:
C Window Cill Level
FL Floor Level
H Window Head
S/C Sloping Ceiling
U/S Underside Level

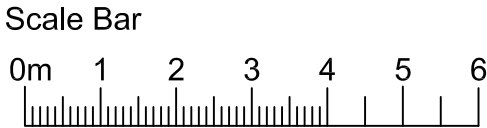

Rev. Date Details By

Status
AS BUILT



PROPERTY SERVICES DEPARTMENT
PO Box 227
Kidlington
Oxon OX5 1YE

Consultant
MILTON KEYNES SURVEYS LTD.
Land & Building Surveys • 3D Laser Scanning • CAD Bureau
Datum House
41 Burners Lane South
Kiln Farm
Milton Keynes
MK11 3HA
Tel: 01908 565561
Fax: 01908 261030
E-mail: mail@mksurveys.co.uk
Web: www.mksurveys.co.uk


Site
Cemetery Arch Junction UPRN
0109/01

Project
Measured Building Survey

Title
Ground & First Floor Plans


Scale.
1:100 @ A3 Date.
05-03-2010 Drawn by.
MKS

Drawing No.
0109-001-M Rev.

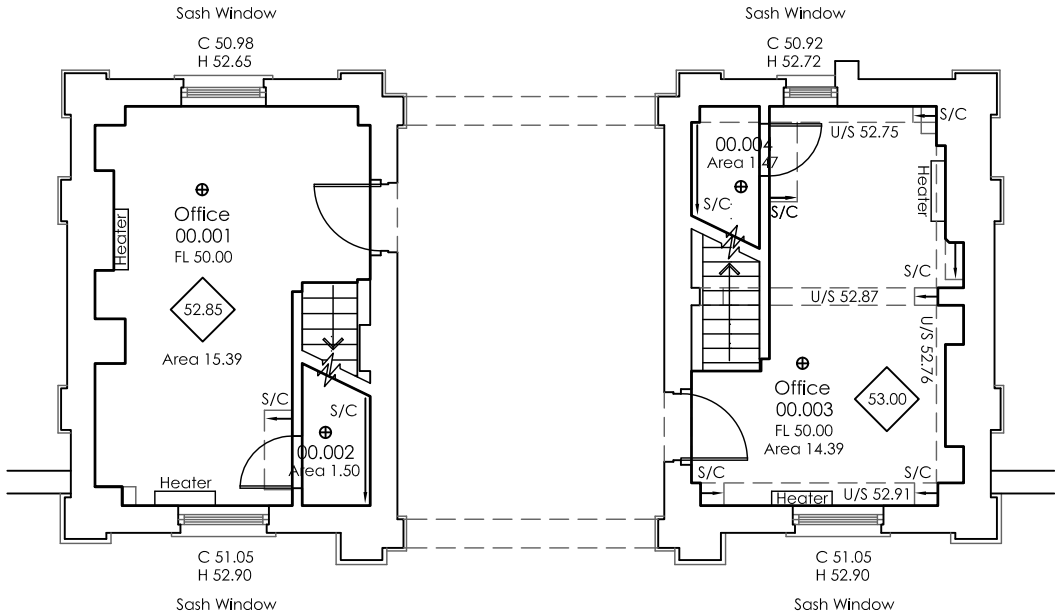


Ground Floor

NIA=32.75
GIA=36.26
GEA=53.34

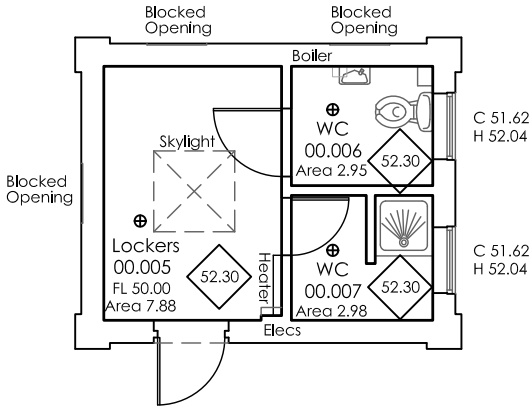


Toilet Block

NIA=10.86
GIA=14.62
GEA=19.87

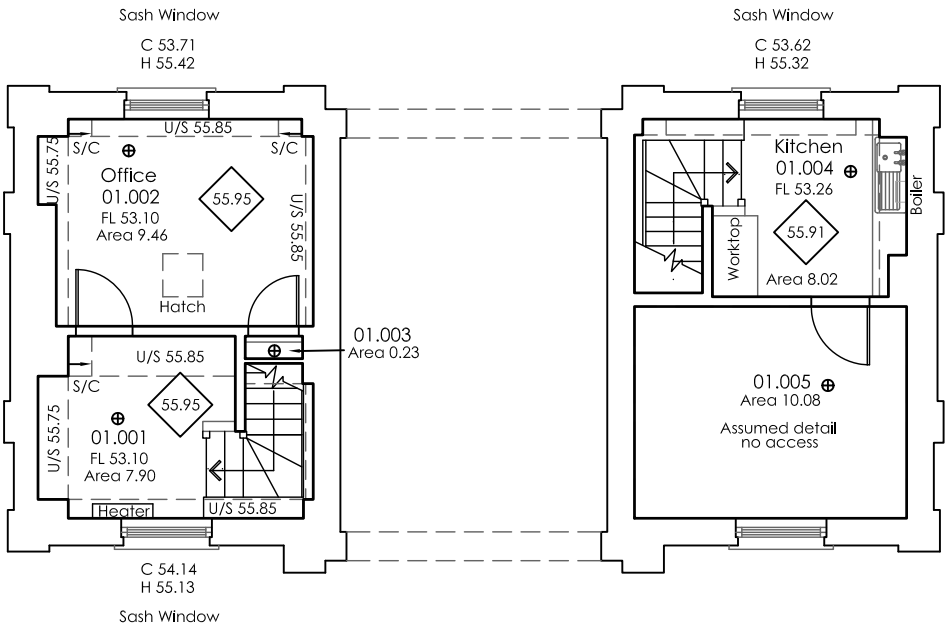

First Floor

NIA=35.69
GIA=36.94
GEA=53.27

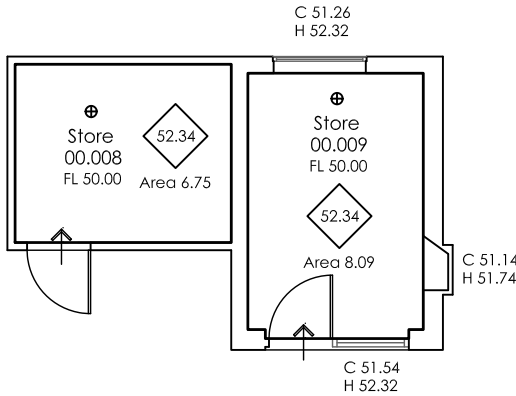

Bike Store

NIA=14.84
GIA=15.34
GEA=18.53