



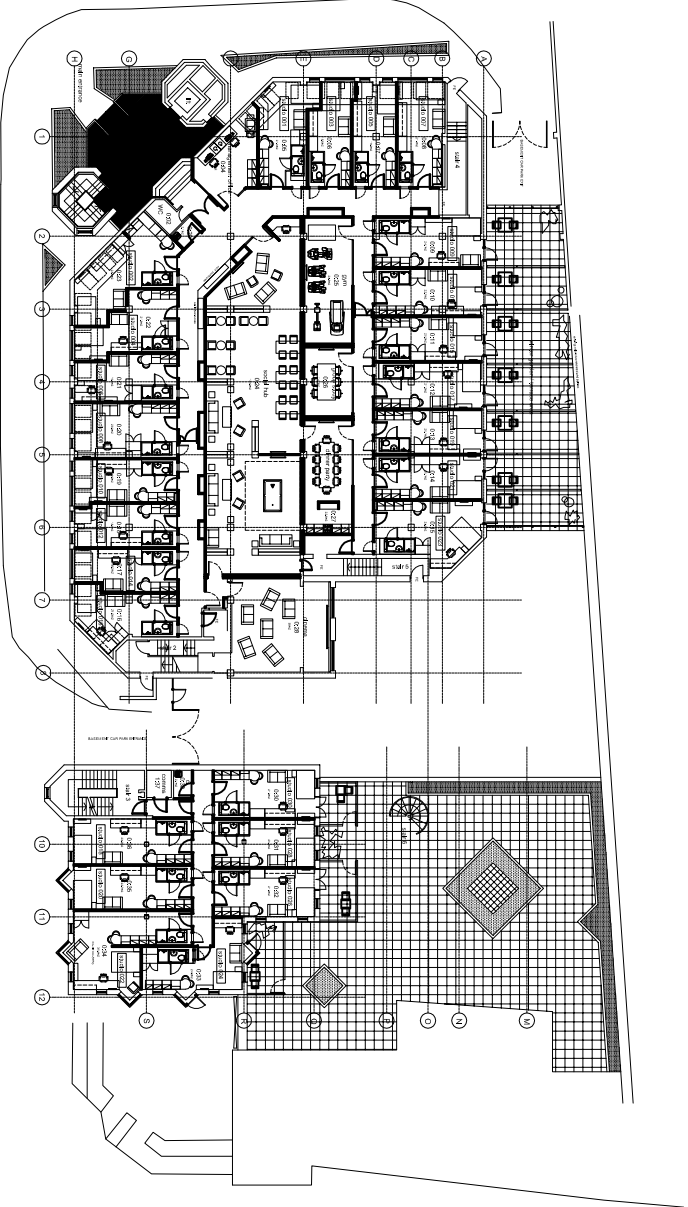

14038_110 PROP LO / 01
ST GILES HOUSE - PROPOSED LEVEL 0 PLAN
Scale 1:500

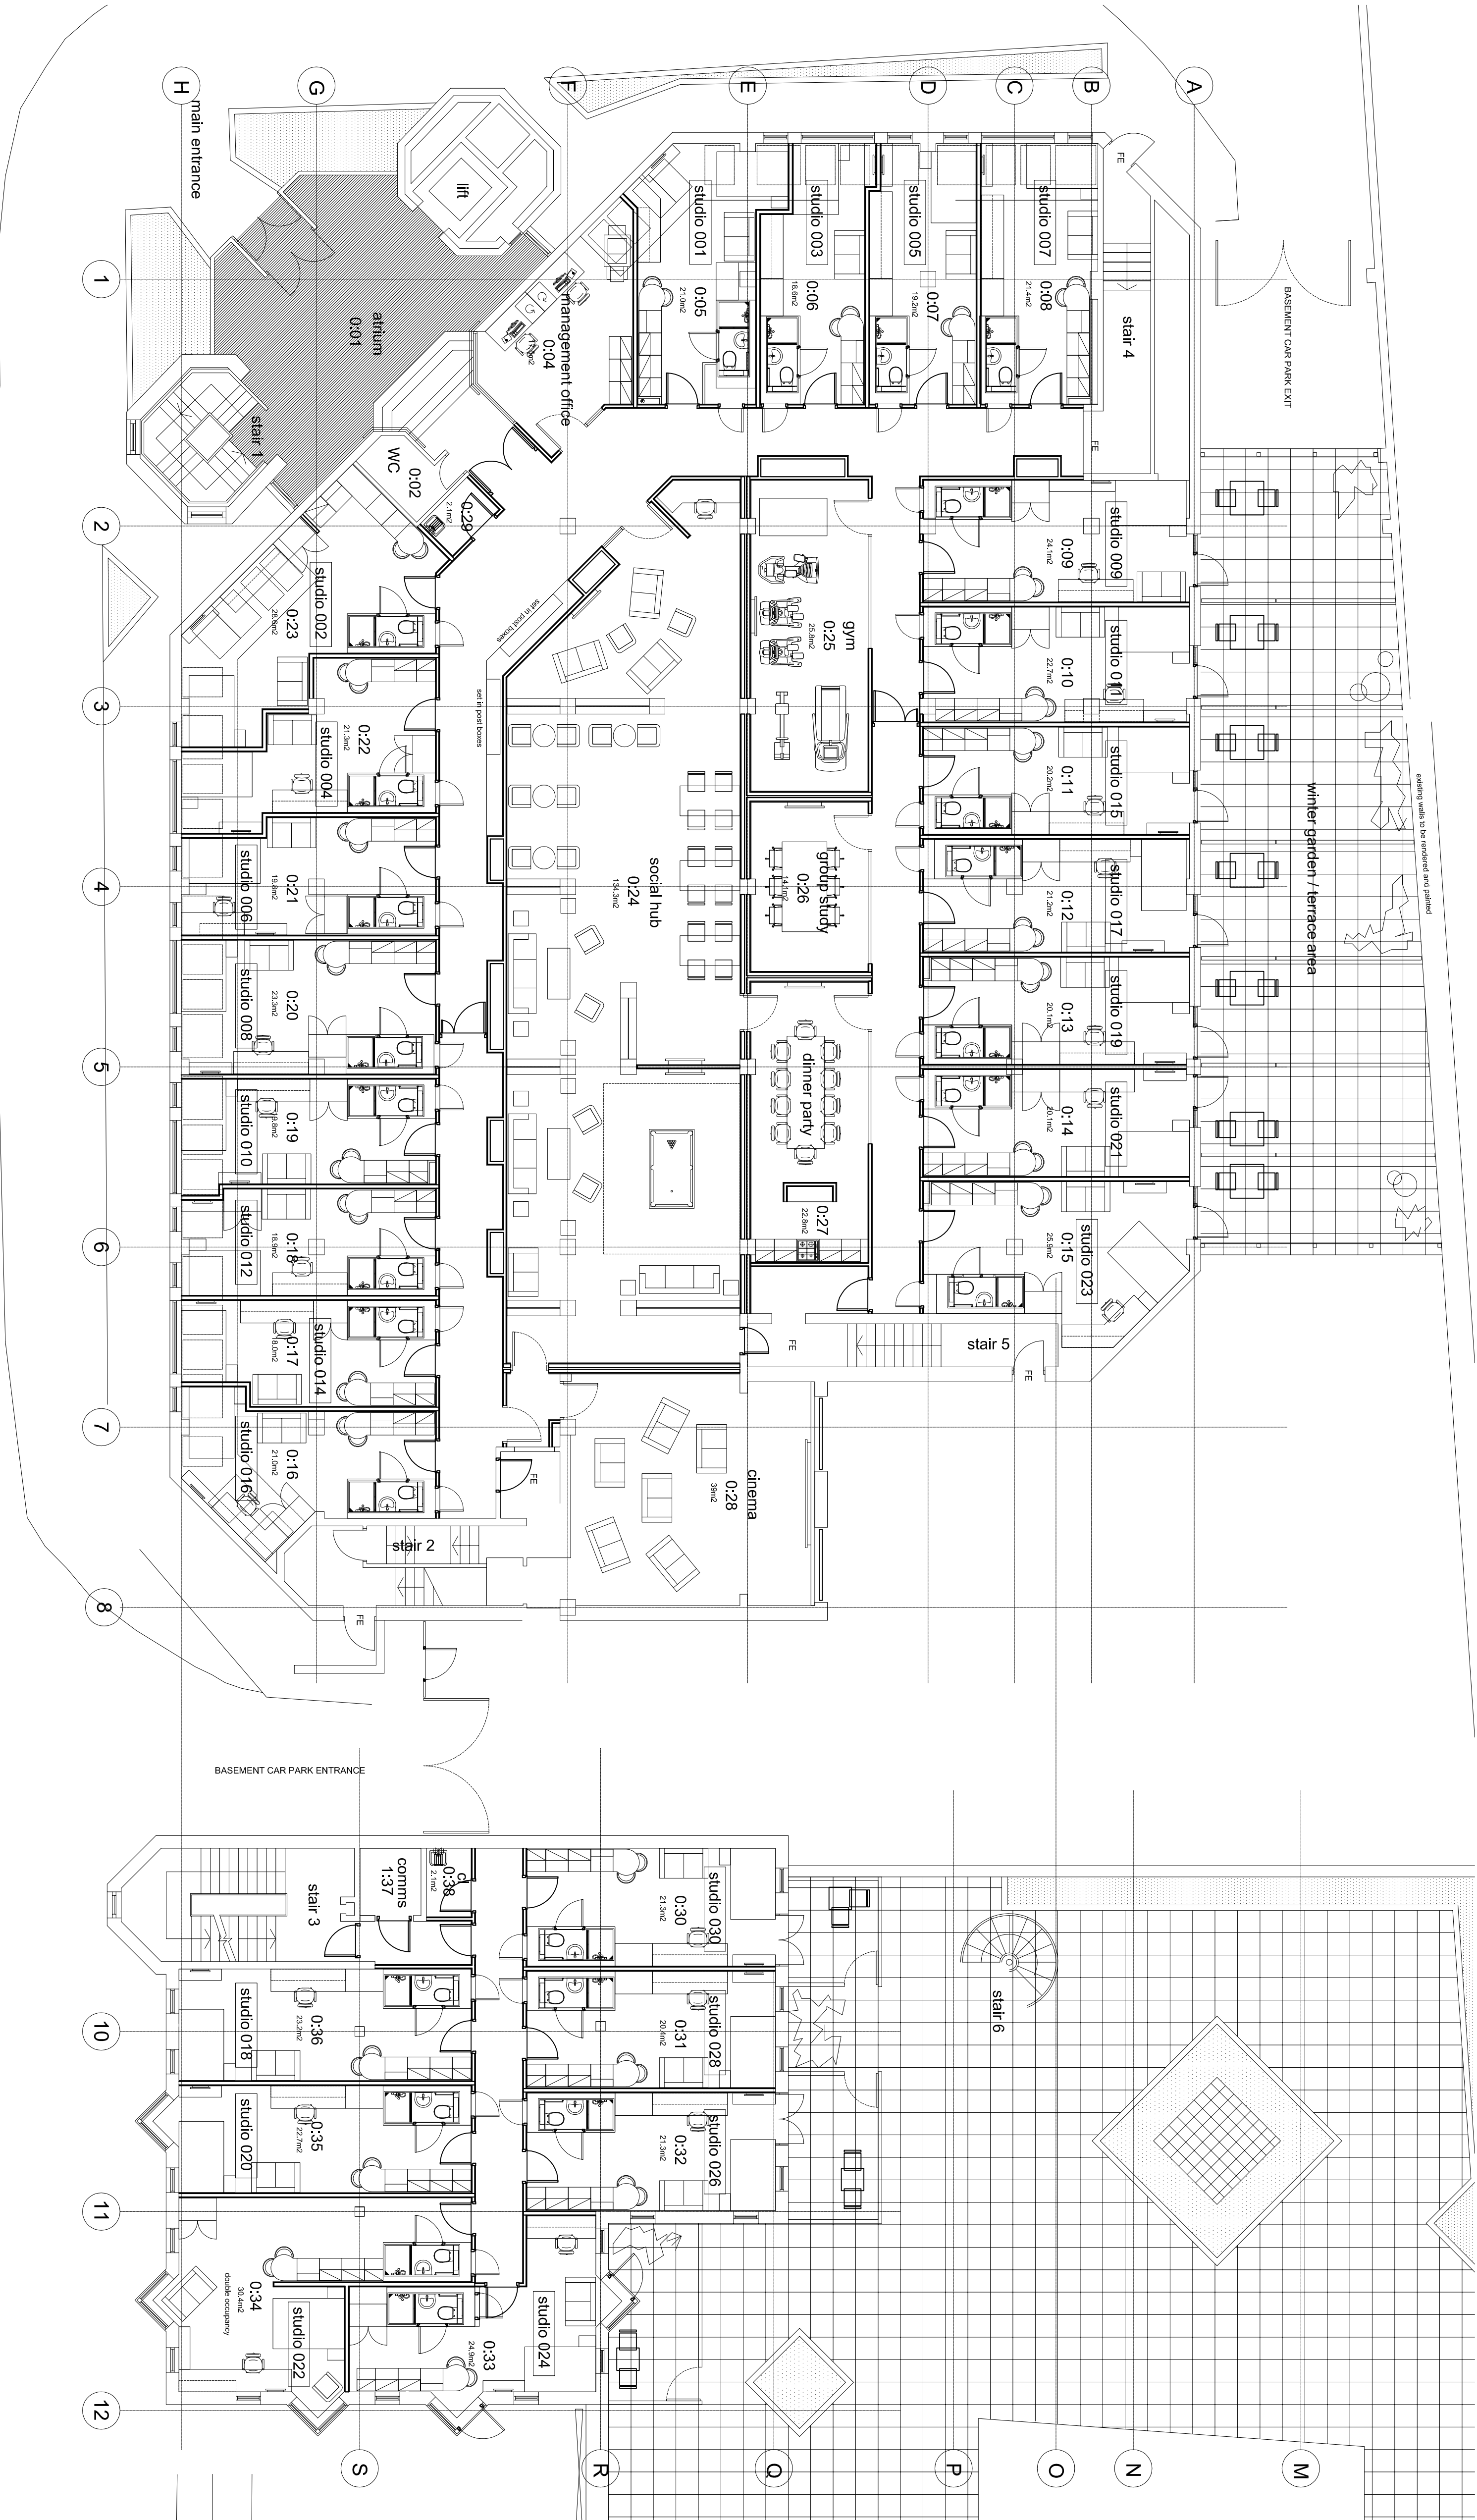

- GENERAL NOTES
1. This drawing is copyright and must not be reproduced without the consent of Greenwell Design Ltd.
 2. All dimensions are in millimeters unless otherwise noted.
 3. Do not scale from this drawing - if in doubt ask.
 4. Any information based on site prior to commencement of work or preparation of this drawing is for reference only and should not be relied upon for construction.
 5. The contractor shall report any discrepancies in information in writing to the design team at the earliest opportunity.
 6. This drawing is to be read in conjunction with the following relevant information:
 - a) All architecture and structural engineers drawings and specifications.
 - b) All CDM information including designers risk assessments.

revision	notes	status	date	author	reviewer
M	RECORD DRAWING ISSUE	P	2015.03.17	MB	-
L	studio signage numbers added	P	2015.03.04	MB	-
K	7th pool table setting out indicated	P	2015.06.17	MB	-
J	Studios 0:16 and 0:17 amended to reflect site	P	2015.06.15	MB	-
I	Summertime indicated where required	P	2015.03.25	MB	-
H	TENDER ISSUE STAGE 2	P	2015.03.13	MB	-
G	Plans updated to reflect comments received DTM	P	2015.03.10	MB	DAS
F	- reduced spec for corridor social hub walls	P	2015.02.23	MB	DAS
E	- retained external garden / terrace doors to be retained	P	2015.02.14	MB	-
D	- TENDER ISSUE - reflect comments from M&E	P	2015.02.14	MB	-
C	Layout updated to reflect comments received	P	2015.02.03	MB	-
B	ROOM LAYOUTS INDICATED	P	2015.01.26	MB	-
A	PD APPLICATION ISSUE	P	2015.01.25	MB	-
-	First Issue	P	2015.01.16	MB	TS

Bywater Capital (St Giles) Ltd
46 James Street
London W1U 1EZ
United Kingdom

STUDIOS

design
architecture
interiors
urban design
masterplanning
graphic design
conservation

St Giles House,
Reading
PROPOSED LEVEL 0
26 No. (C3 Residential)

Studio 2, Riverside Centre, Farnfield Lane, Dinning, DH1 5TA
t: 01931 447 1775
www.greenwelldesign.co.uk

Project
St Giles House,
Reading
PROPOSED LEVEL 0
26 No. (C3 Residential)

Scale	Job no.	Status	Draw no.	Rev.
1:100	14 038	RECORD	110 Prop LO	M
at site A1				

Do not scale. This drawing is copyright