



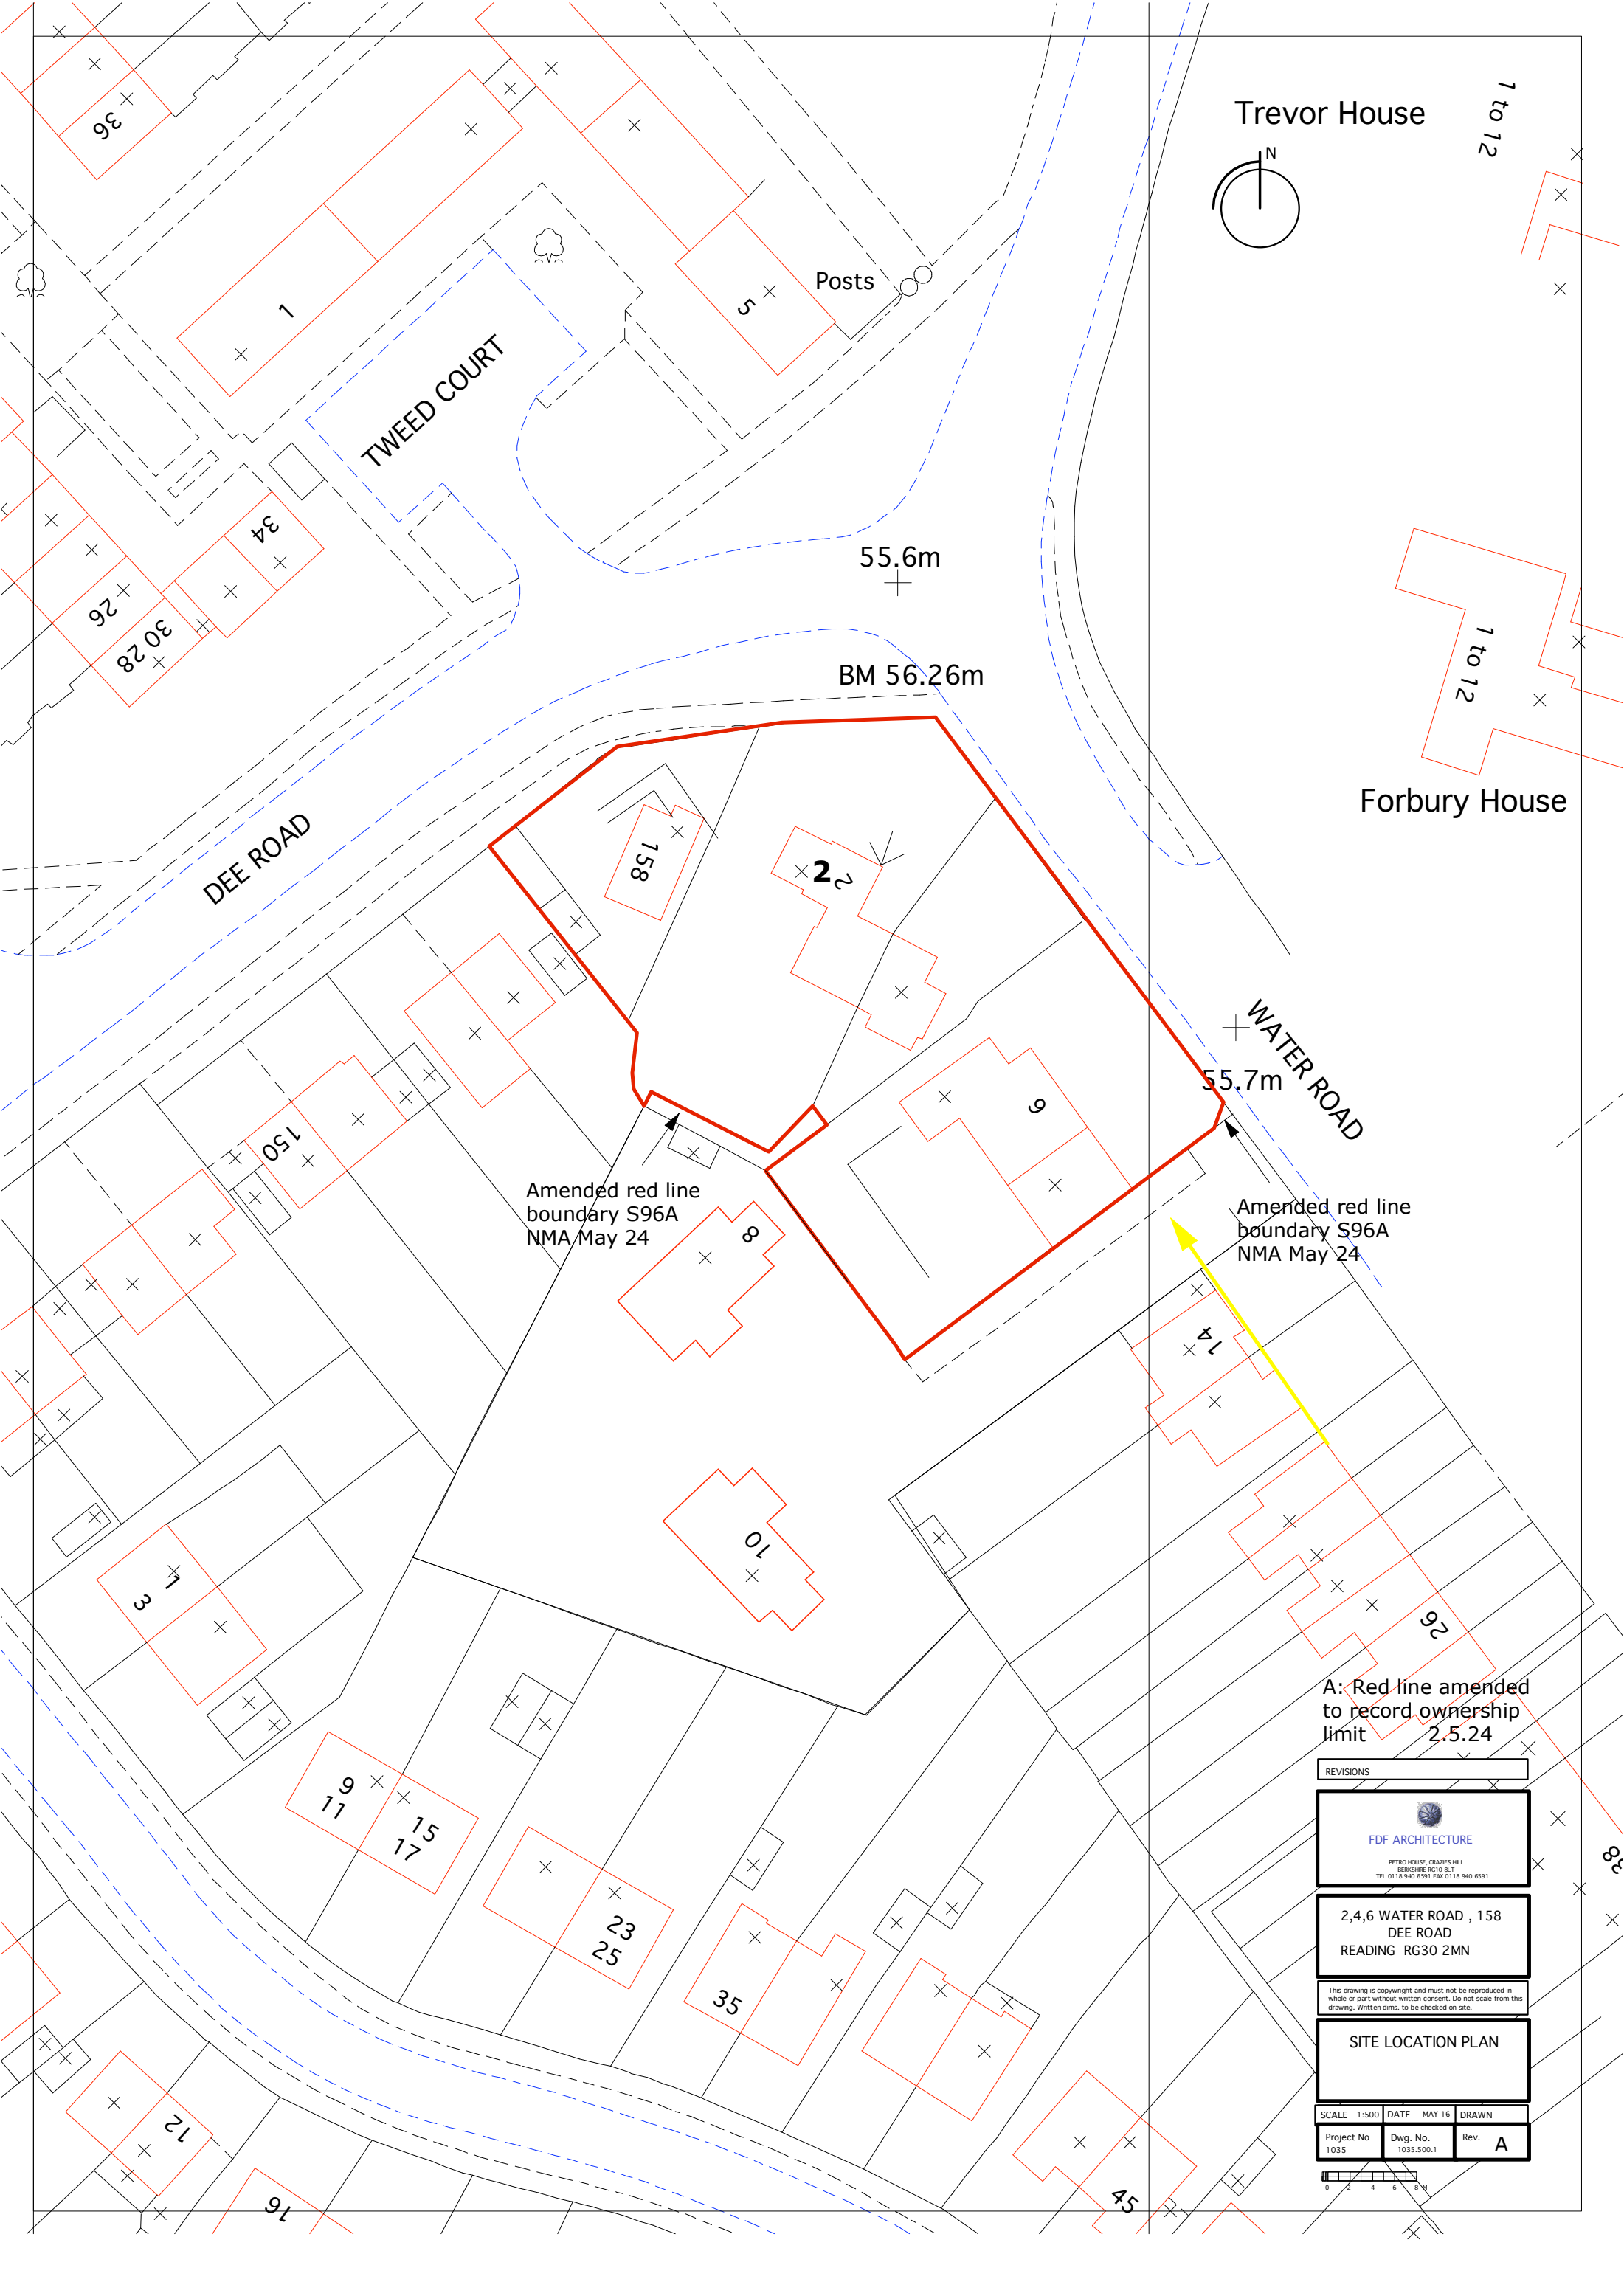

Trevor House

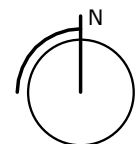

1 to 12

Forbury House

1 to 12

Posts

55.6m

BM 56.26m

55.7m
WATER ROAD

Amended red line
boundary S96A
NMA May 24

Amended red line
boundary S96A
NMA May 24

A: Red line amended to
record ownership
limit 2.5.24

REVISIONS		
 FDF ARCHITECTURE PETRO HOUSE, CRAZIES HILL BERKSHIRE RG10 8LT TEL 0118 940 6591 FAX 0118 940 6591		
2,4,6 WATER ROAD , 158 DEE ROAD READING RG30 2MN		
This drawing is copyright and must not be reproduced in whole or part without written consent. Do not scale from this drawing. Written dims. to be checked on site.		
SITE LOCATION PLAN		
SCALE 1:500	DATE MAY 16	DRAWN
Project No 1035	Dwg. No. 1035.500.1	Rev. A

