


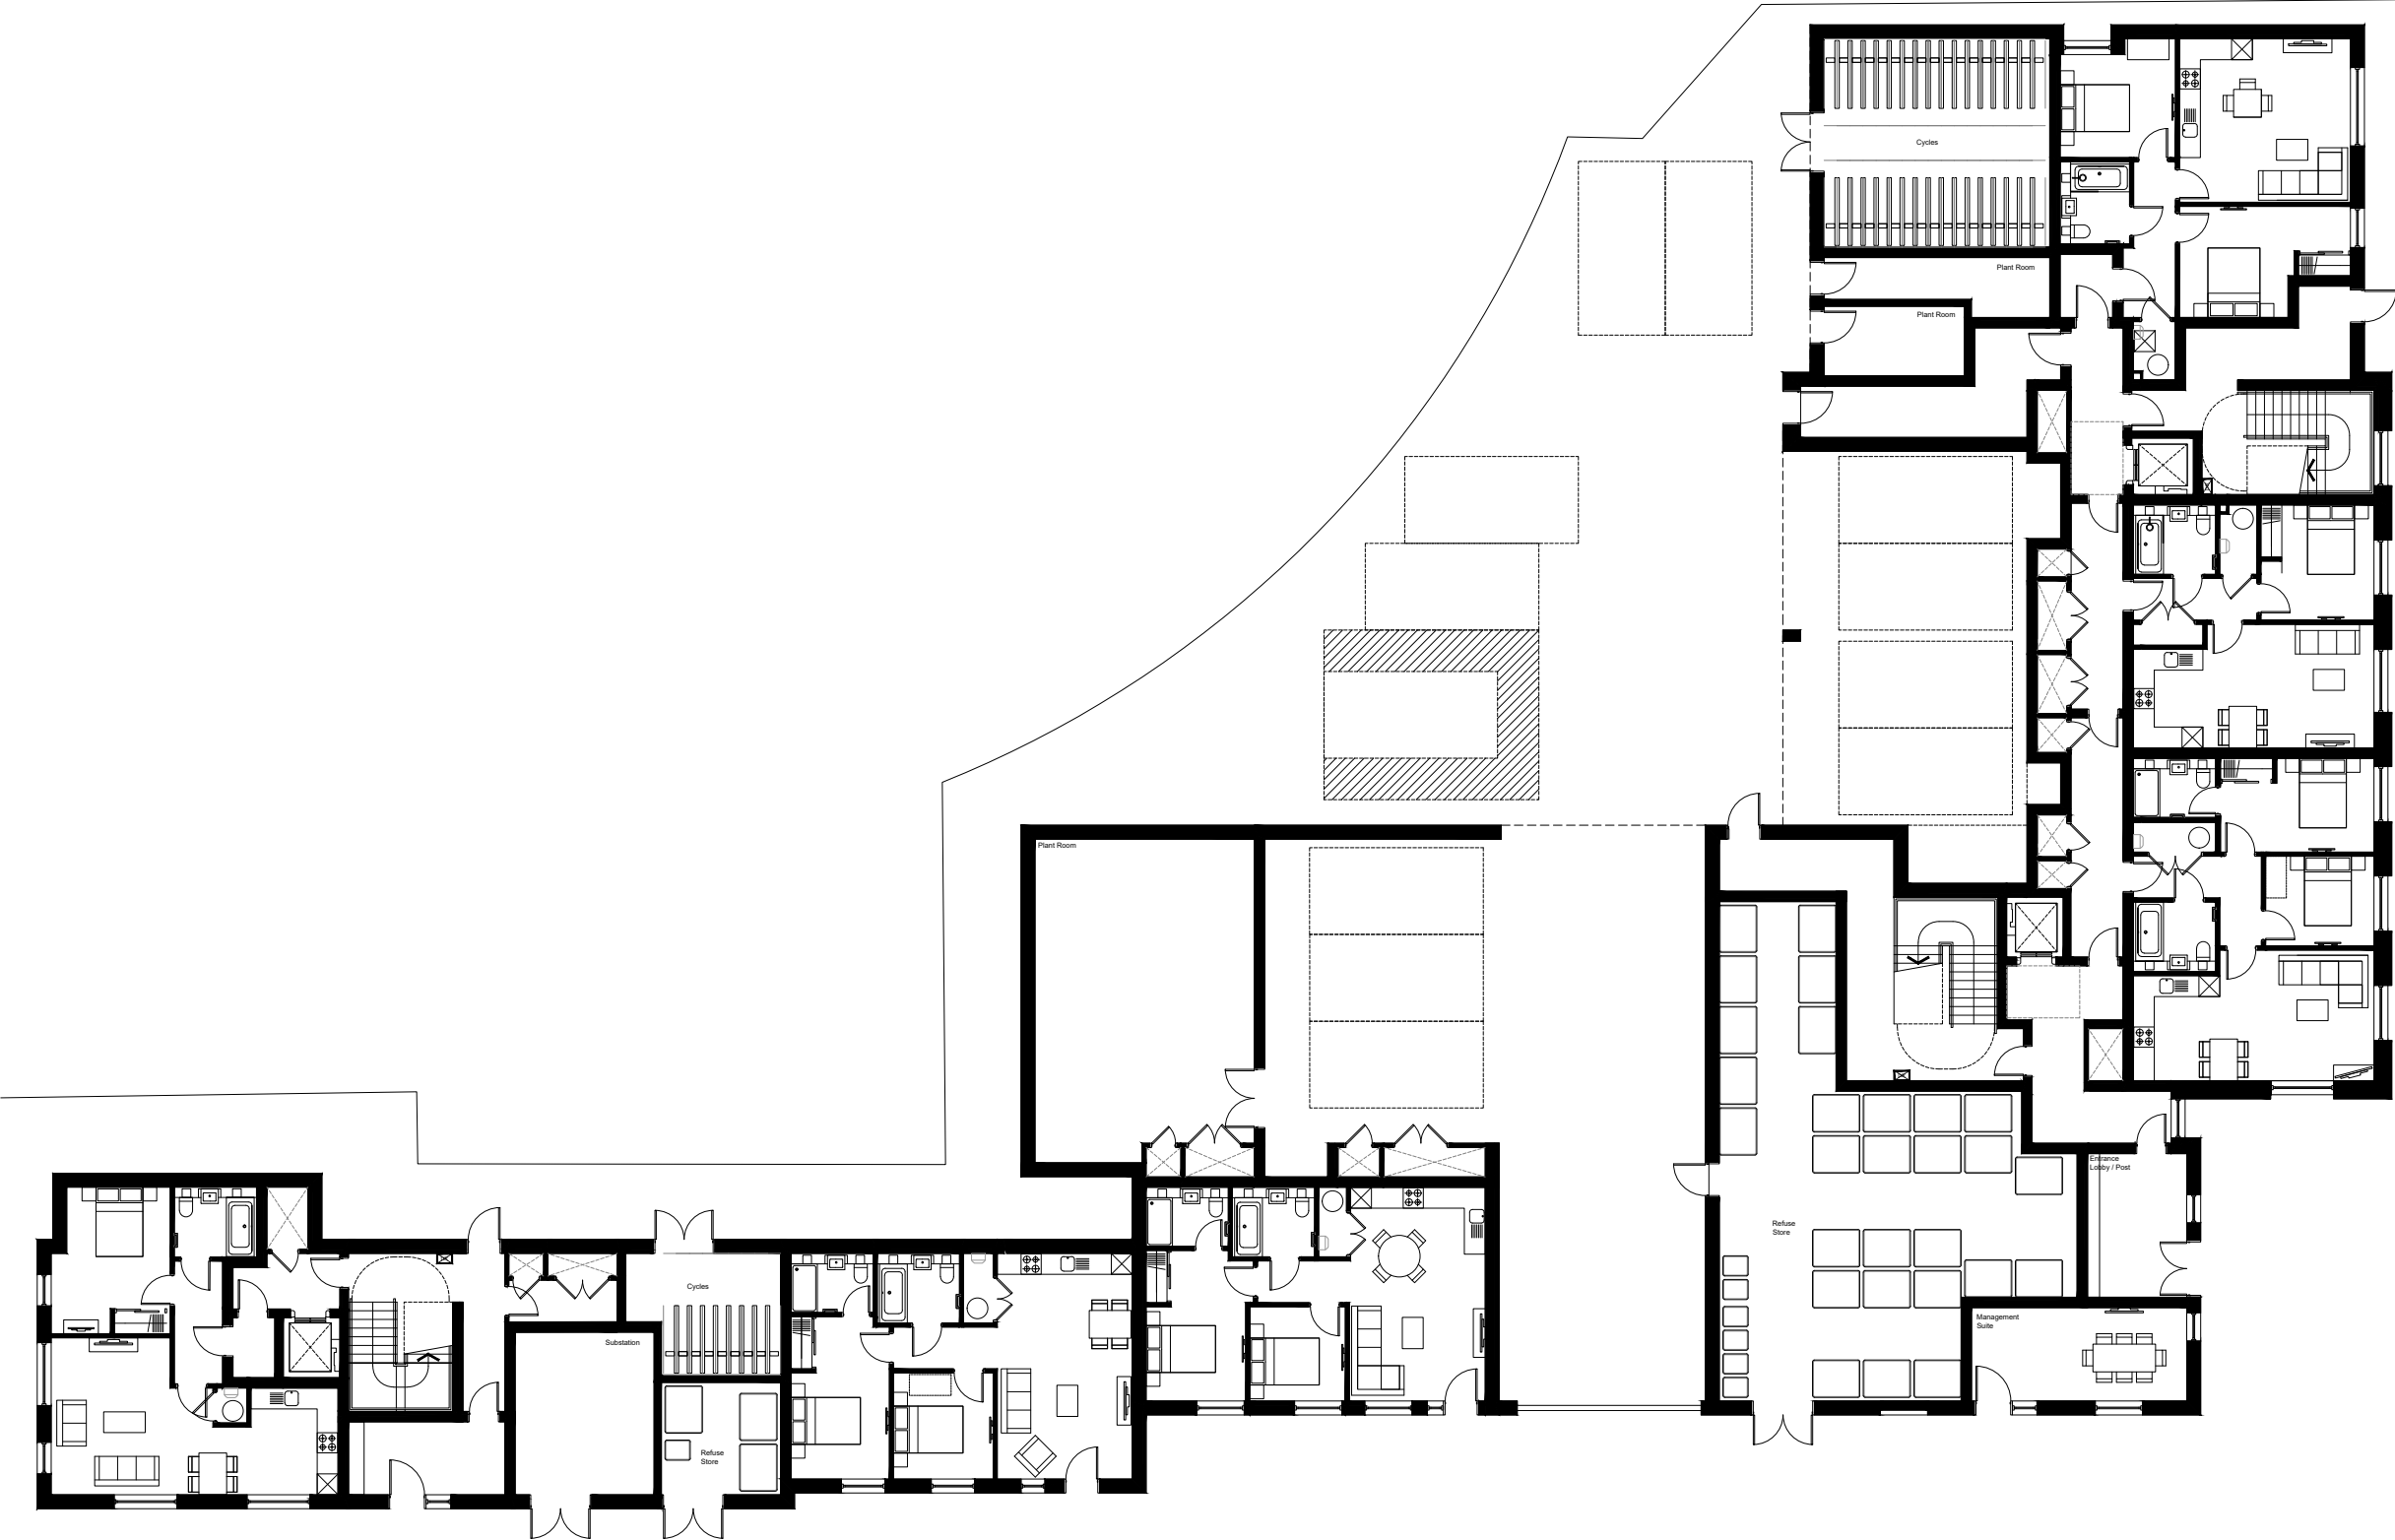

Ground Floor Plan

key plan

notes

A 20.04.20 EE Added glazing next to a door on one apartment

B 10.06.20 EE Added cycle storage

C 08.09.20 DT Cycle storage, refuse, parking updated

D 10.11.20 DT Lobby to cycle and refuse store added

E 09.10.23 PO Fire strategy review

F 11.10.23 EE Fire strategy review

G 08.11.23 EE Refuse store added

H 21.12.23 ISB Fire strategy update

I 29.02.24 EE Refuse store update

revision

date

prepared

description

Berkeley

Designed for life

Berkeley House  
Fornham Lane  
Fornham Royal  
Suffolk IP20 9JQ

T: 01753 784400  
F: 01753 648305  
www.berkeleygroup.co.uk

project

Vastern Road  
Reading

drawing

Block B and C  
Ground Floor Plan

date

October 2019

scale @ a1

1:100

drawn

ISB


drawing number

448.PL.BC.100

revision

I

0 1 5 10m

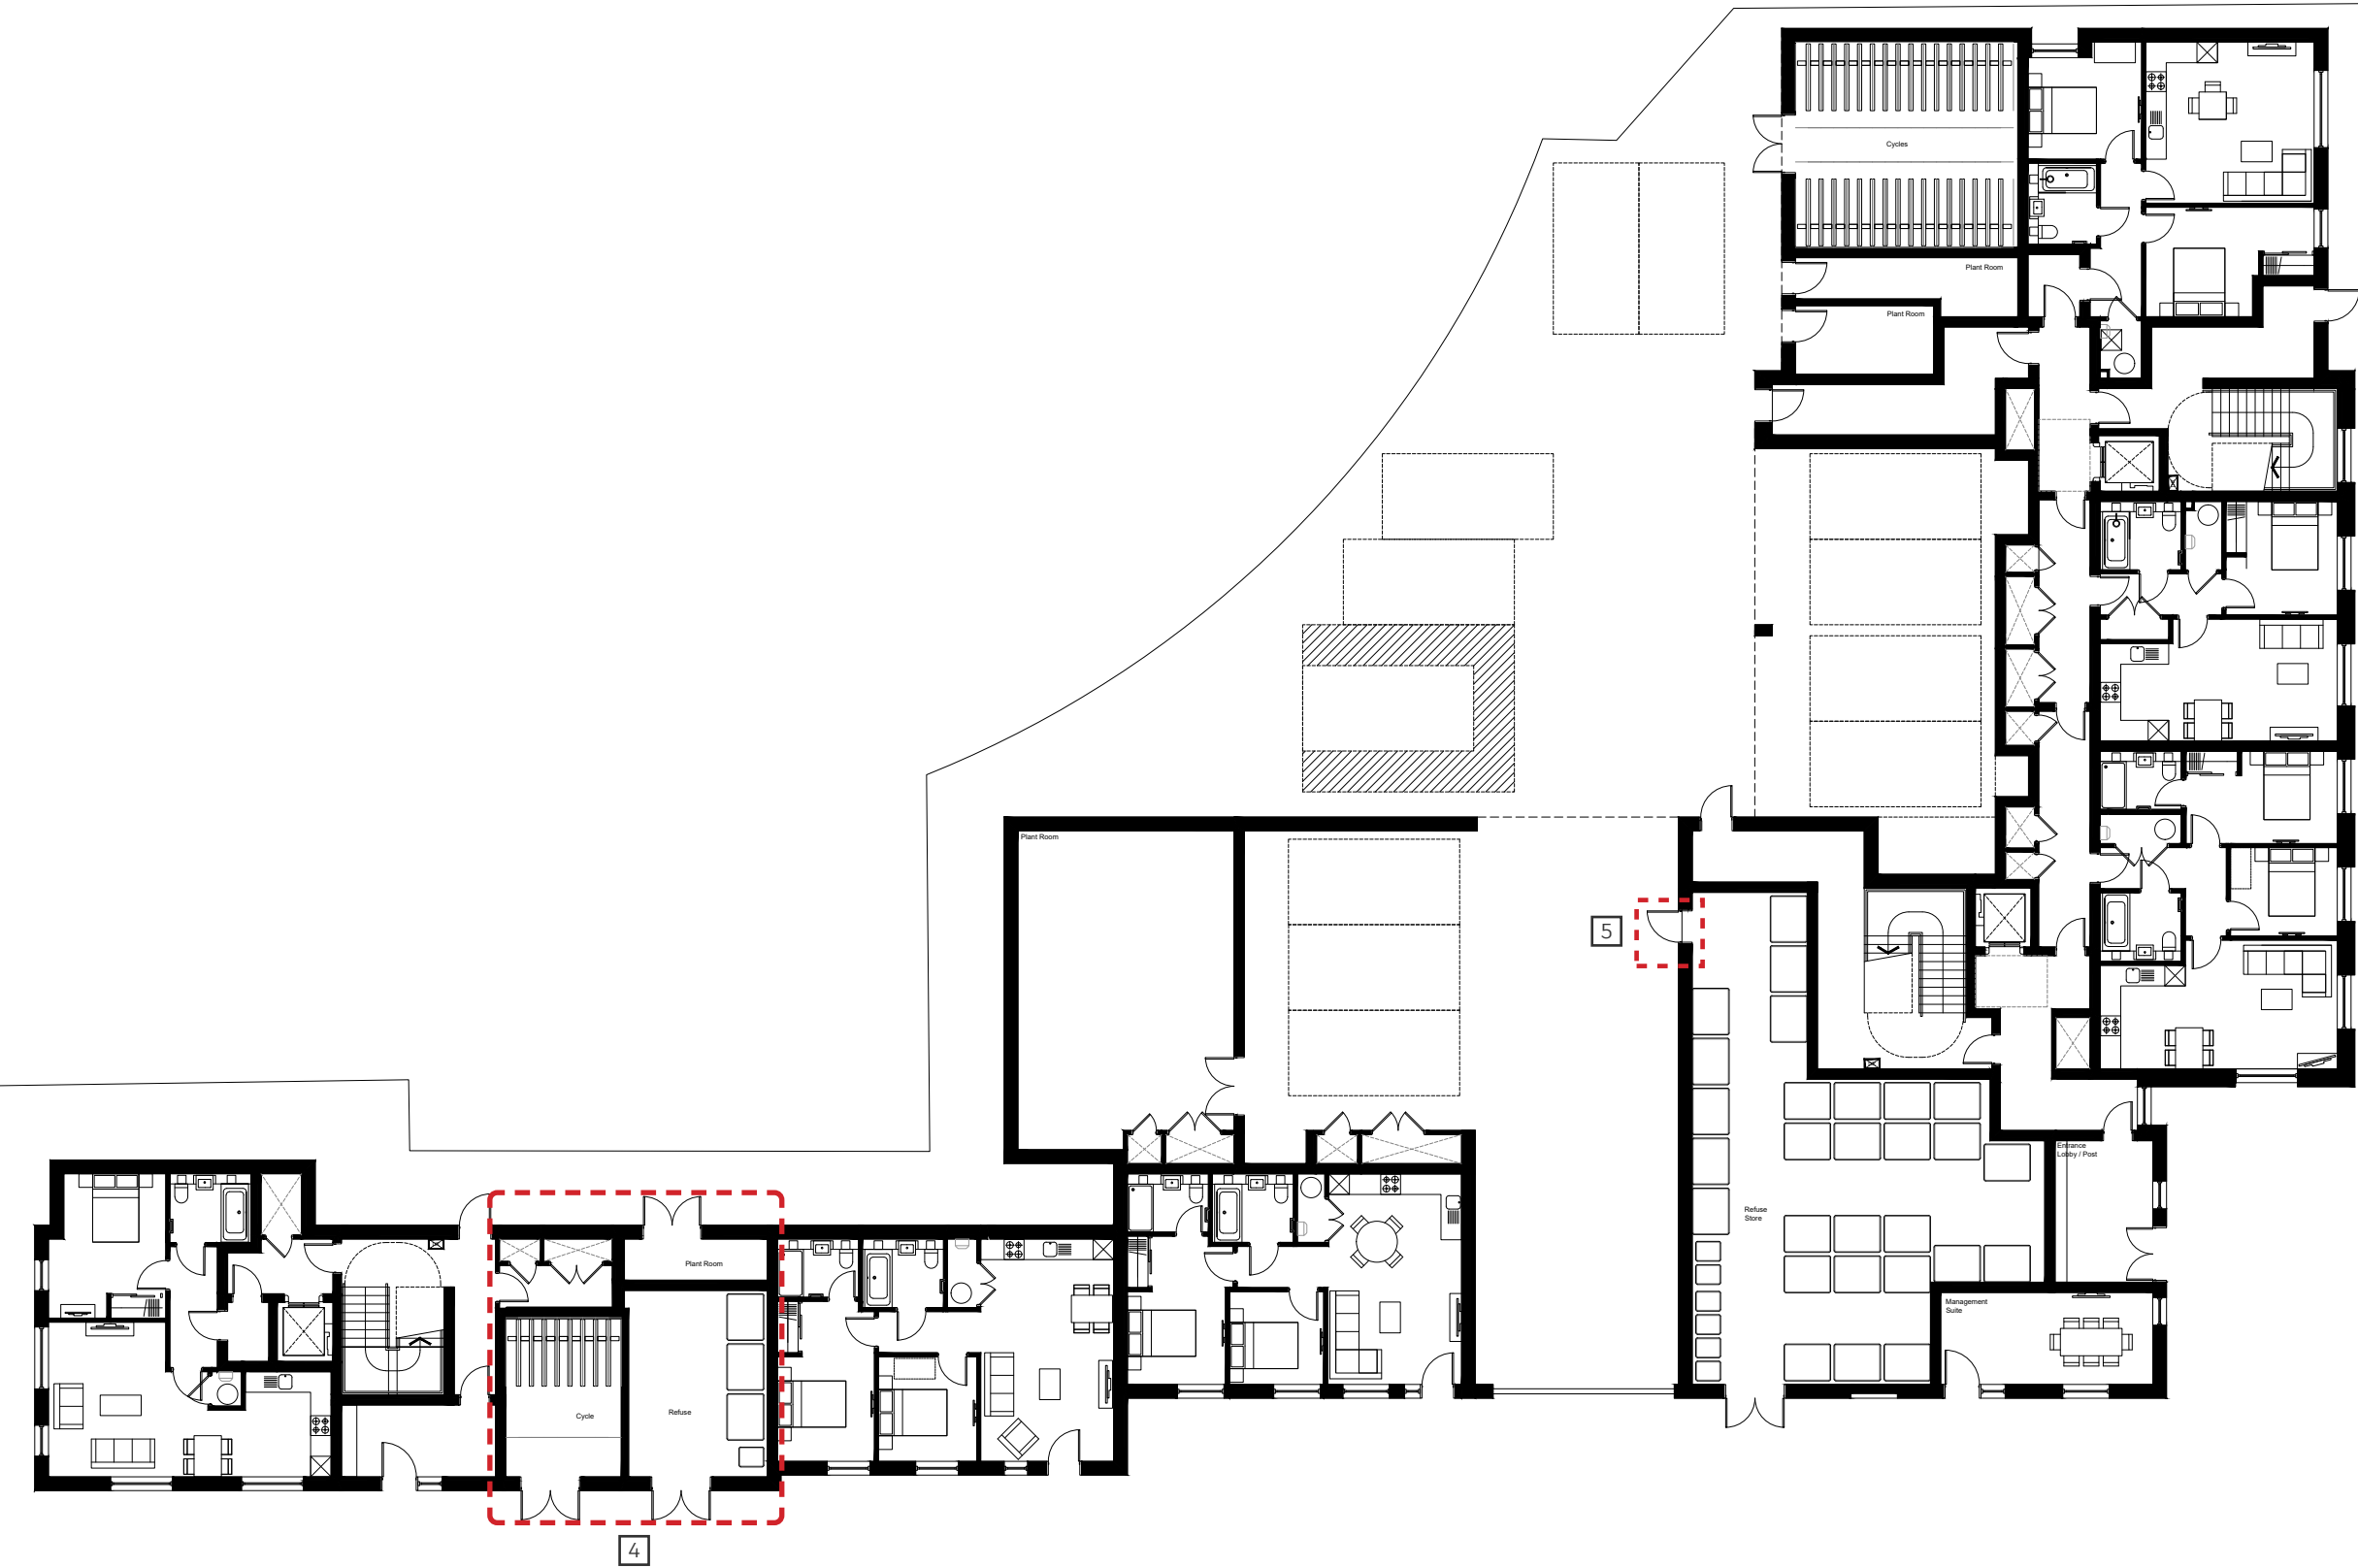

key plan

notes

- Updates:
- 4. Substation removed from block C and cycle store moved to the front of the block.
  - 5. Refuse door moved closer to the staircore.

|   |          |     |                                               |
|---|----------|-----|-----------------------------------------------|
| A | 30.04.20 | EE  | Added glazing next to a door on one apartment |
| B | 10.08.20 | EE  | Added cycle storage                           |
| C | 08.09.20 | DT  | Cycle storage, refuse, parking updated        |
| D | 10.11.20 | DT  | Layout to cycle and refuse store added        |
| E | 09.10.23 | PO  | Fire strategy review                          |
| F | 11.10.23 | EE  | Fire strategy review                          |
| G | 08.11.23 | EE  | Red line added                                |
| H | 21.12.23 | ISB | Fire strategy update                          |
| I | 29.02.24 | EE  | Refuse store update                           |
| J | 24.06.24 | PO  | Amendments to Plant Room and Refuse Store     |

| revision | date | prepared | checked |
|----------|------|----------|---------|
|----------|------|----------|---------|

**Berkeley**  
Designed for life

Berkeley House  
Farnham Lane  
Farnham Royal  
SL2 3RQ

T: 01753 784400  
F: 01753 648305  
www.berkeleygroup.co.uk

project  
Vastern Road  
Reading

drawing  
Block B and C  
Ground Floor Plan

date  
October 2019

scale @ a1  
1:100


drawn  
ISB

drawing number  
448.PL.BC.100

revision  
J

Ground Floor Plan



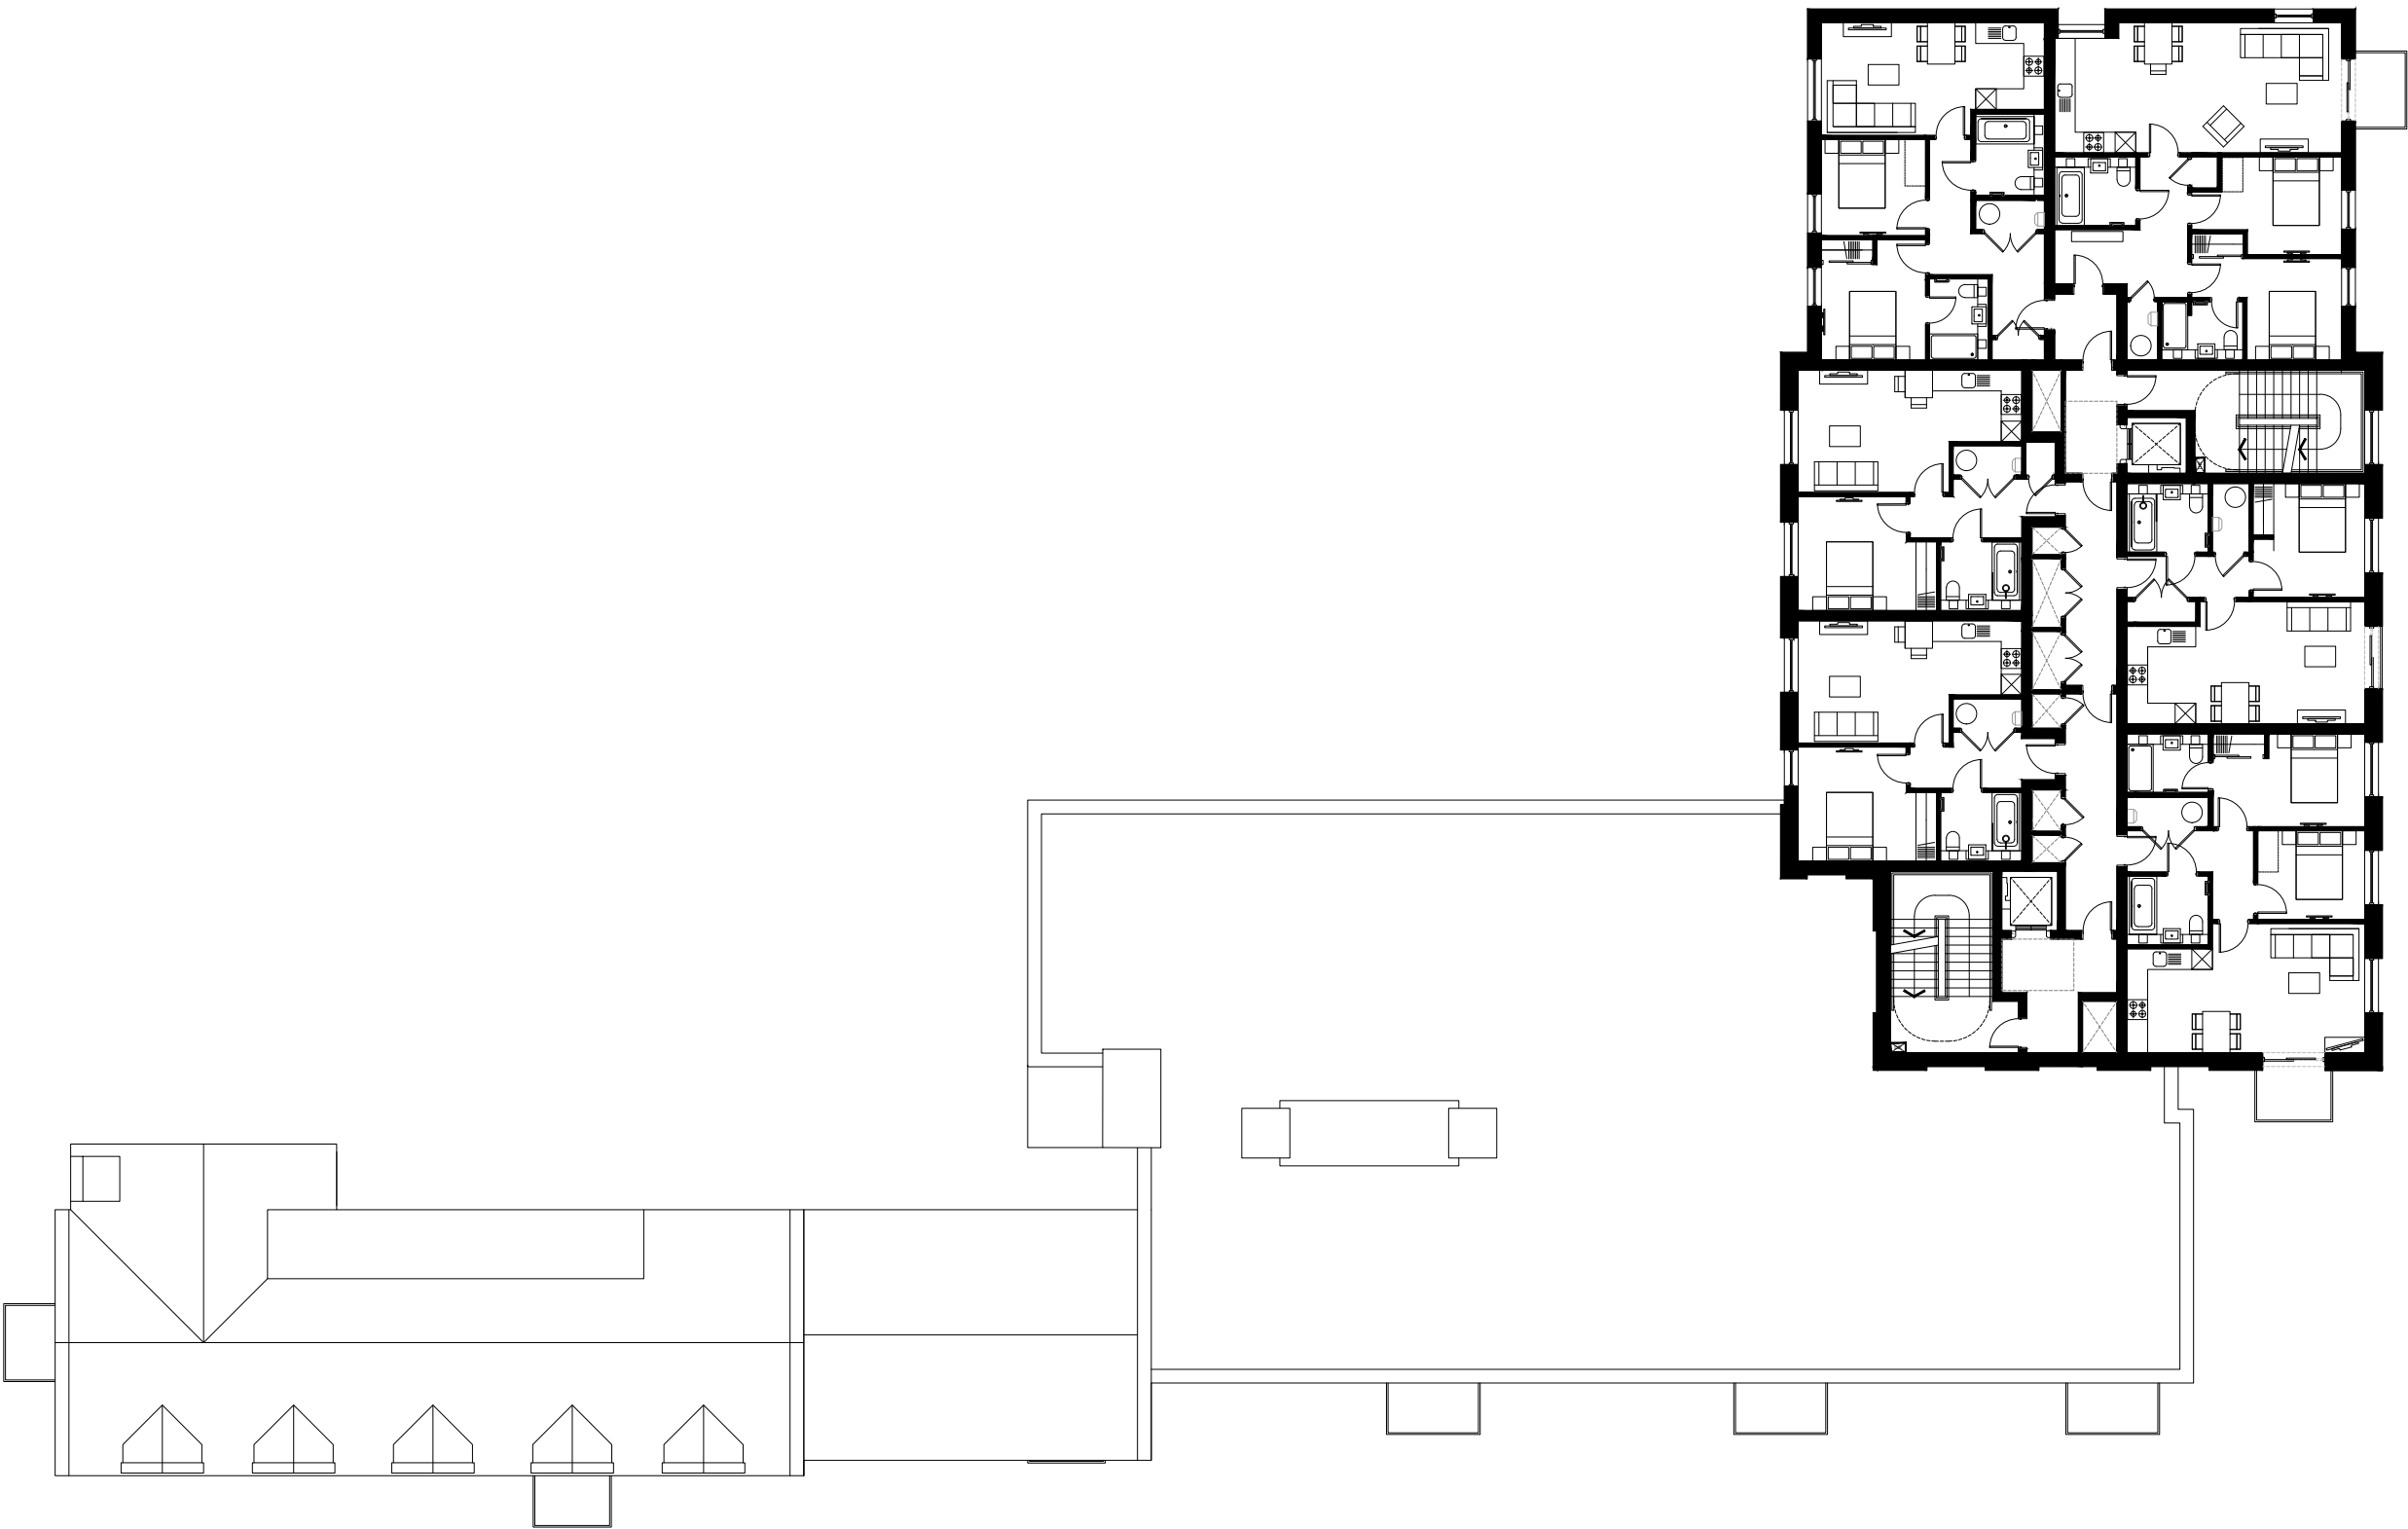

Fifth Floor Plan

key plan

notes

A 30.04.20 EE Removed balconies

B 06.09.20 DT Cycle storage updated, added dormer on block C

C 09.10.23 PD Fire strategy review

D 11.10.23 EE Fire strategy review

E 21.12.23 ISB Fire strategy update

revision

date

prepared

checked

Berkeley

Designed for life

Berkeley House

Furnham Lane

Furnham Royal

SL2 3RQ

T: 01753 784400

F: 01753 648305

www.berkeleygroup.co.uk

project

Vastern Road

Reading

drawing

Block B and C

Fifth Floor Plan

date

October 2019

scale @ a1

1:100

drawn

ISB

drawing number

448.PL.BC.105

revision

E



key plan

notes

Updates:

6. Roof access window added.

|   |          |     |                                                |
|---|----------|-----|------------------------------------------------|
| A | 30.04.20 | EE  | Removed balconies                              |
| B | 08.09.20 | DT  | Cycle storage updated, added dormer on block C |
| C | 05.10.23 | PT  | Fire strategy review                           |
| D | 11.10.23 | EE  | Fire strategy review                           |
| E | 21.12.23 | ISB | Fire strategy update                           |
| F | 03.07.24 | EE  | Roof access window added                       |

| revision | date | prepared | description |
|----------|------|----------|-------------|
|----------|------|----------|-------------|

**Berkeley**  
Designed for life

Berkeley House  
Farnham Lane  
Farnham Royal  
SL2 3RQ

T: 01753 784400  
F: 01753 648305  
www.berkeleygroup.co.uk

project:  
Vastern Road  
Reading


drawing:  
Block B and C  
Fifth Floor Plan

|              |            |       |
|--------------|------------|-------|
| date         | scale @ a1 | drawn |
| October 2019 | 1:100      | ISB   |

|                |          |
|----------------|----------|
| drawing number | revision |
| 448.PL.BC.105  | F        |

Fifth Floor Plan



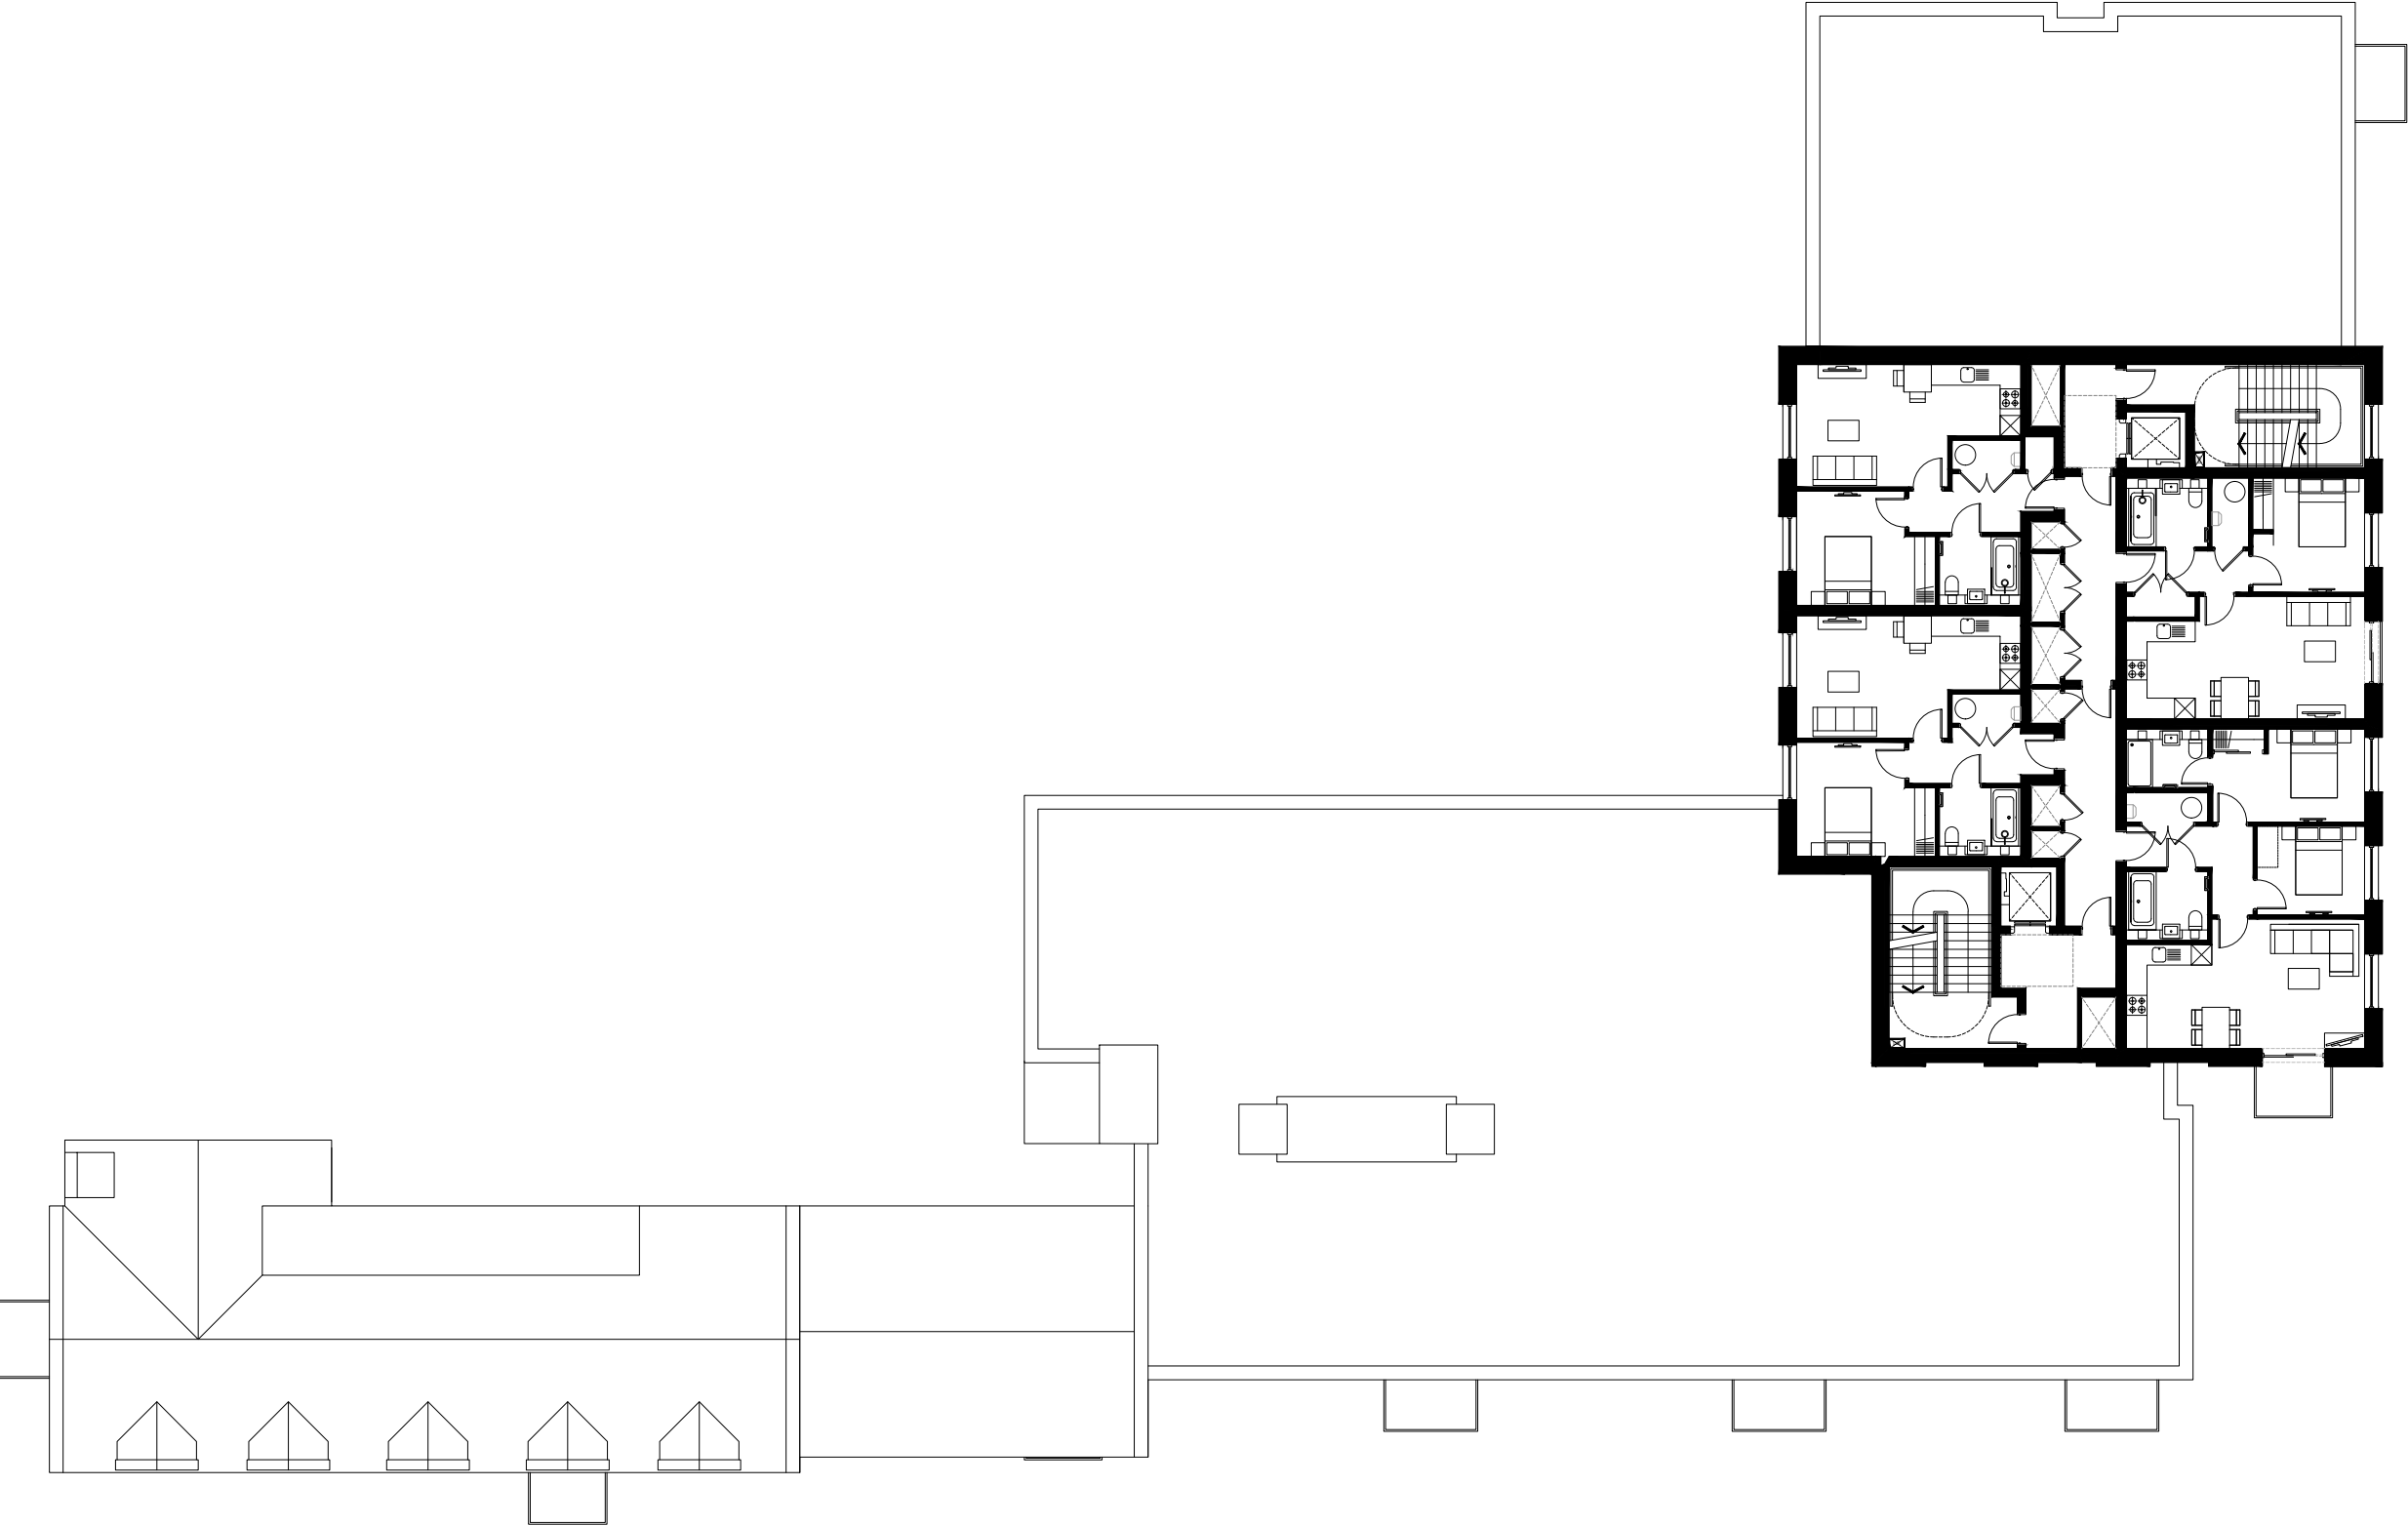

Ninth Floor Plan

key plan

notes

A30.04.20EERemoved balconies

B08.09.20DTCycle storage updated, added dormer on block C

C05.10.23P2Fire strategy review

D11.10.23EEFire strategy review

E25.10.23P2Replaced two 1 bed apts in block B with one 3 bed apt

F21.12.23ISBFire strategy update

revision

date

prepared

checked

Berkeley

Designed for life

Berkeley House

Furnham Lane

Furnham Royal

SL2 3RQ

T: 01753 784400

F: 01753 648305

www.berkeleygroup.co.uk

project

Vastern Road

Reading

drawing

Block B and C

Ninth Floor Plan

date

October 2019

scale @ a1

1:100

drawn

ISB


drawing number

448.PL.BC.109

revision

F

015m

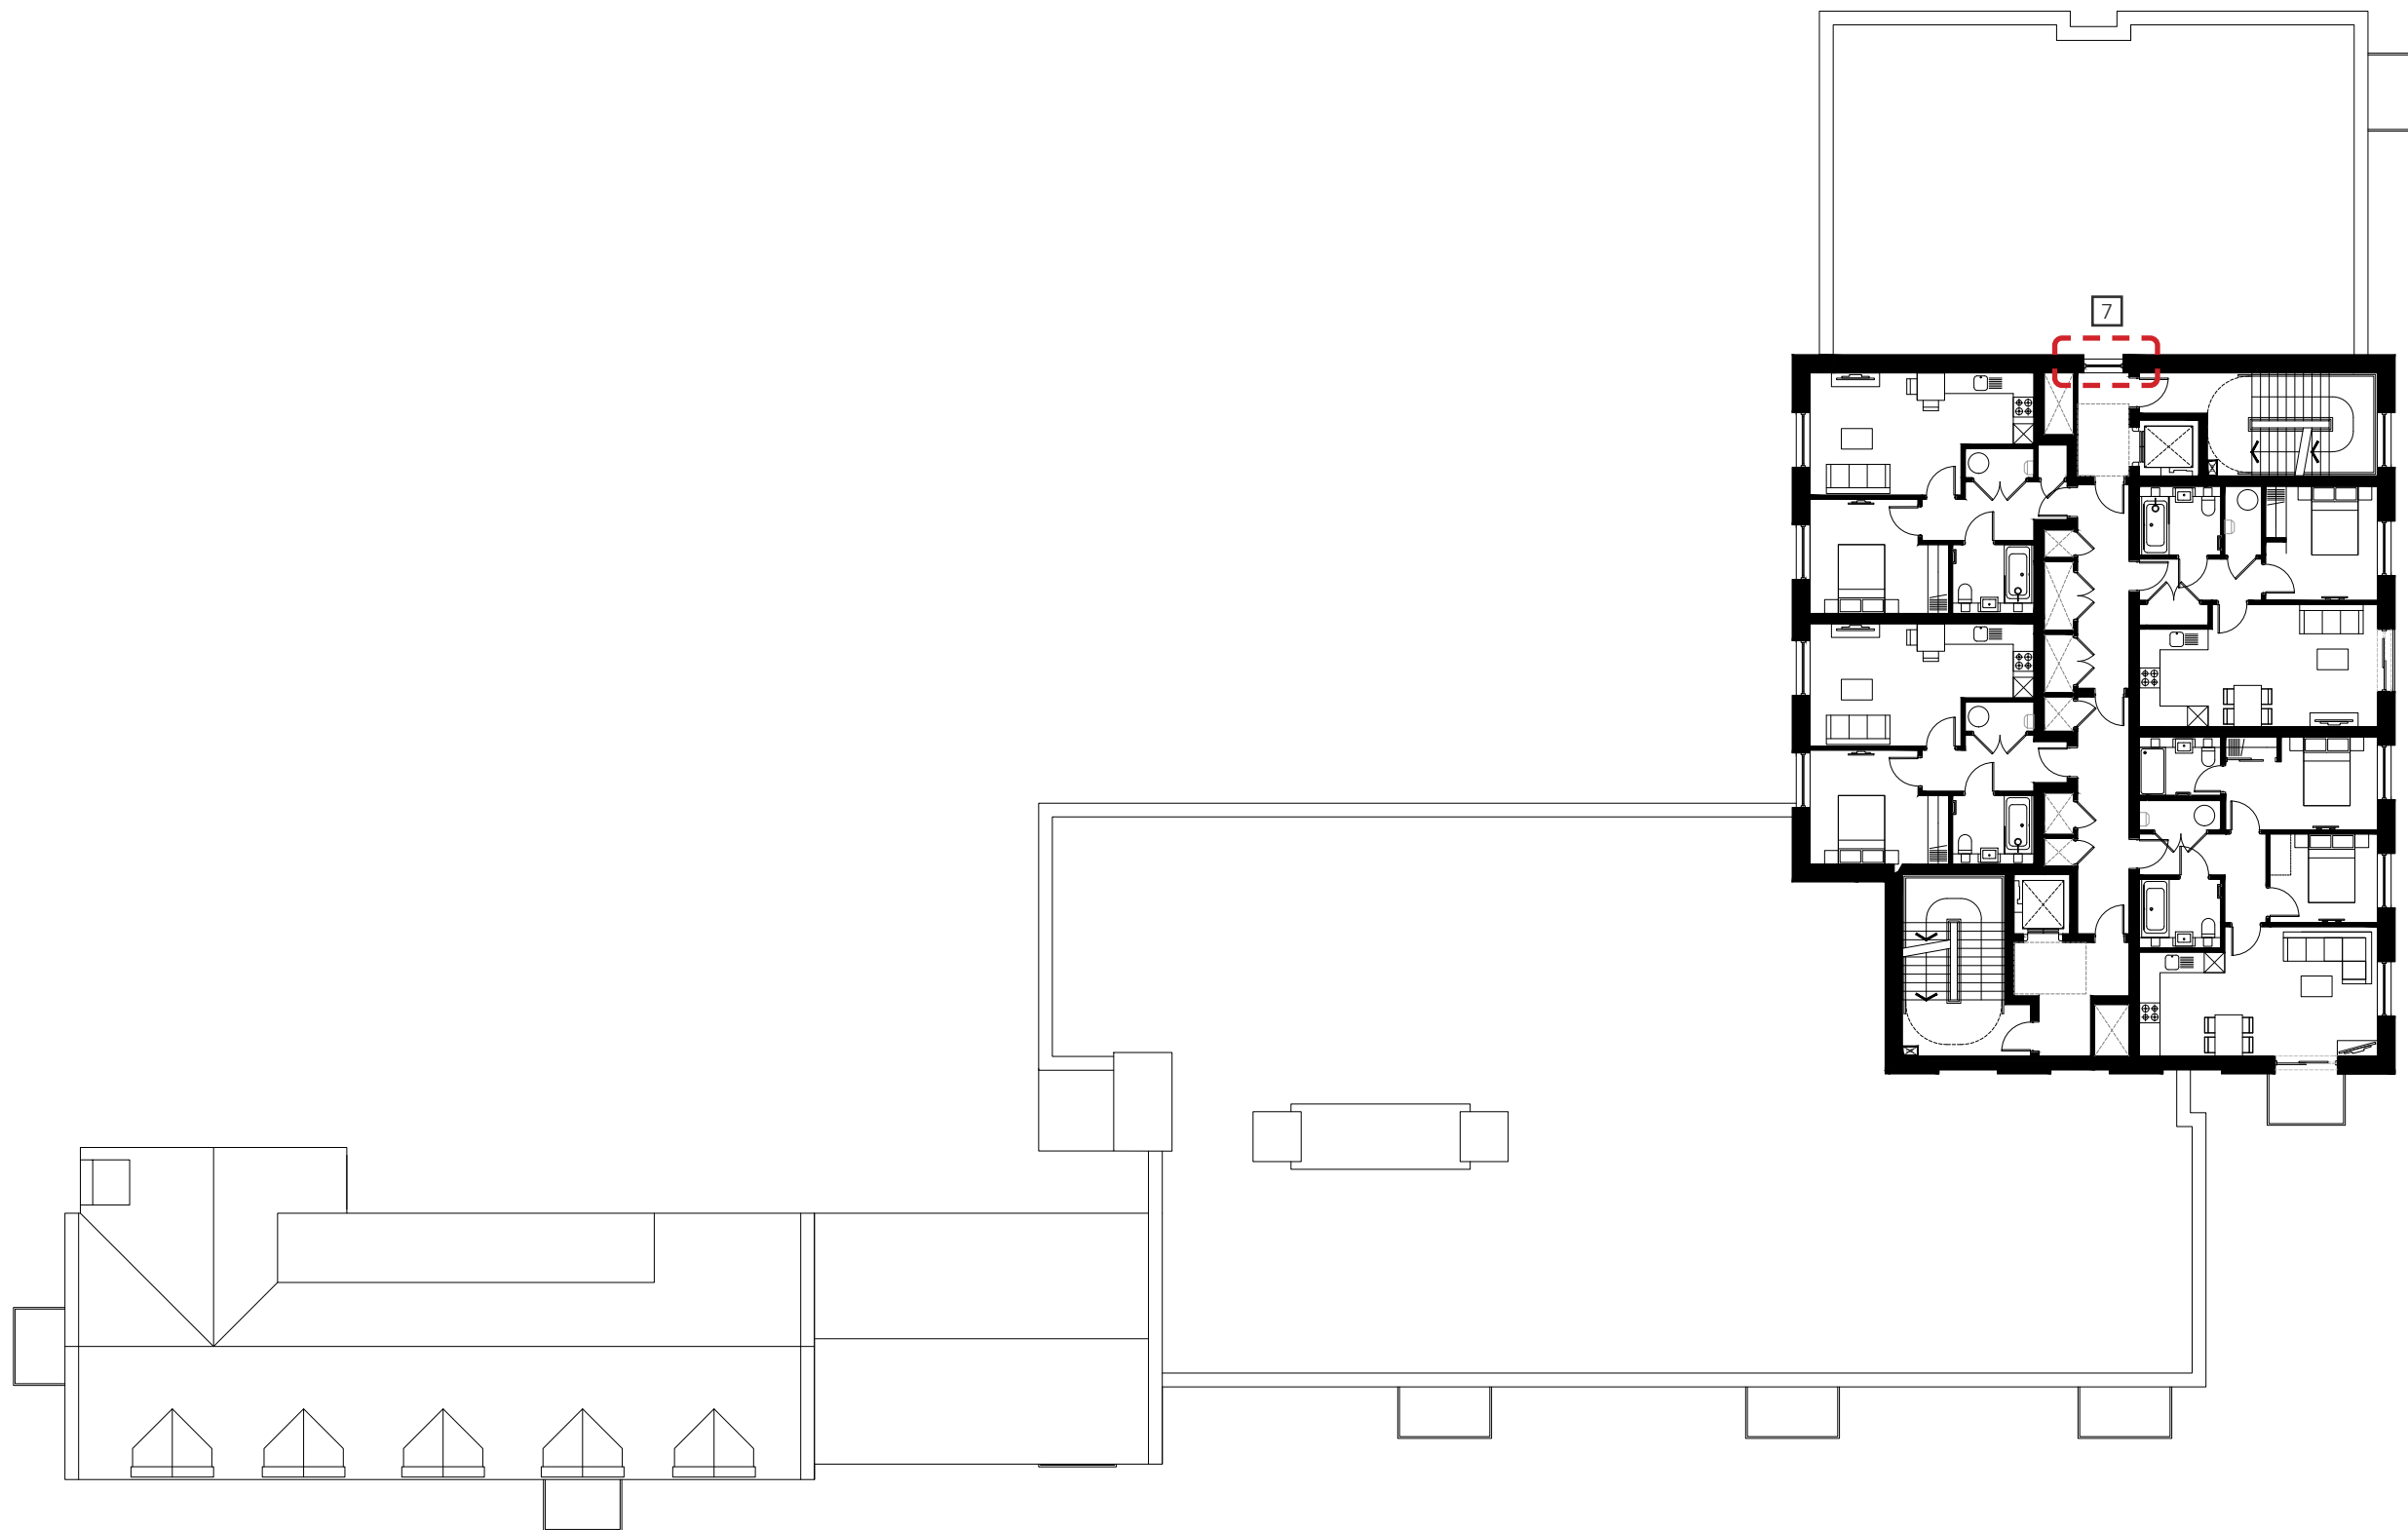

### Ninth Floor Plan

key plan

notes

Updates:

7. Roof access window added.

|   |           |     |                                                        |
|---|-----------|-----|--------------------------------------------------------|
| A | 30.04.20. | EE  | Removed balconies                                      |
| B | 08.09.20. | DT  | Cycle storage updated, added dormer on block C         |
| C | 09.10.23. | PO  | Fire strategy review                                   |
| D | 11.10.23. | EE  | Fire strategy review                                   |
| E | 25.10.23. | PO  | Replaced two 1 bed apts in block B with one 3 bed apt. |
| F | 21.12.23. | ISB | Fire strategy update                                   |
| G | 03.07.24  | EE  | Roof access window added                               |

| revision | prepared | description |
|----------|----------|-------------|
| date     |          |             |

**Berkeley**  
Designed for life

Berkeley House  
Farnham Lane  
Farnham Royal  
SL2 3RQ

T: 01753 784400  
F: 01753 646855  
[www.berkeleygroup.co.uk](http://www.berkeleygroup.co.uk)


project  
Vastern Road  
Reading

drawing  
Block B and C  
Ninth Floor Plan


|              |            |       |
|--------------|------------|-------|
| date         | scale @ a1 | drawn |
| October 2019 | 1:100      | ISB   |

drawing number 448.PL.BC.109 revision G



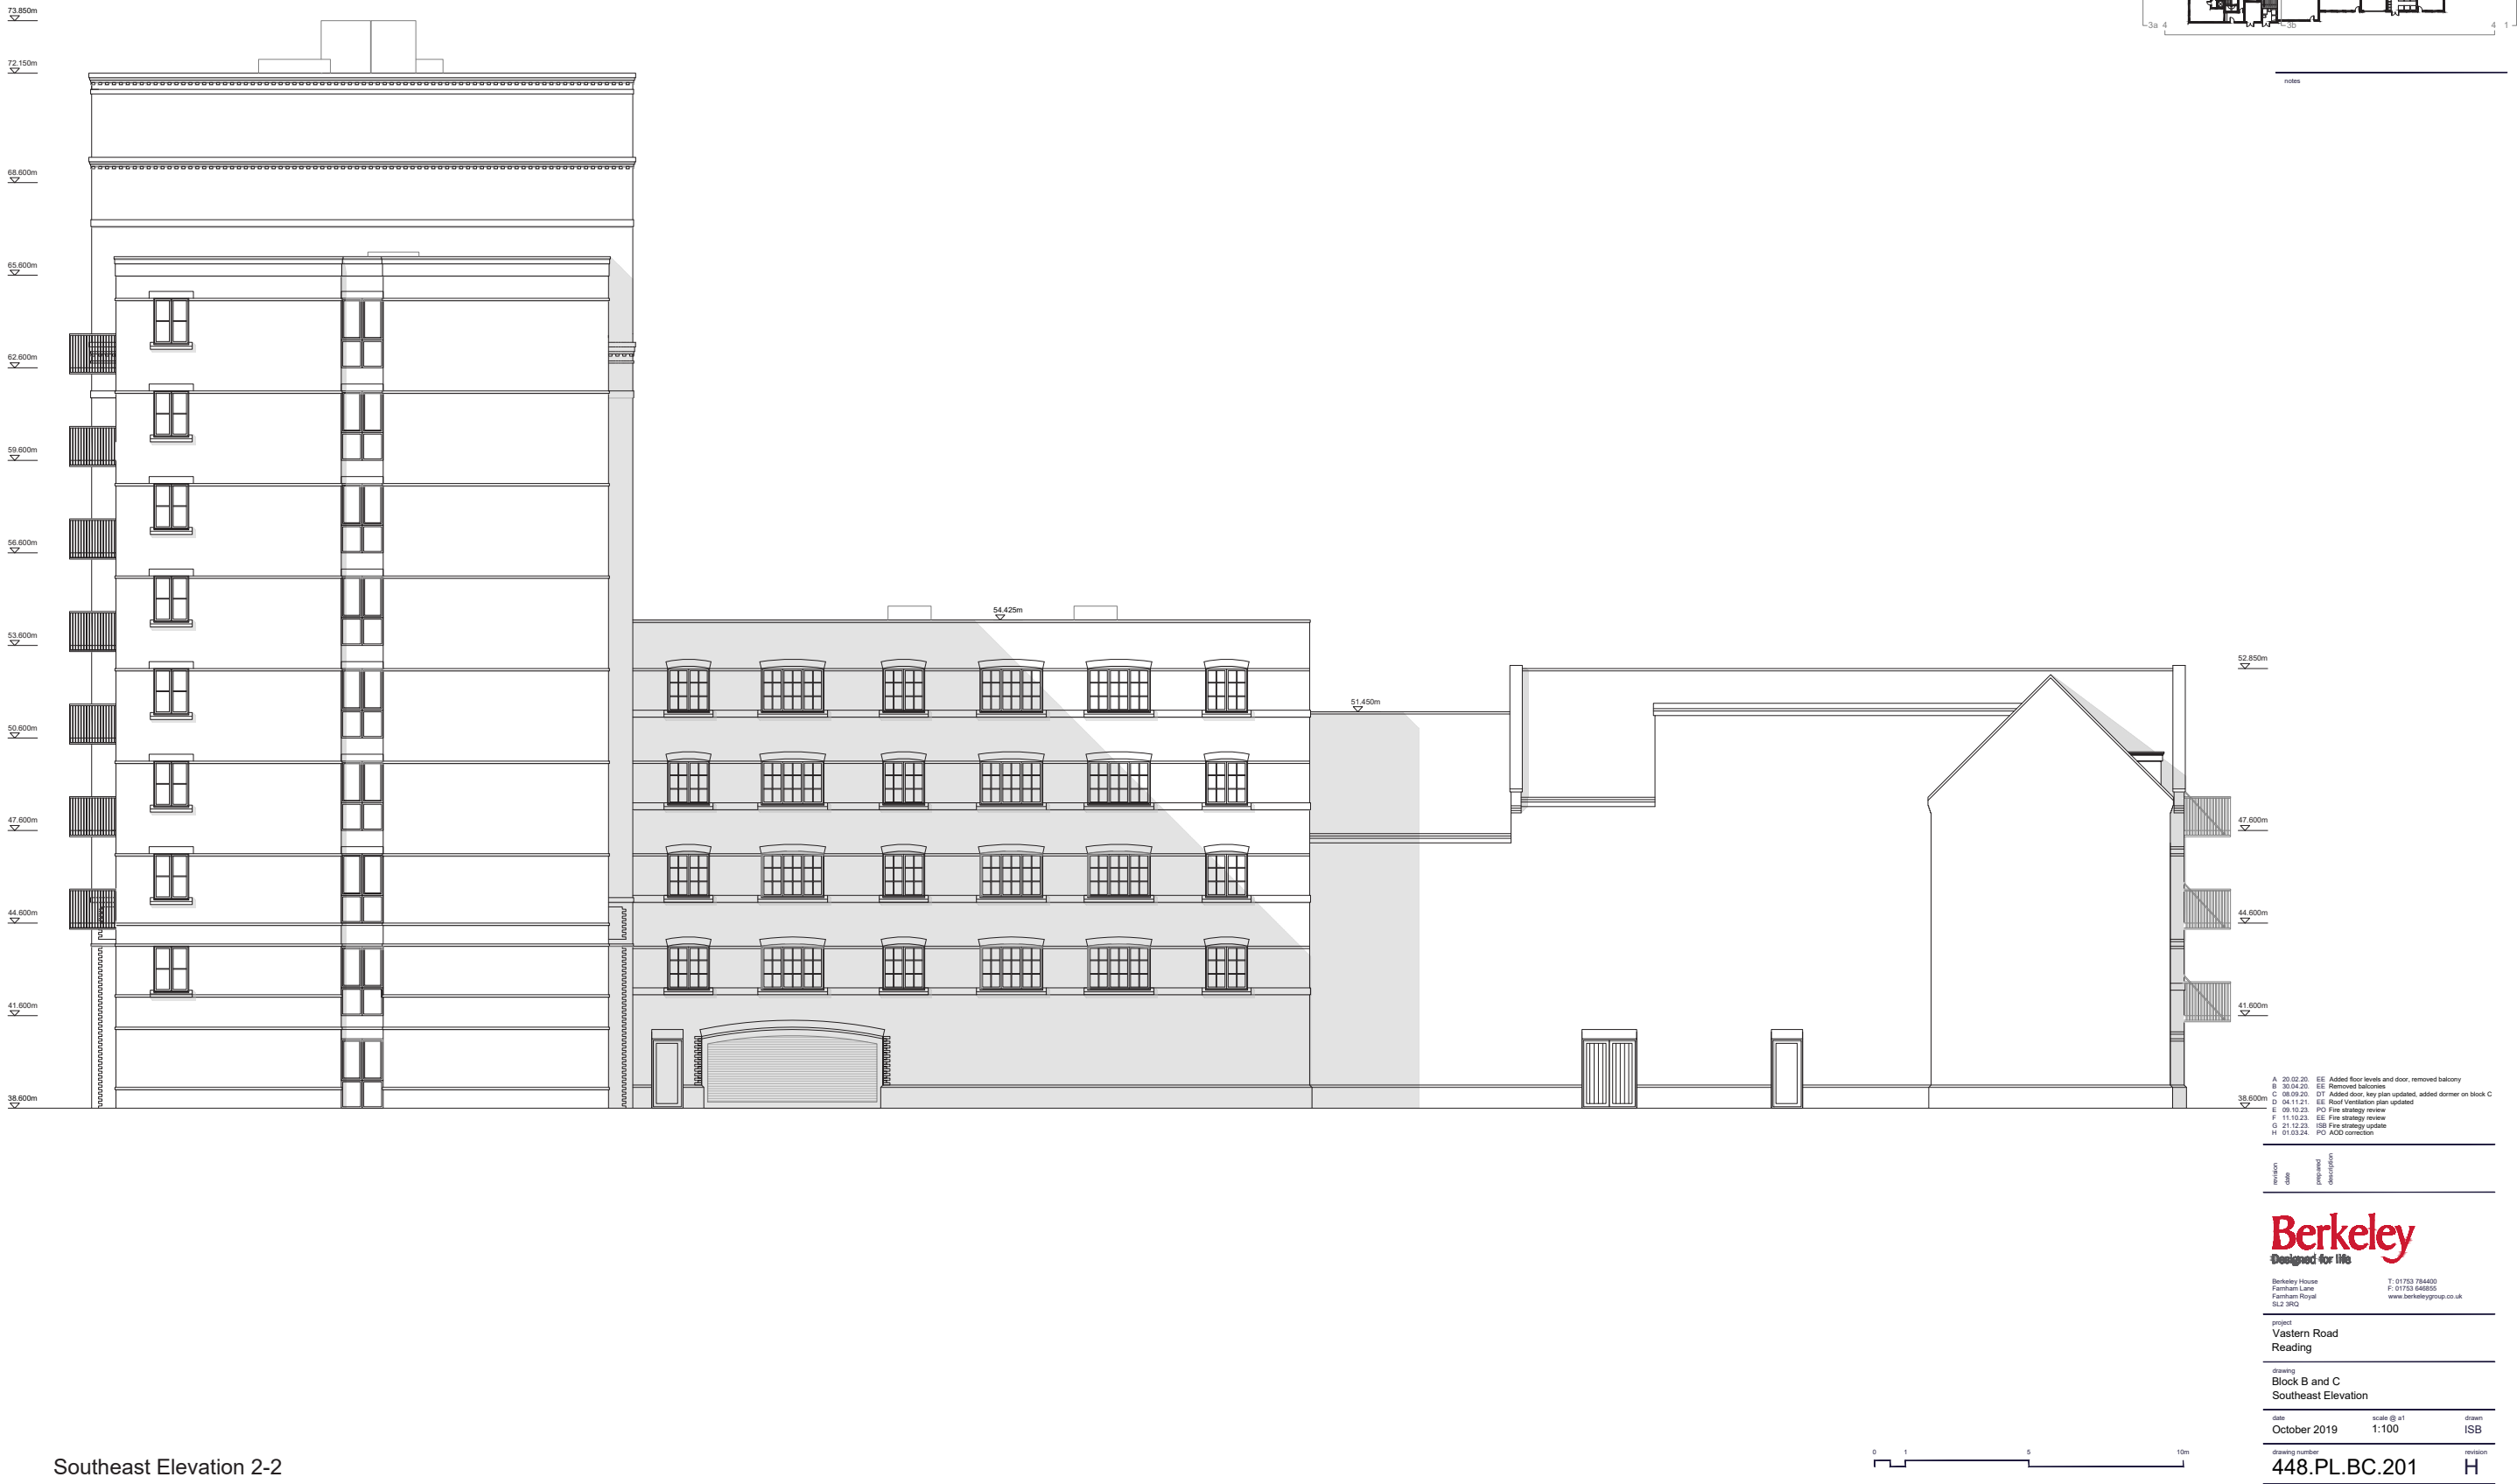

Southeast Elevation 2-2

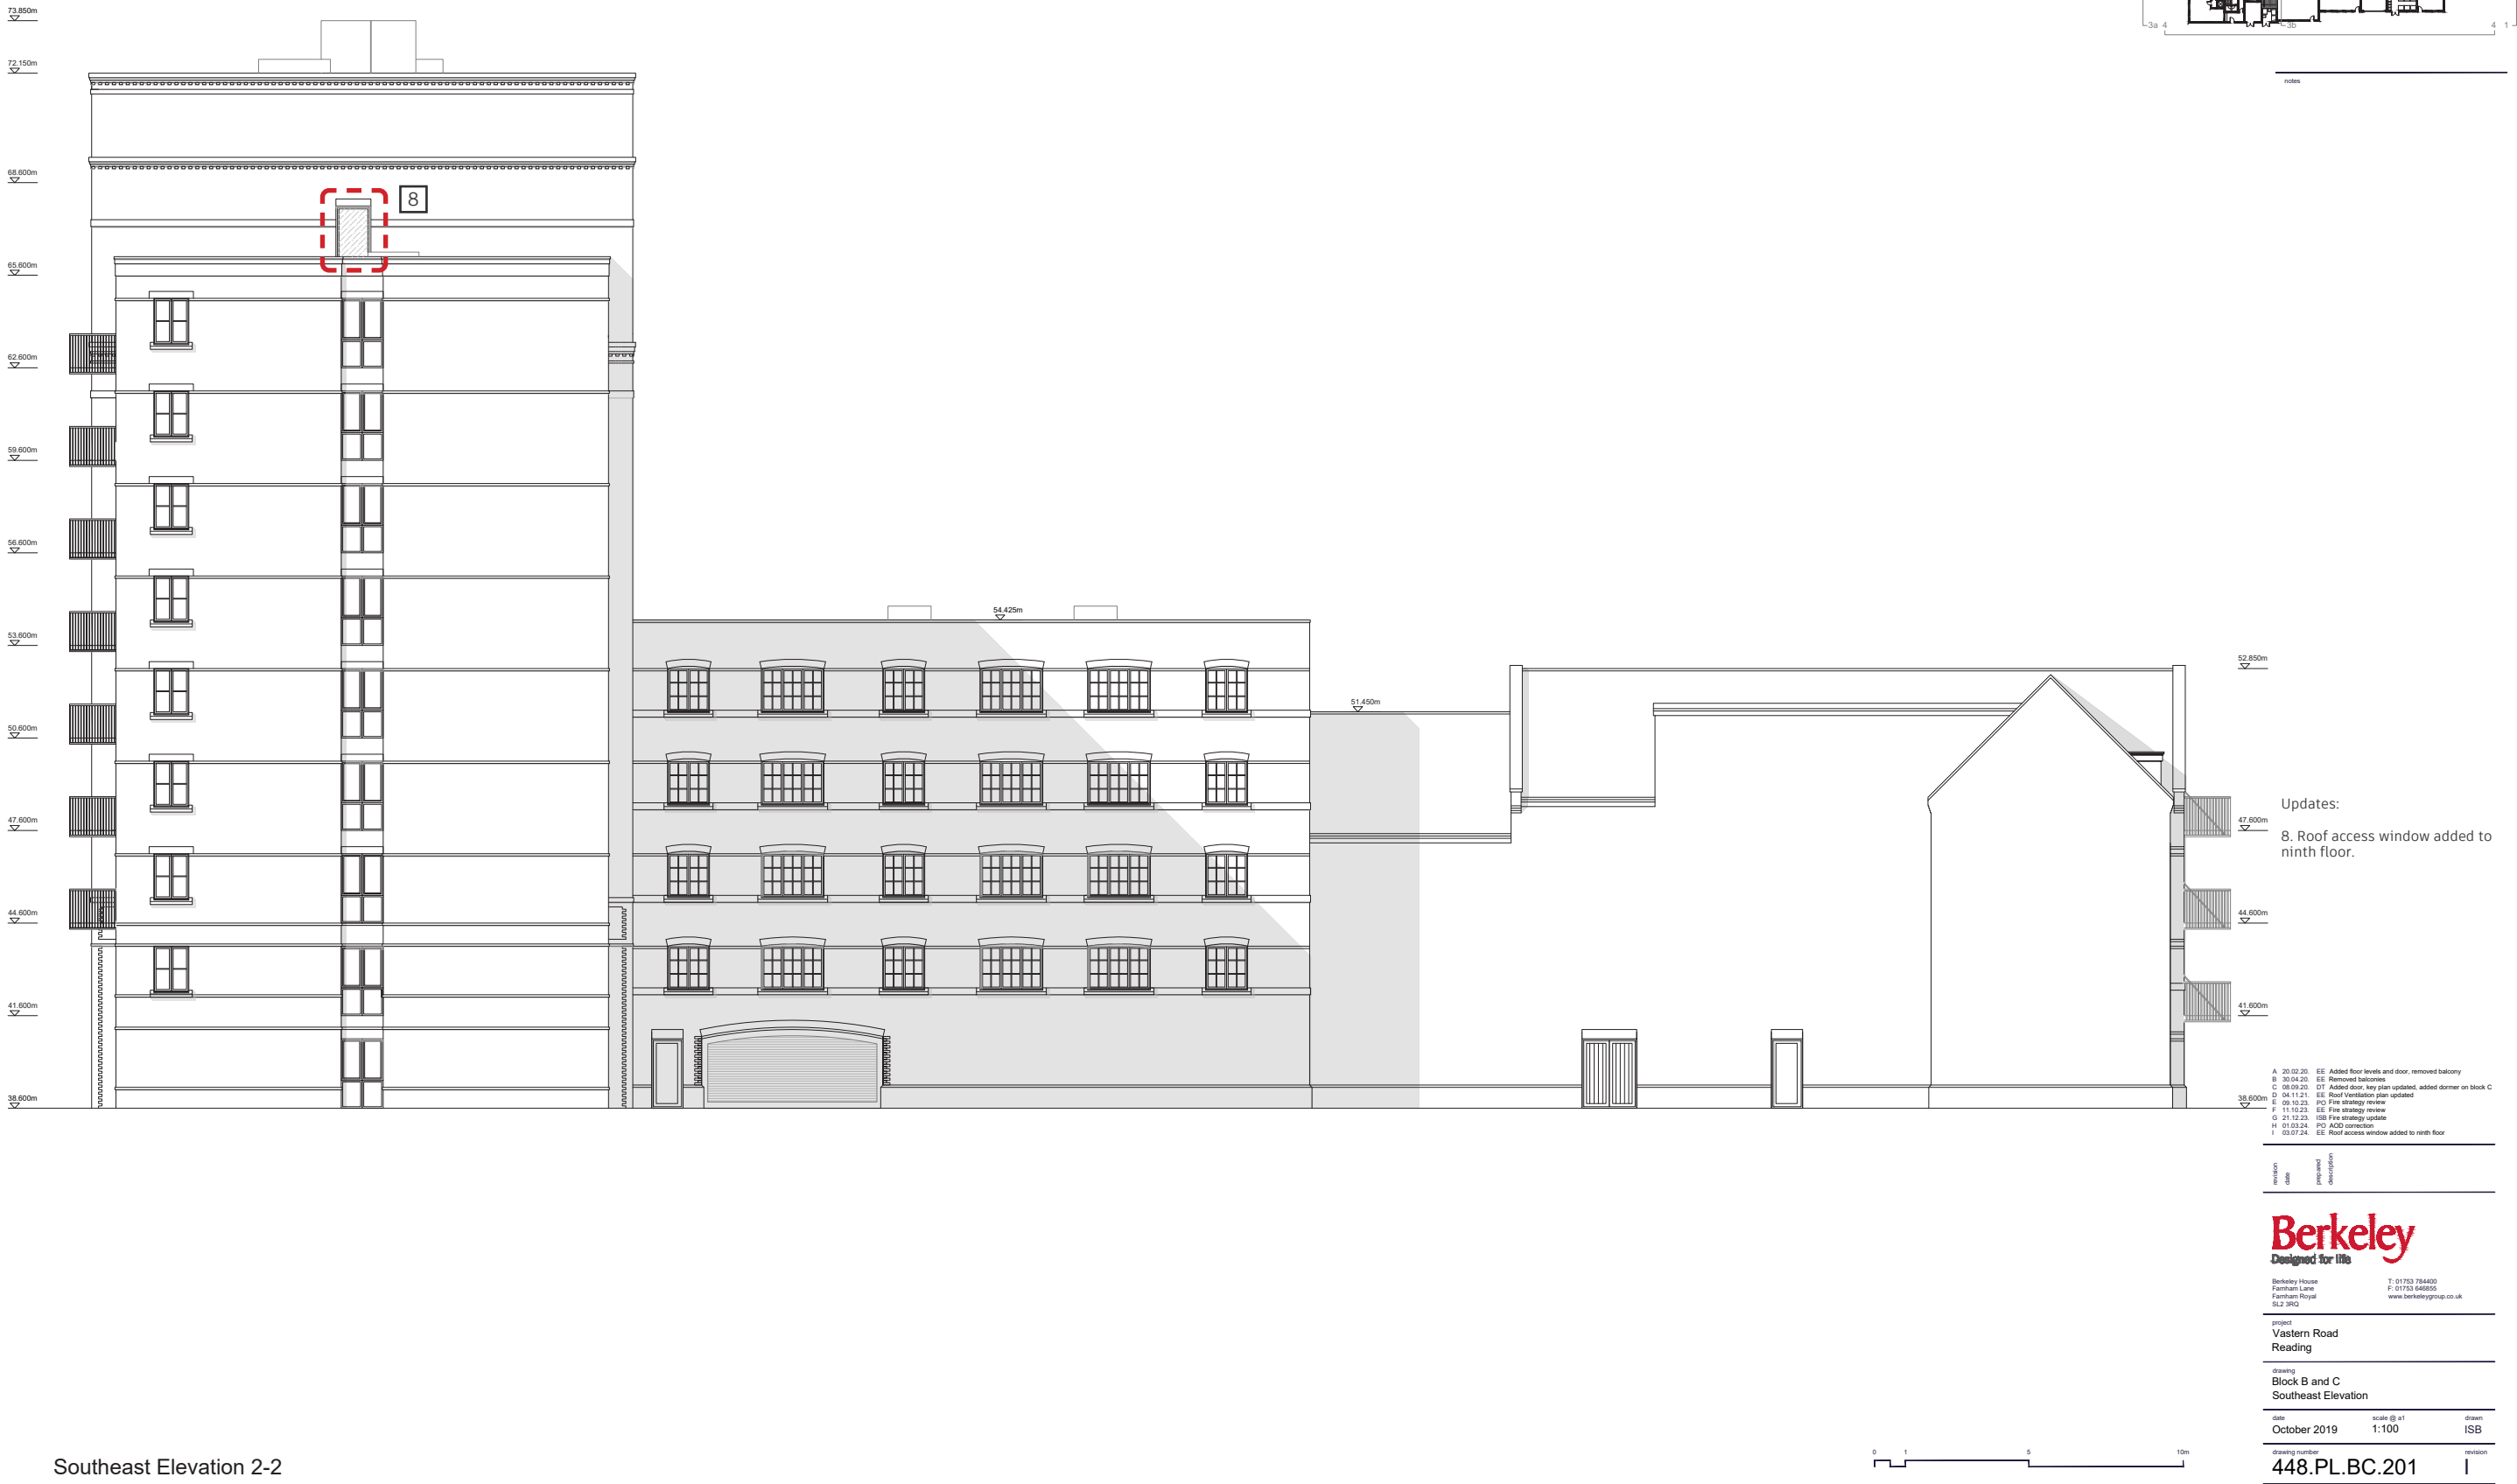


Southeast Elevation 2-2







Northwest Elevation 4-4

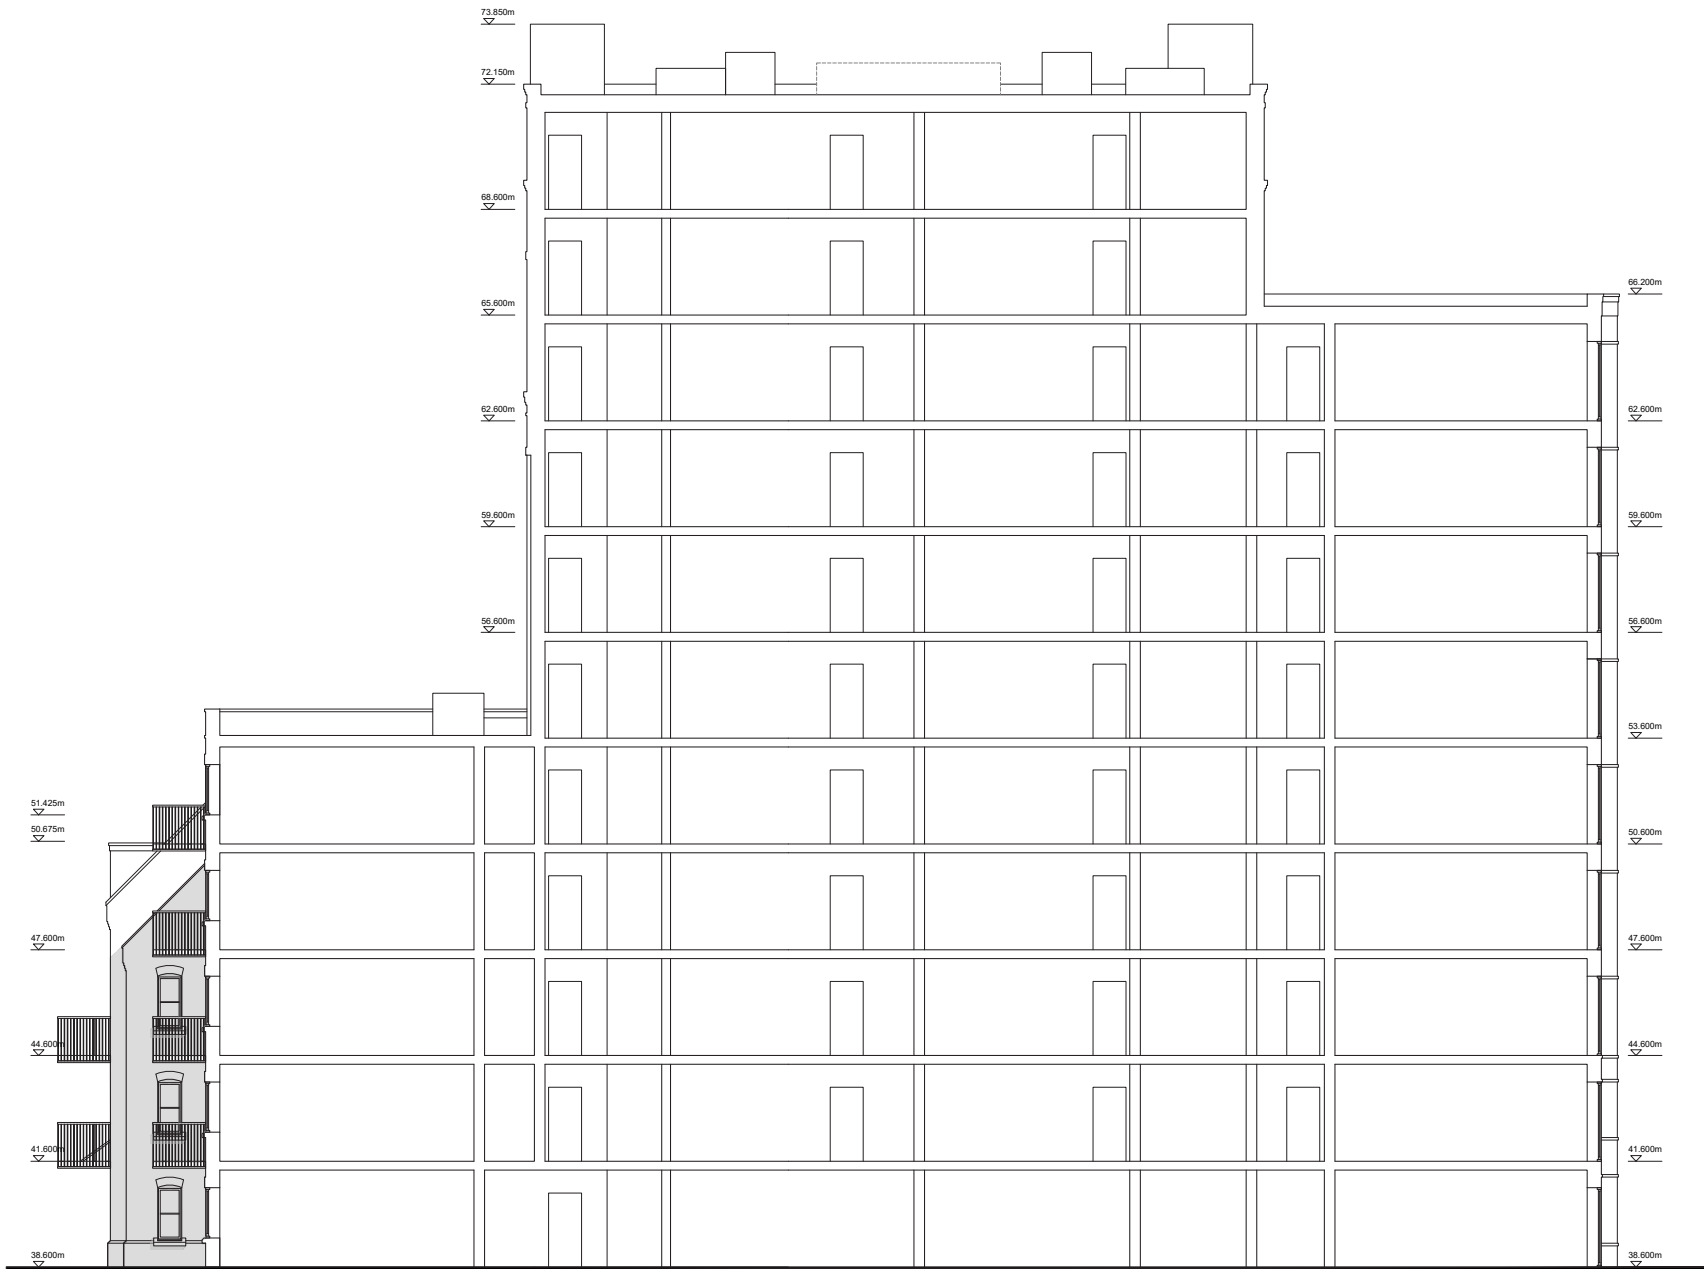

Section A-A

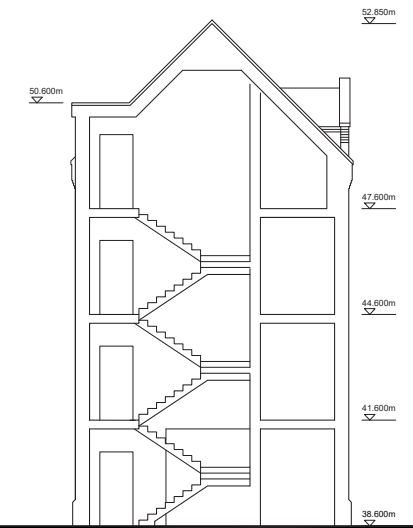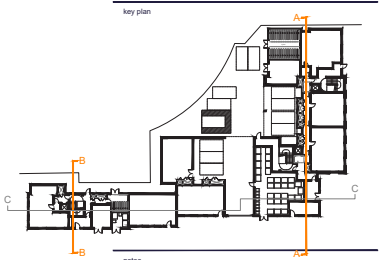

Section B-B

- A. 20.02.20 EE Added floor levels
- B. 20.04.20 EE Removed balconies
- C. 08.09.20 DT Key plan updated
- D. 04.11.21 EE Roof Ventilation plan updated
- E. 05.10.23 PO Fire strategy review
- F. 11.10.23 EE Fire strategy review
- G. 21.12.23 USB Fire strategy update
- H. 01.03.24 PO ADD correction

| revision | date | prepared | checked |
|----------|------|----------|---------|
|          |      |          |         |

**Berkeley**  
Designed for life

Berkeley House  
Farnham Lane  
Farnham Royal  
SL2 3RQ

T: 01753 784400  
F: 01753 648305  
www.berkeleygroup.co.uk


project  
Vastern Road  
Reading

drawing  
Block BC  
Section A-A and B-B


|              |            |       |
|--------------|------------|-------|
| date         | scale @ a1 | drawn |
| October 2019 | 1:100      | EE    |

|                |          |
|----------------|----------|
| drawing number | revision |
| 448.PL.BC.300  | H        |




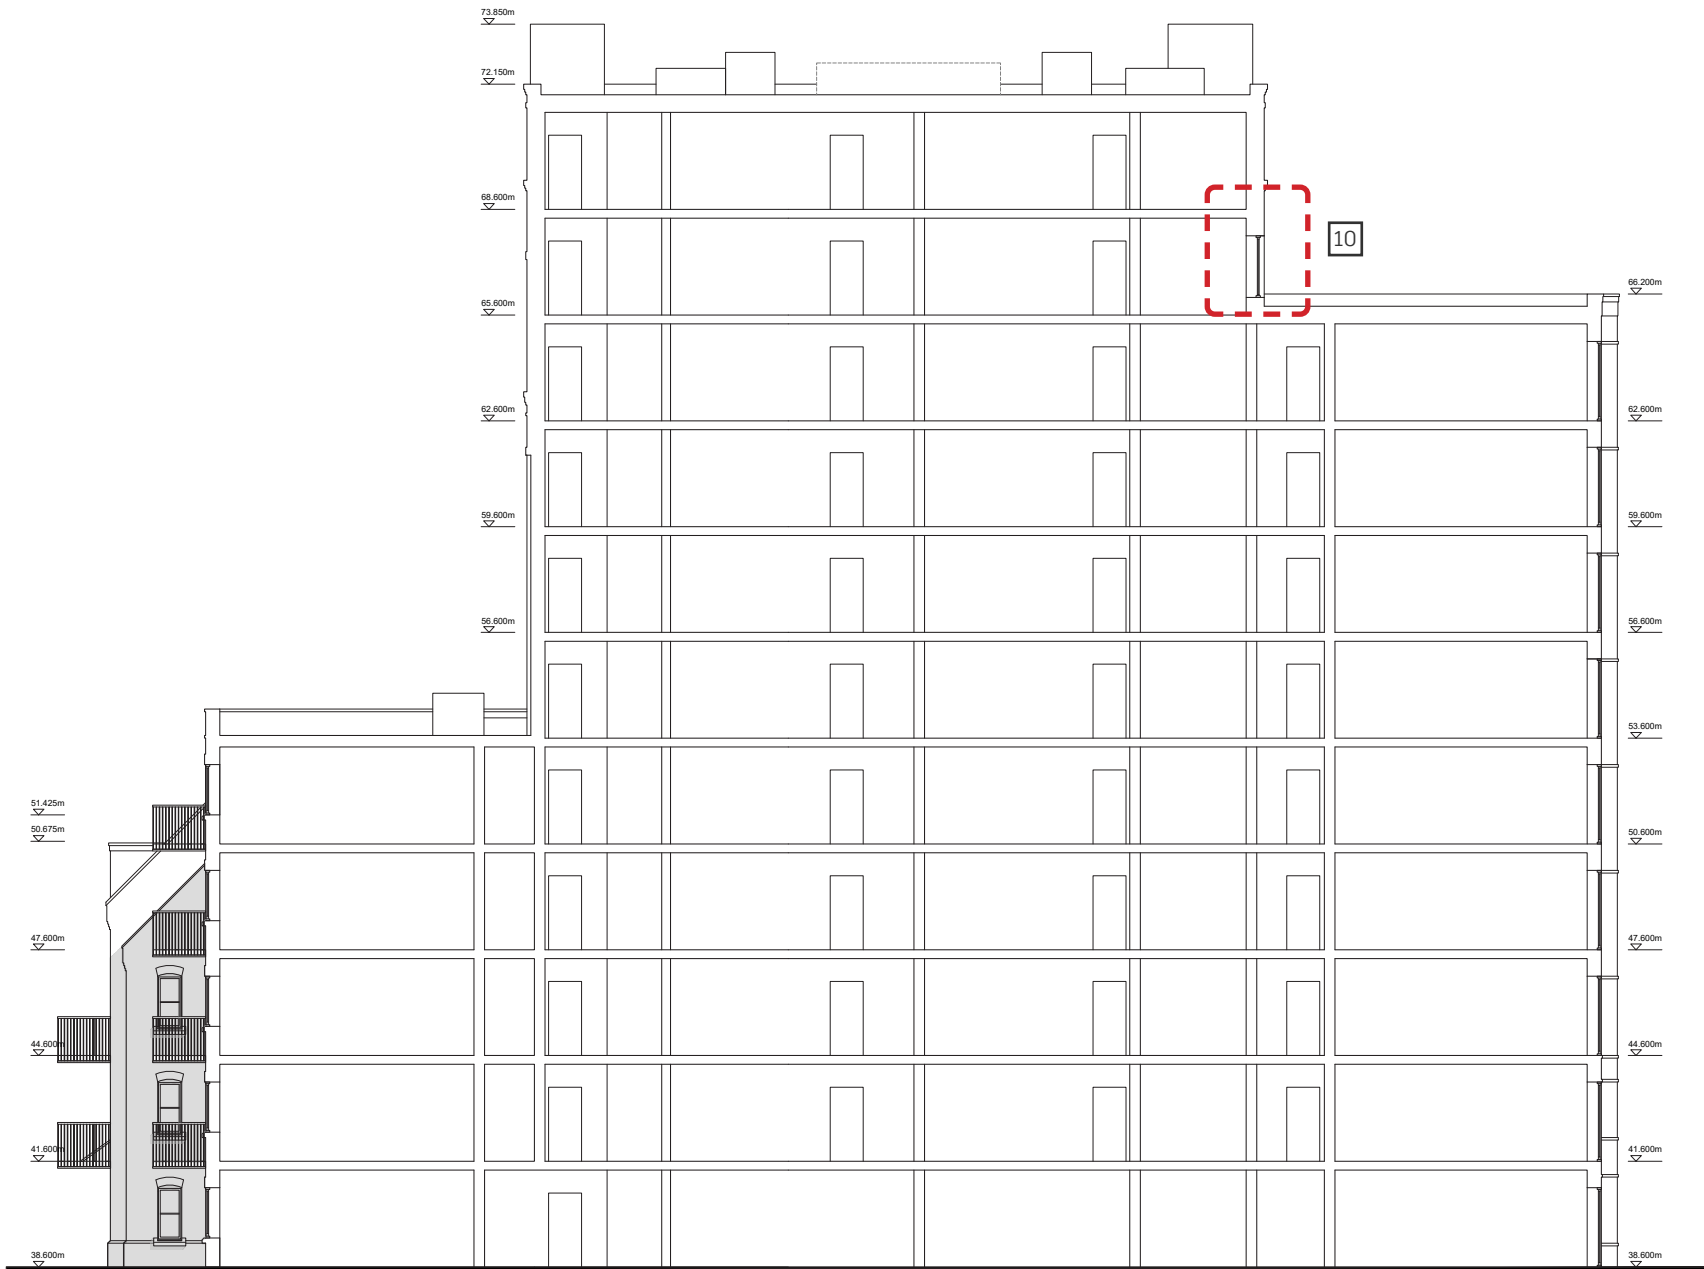

Section A-A

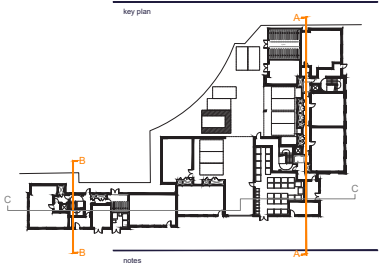

Updates:  
10. Roof access window added to ninth floor.

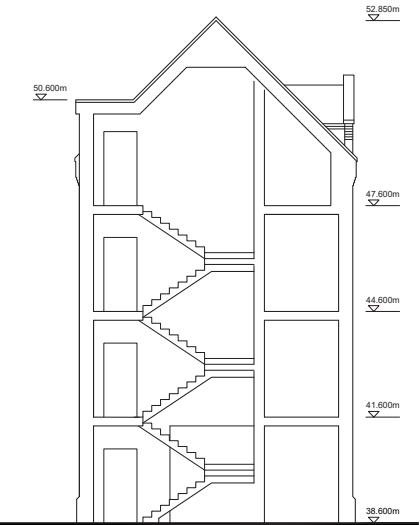

Section B-B

|   |          |     |                                         |
|---|----------|-----|-----------------------------------------|
| A | 20.02.20 | EE  | Added floor levels                      |
| B | 30.04.20 | EE  | Removed balconies                       |
| C | 08.09.20 | DT  | Key plan updated                        |
| D | 04.11.21 | EE  | Roof Ventilation plan updated           |
| E | 09.10.23 | PD  | Fire strategy review                    |
| F | 11.10.23 | EE  | Fire strategy update                    |
| G | 21.12.23 | 158 | Fire strategy update                    |
| H | 01.03.24 | PD  | AKD correction                          |
| I | 03.07.24 | EE  | Roof access window added to ninth floor |

**Berkeley**  
Designed for life

Berkeley House  
Farnham Lane  
Farnham Royal  
SL2 3RQ

T: 01753 784400  
F: 01753 648305  
www.berkeleygroup.co.uk

project  
Vastern Road  
Reading

drawing  
Block BC  
Section A-A and B-B

date  
October 2019


scale @ a1  
1:100

drawn  
EE

drawing number  
448.PL.BC.300

revision  
I



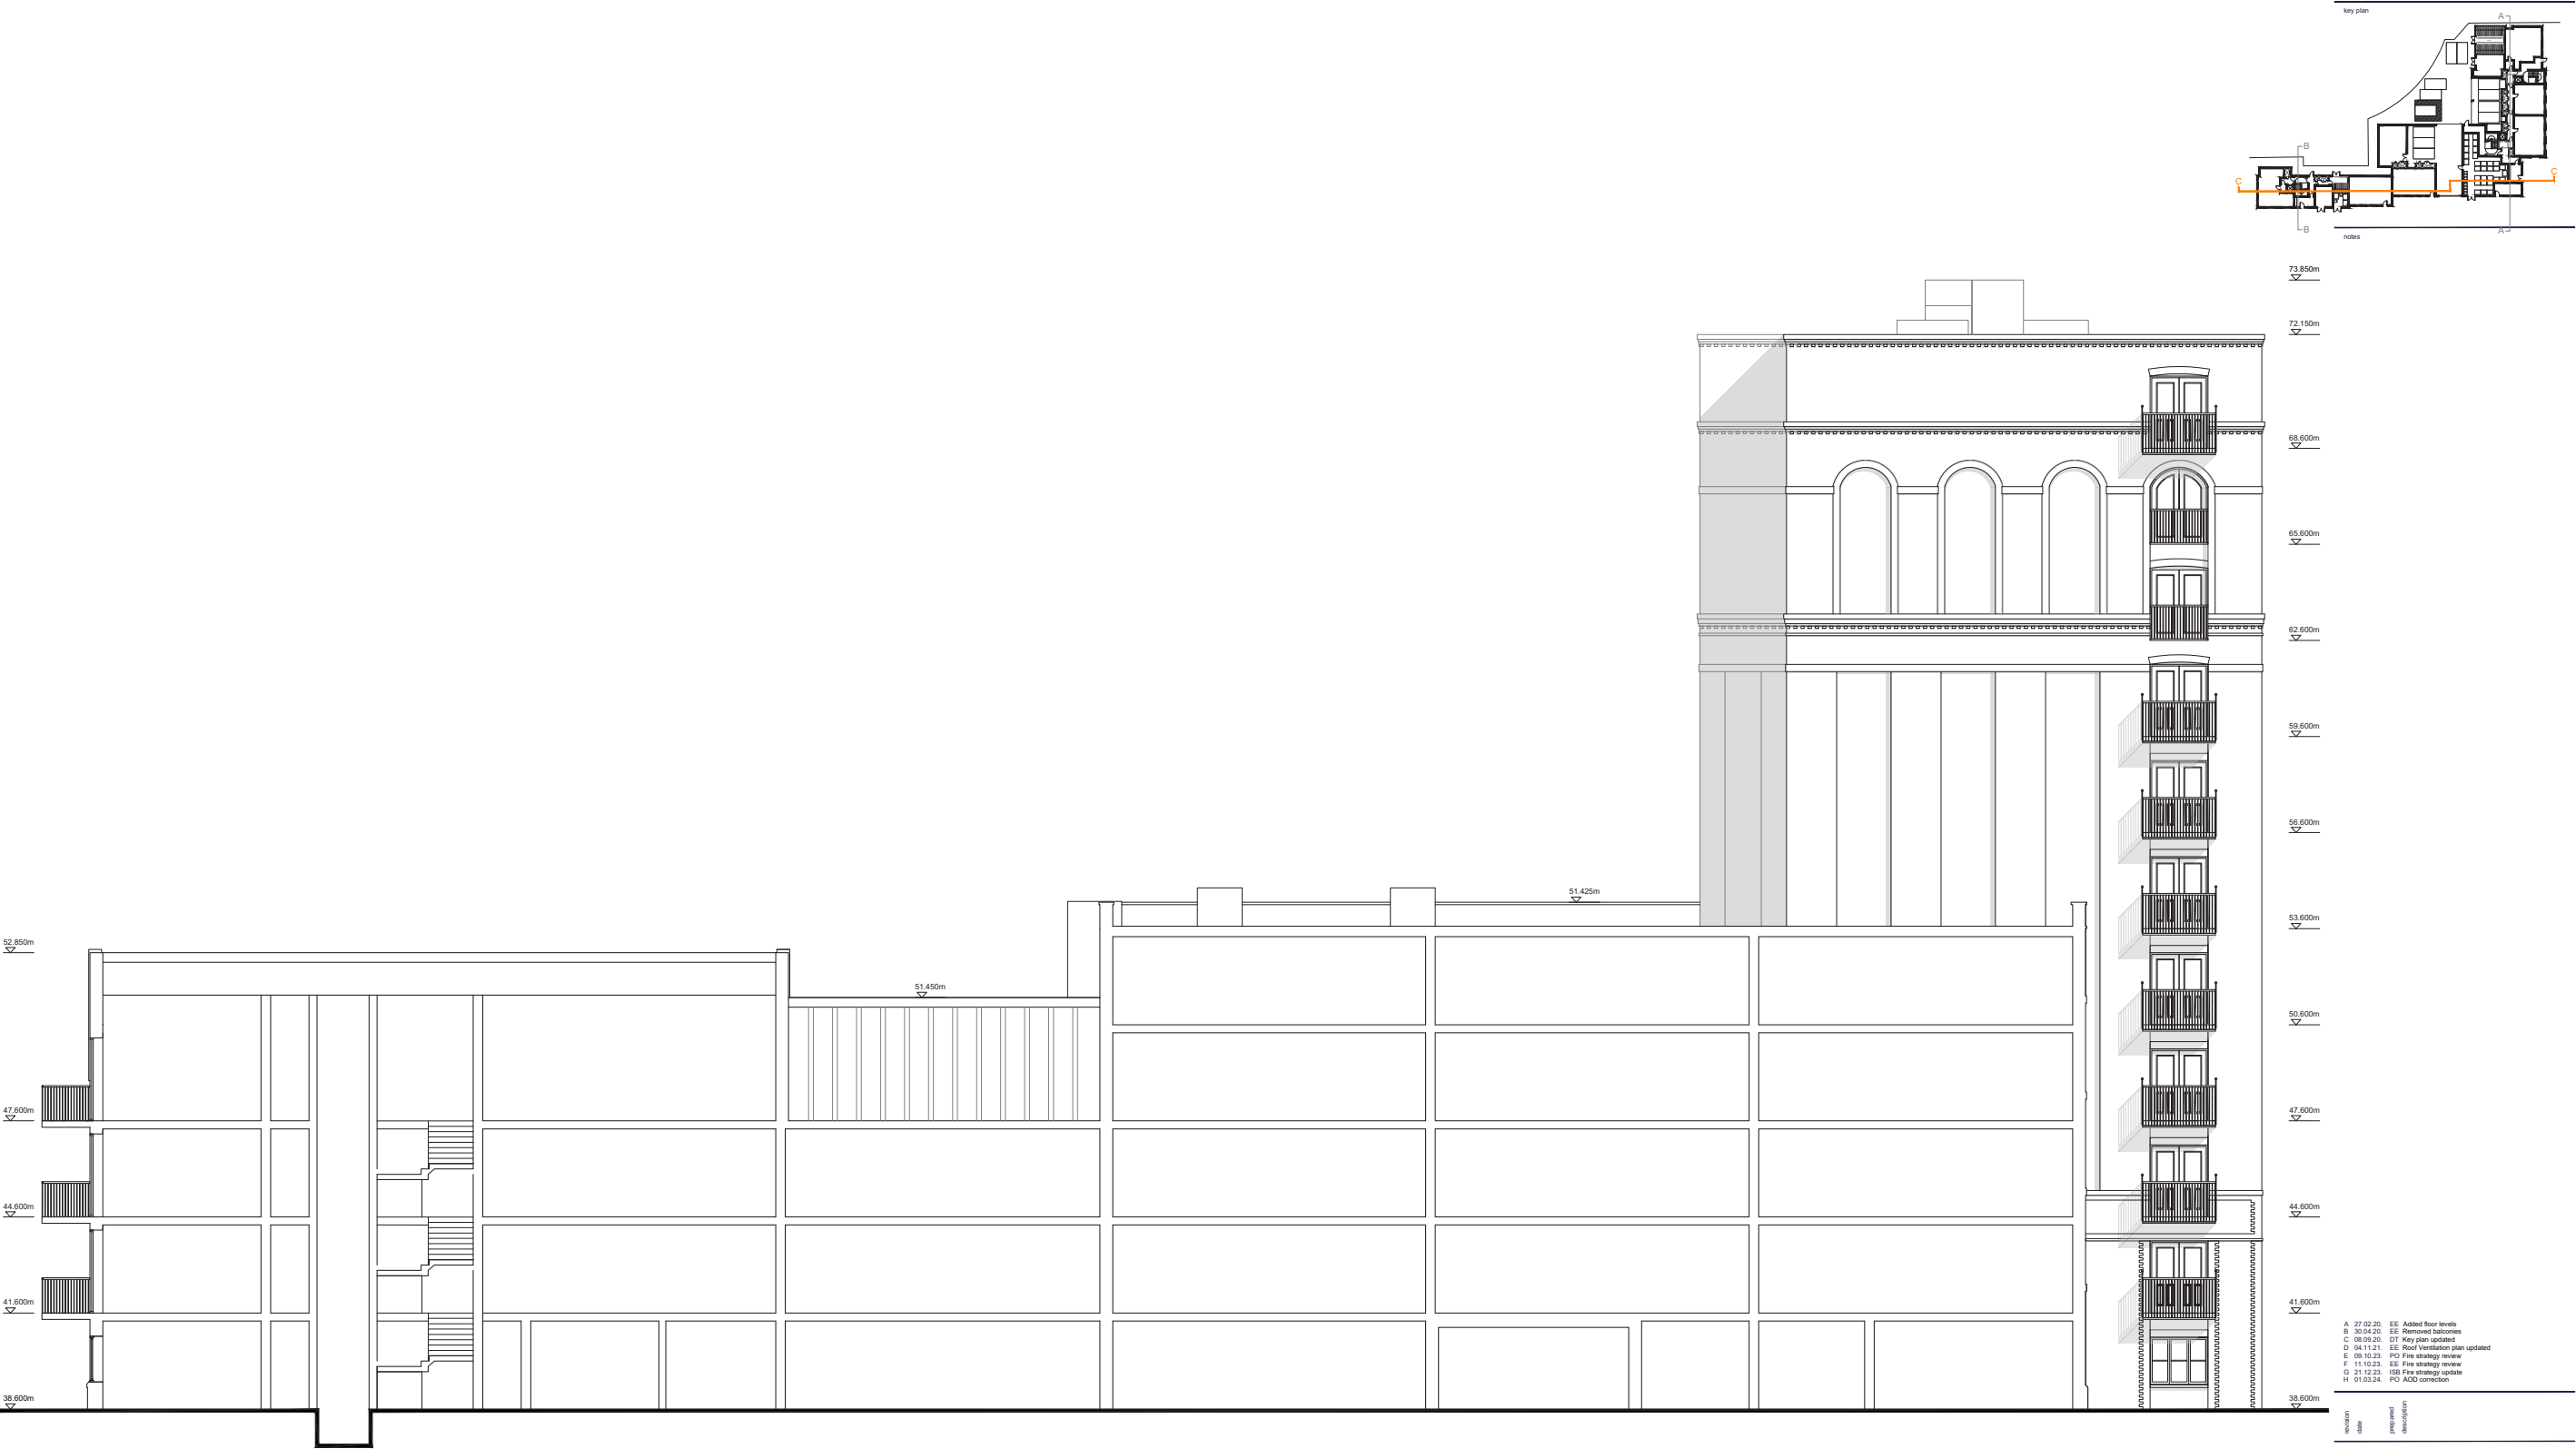

Section C-C

- A 27.02.20 EE Added floor levels
- B 26.04.20 EE Removed balconies
- C 08.09.20 DT Key plan updated
- D 04.11.21 EE Roof Ventilation plan updated
- E 05.10.23 PO Fire strategy review
- F 11.10.23 EE Fire strategy review
- G 21.12.23 IBB Fire strategy update
- H 01.03.24 PO ADD correction

**Berkeley**  
Designed for life

Berkeley House  
Farnham Lane  
Farnham Royal  
SL2 3RQ

T: 01753 784400  
F: 01753 648305  
www.berkeleygroup.co.uk

project  
Vastern Road  
Reading

drawing  
Block BC  
Section C-C

date  
October 2019


scale @ a1  
1:100

drawn  
EE

drawing number  
448.PL.BC.301

revision  
H



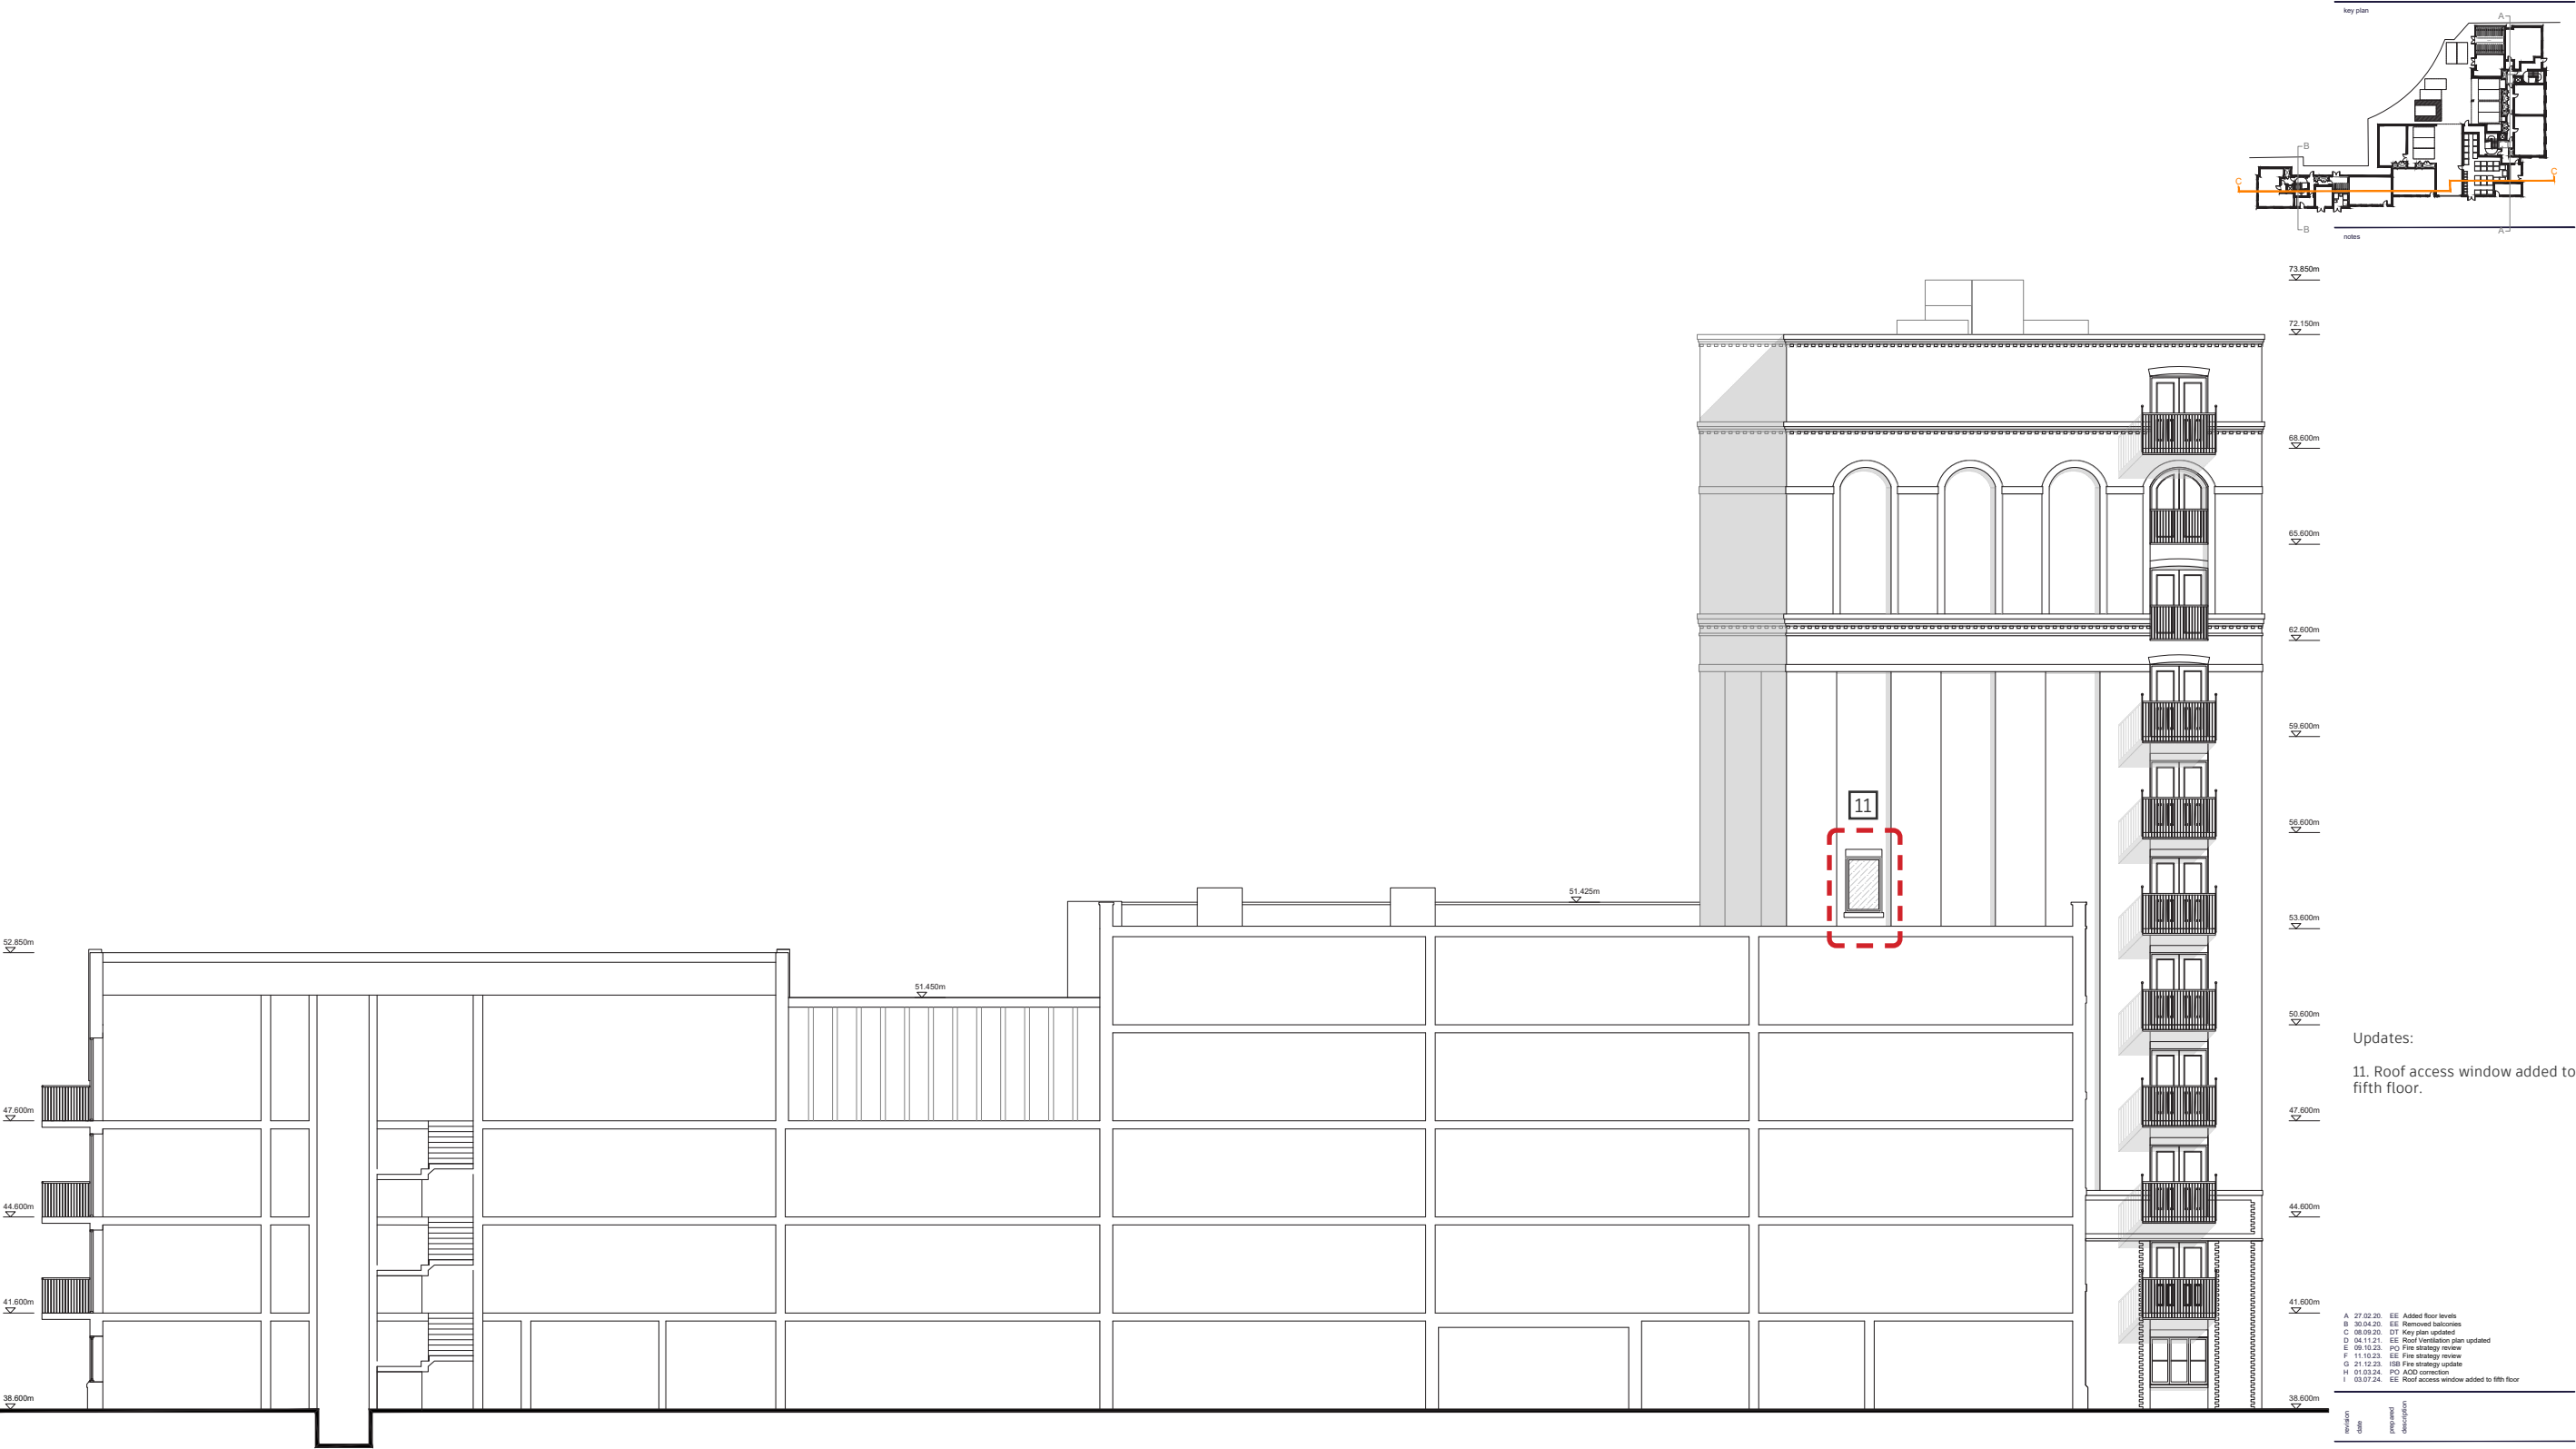

Section C-C

**Berkeley**  
Designed for life

Berkeley House  
Farnham Lane  
Farnham Royal  
SL2 3RQ

T: 01753 784400  
F: 01753 648305  
www.berkeleygroup.co.uk

project  
Vastern Road  
Reading

drawing  
Block BC  
Section C-C

date  
October 2019

scale @ a1  
1:100

drawn  
EE

drawing number  
448.PL.BC.301

revision  
I

