
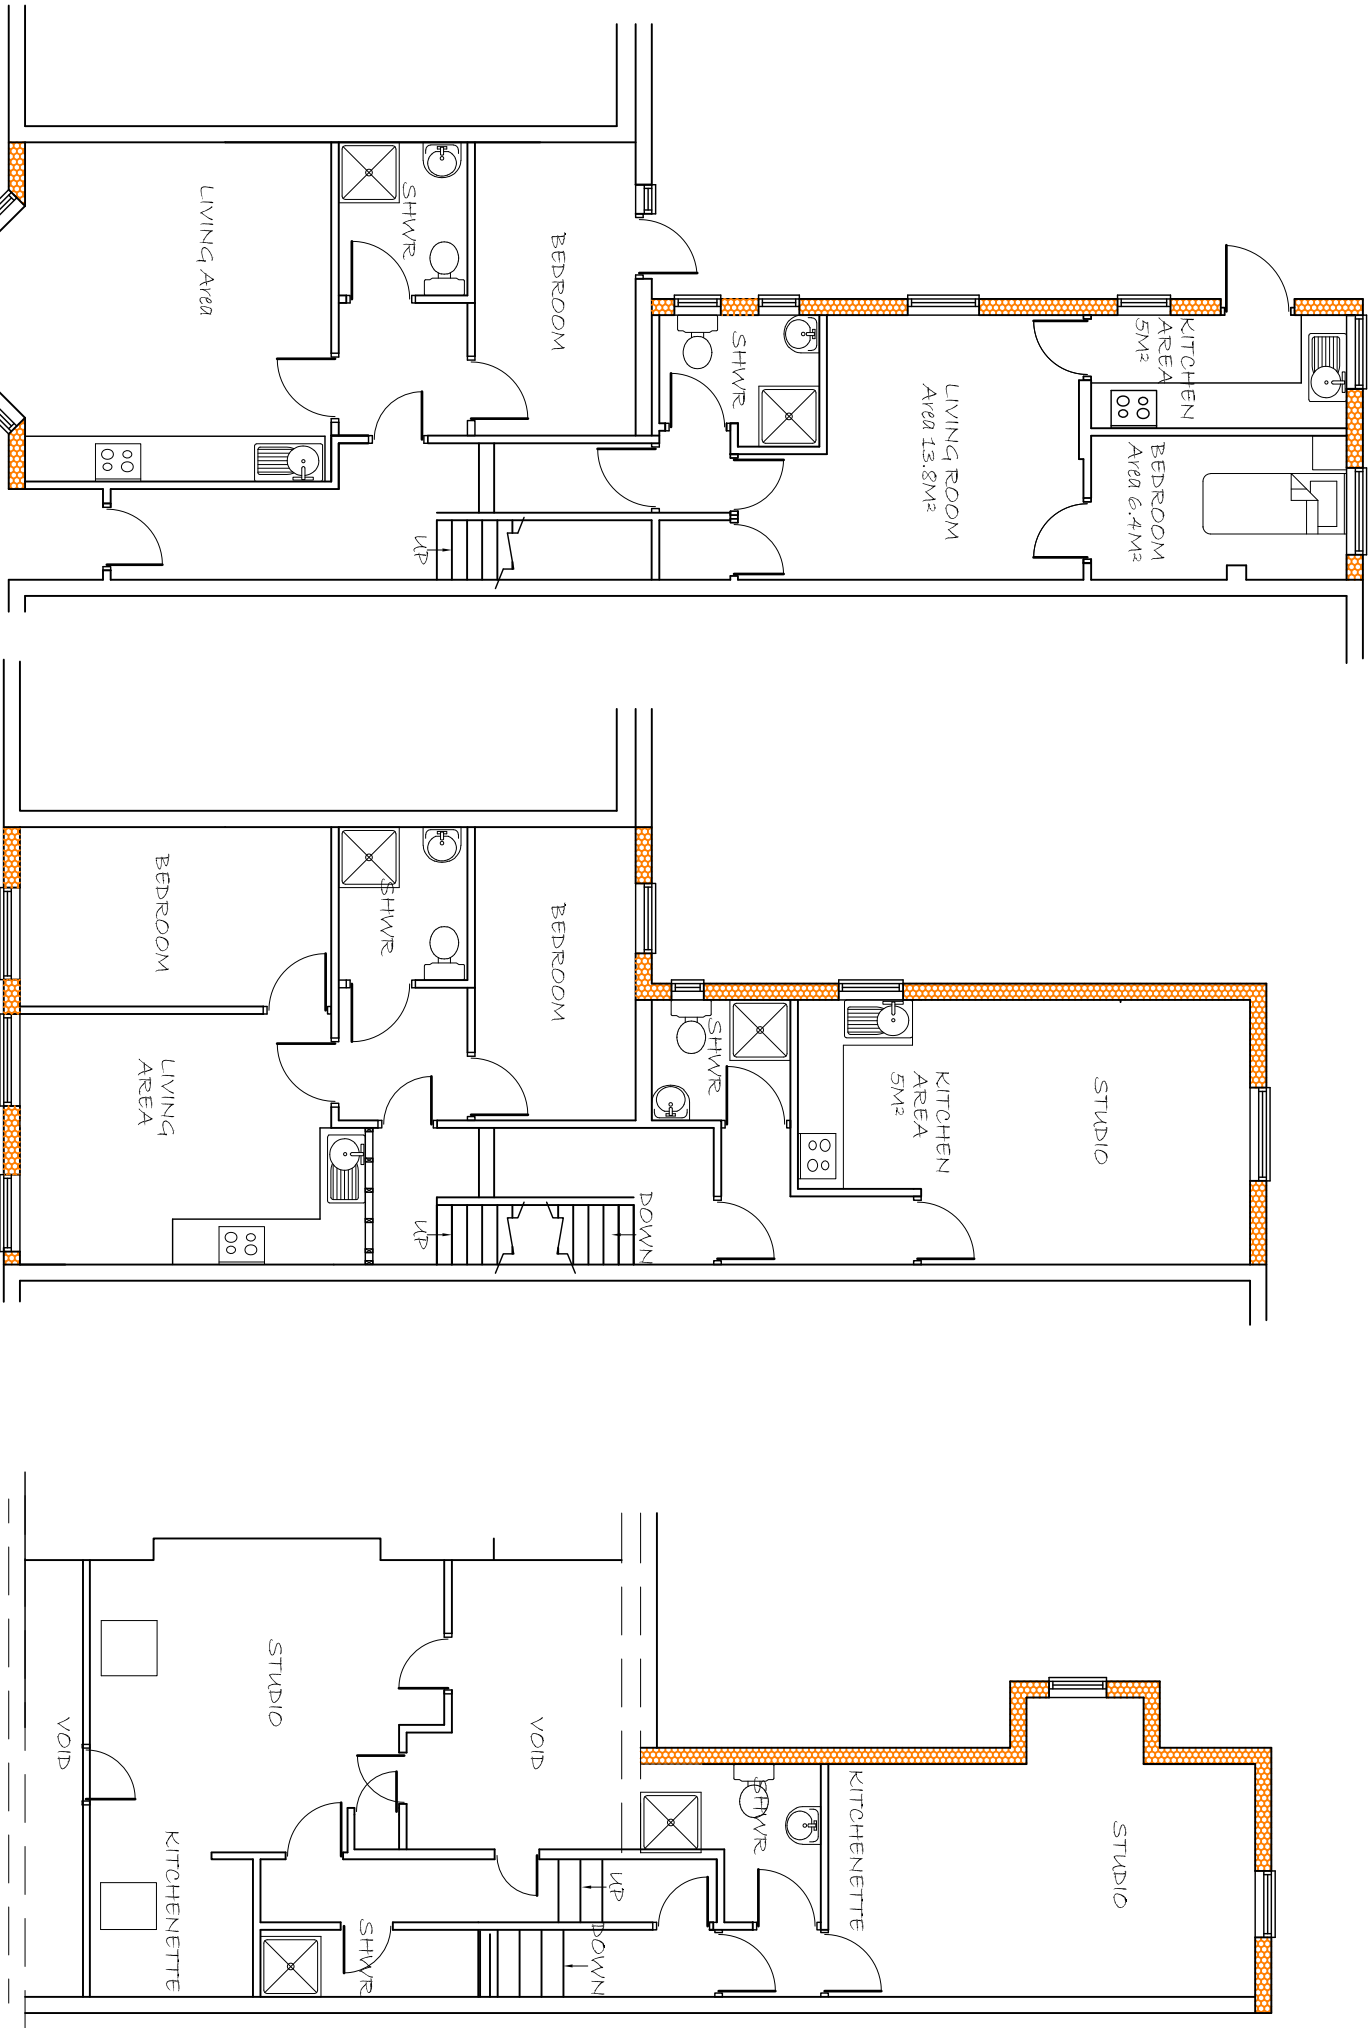


RAMMURTI DESIGN LTD
ARCHITECTURAL & PLANNING SERVICES
268 TILGHURST ROAD, READING RG30 2NE
TEL/FAX: 01189510628 MOB: 07799883574

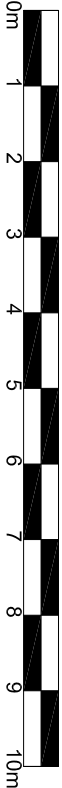

Certificate of Lawfulness for 6No Self contained apartments
at 5 Hamilton Road, Reading RG1 5RA
for GVA Properties Limited

AS BUILT FLOOR PLANS
Scale: 1/100
Date: August 2024
HR05:002 Rev -