


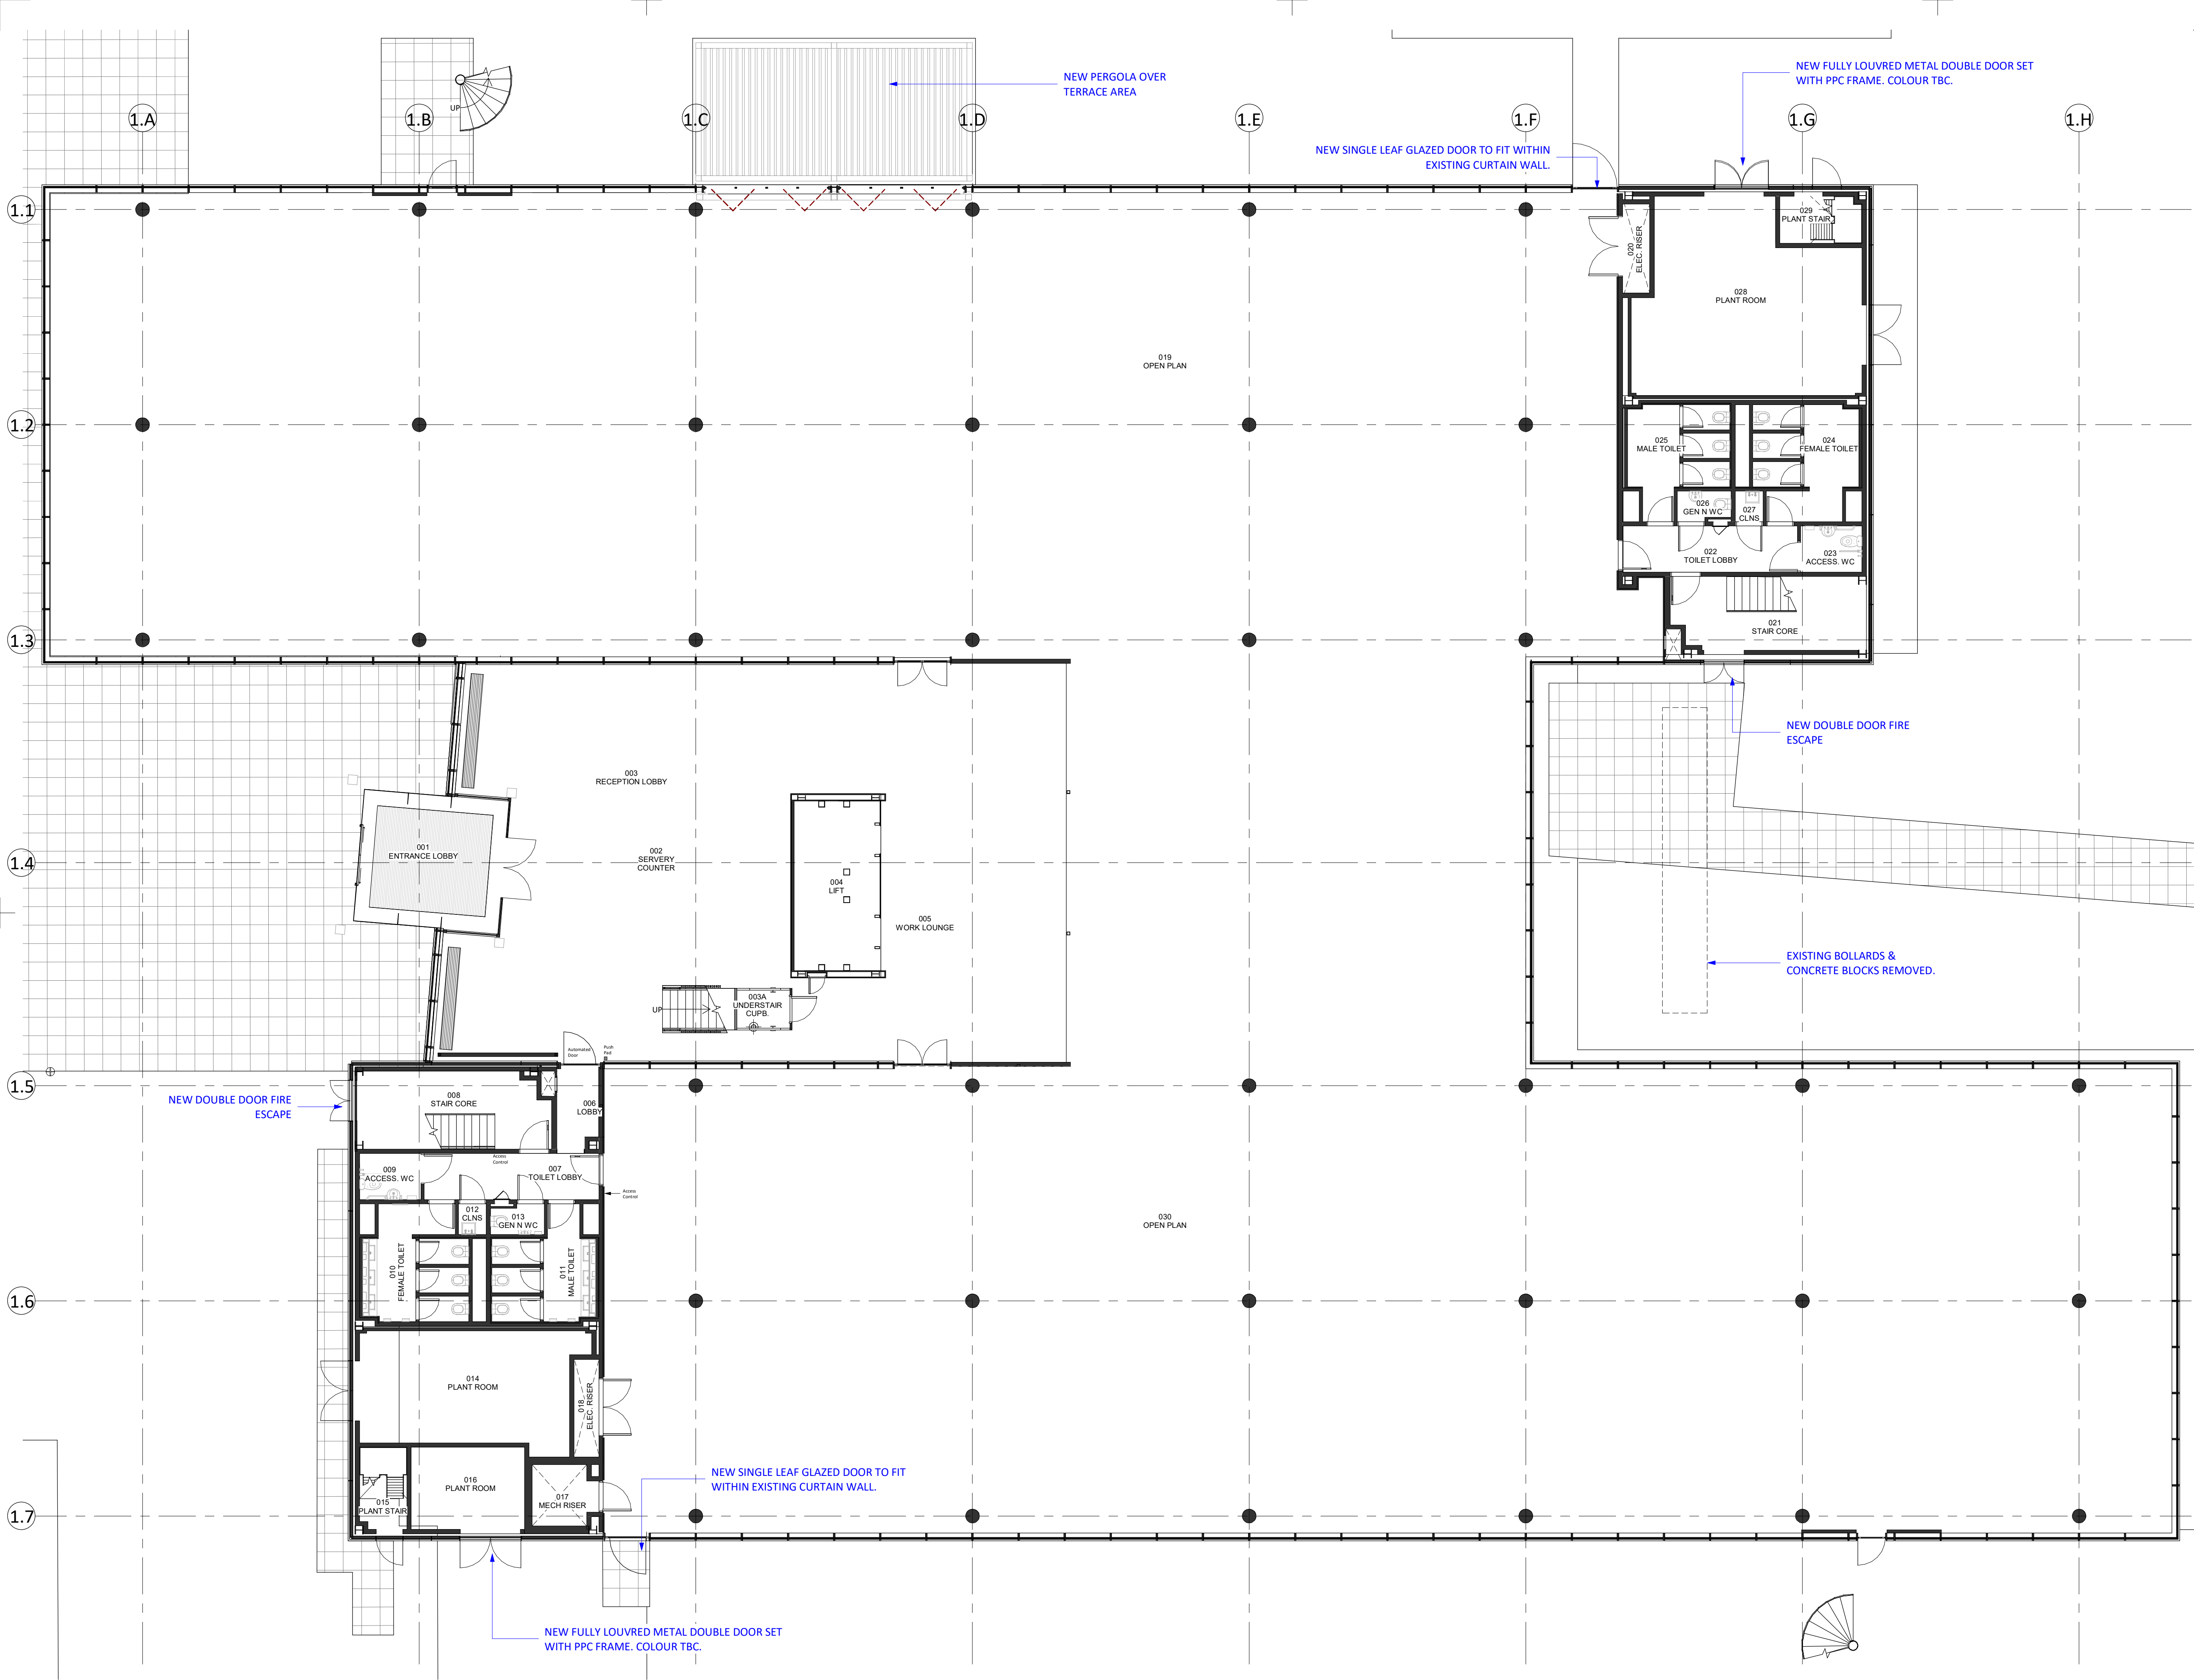

Responsibility is not accepted for errors made by others in scaling from this drawing.
All construction information should be taken from figured dimensions only.

General Notes:
Drawing information has been based on existing record drawings. Stride Treglown accept no responsibility for omissions and errors made in the production of this base line information or errors in new construction information deriving from the existing drawings.

All figured dimensions should be checked on site and any discrepancies reported to Stride Treglown immediately.

This drawing is to be read in conjunction with all other relevant drawings and information prepared by consultants and sub-contractors.

PL	P27	05/11/2024	PLANNING ISSUE FINAL
PL	P22	21/10/2024	UPDATED PLANNING PACK
STATUS	REV	DATE	DESCRIPTION
CLIENT	Mapletree Investments		
REVISD BY	ACS		
CHECKED BY	GW		
ORIGINATOR NO	156210		

CONSULTANT
STRIDE TREGLOWN
www.stridetreglown.com © Stride Treglown Limited 2020
PROJECT
300 Brook Drive
Green Park, Reading RG2 6UB

DRAWING TITLE
Proposed Ground Plan

STATUS CODE	SCALE
PL : Authorized and accepted	1 : 100@A1
DRAWING USAGE: PLANNING ISSUE	
PROJECT - ORIGINATOR - VOLUME - LEVEL - TYPE - ROLE - CLASS - NUMBER	STATUS _ REVISION
156210-STL-XX-00-DR-A-XXXX-10200	PL_P27