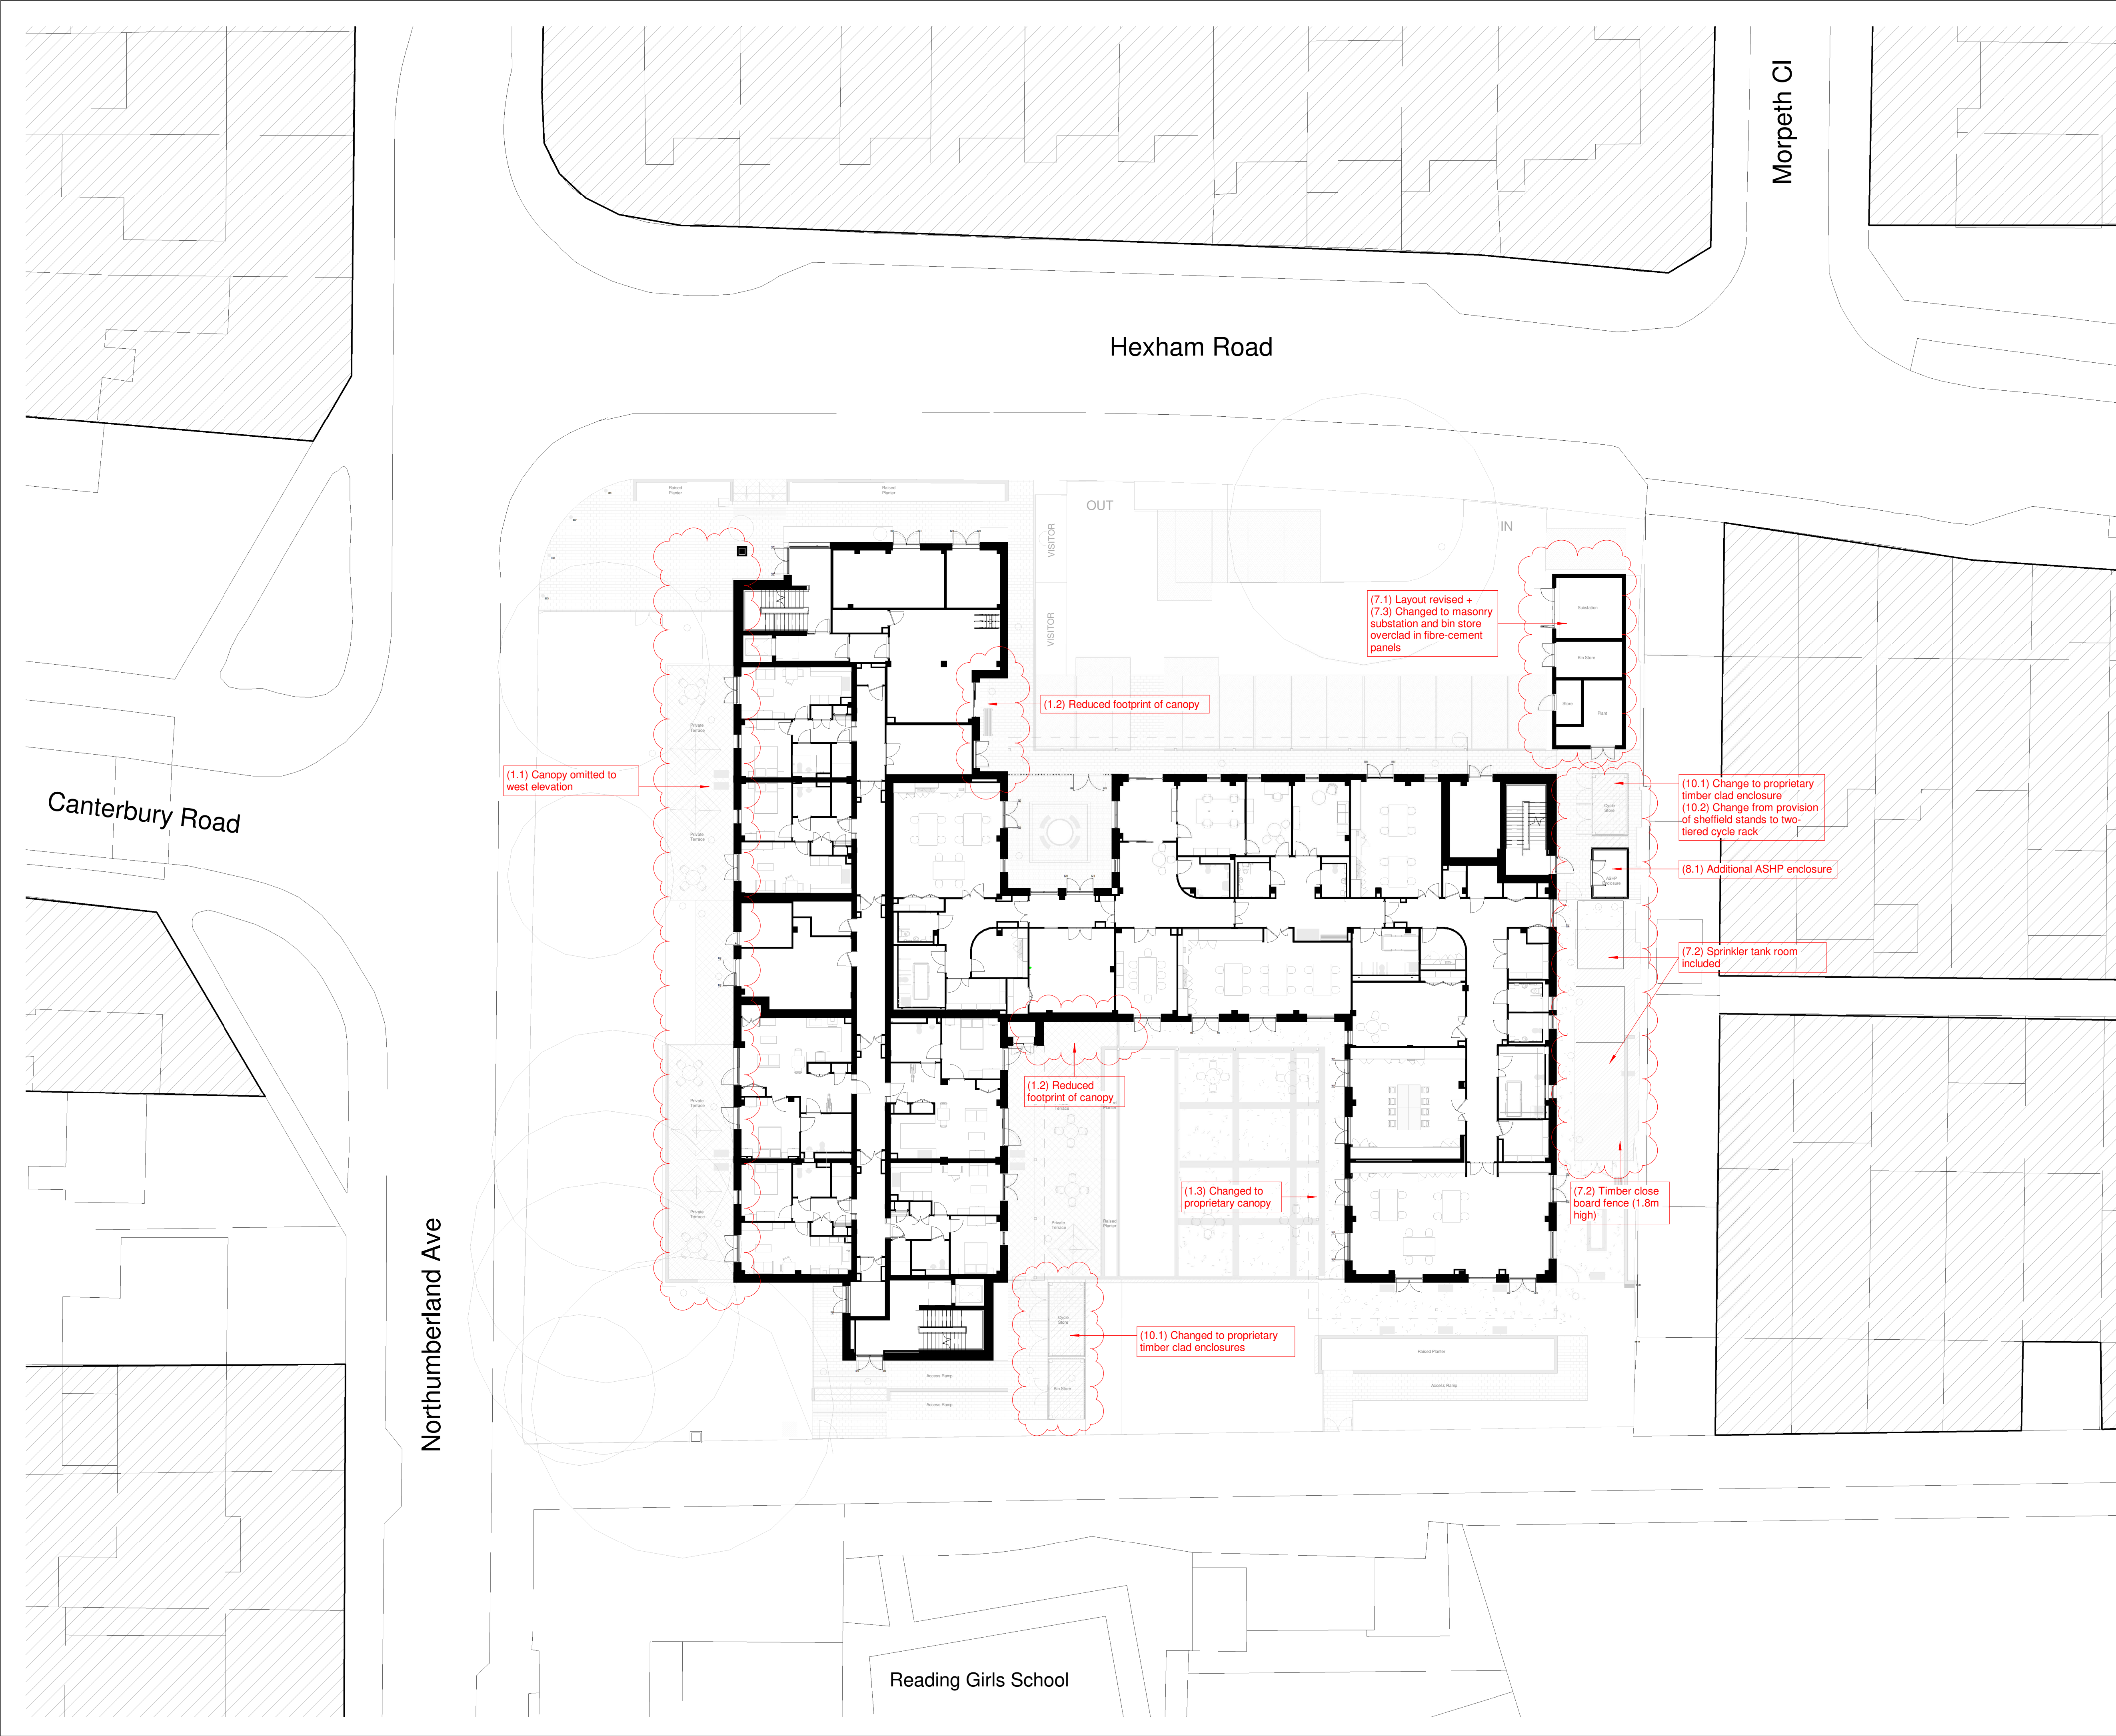


To be read in conjunction with document
HEX-CPM-XX-XX-T-A-00200-Planning Changes

P02	12.11.24	Amalgamation of S73 and NMA application into singular application.	AS
P01	04.10.24	First issue	AS
REV	DATE	DESCRIPTION	BY
CLIENT			

MORGAN
SINDALL
CONSTRUCTION

ORIGINATOR

CPMG

Nottingham: 13 St Peter's Gate, Nottingham, NG1 2JF
London: 218 Rosebery Avenue, Farringdon, EC1R 4BN
Birmingham: Spaces, Level 1, The Mailbox, 3 Wharfside Street, Birmingham, B1 1RD
China: 168 Wuxing Road, Qianjiang New District, Hangzhou
India: 308, Transbay, Sakinaka, Pune, 411045

Let's create something remarkable. responsible. real.

enquiries@cpmg-architects.com cpmg-architects.com

Architecture &
Interior Design

Hexham Road
Architectural Model

DRAWING TITLE

PM_70_90_46 : Landscape record drawings

FLOOR PLANS
GA Site Planning Layout

DRAWING STATUS				
PLANNING				
CLIENT REFERENCE	DRAWN BY	DATE	SCALE	MEDIA
MSC	AS	2023-07-17	1 : 200	A1
FUNCTIONAL PROJECT - ORIGINATOR - BREAKDOWN - BREAKDOWN - FORM - DISCIPLINE - NUMBER				REVISION
HEX-CPM-30-000-D-A-90010				P02

Copyright of CPMG Architects Limited 2024. All rights reserved. No part of this publication may be reproduced, stored in any retrieval system or transmitted in any form or by any means without prior permission of CPMG Architects Limited. Do not scale from drawing. Use figured dimensions only. All dimensions to be checked on site.

ISO 9001:2015 Quality Management ISO 14001:2015 Environmental Management
BS EN ISO 19650:2018 Information Management