




ELEVATION KEY
scale 1:500

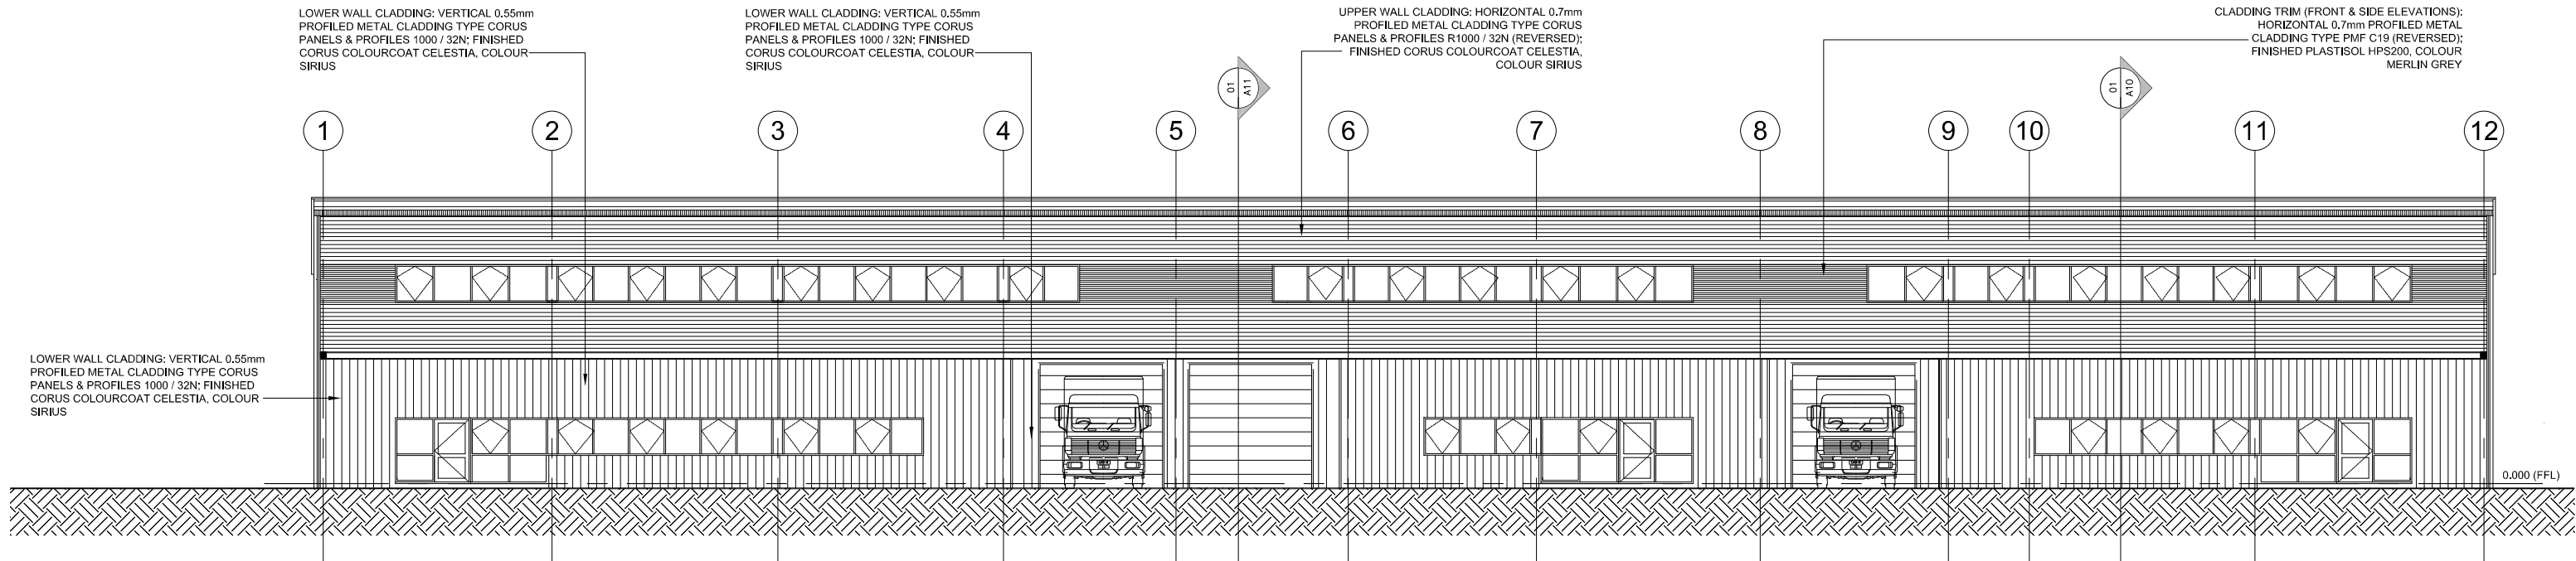

1. SOUTH ELEVATION

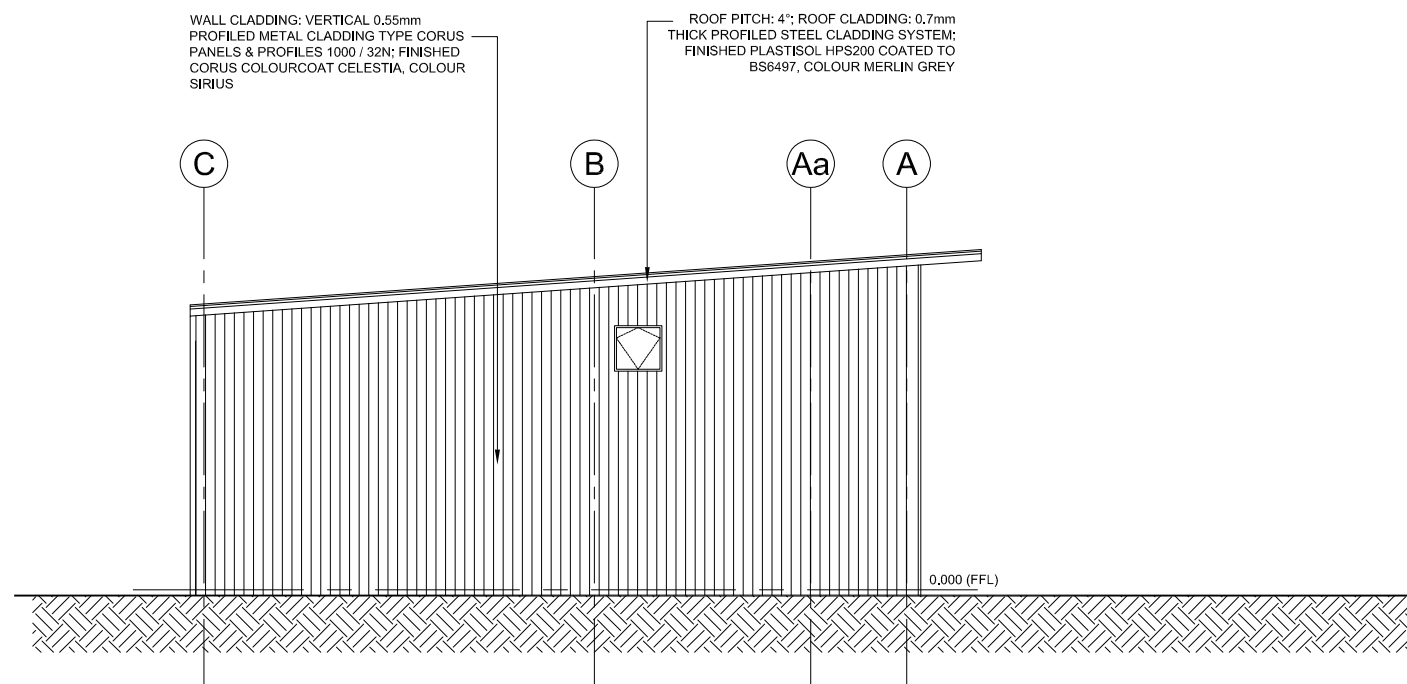

2. WEST ELEVATION

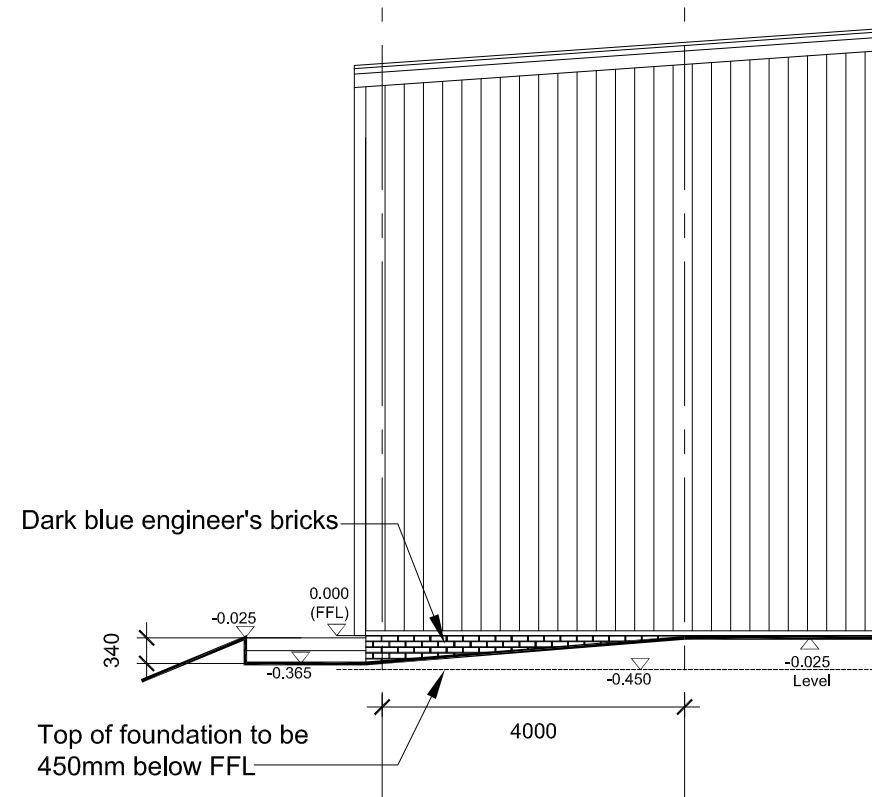

RECORD DRAWING

This drawing represents the last revision issued for construction under the building contract. Note: The content of this drawing has not been verified by site survey and consequently, there may be differences between this drawing and the completed building.

Rev	Notes	By	Issue
C	ISSUED FOR RECORD PURPOSES	03.11.2004	MB HA
B	ISSUED FOR WINDOW SETTING OUT	04.06.23	MB HA
A	Issued for Construction - elevation added showing facing brickworks along grid line C1	14.06.2004	JW HA

FOR RECORD

Do not scale from this drawing. Check all dimensions on site.

hamilton associates

280 Kings Road
London SW3 5AW

T: 020 7351 5432
F: 020 7352 7361
E: ha@hamilton-assoc.com
www.hamiltonassociates.co.uk

Project:	BENNET ROAD		
Reading:	READING		
Unit:	UNIT 1, 2 & 3		
Elevations Sheet:	ELEVATIONS SHEET 1		
Project No:	Drawing No:	Revision:	
22417	L104	C	
Scale: 1:100 @ A1	CAD File No: N:\22417\Cur\Rec\L104		
Date: 10.05.2004	Drawn: JW	Issue: HA	