




ELEVATION KEY
scale 1:500

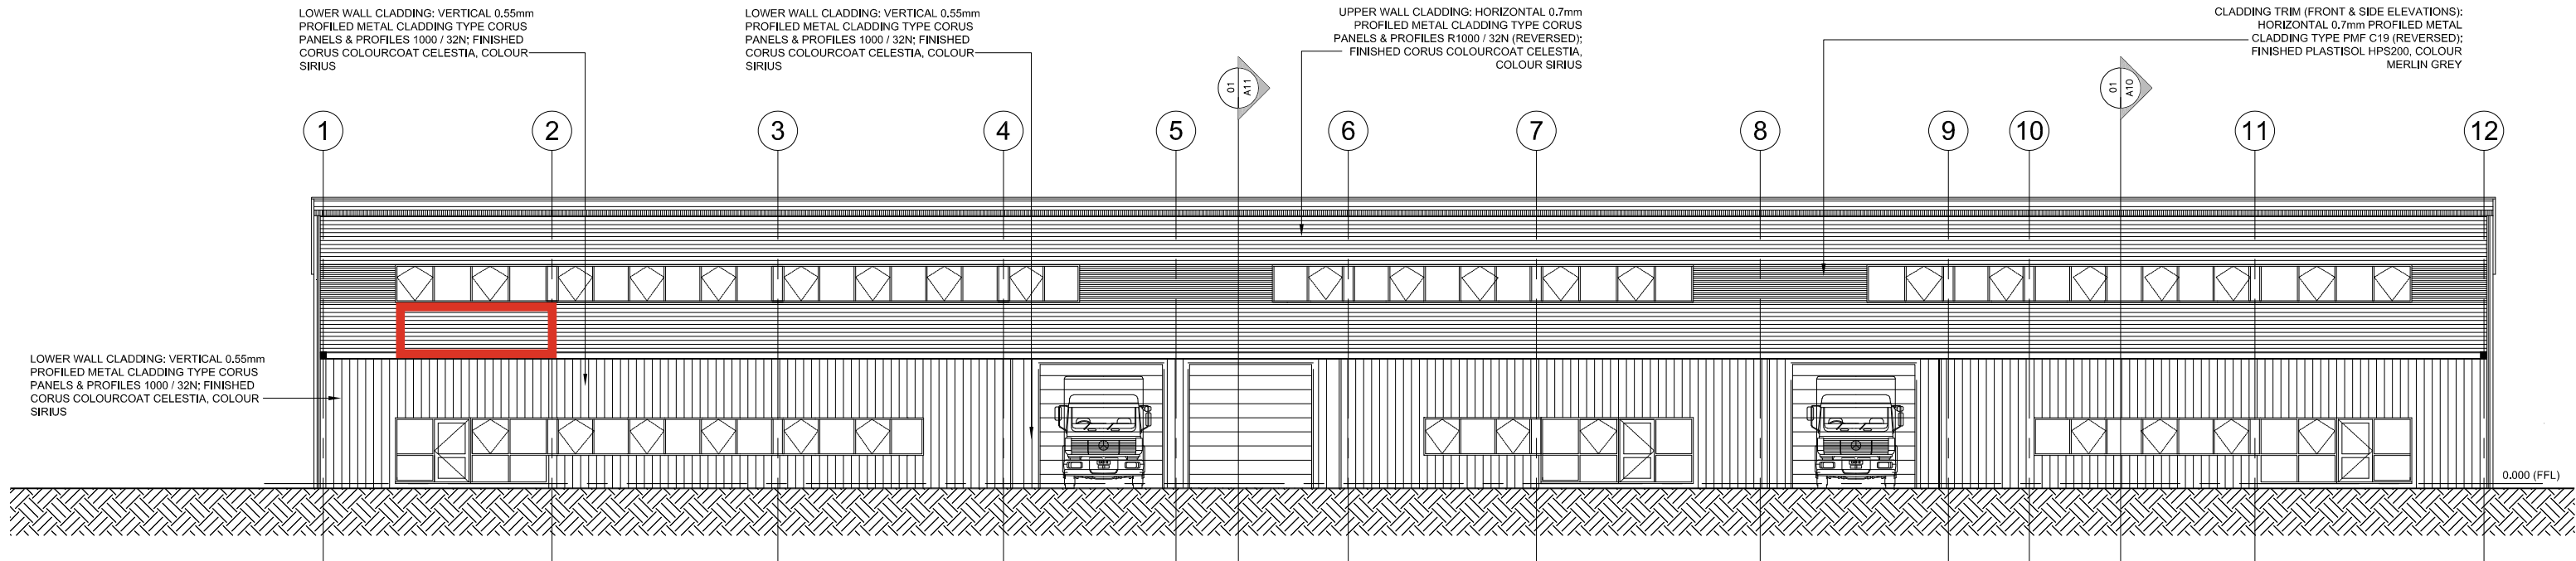

1. SOUTH ELEVATION

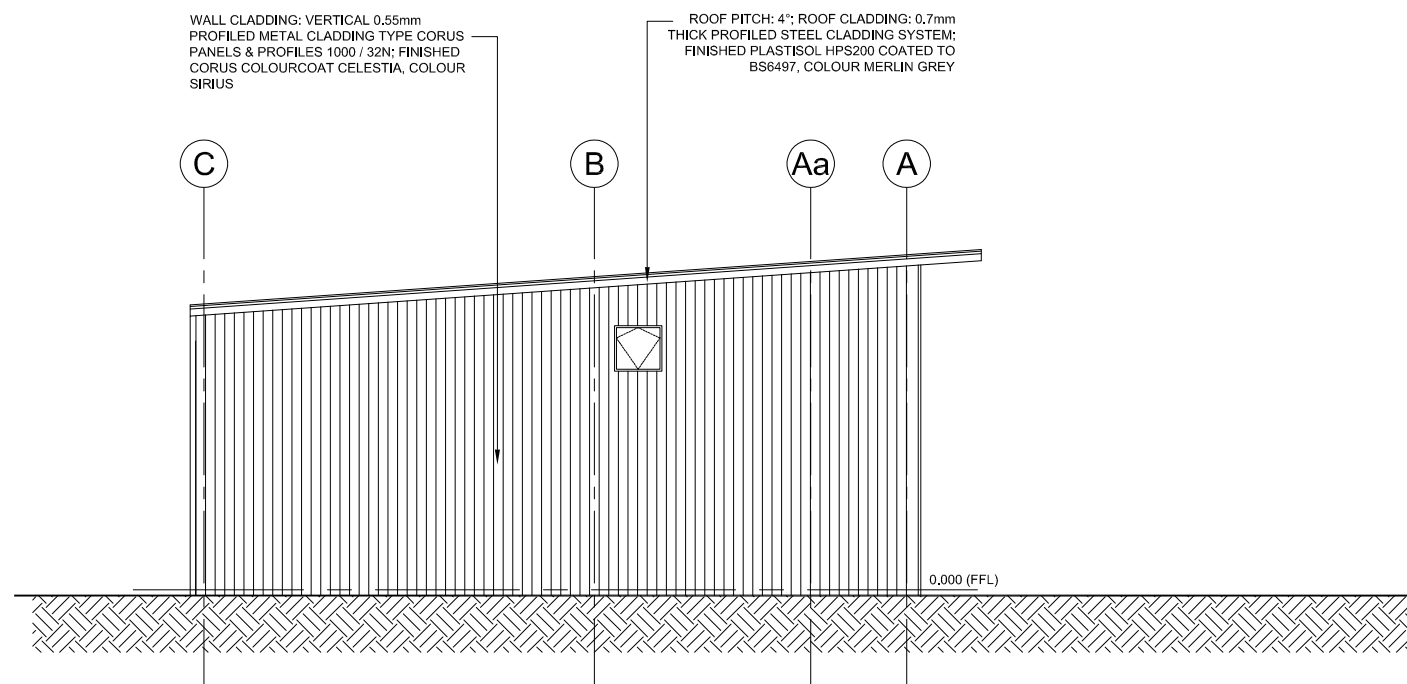

2. WEST ELEVATION

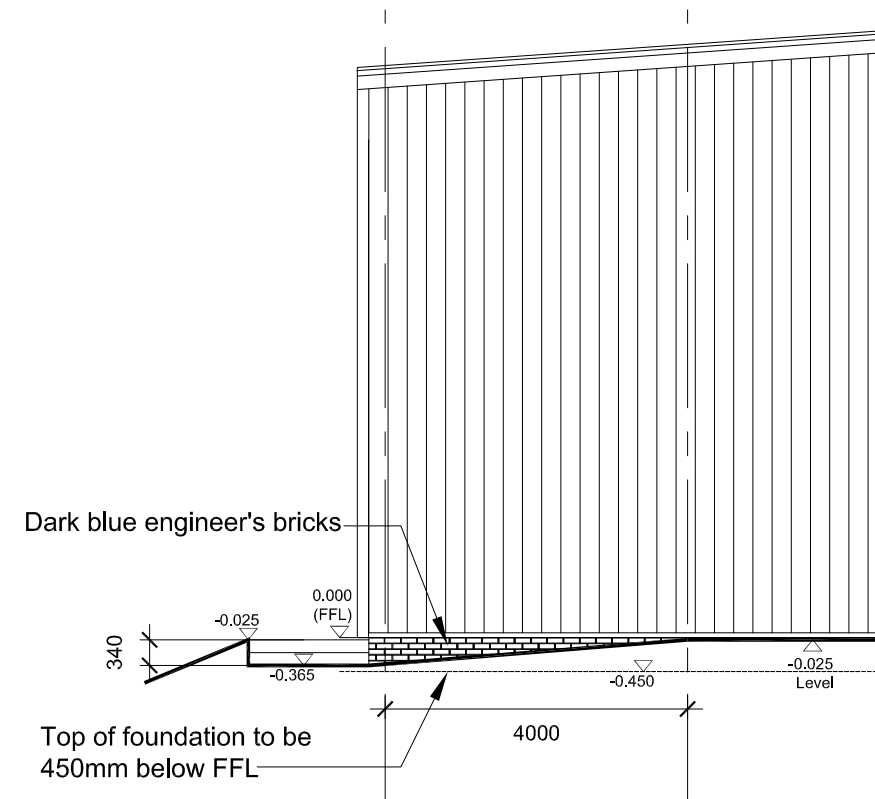

RECORD DRAWING

This drawing represents the last revision issued for construction under the building contract. Note: The content of this drawing has not been verified by site survey and consequently, there may be differences between this drawing and the completed building.

C	ISSUED FOR RECORD PURPOSES	03.11.2004	MB	HA
B	ISSUED FOR WINDOW SETTING OUT	04.06.23	MB	HA
A	Issued for Construction - elevation added showing facing brickworks along grid line C1	14.06.2004	JW	HA
Rev	Notes	yy.mm.dd	By	Issue

FOR RECORD

Do not scale from this drawing. Check all dimensions on site.

hamilton associates

280 Kings Road
London SW3 5AW

T: 020 7351 5432
F: 020 7352 7361
E: ha@hamilton-assoc.com
www.hamiltonassociates.co.uk

Project:	BENNET ROAD		
	READING		
Title:	UNIT 1, 2 & 3		
	ELEVATIONS SHEET 1		
Project No:	Drawing No:	Revision:	
22417	L104	C	
Scale: 1:100 @ A1	CAD File No: N:\22417\Cur\Rec\L104		
Date: 10.05.2004	Drawn: JW	Issue: HA	