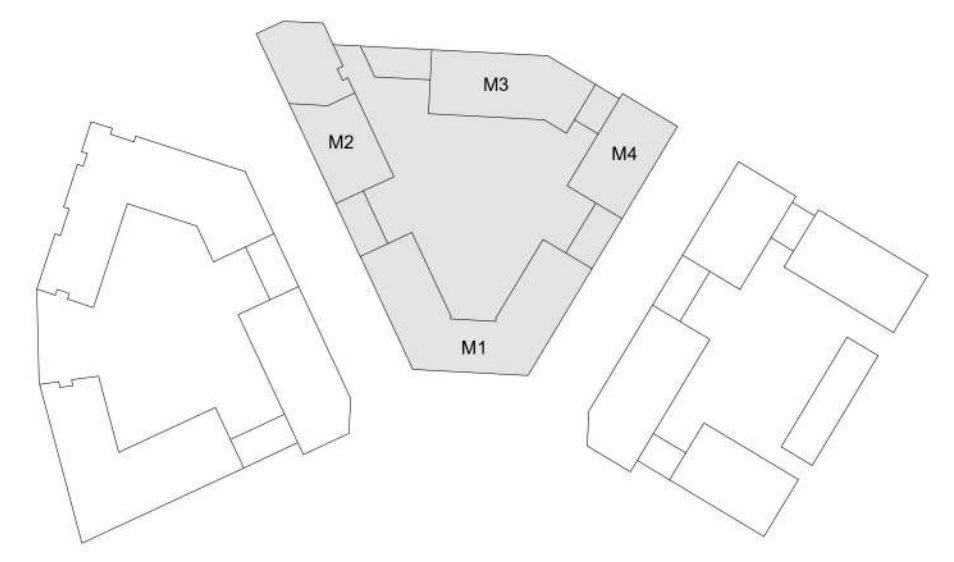
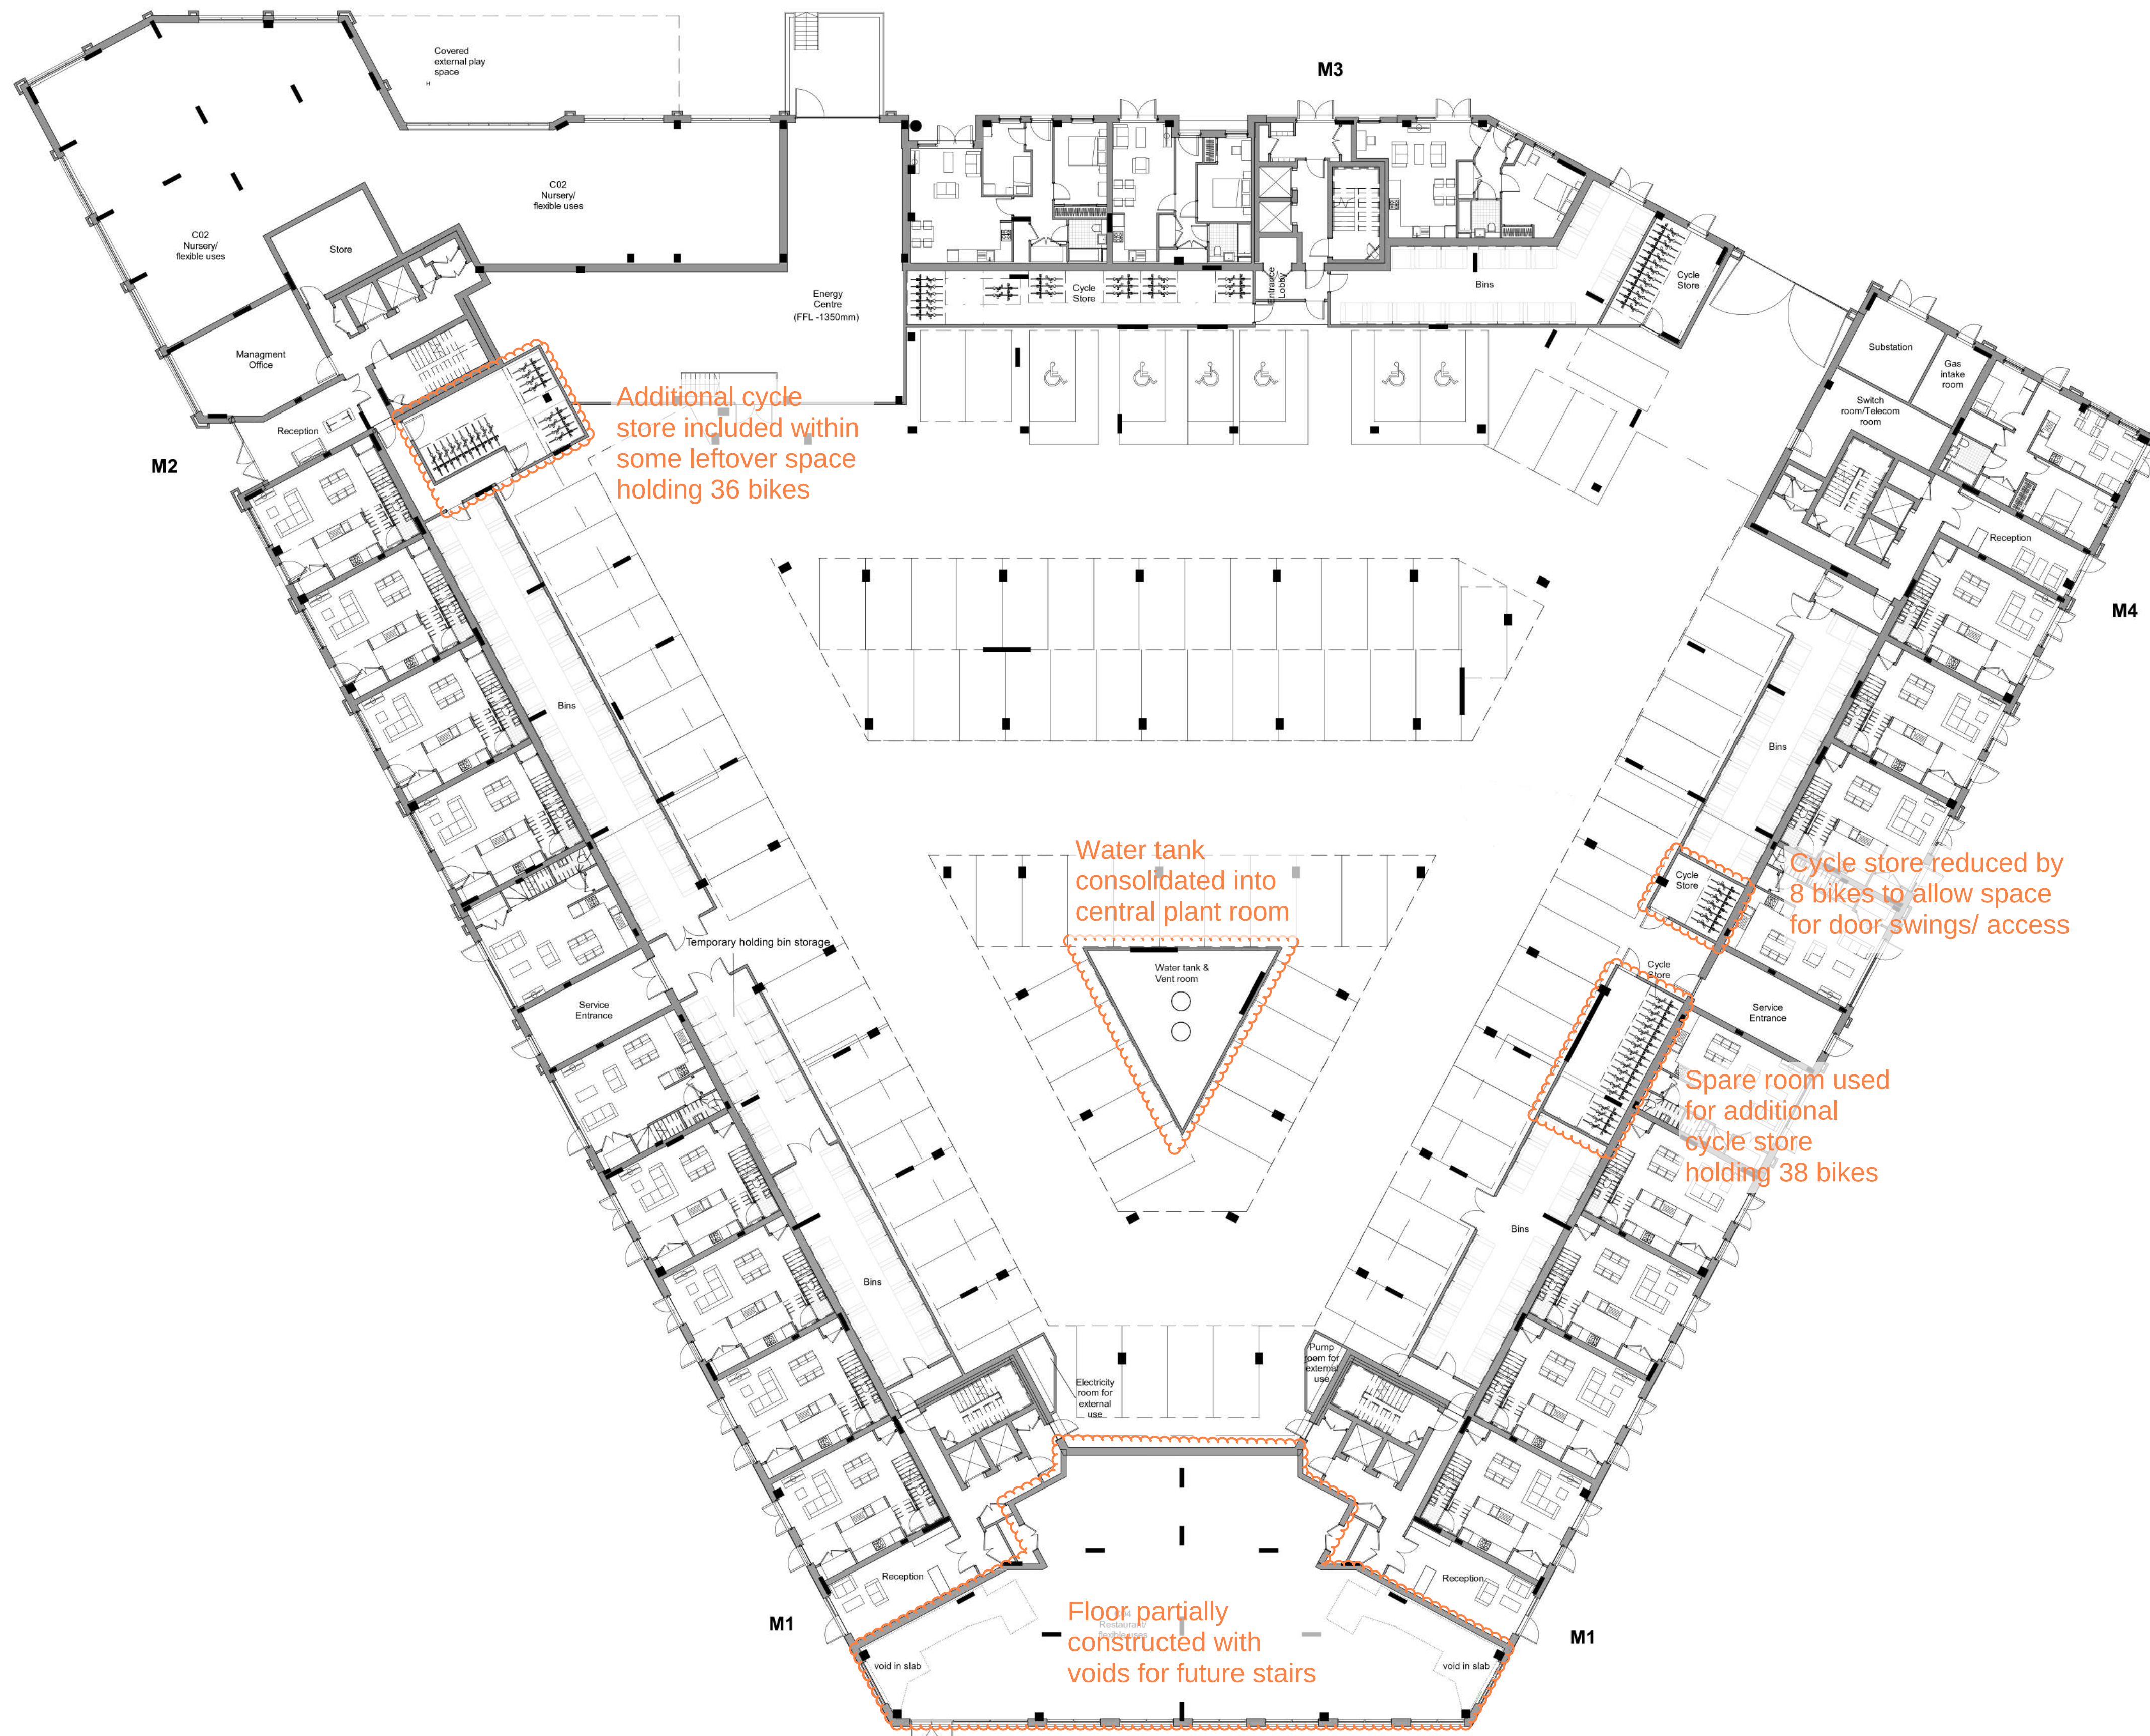


0m 5m 10m 15m

CDM REGULATIONS 2015. All current drawings and specifications for the project must be read in conjunction with the Designer's Hazard and Environment Assessment Record. All intellectual property rights reserved.

As Built



Rev	Date	Description
A	27/01/17	First Issue
B	22/03/17	For submission
C	13/07/17	Cycle Storage Revised
D	07/02/20	Cores updated to reduce travel distances
E	07/07/21	Energy Centre Minor Update
F	15/05/25	Cycle/Bin Storage Revised

Dwn	Ckd	Drawn	KR
FR	CS	Checked	CS
FR	CS	Date	Jan 2017
GS	RS	Scale @ A1	As indicated
AC	RS		
YW	YW		

Kenavon Drive
Middle Block
Ground Floor

AA5990-2140
REV E
FOR PLANNING

PRP

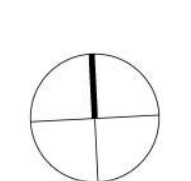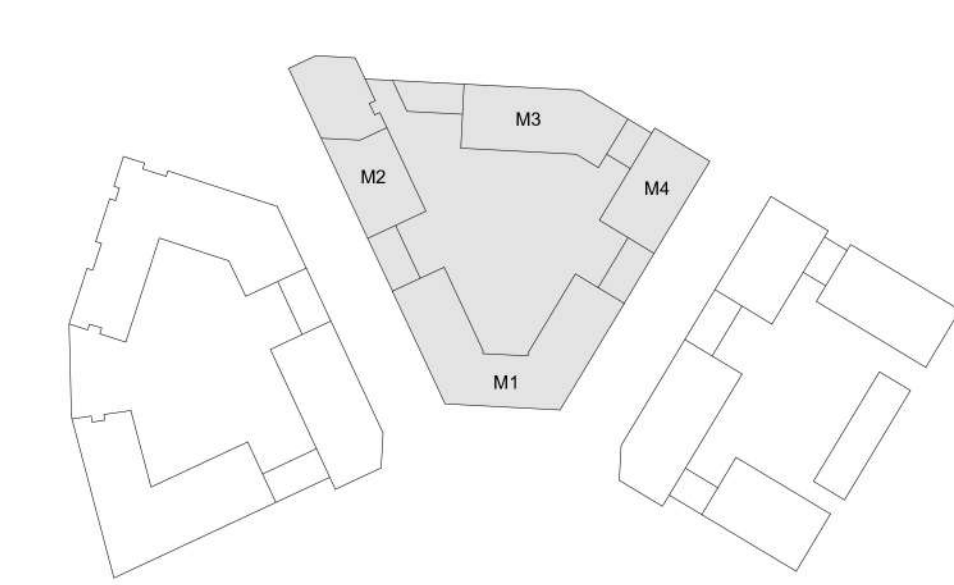

CDM REGULATIONS 2015. All current drawings and specifications for the project must be read in conjunction with the Designer's Hazard and Environment Assessment Record. All intellectual property rights reserved.

As Built

Rev	Date	Description	Dwn	Ckd	Drawn	KR
B	12/04/17	Post submission comments	FR	CS	Checked	CS
C	07/02/20	Cores updated to reduce travel distances	GS	RS		
D	06/05/20	Updated following RBC feedback on NMA 02 application	GS	RS		
E	03/12/20	East & Mid-Block Podium gardens Updated for BHOC Site Layout and Podium Application	AC	RS		
F	15/05/25	Podium Landscape Revised	YW	YW	Scale @ A1	As indicated

Kenavon Drive
Middle Block
First Floor

AA5990-2141
REV F
FOR PLANNING



Materials Legend

M-BA 03

M-BA 05

M-BA 07

M-BA 10

M-C 07

M-C 08

M-C 09

M-C 14

M-C 22

M-WD 08

M-WD 09

PPC Metal balustrade Juliet

Cantilevered glass balustrade to inset balcony

Cantilevered glass balustrade with fitted bands to match M-C 09

Precast concrete balcony fascia

Brick / mortar colour C (Light)

Brick / Mortar colour C soldier course (Light)

Brick / mortar colour C alternating 25mm projecting (Light)

Precast concrete band course



Entrance canopy PCC metal cladding


Block entrance door/window assembly

Gold coloured frame glazed window / door assembly

North

South

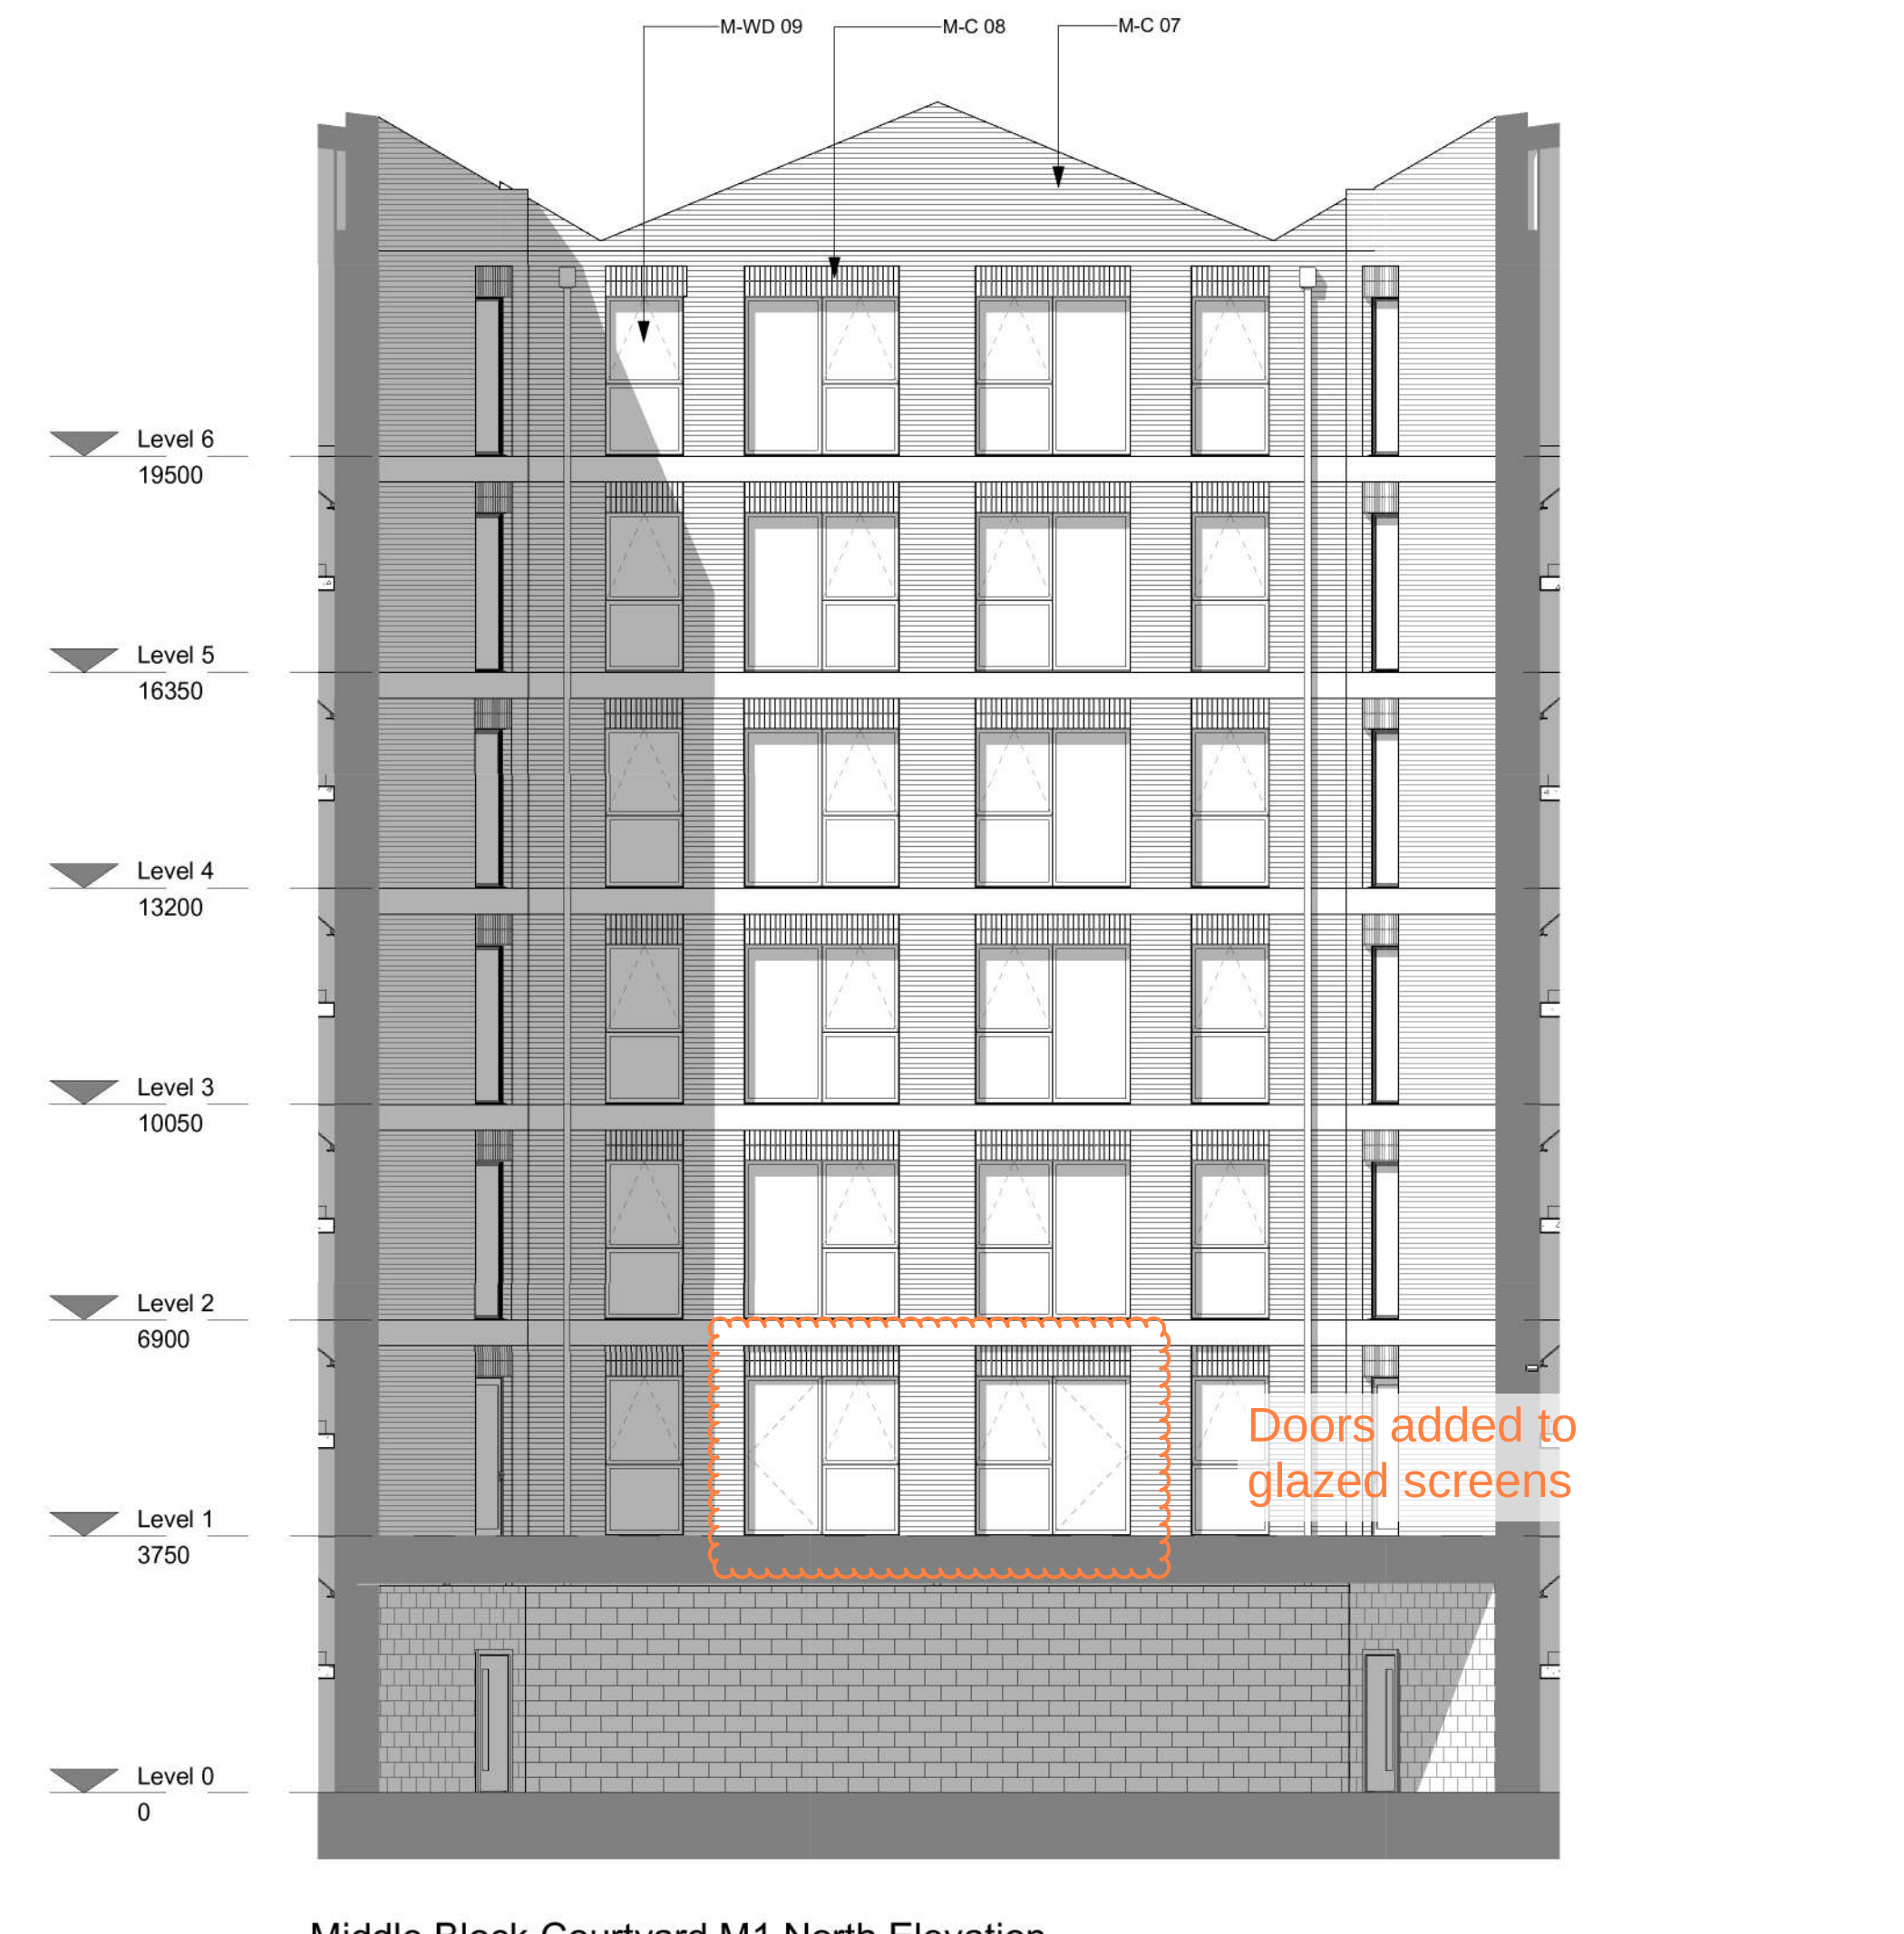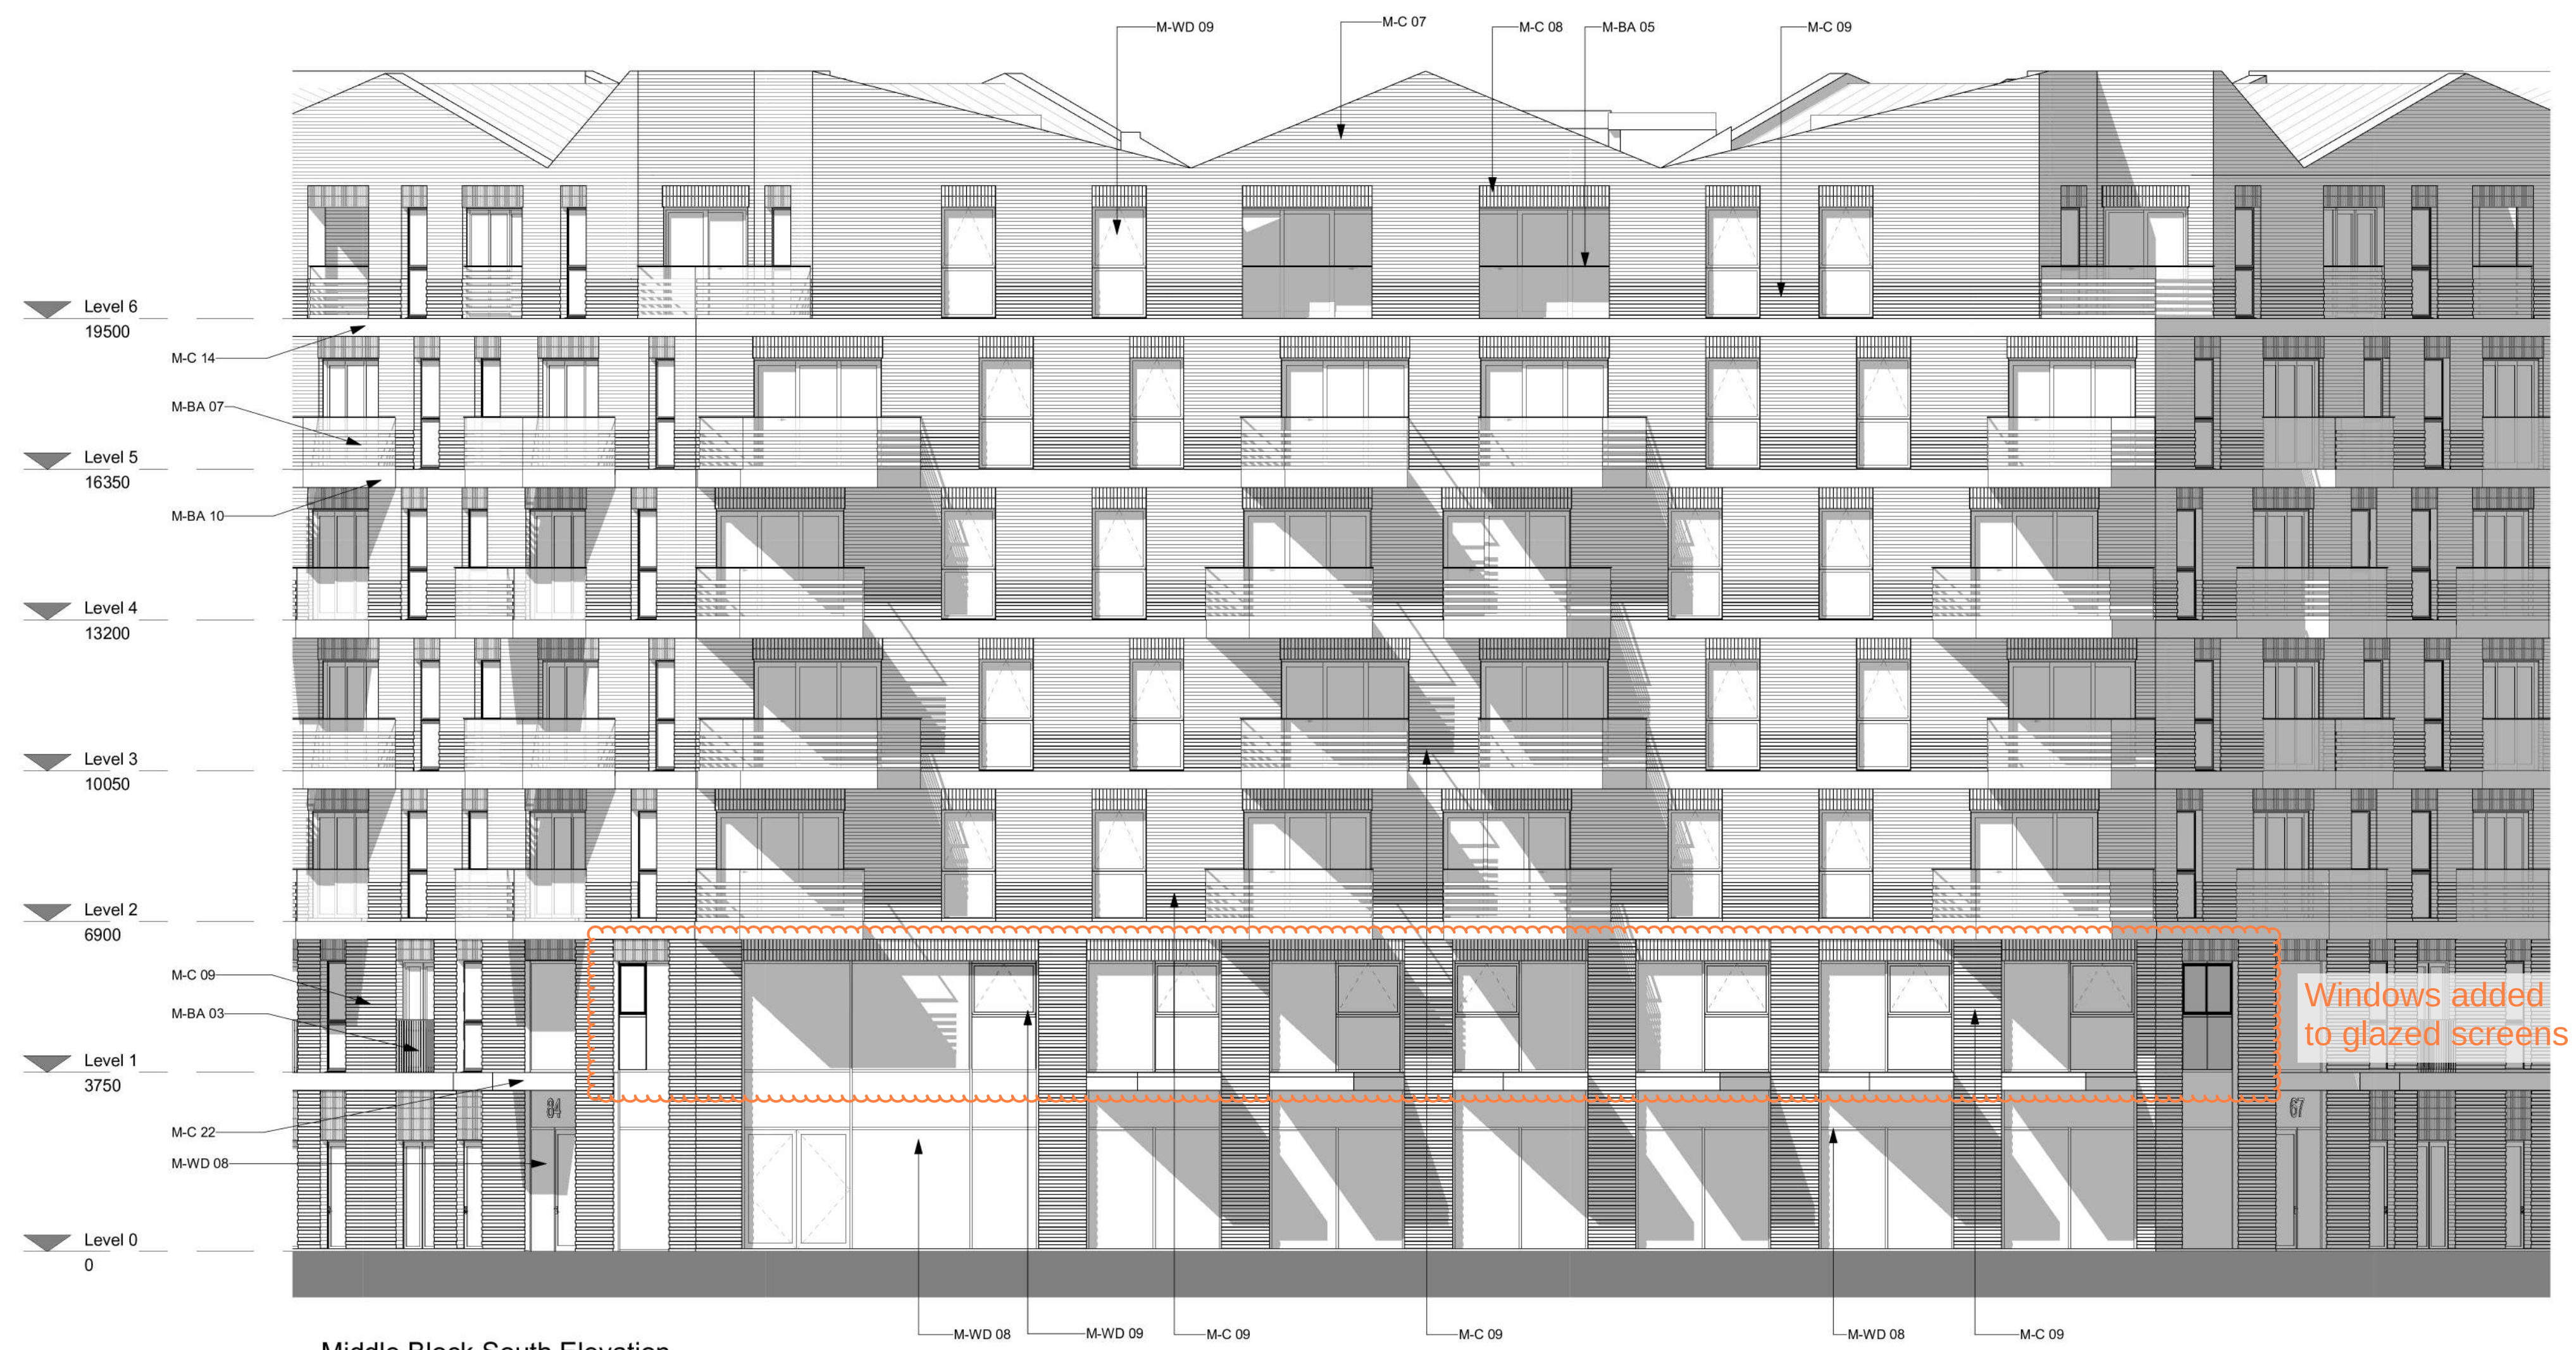

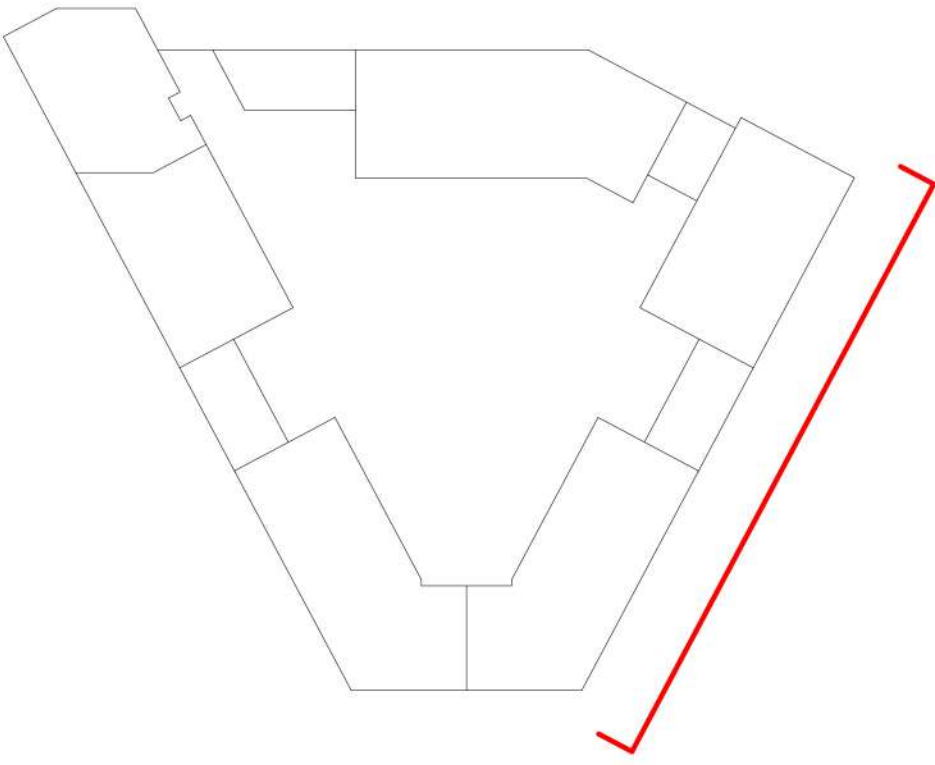

Materials Legend

- M-BA 03 PPC Metal balustrade Juliet
- M-BA 07 Cantilevered glass balustrade with fritted bands to match M-C 09
- M-C 01 Brick / mortar colour A (Dark)
- M-C 03 Brick / mortar colour A soldier course (Dark)
- M-C 04 Brick / mortar colour B (Medium)
- M-C 05 Brick / mortar colour B soldier course (Medium)
- M-C 07 Brick / mortar colour C (Light)
- M-C 08 Brick / mortar colour C soldier course (Light)
- M-C 09 Brick / mortar colour C alternating 25mm projecting (Light)
- M-C 14 Precast concrete band course
- M-C 16 Metal panel cladding colour A (Dark)
- M-C 17 Metal panel cladding colour B (Gold)
- M-WD 01 Dark grey coloured frame glazed window / door assembly
- M-WD 08 Block entrance door/window assembly
- M-WD 09 Gold coloured frame glazed window / door assembly



As Built

Rev	Date	Description
-	27/01/17	First Issue
-	22/03/17	For submission
A	25/10/19	Issued for S73 Re-submission
B	15/05/25	M5 first floor glazing updated

Dwn	Ckd	Drawn	GS
FR	CS	Checked	CS
AMC	RS	Date	Jan 2017
YW	YW	Scale @ A1	100


Kenavon Drive
Middle Block East Elevation

AA5990-2223
REV B
FOR PLANNING

PRP

Materials Legend

M-BA 02	PPC Metal balustrade front, balusters turned 45 deg
M-BA 07	Canilevered glass balustrade with fritted bands to match M-C 09
M-BA 09	Fair faced pre-cast concrete fascia & soffit to projected balcony
M-C 01	Brick / mortar colour A (Dark)
M-C 03	Brick / mortar colour A soldier course (Dark)
M-C 04	Brick / mortar colour B (Medium)
M-C 05	Brick / mortar colour B soldier course (Medium)
M-C 07	Brick / mortar colour C (Light)
M-C 08	Brick / Mortar colour C soldier course (Light)
M-C 09	Brick / mortar colour C alternating 25mm projecting (Light)
M-C 14	Precast concrete band course
M-C 22	Entrance canopy PPC metal cladding
M-WD 01	Dark grey coloured frame glazed window / door assembly
M-WD 08	Block entrance door/window assembly

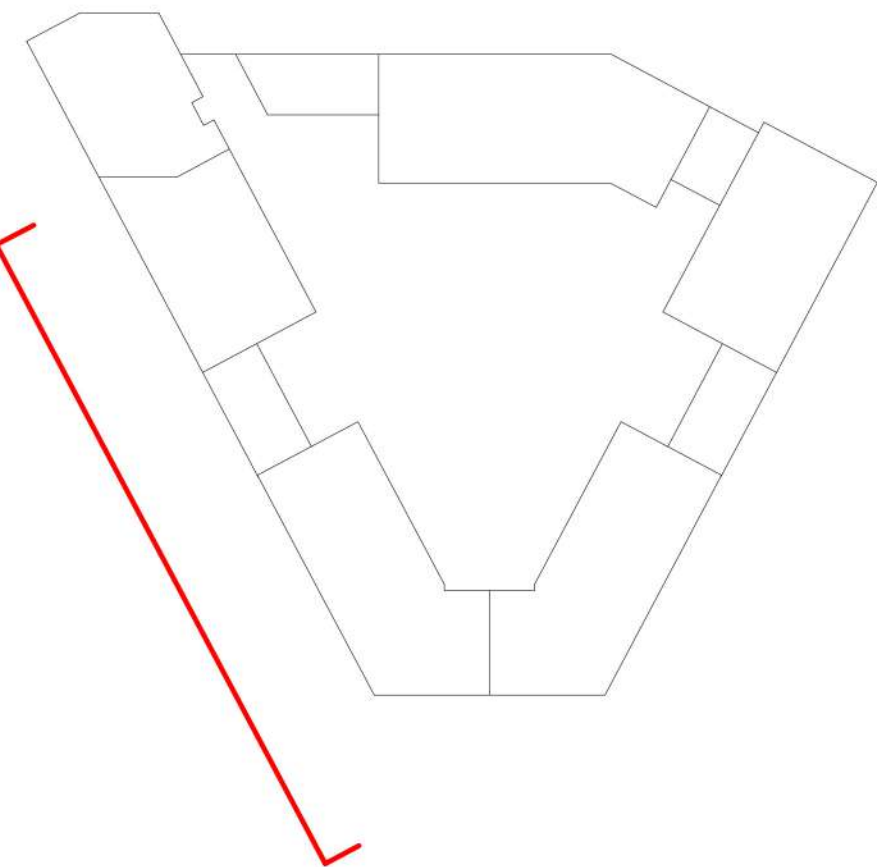

0m 2m 4m 6m 8m

CDM REGULATIONS 2015. All current drawings and specifications for the project must be read in conjunction with the Designer's Hazard and Environment Assessment Record. All intellectual property rights reserved.

As Built


Rev	Date	Description
-	22/03/17	For submission
A	11/03/19	Issued for S73 Coordination
B	29/03/19	Issued for S73 application
C	07/05/19	Levels added. Re-issued for S73
D	25/10/19	Issued for S73 Re-submission
E	15/05/25	M1 first floor glazing updated

Dwn	Ckd	Drawn	GS
FR	CS	Checked	CS
MC	RS		
MC	RS		
AMC	RS	Date	Jan 2017
YW	YW	Scale @ A1	100

Kenavon Drive
Middle Block West Elevation

AA5990-2225
REV E
FOR PLANNING

PRP

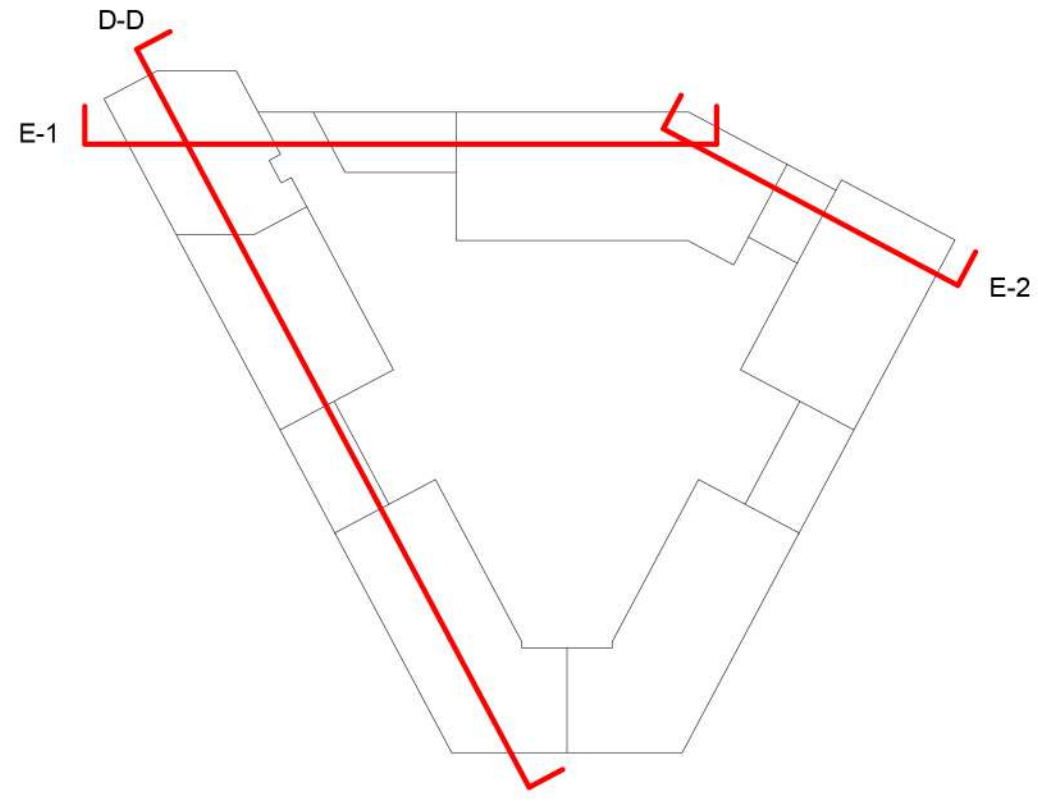

Middle Block Section D-D
1 : 150

As Built

Rev	Date	Description
-	22/03/17	For submission
A	29/03/19	Issued for S73 application
B	25/10/19	Issued for S73 Re-submission
C	15/05/25	M1 first floor slab added

Dwn	Ckd	Drawn	KR
FR	CS	Checked	CS
MC	RS	Date	Jan 2017
AMC	RS	Scale @ A1	As indicated
YW	YW		

Kenavon Drive
Middle Block Sections

AA5990-2320
REV C
FOR PLANNING

PRP


Materials Legend

M-BA 05	Cantilevered glass balustrade to inset balcony
M-BA 07	Cantilevered glass balustrade with fritted bands to match M-C 09
M-BA 10	Precast concrete balcony fascia
M-C 07	Brick / mortar colour C (Light)
M-C 08	Brick / mortar colour C soldier course (Light)
M-C 09	Brick / mortar colour C alternating 25mm projecting (Light)
M-C 14	Precast concrete band course
M-C 32	Metal panel cladding - perforated panel with banding
M-WD 09	Gold coloured frame glazed window / door assembly



Bay Study 4 Middle Block South Elevation
1 : 100

Windows added to glazed screens

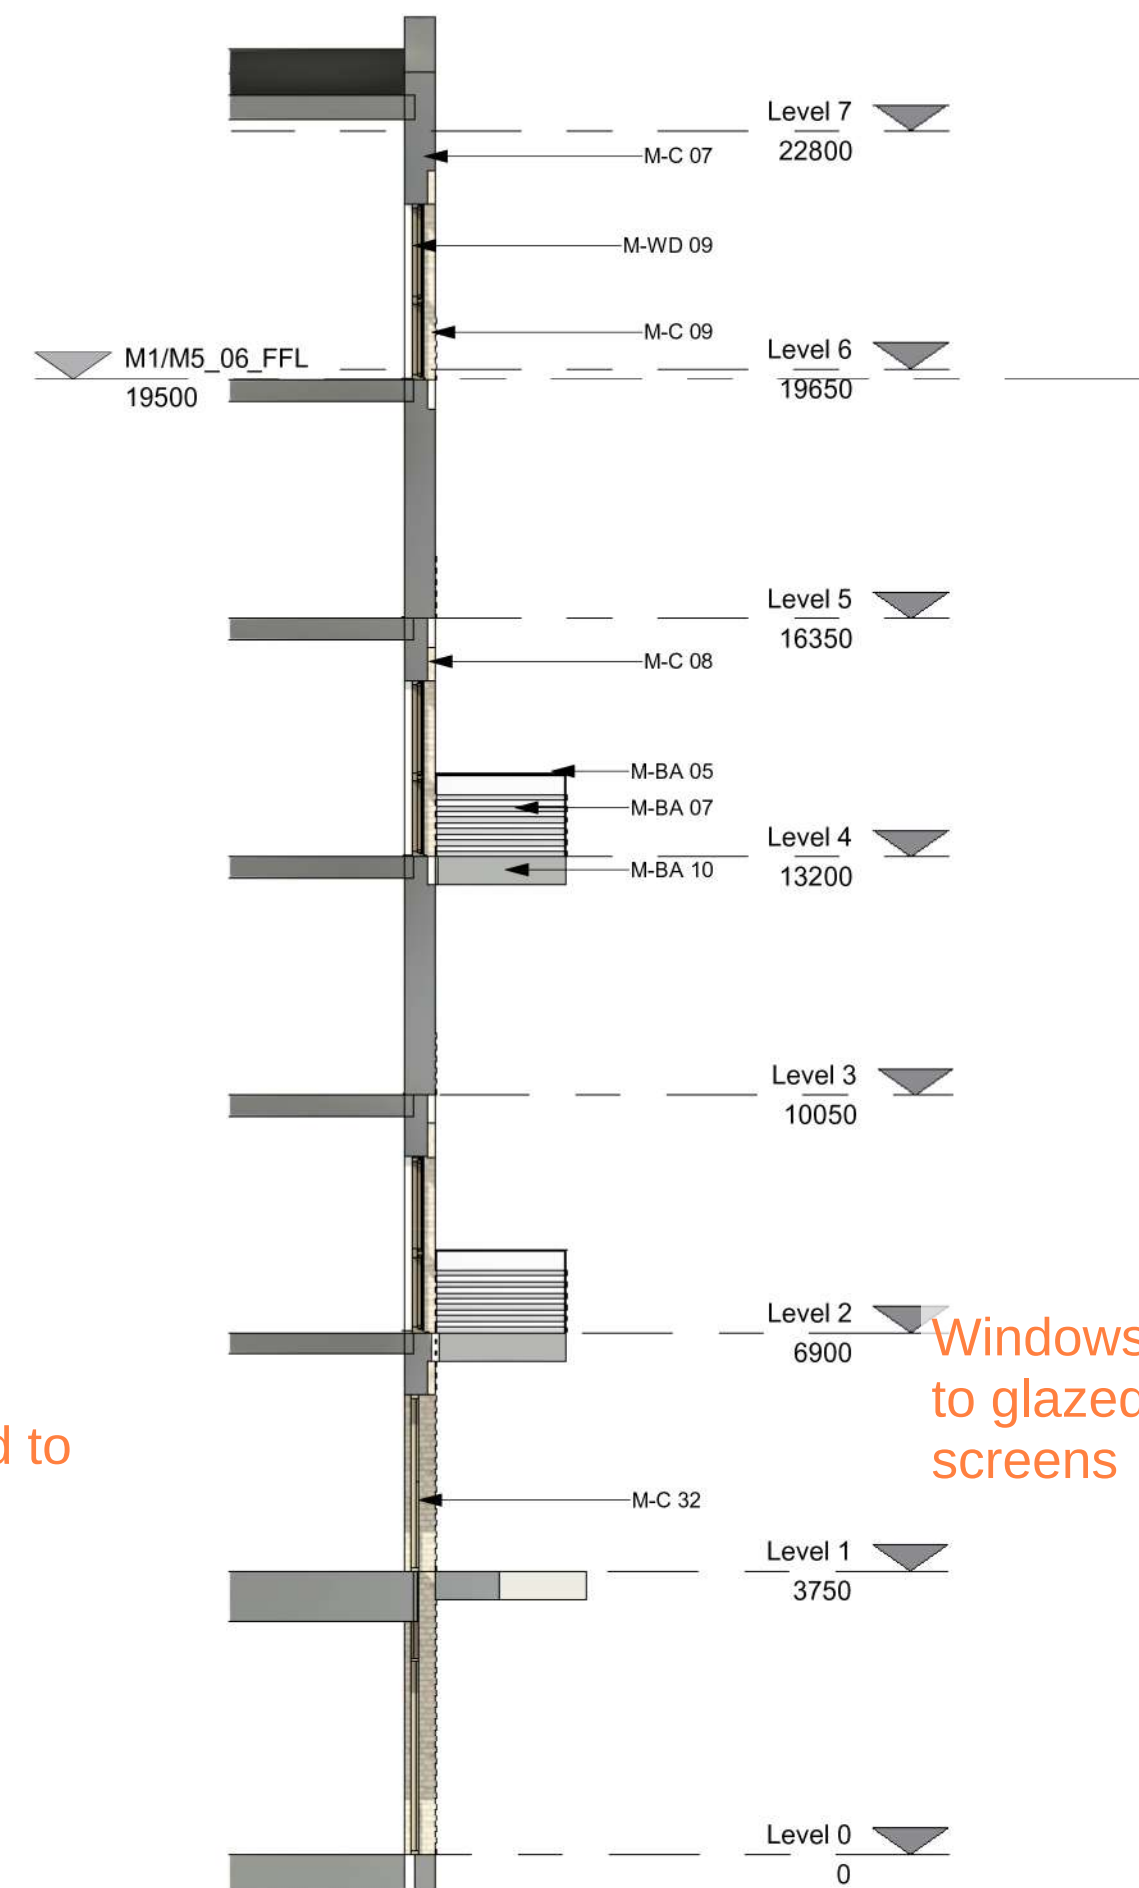


Bay Study 4 Section A-A
1 : 100


Windows added to glazed screens



Bay Study 4 Axonometric

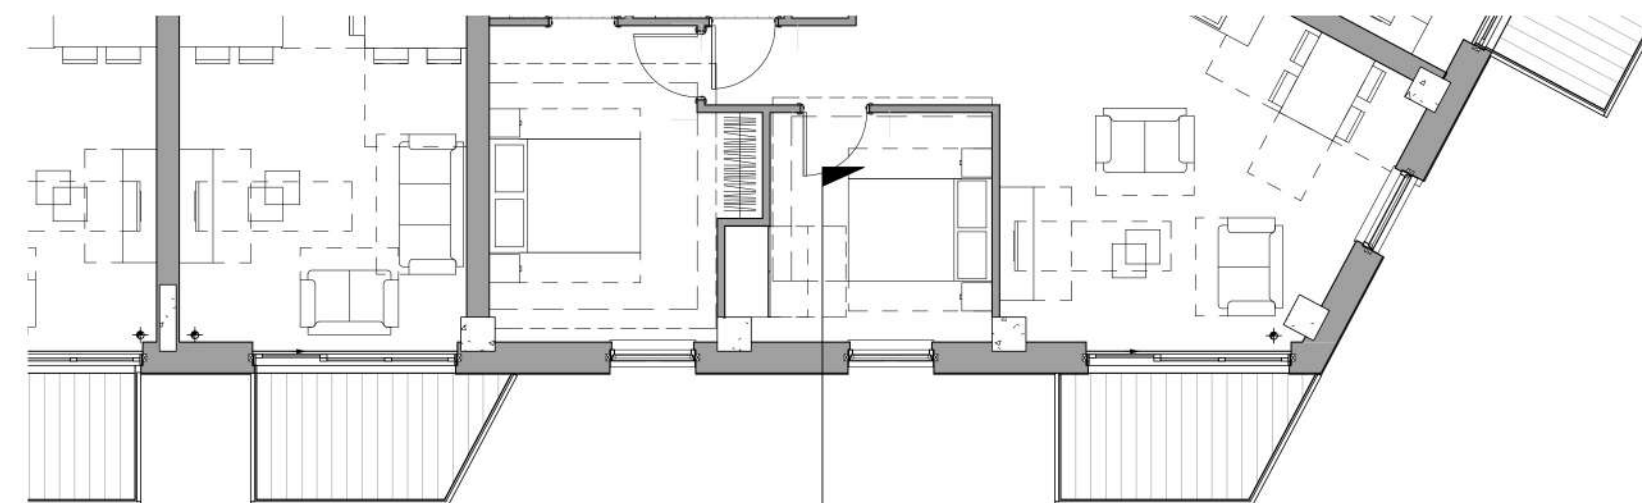

Bay Study 4 Level 3
1 : 100

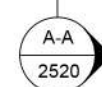

As Built

Rev	Date	Description
-	27/01/17	First Issue
-	22/03/17	For submission
A	15/05/25	M1 & M5 first floor glazing updated

Dwn	Ckd	Drawn	KR
FR	CS	Checked	CS
FR	CS	Date	Jan 2017
YW	YW	Scale @ A1	1 : 100

Kenavon Drive
Bay Study 4
Block M1

AA5990-2520
REV A
FOR PLANNING

PRP