





PROPOSED FRONT ELEVATION

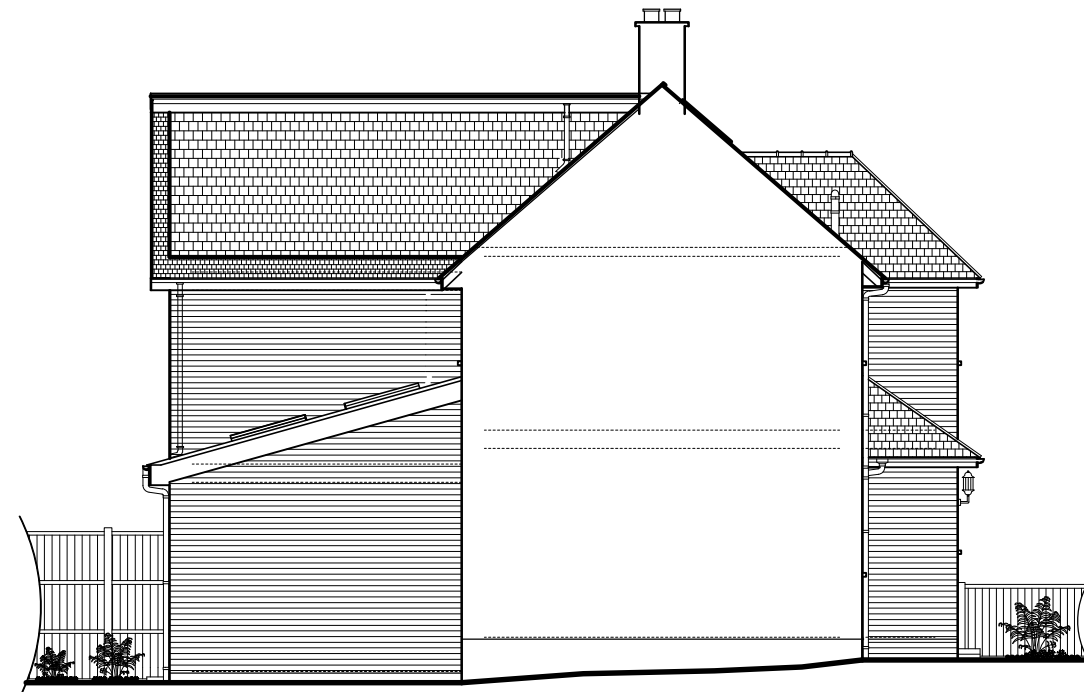


PROPOSED LEFT HAND SIDE ELEVATION (same as approved)

PROPOSED SECTION IS SHOWN IN RED TO CLEARLY IDENTIFY THE CHANGES PROPOSED AND OTHER AREAS AS PER THE APPROVED DRAWINGS REF 211335

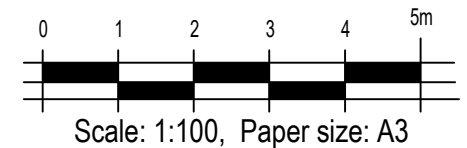

PROPOSED REAR ELEVATION

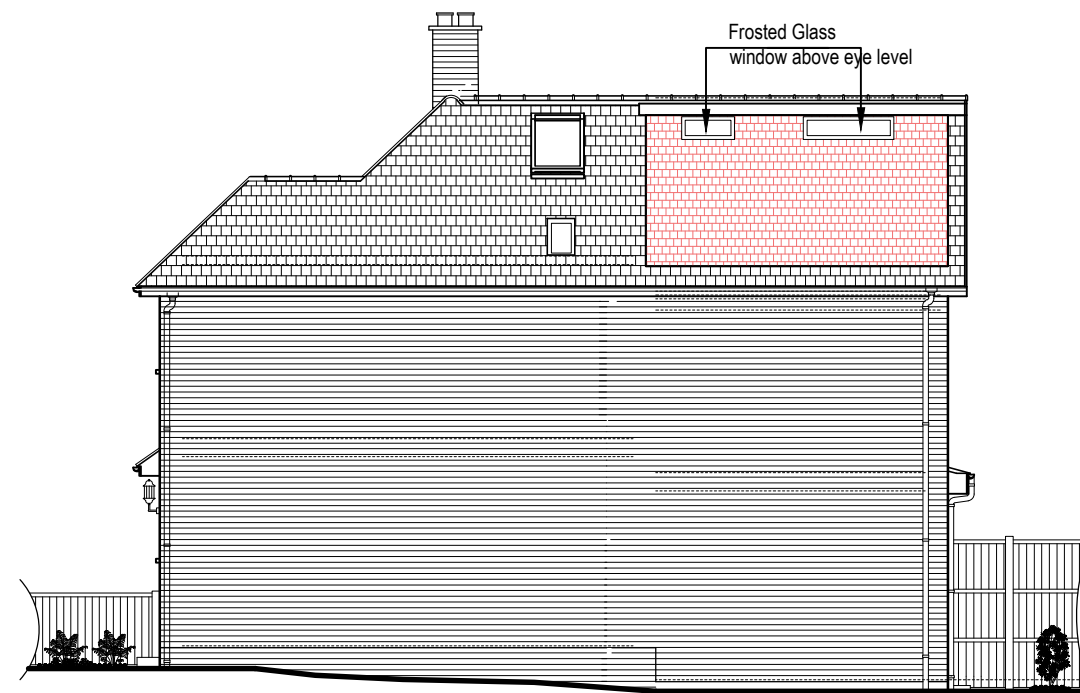

PROPOSED RIGHT HAND SIDE ELEVATION

Rev	Date	Description	By	Checked
JAGO ASSOCIATES PLANNING CONSULTANTS, STRUCTURAL ENGINEERS AND BUILDING SURVEYORS 120 Kingspark Business Centre, 152-178 Kingston Road New Malden, Surrey KT3 3ST Tel: 020 8241 1879 Email: mail@jagoassociates.co.uk				
Project 10 ANGLEFIELD ROAD, READING Proposed Loft Conversion				
Drawing Title PROPOSED ELEVATIONS				
Drawing Date Jan. 2024	Scale 1:100	Paper size A3	Status Planning	
Project No. 2259	Drawing No. P04	Revision D	Revision Date	