


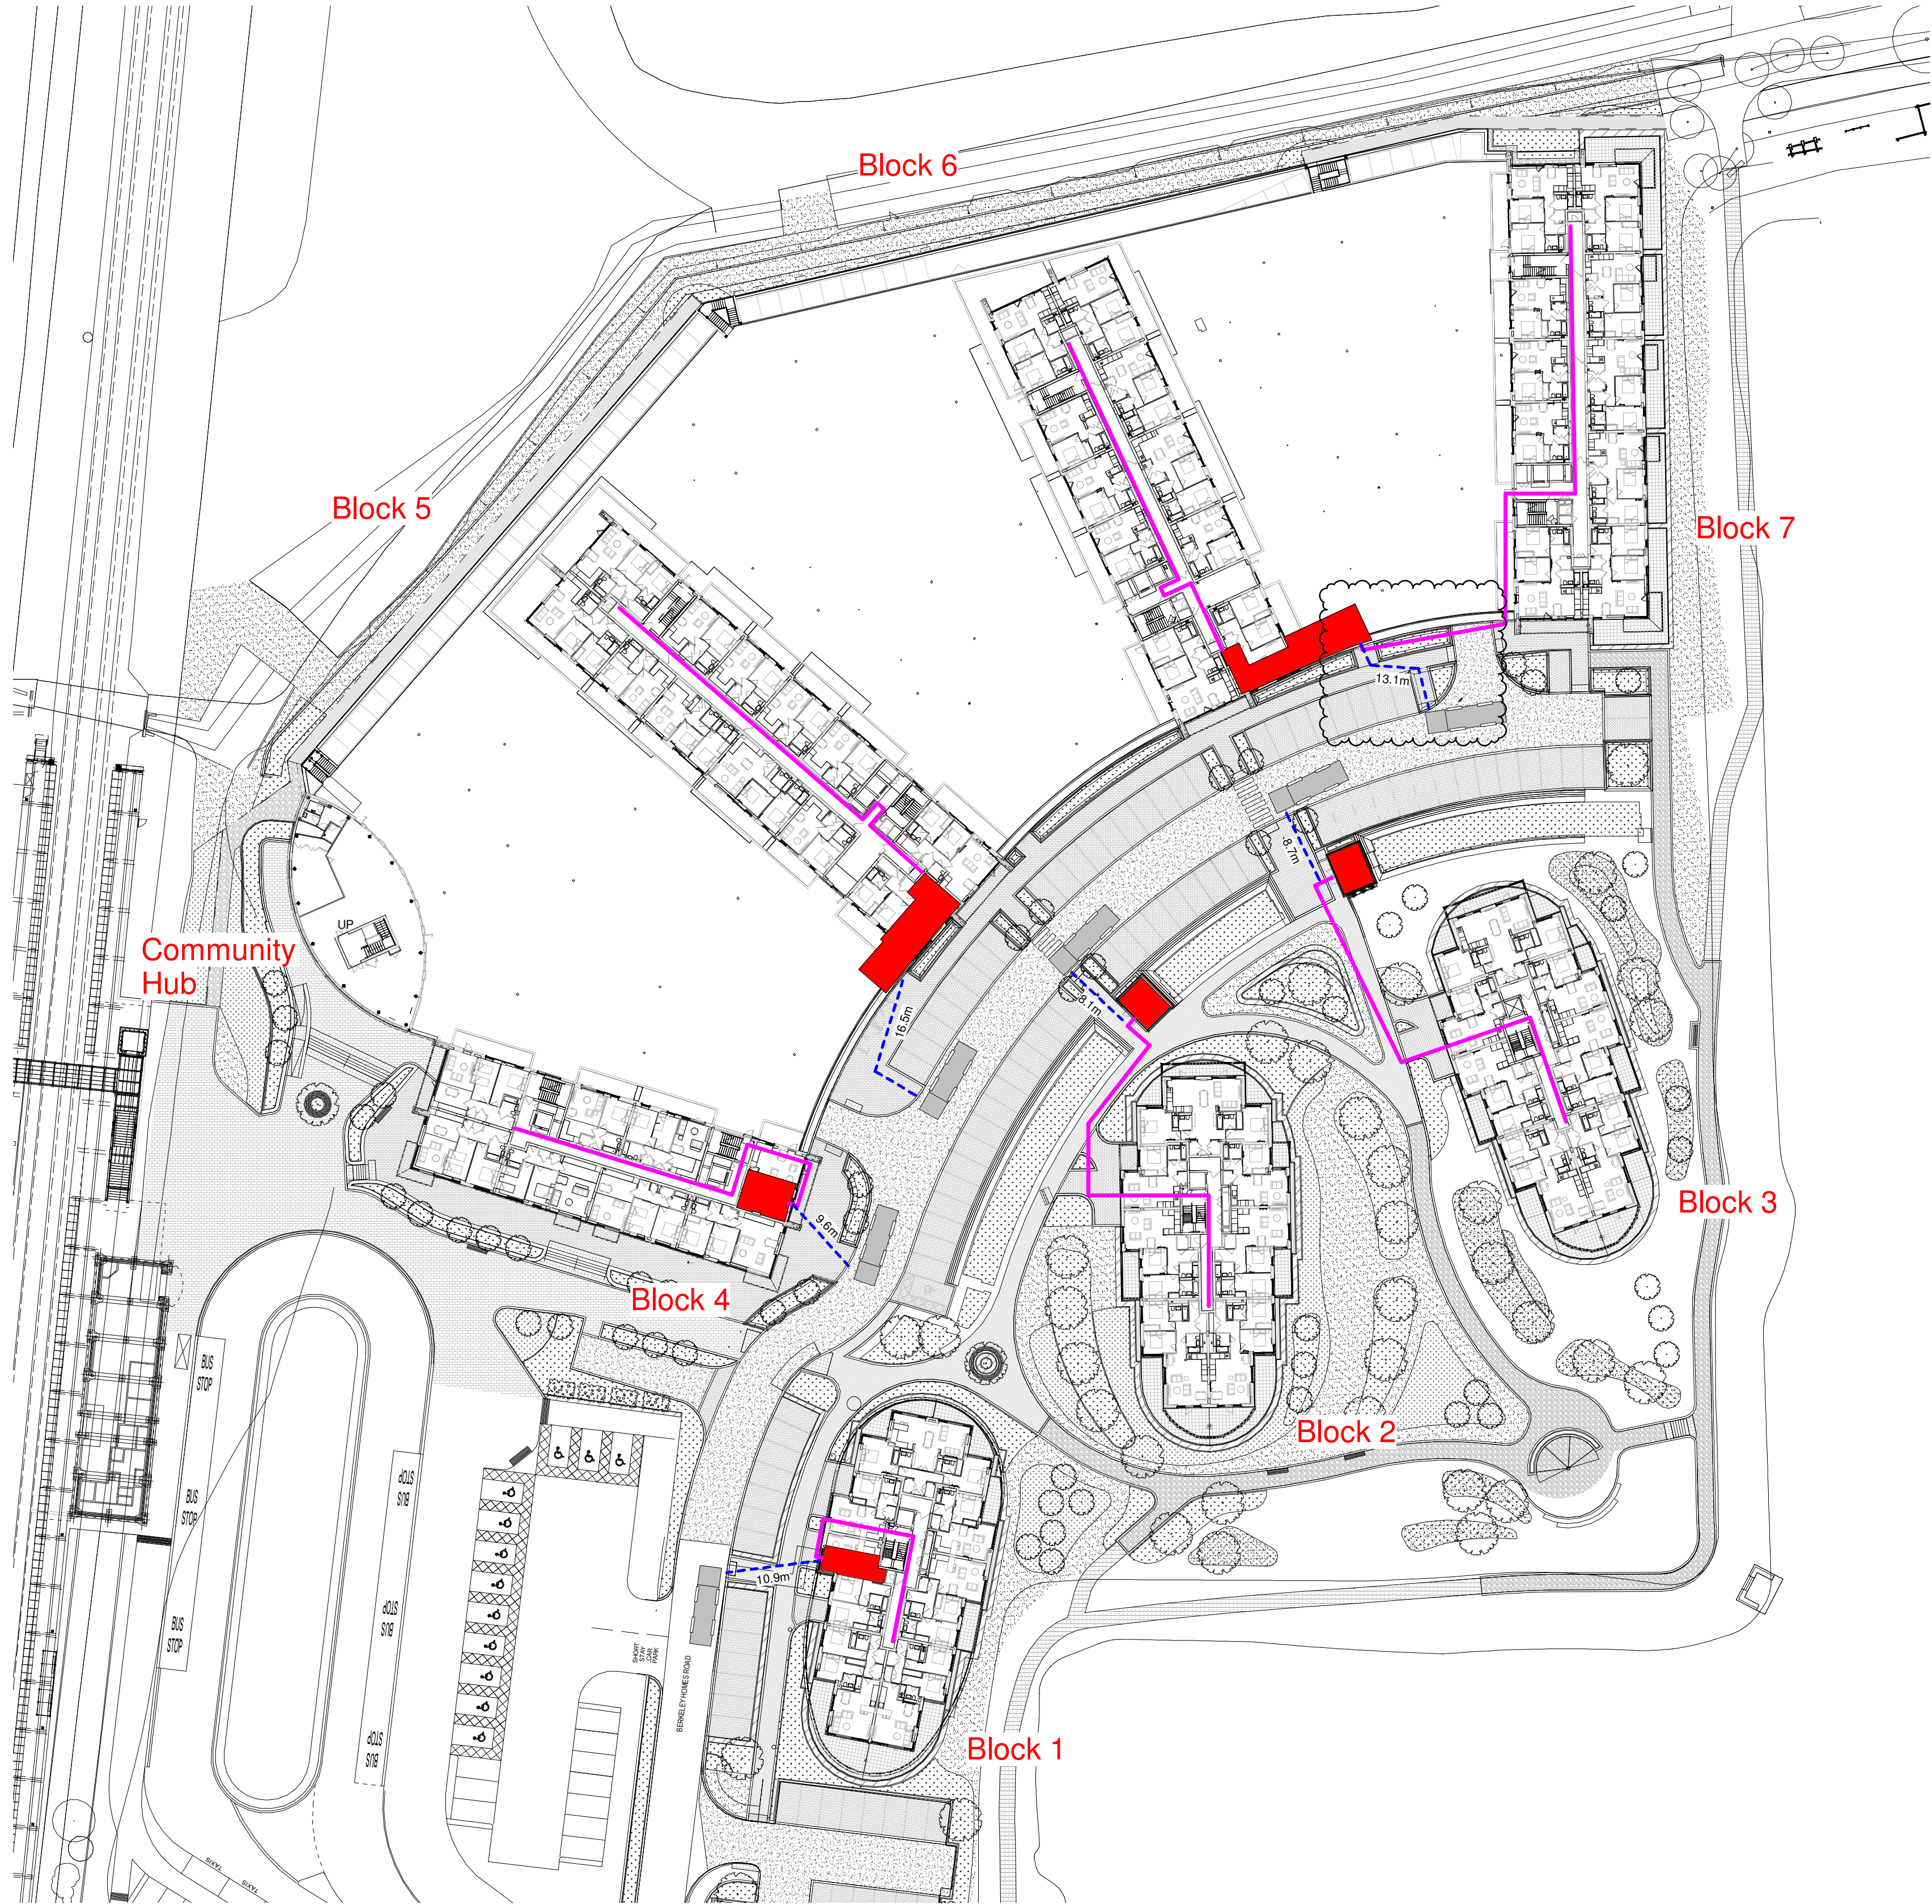

01 - First Floor (Distance from dwellings to refuse stores)

Key

Refuse and recycling store location on the ground floor

Distance from refuse & recycling storage areas to vehicular access road

- Route from refuse storage to vehicular access road for building 1 - 10.9m
- Route from refuse storage to vehicular access road for building 2 - 8.1m
- Route from refuse storage to vehicular access road for building 3 - 8.7m
- Route from refuse storage to vehicular access road for building 4 - 9.6m
- Route from refuse storage to vehicular access road for building 5 - 16.5m
- Route from refuse storage to vehicular access road for buildings 6 & 7 - 13.1m

Distance from refuse & recycling storage areas to furthest dwelling

- Block 1 furthest distance from dwelling to refuse collection store 26.5m
- Block 2 furthest distance from dwelling to refuse collection store 40m
- Block 3 furthest distance from dwelling to refuse collection store 47m
- Block 4 furthest distance from dwelling to refuse collection store 44m
- Block 5 furthest distance from dwelling to refuse collection store 50m
- Block 6 furthest distance from dwelling to refuse collection store 44m
- Block 7 furthest distance from dwelling to refuse collection store 70m

Do not scale from this drawing

This drawing is copyright and owned by Brookes Architects Limited and is for use on this site only unless contractually stated otherwise.

Contractors must check all dimensions from site.

All other design team elements, where indicated, have been imported from the consultant's drawings and reference should be made to the individual consultant's drawings for exact setting out, size and type of component.

Discrepancies and / or ambiguities within this drawing, between it and information given elsewhere, must be reported immediately to the architect for clarification before proceeding.

All works are to be carried out in accordance with the latest British Standards and Codes of practice unless specifically directed otherwise in the specification.

Responsibility for the reproduction of this drawing in paper form, or if issued in electronic format, lies with the recipient to check that all information has been replicated in full and is correct when compared to the original paper or electronic image. Graphical representations of equipment on this drawing have been co-ordinated, but are approximations only. Please refer to Specifications and / or Details for actual sizes and / or specific contractor construction information.

This original document is issued for the purpose indicated below and contains information of a confidential nature. Further copies and circulation will be strictly in accordance with the confidentiality agreement under the contract. This original must be destroyed or returned to the originator.

SAFETY, HEALTH AND ENVIRONMENTAL INFORMATION

Refer to the relevant Construction (Design and Management) documentation where applicable.

It is assumed that all works on this drawing will be carried out by a competent contractor working, where necessary, to an approved method statement.

AS BUILT RECORD

B	Path added for Block 6-7 refuse collection	06.05.25	AM	AM
A	Site Plan & Updated Bin Location	30.06.22	AM	JN
P2	Refuse storage updated to show collection points	18.10.19	PGT	AM
P1	First Issue	10.09.19	PGT	AM
Rev	Description	Issued	Dwn	Chk

Client
Berkeley Homes (Western) Ltd

Project
Green Park Village, Reading
Phase 6

Drawing
Refuse Store Locations
& Travel Distance

Scale	Date	Drawn	Checked
1 : 500@A1	09/09/19	PGT	AM

Brookes Architects
Unit 1 - 68 Glenham Road
London SW13 9LJ
T 020 8487 1223
www.brookesarchitects.co.uk

Rev. No.
G259-BAL-XX-01-DR-A-90-0006 B