



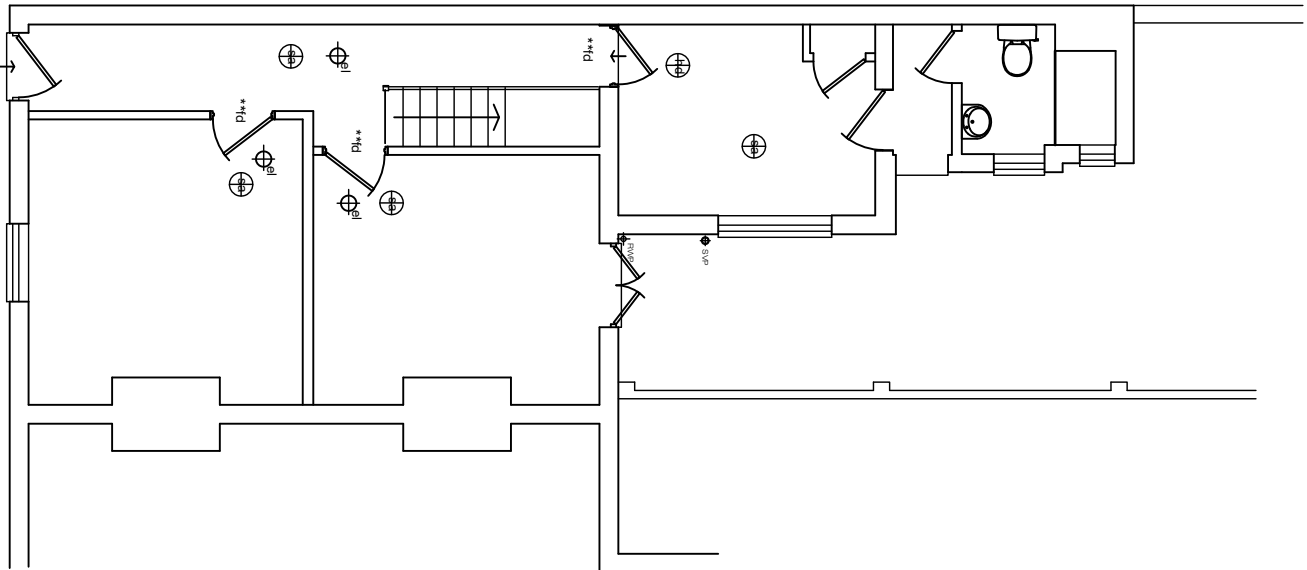


Ground Floor Plan

PRE- EXISTING

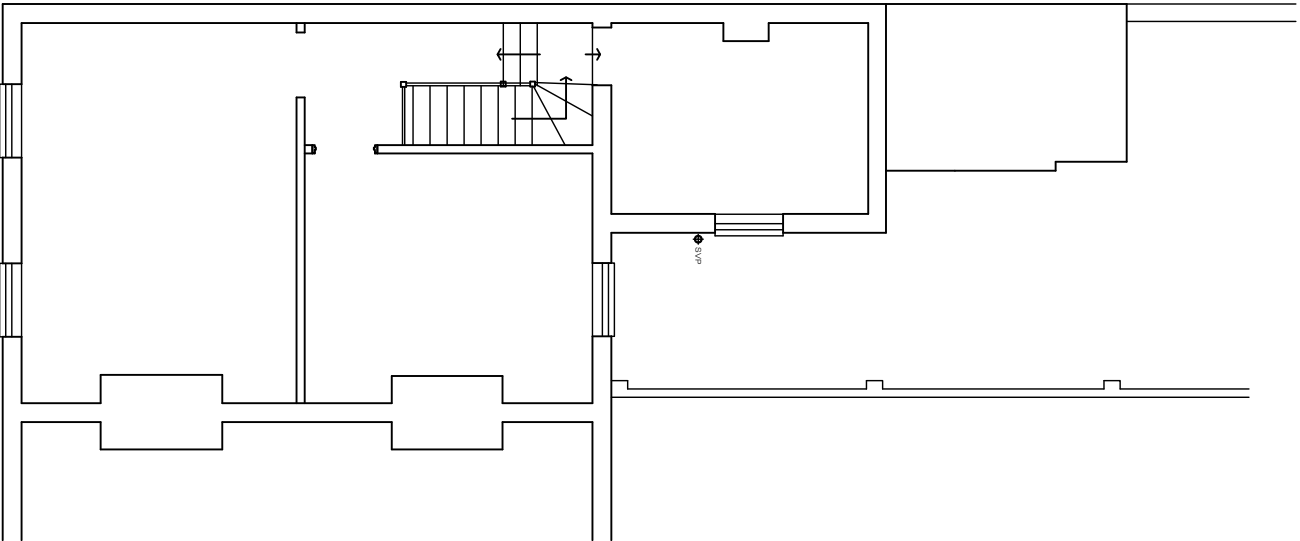


First Floor Plan

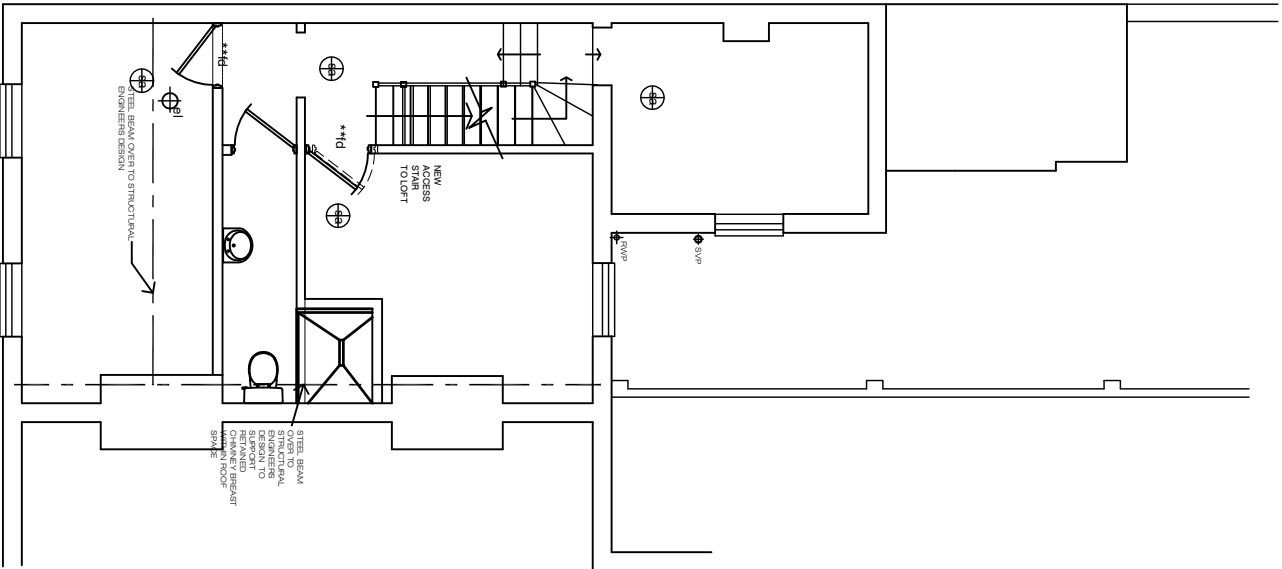


First Floor Plan

AS BUILT


PROPOSALS FOR LOFT WORKS AS
APPROVED VIA APPLICATION
REFERENCE PL/25/0588

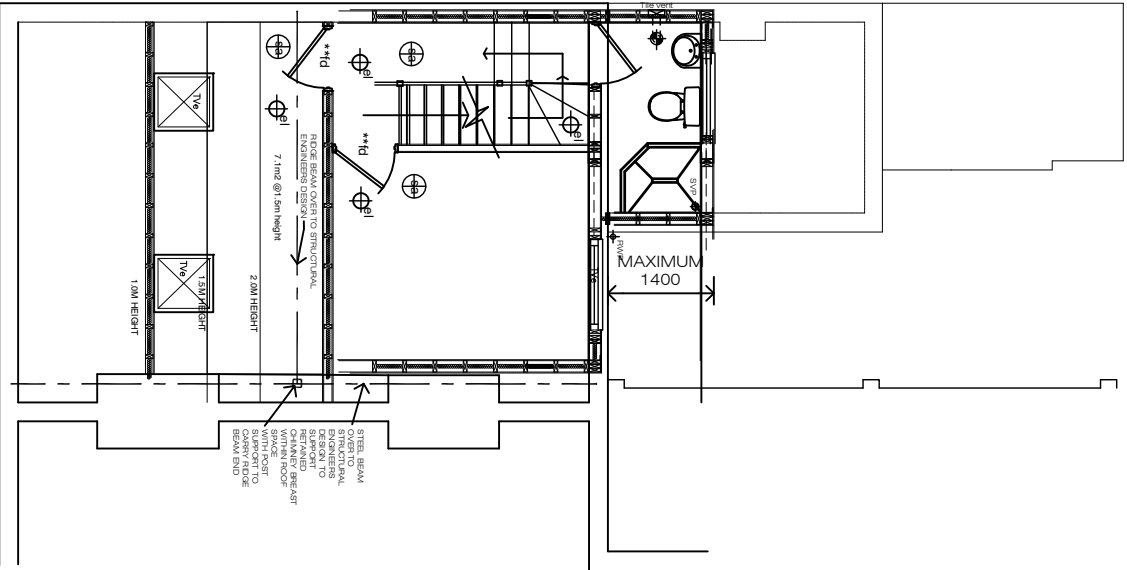

Loft Floor Plan

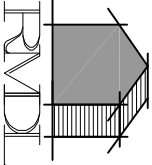

RAMMURTI DESIGN LTD
ARCHITECTURAL & PLANNING SERVICES
268 TILGHURST ROAD, READING RG30 2NE
TEL/FAX:01189510628 MOB:07799883574

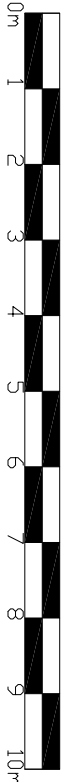

Proposed rear extensions ground and first floors following
implementation of loft conversion and addition of rear
dormer to existing dwelling
at No 13 Sidmouth Street, Reading
for Mr Khatter

Pre-Existing AND As Built floor plans

Scale: 1/100
Date: March 2025

SSR13:102 Rev -