


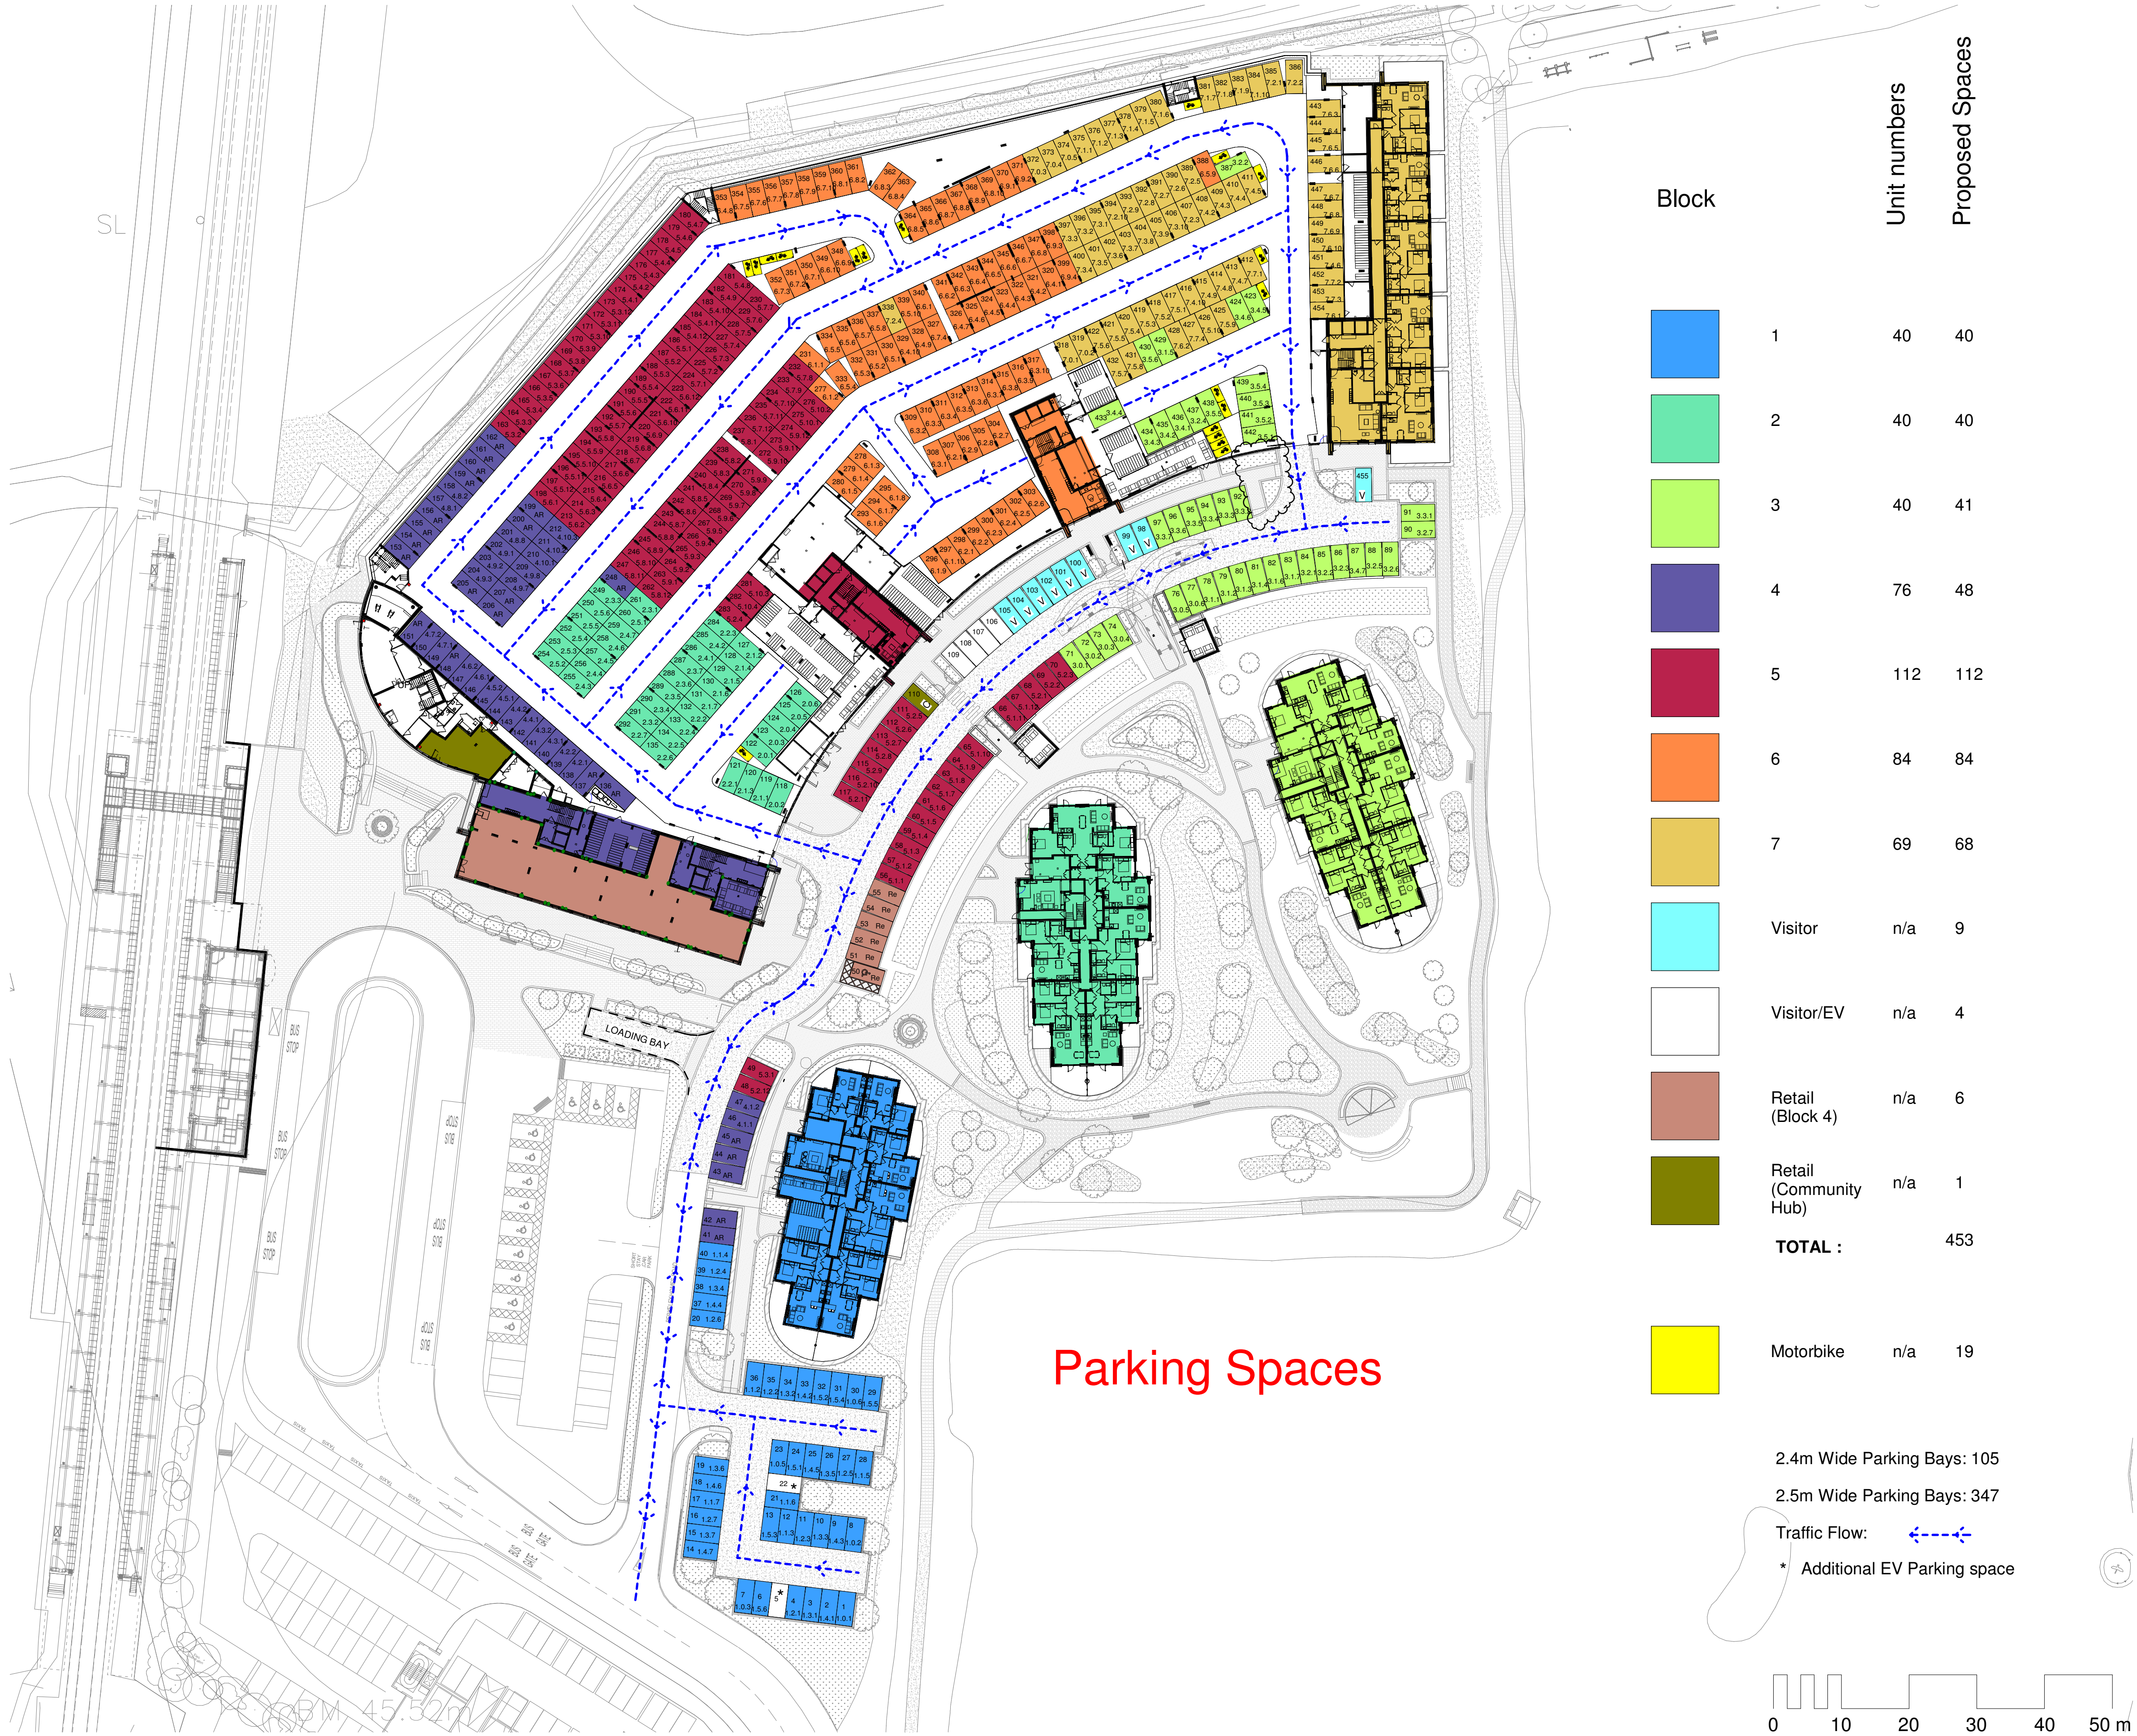

Do not scale from this drawing

This drawing is copyright and owned by Brookes Architects Limited and is for use on this site only unless contractually stated otherwise.

Contractors must check all dimensions from site.

All other design team elements, where indicated, have been imported from the consultant's drawings and reference should be made to the individual consultant's drawings for exact setting out, size and type of component.

Discrepancies and / or ambiguities within this drawing, between it and information given elsewhere, must be reported immediately to the architect for clarification before proceeding.

All works are to be carried out in accordance with the latest British Standards and Codes of practice unless specifically directed otherwise in the specification.

Responsibility for the reproduction of this drawing in paper form, or if issued in electronic format, lies with the recipient to check that all information has been replicated in full and is correct when compared to the original paper or electronic image. Graphical representations of equipment on this drawing have been co-ordinated, but are approximations only. Please refer to Specifications and / or Details for actual sizes and / or specific contractor construction information.

This original document is issued for the purpose indicated below and contains information of a confidential nature. Further copies and circulation will be strictly in accordance with the confidentiality agreement under the contract. This original must be destroyed or returned to the originator.

SAFETY, HEALTH AND ENVIRONMENTAL INFORMATION

Refer to the relevant Construction (Design and Management) documentation where applicable.

It is assumed that all works on this drawing will be carried out by a competent contractor working, where necessary, to an approved method statement.

AS BUILT RECORD

X	Path added for Block 6-7 refuse collection	06.05.25	AM	AM
W	Parking spaces swapped between 7.4.1 and 7.2.3 & 7.7.4 and 7.6.1	19.12.24	AM	AM
V	Parking spaces swapped Plot 3.5.6 with 3.4.7 and 7.7.1 with 7.4.6	10.09.24	AM	AM
U	Parking space swapped between Plot 6.5.9 and 7.2.4	27.08.24	AM	AM
T	Parking swapped 6.4.8 and 6.7.4	19.04.24	AM	AM
S	Bay 397 assigned to Plot 3.2.2	15.03.24	AM	AM
R	Parking space added	08.12.23	AM	AM
Q	Landscape to parking plan updated	21.09.23	AM	AM
P	Parking allocation updated	09.05.23	AM	AM
O	Updated as per L&Q Parking Allocation Change	30.03.23	BP	AM
Rev	Description	Issued	Dwn	Chk

Client
Berkeley Homes (Western) Ltd
Project
Green Park Village, Reading
Phase 6

Drawing
GA Plans - Site
Ground Floor
Parking Allocation

Scale	Date	Drawn	Checked
1 : 500@A1	Aug '19	AM	PGT

BrookesArchitects
Unit 1 - 66 Glenham Road
London SW13 9LJ
T 020 8487 1223
www.brookesarchitects.co.uk