




Roof plan

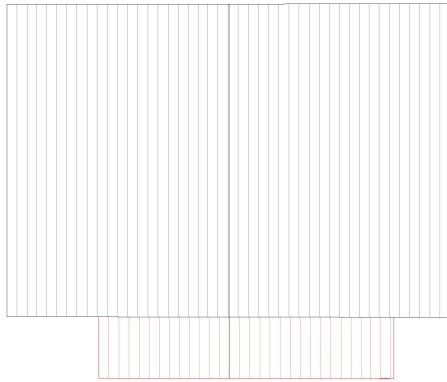


First floor plan

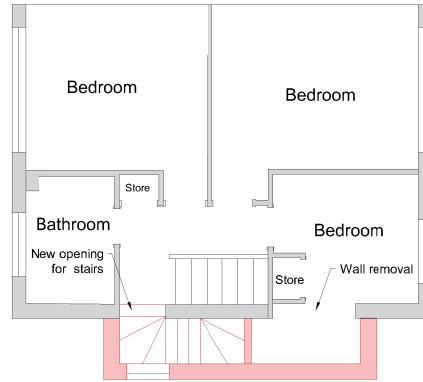


Location plan

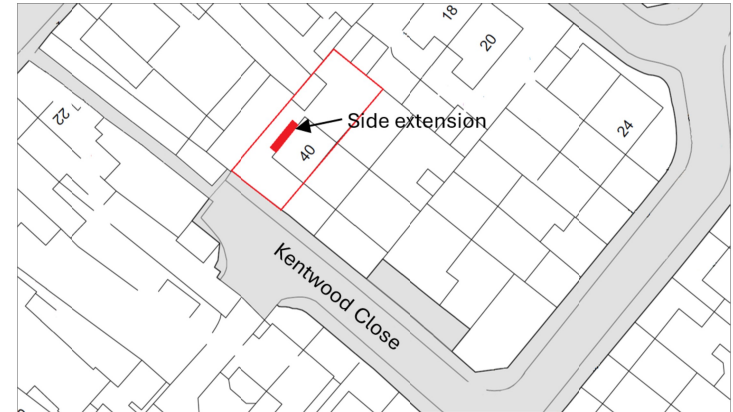

Loft plan

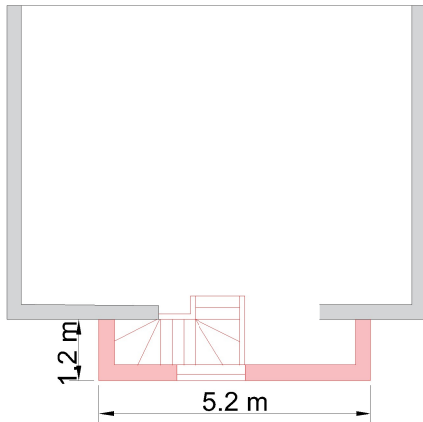


Ground floor plan

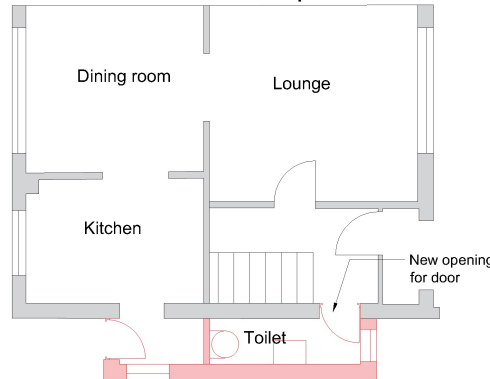


Notes:


- Red lines indicate proposed work
- Black lines indicate existing property
- All work and material to match that of existing property

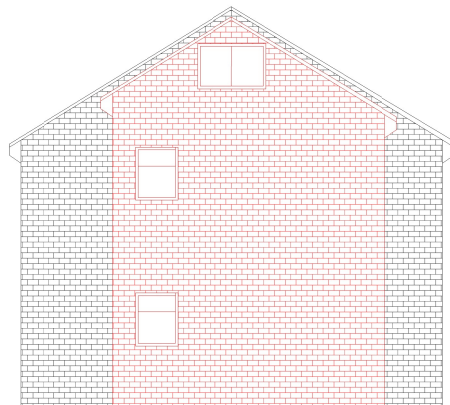

Side elevation

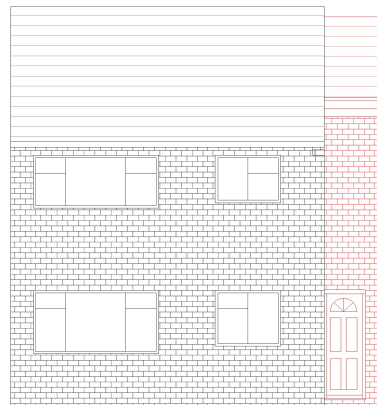

Rear elevation

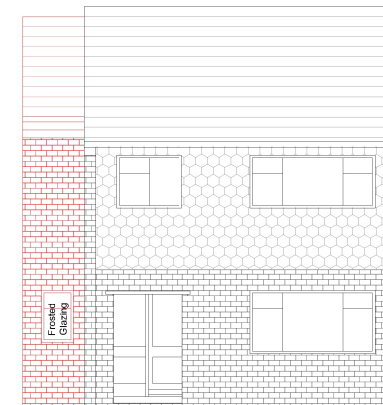

Front elevation

