
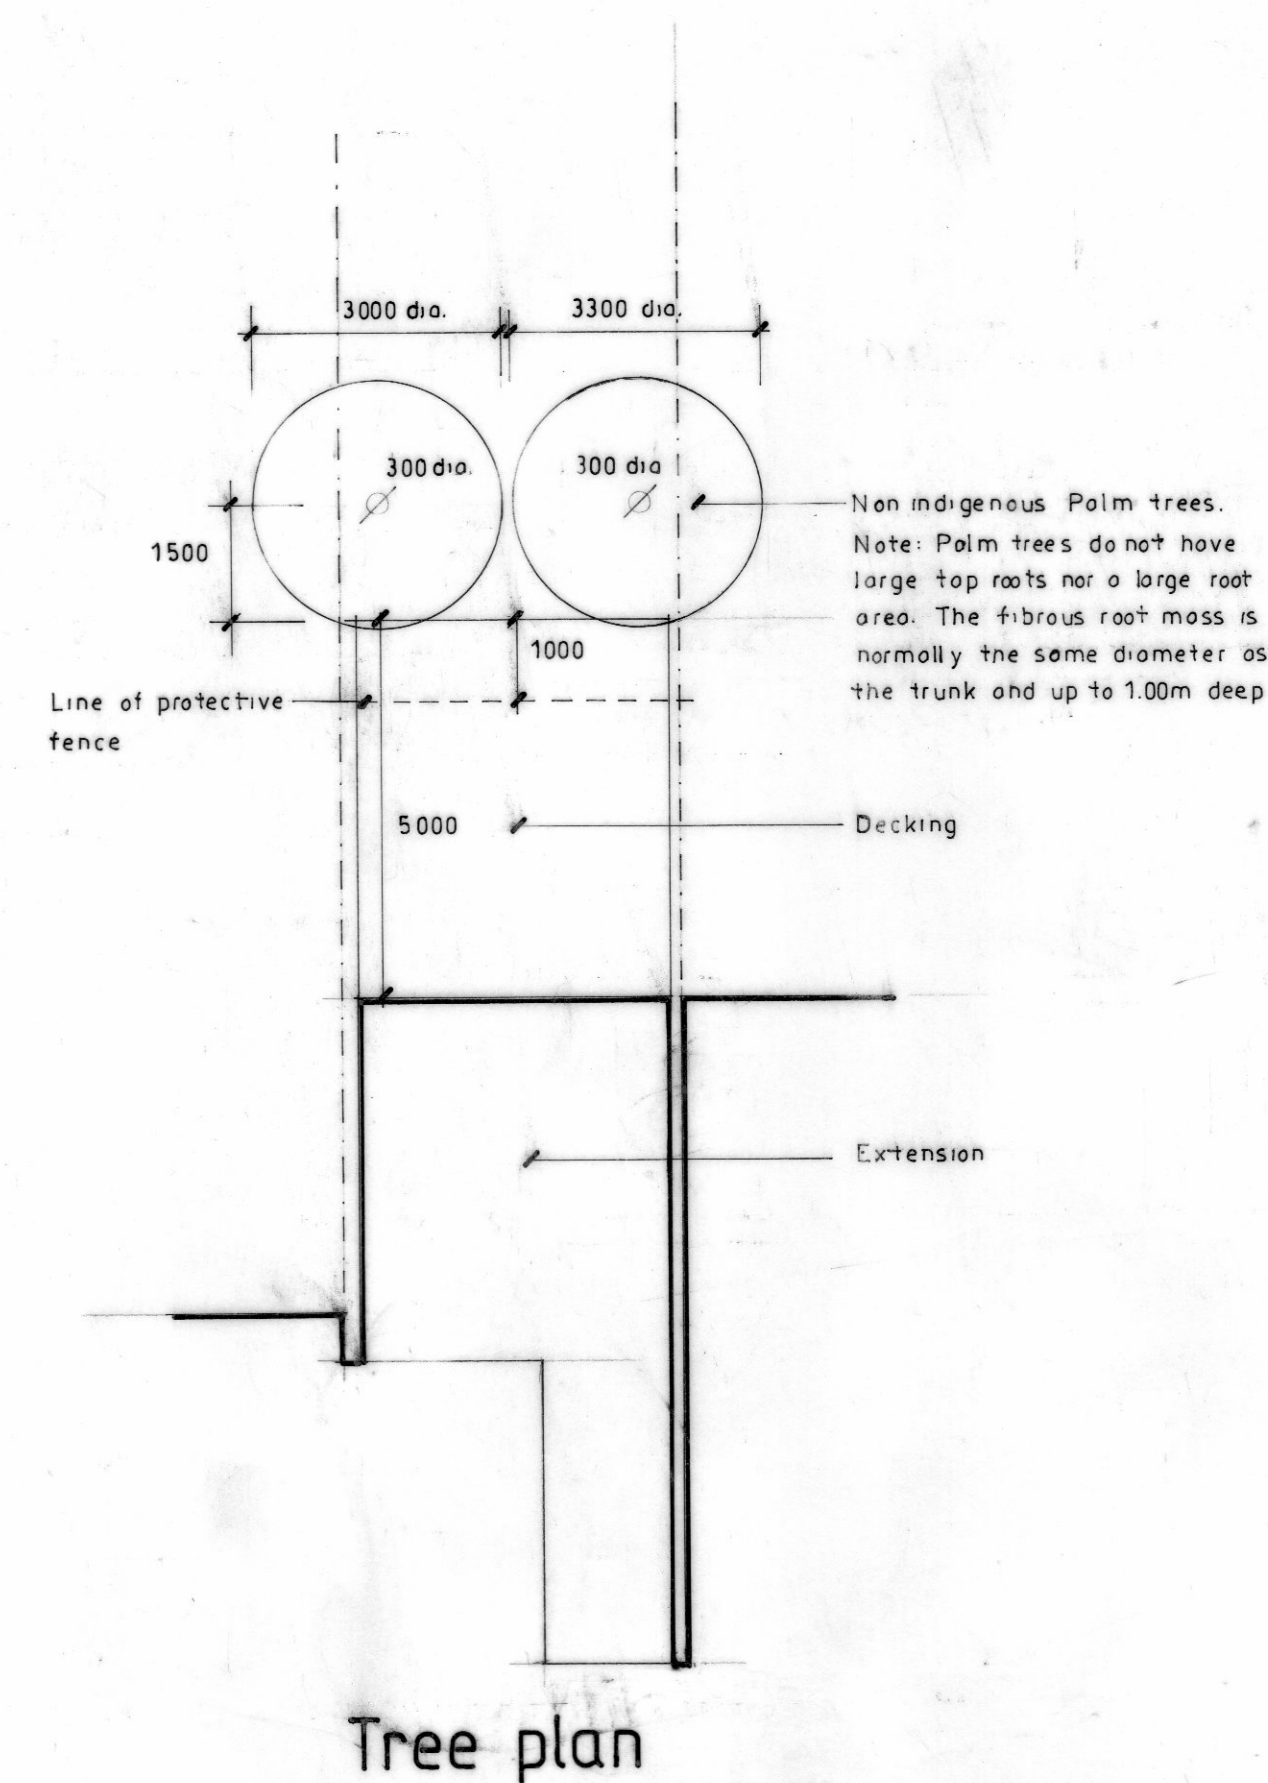
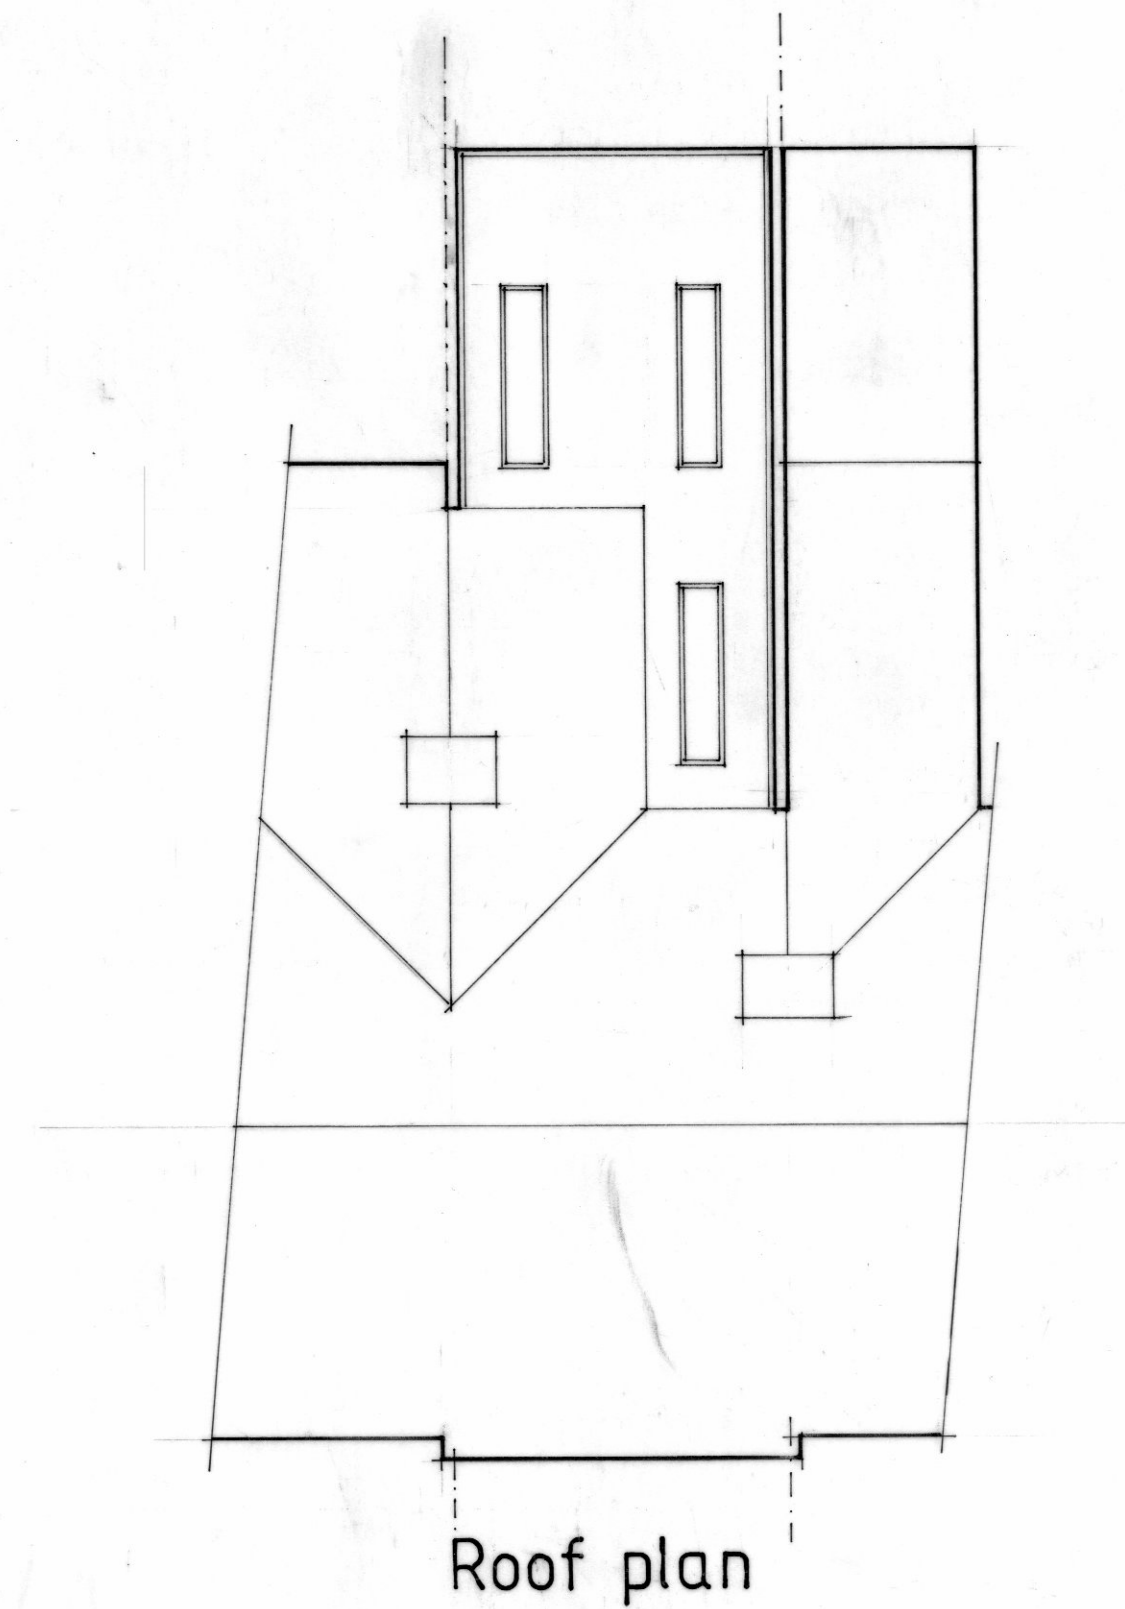
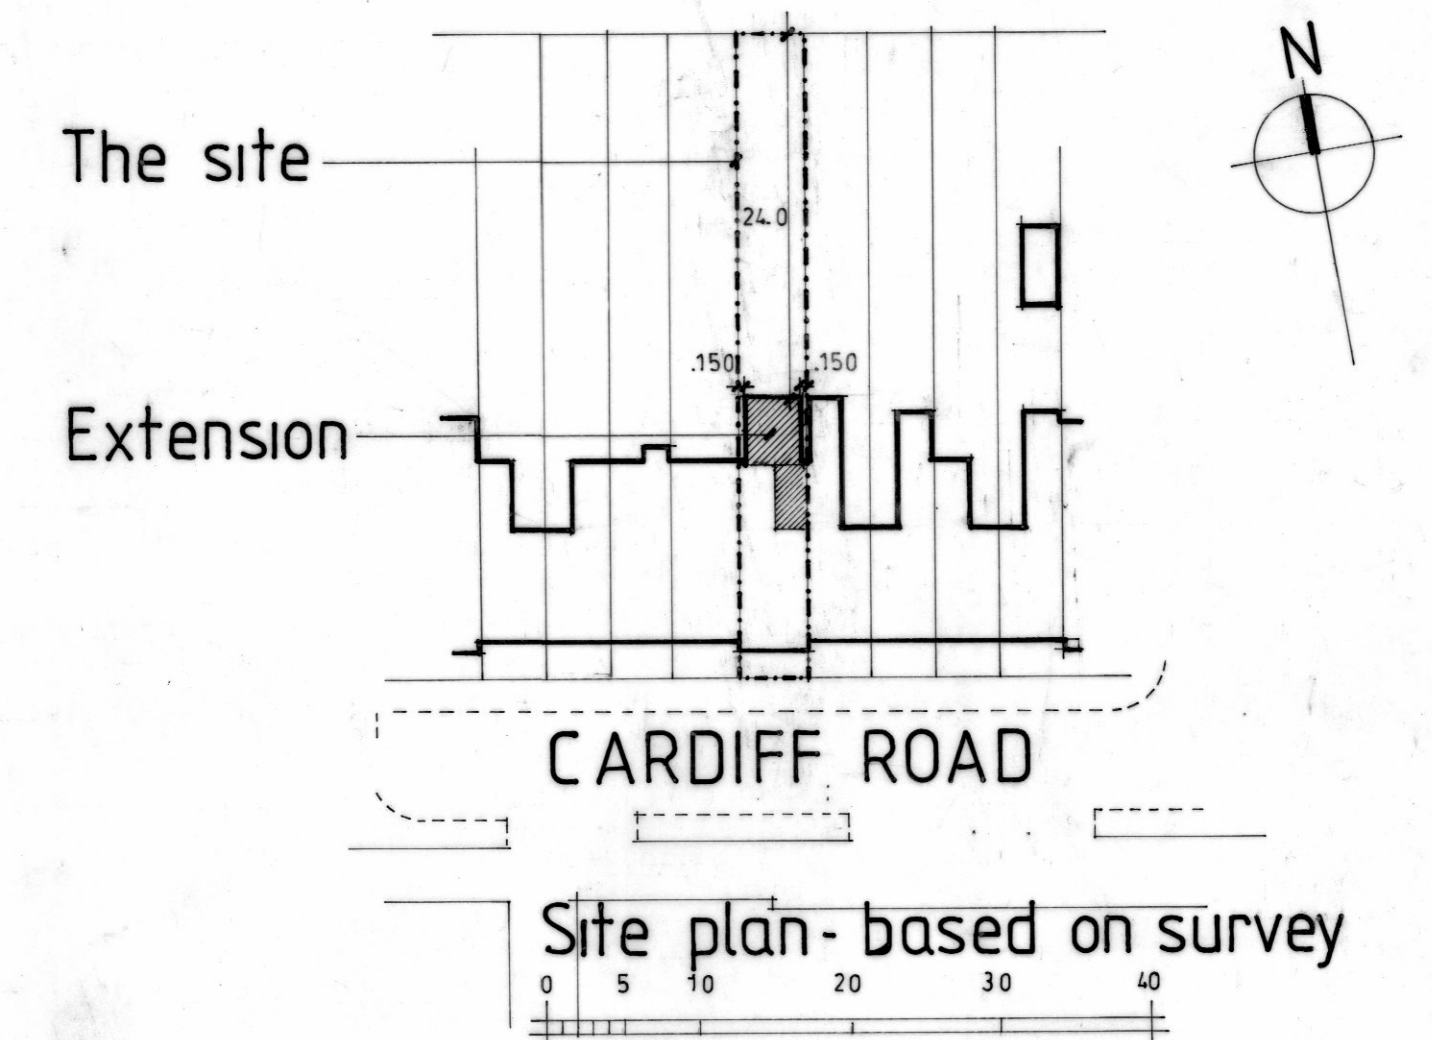
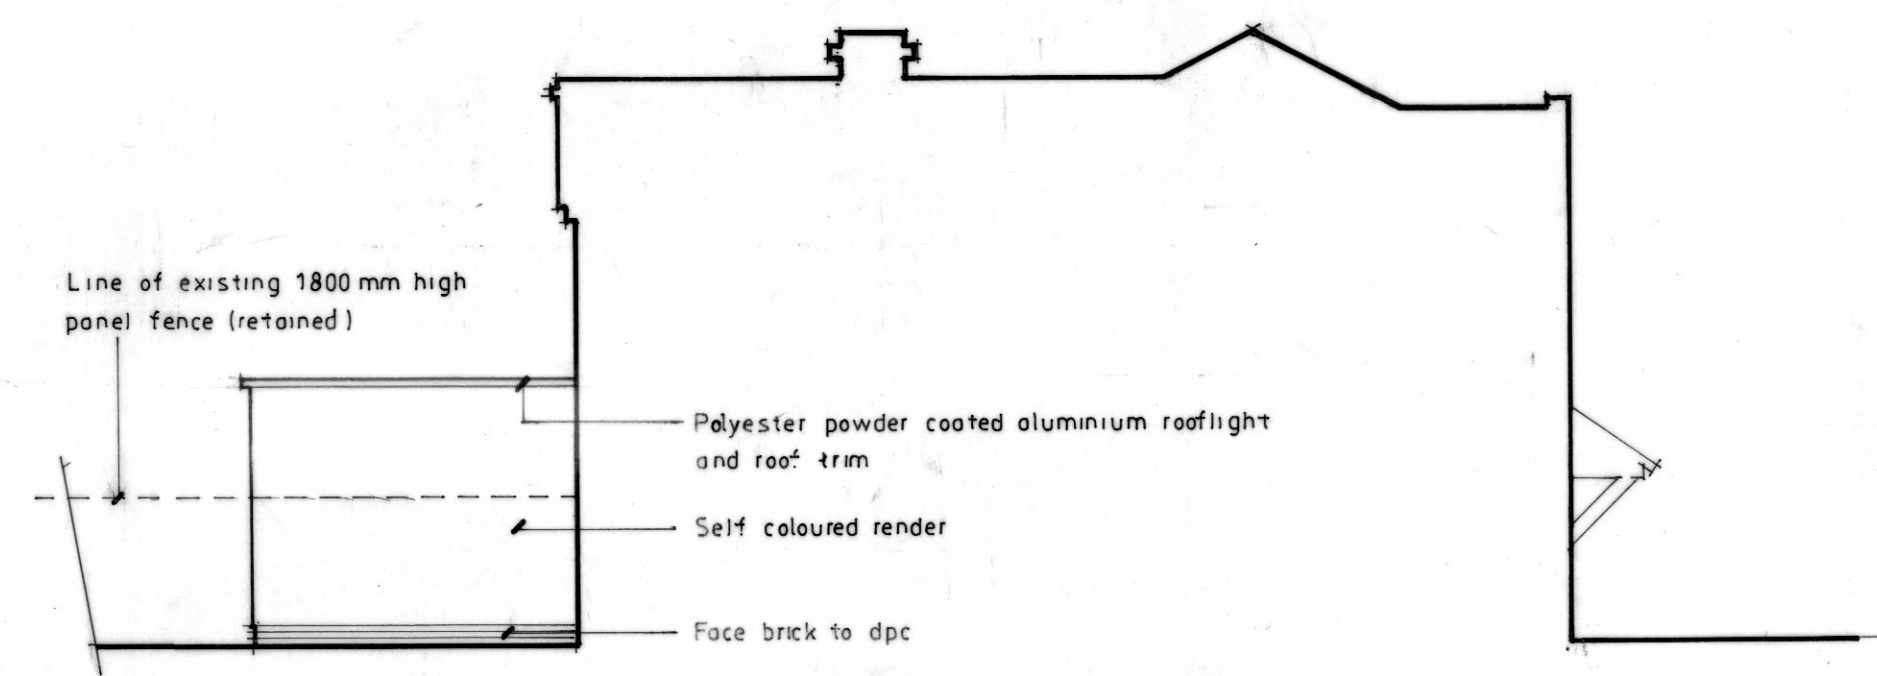
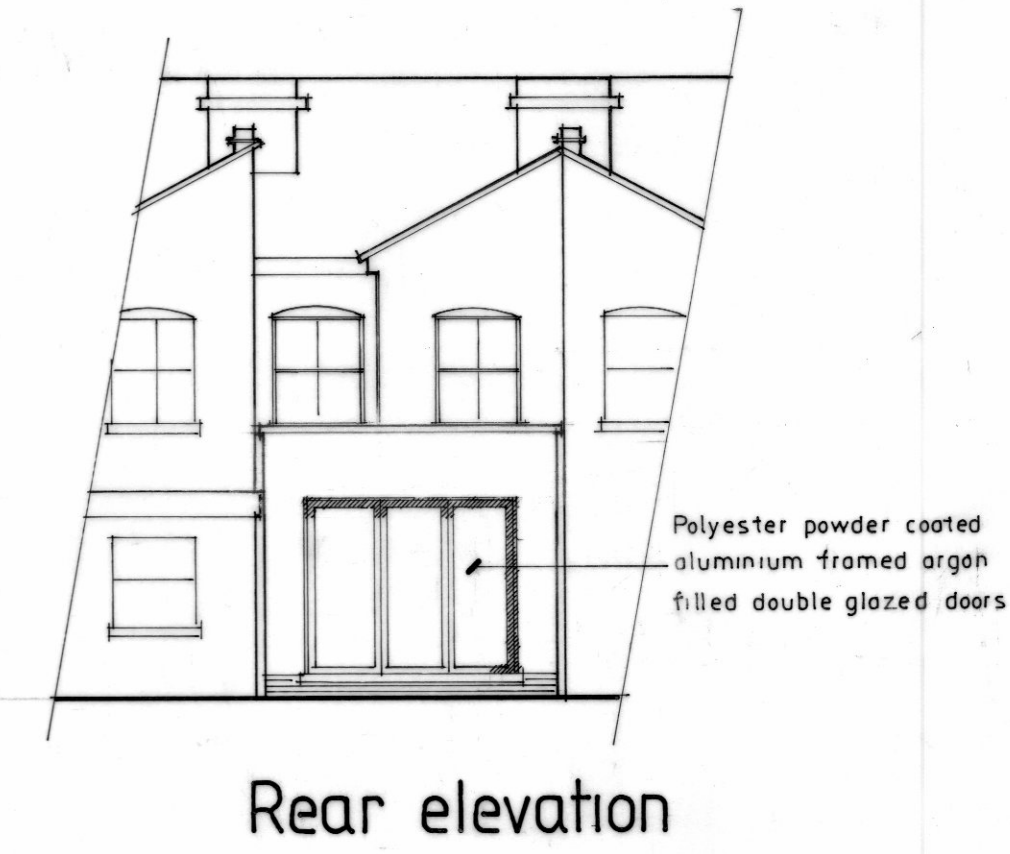
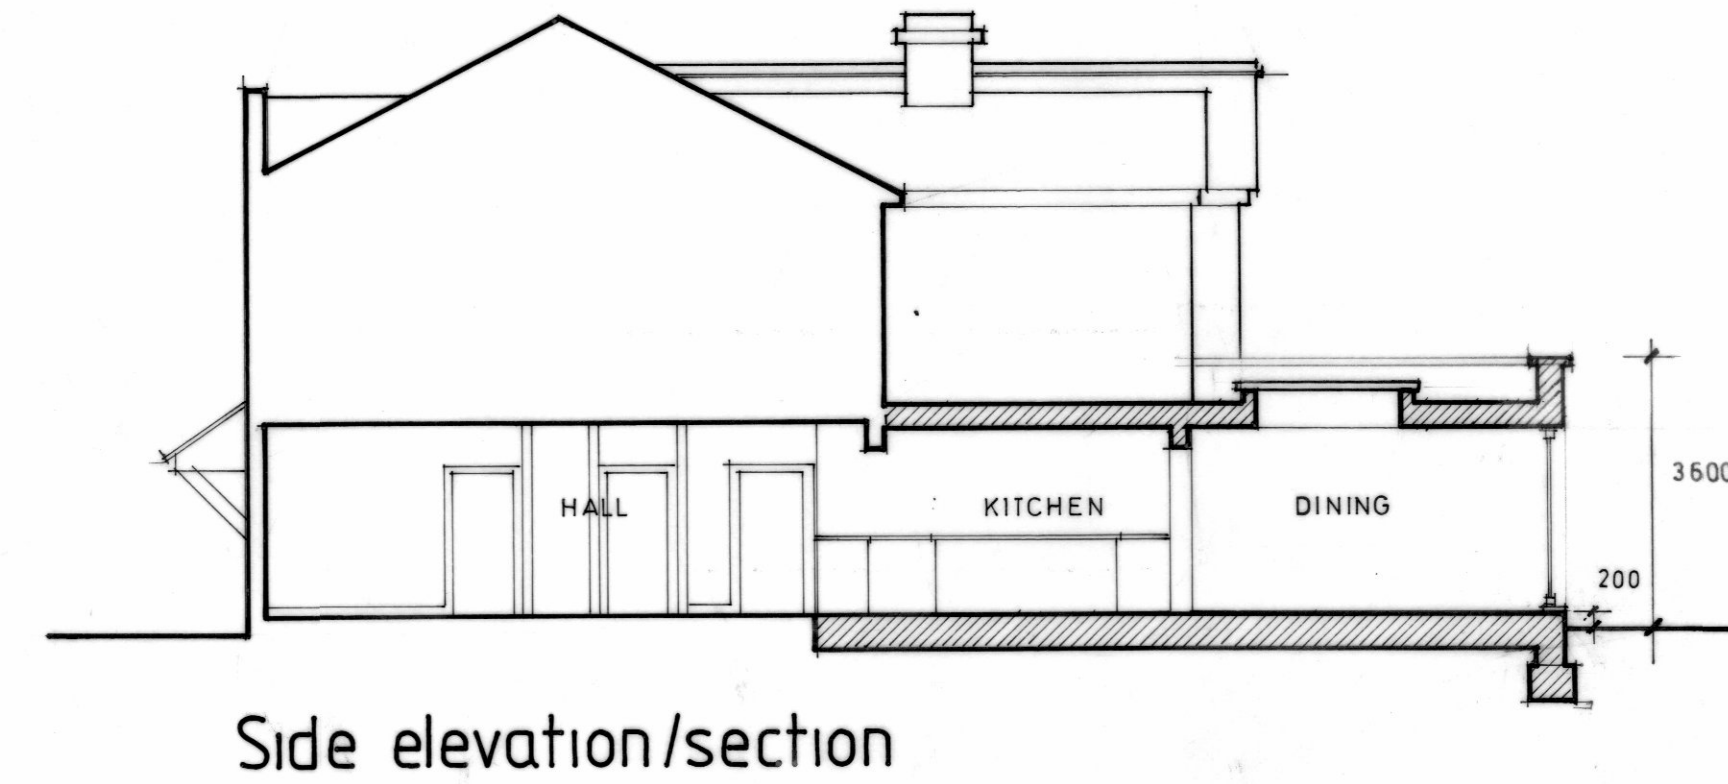


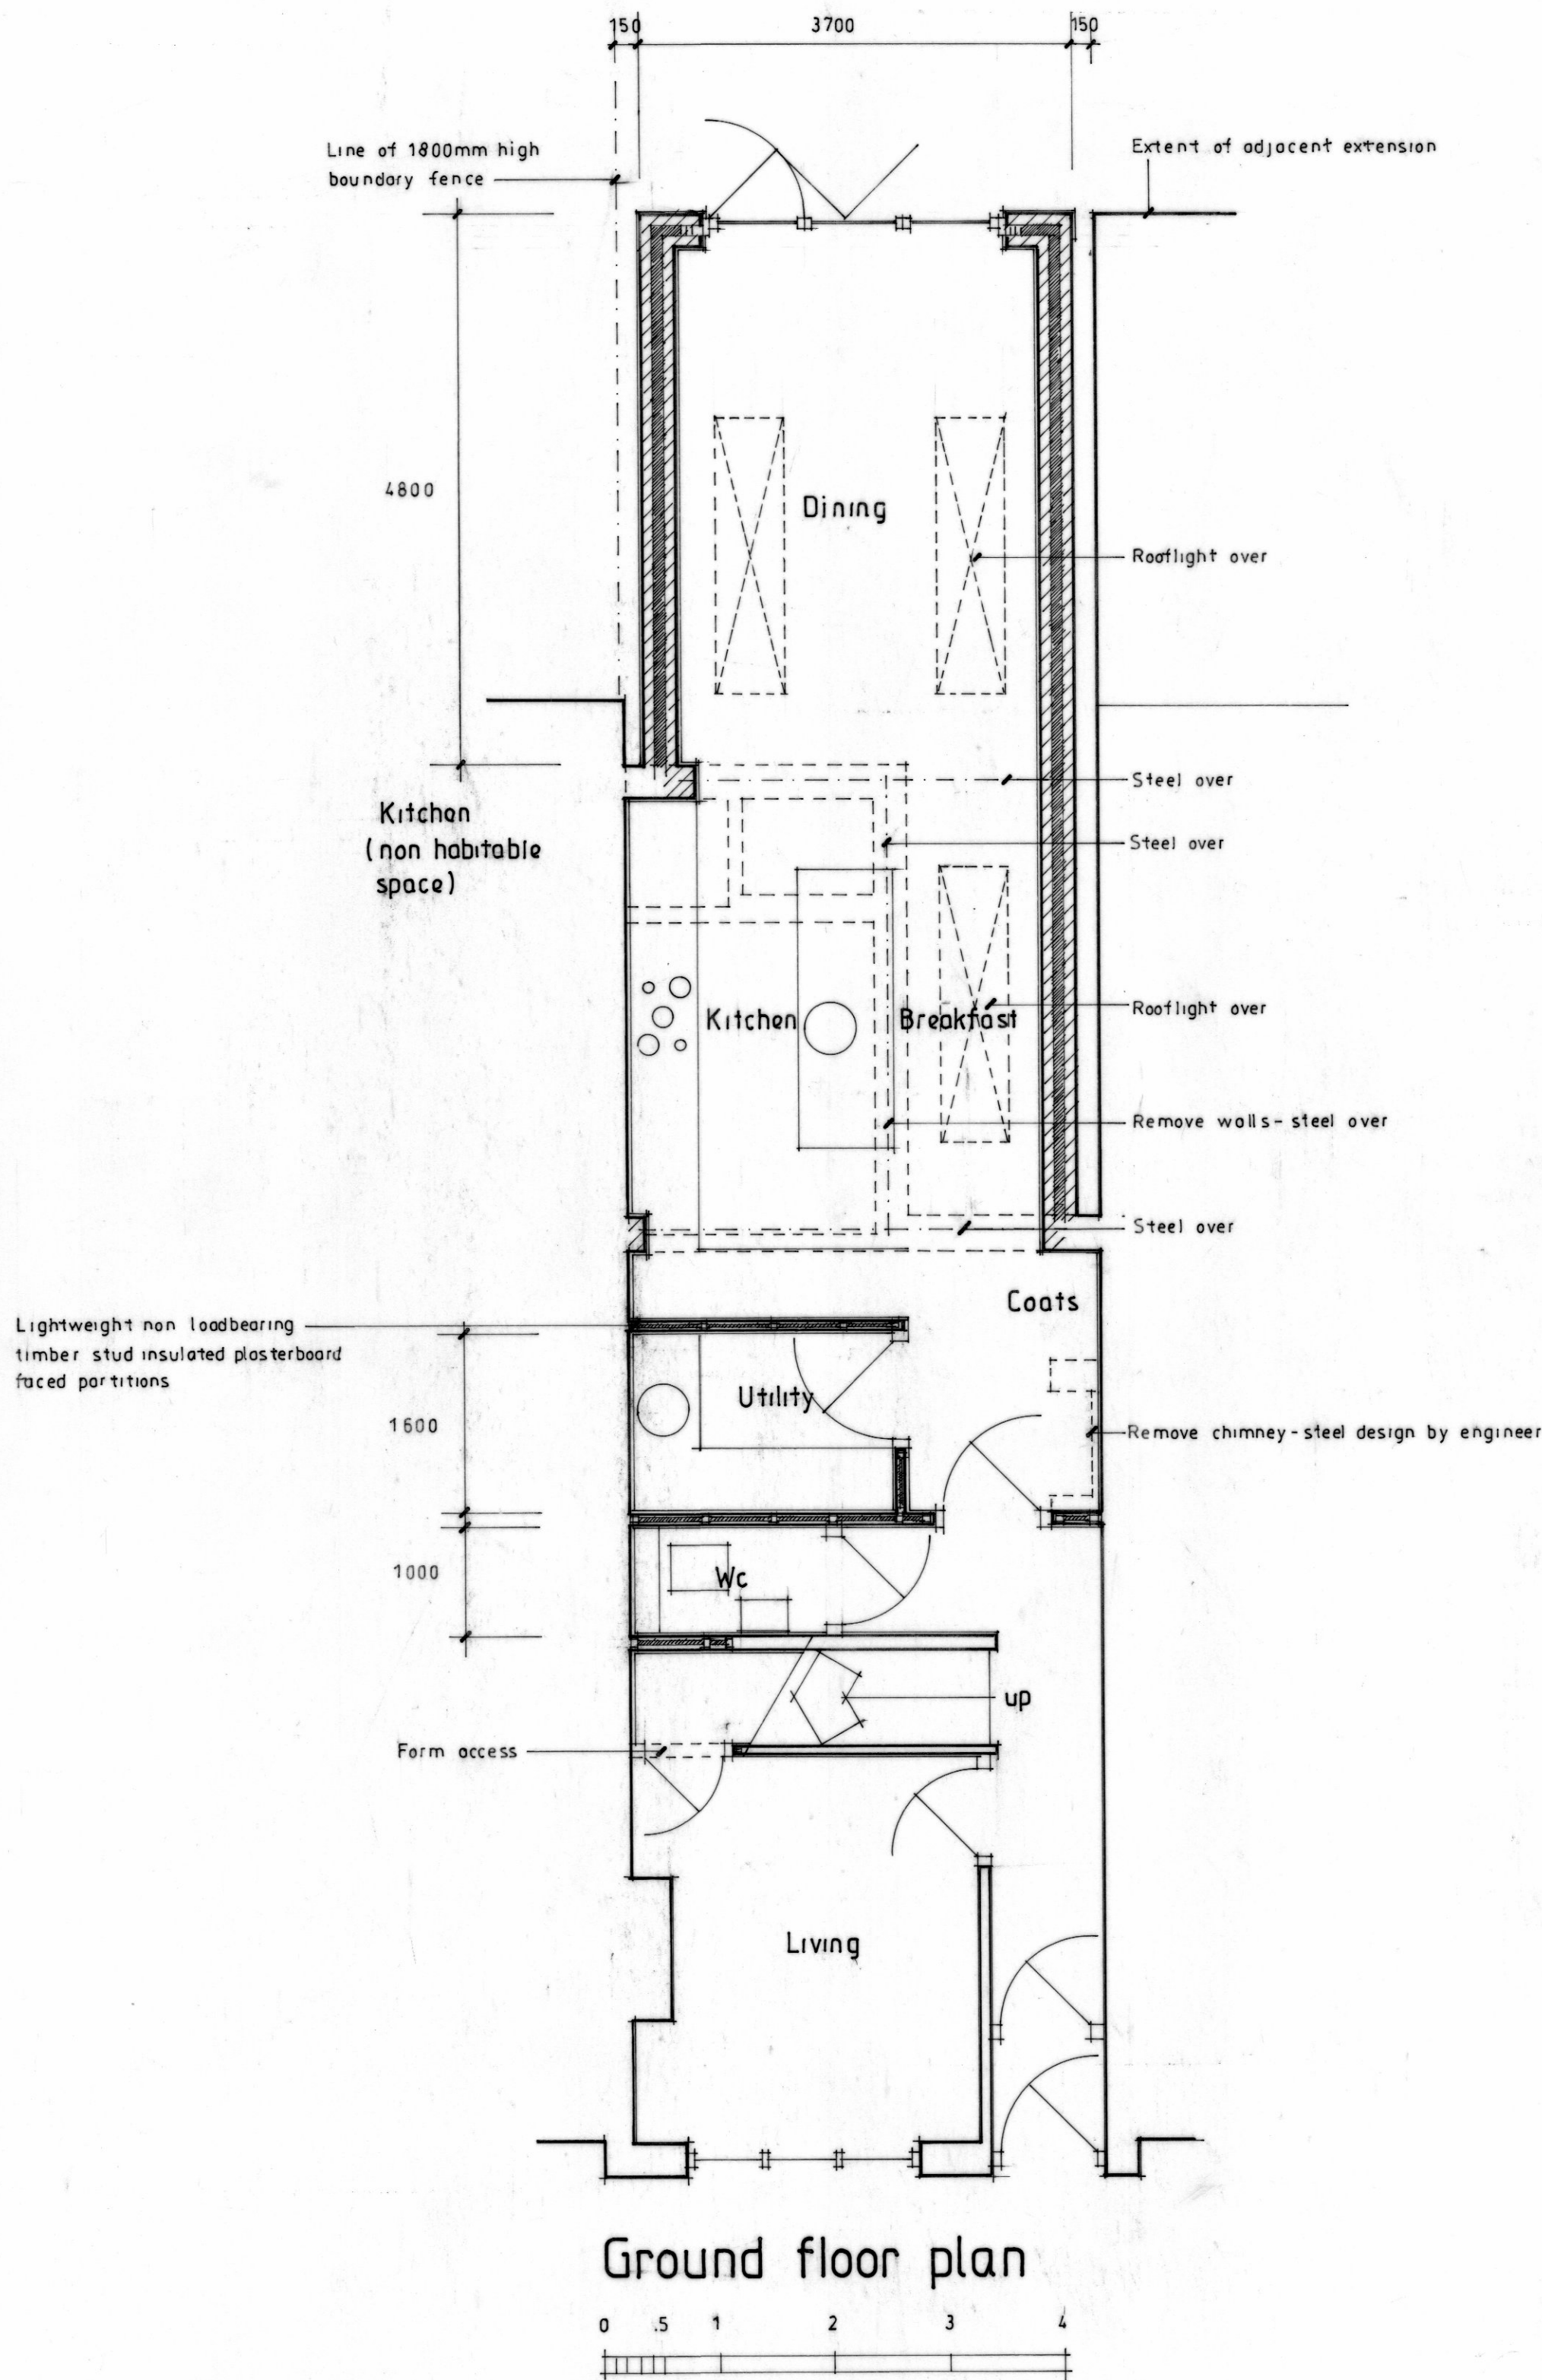

B January Parapet height increased to as built  
A June 21 Tree plan indicated. Slab height indicated on section.  
project Single storey rear extension  
location 50 Cardiff Road, Reading  
drawing Proposed  
drawing no. 1150 / 05 & B  
scale 1 : 50 1 : 100 1 : 500  
date May 2024

T.Neal Ltd  
Architectural Design

Mobile 07970 776 404  
Email tnealtd@gmail.com  
6 Rockwood, Alton, Hampshire GU34 2LP