




Remove tiles from existing roof to accommodate new warm deck flat roof
Make good and lead flashing to seal.

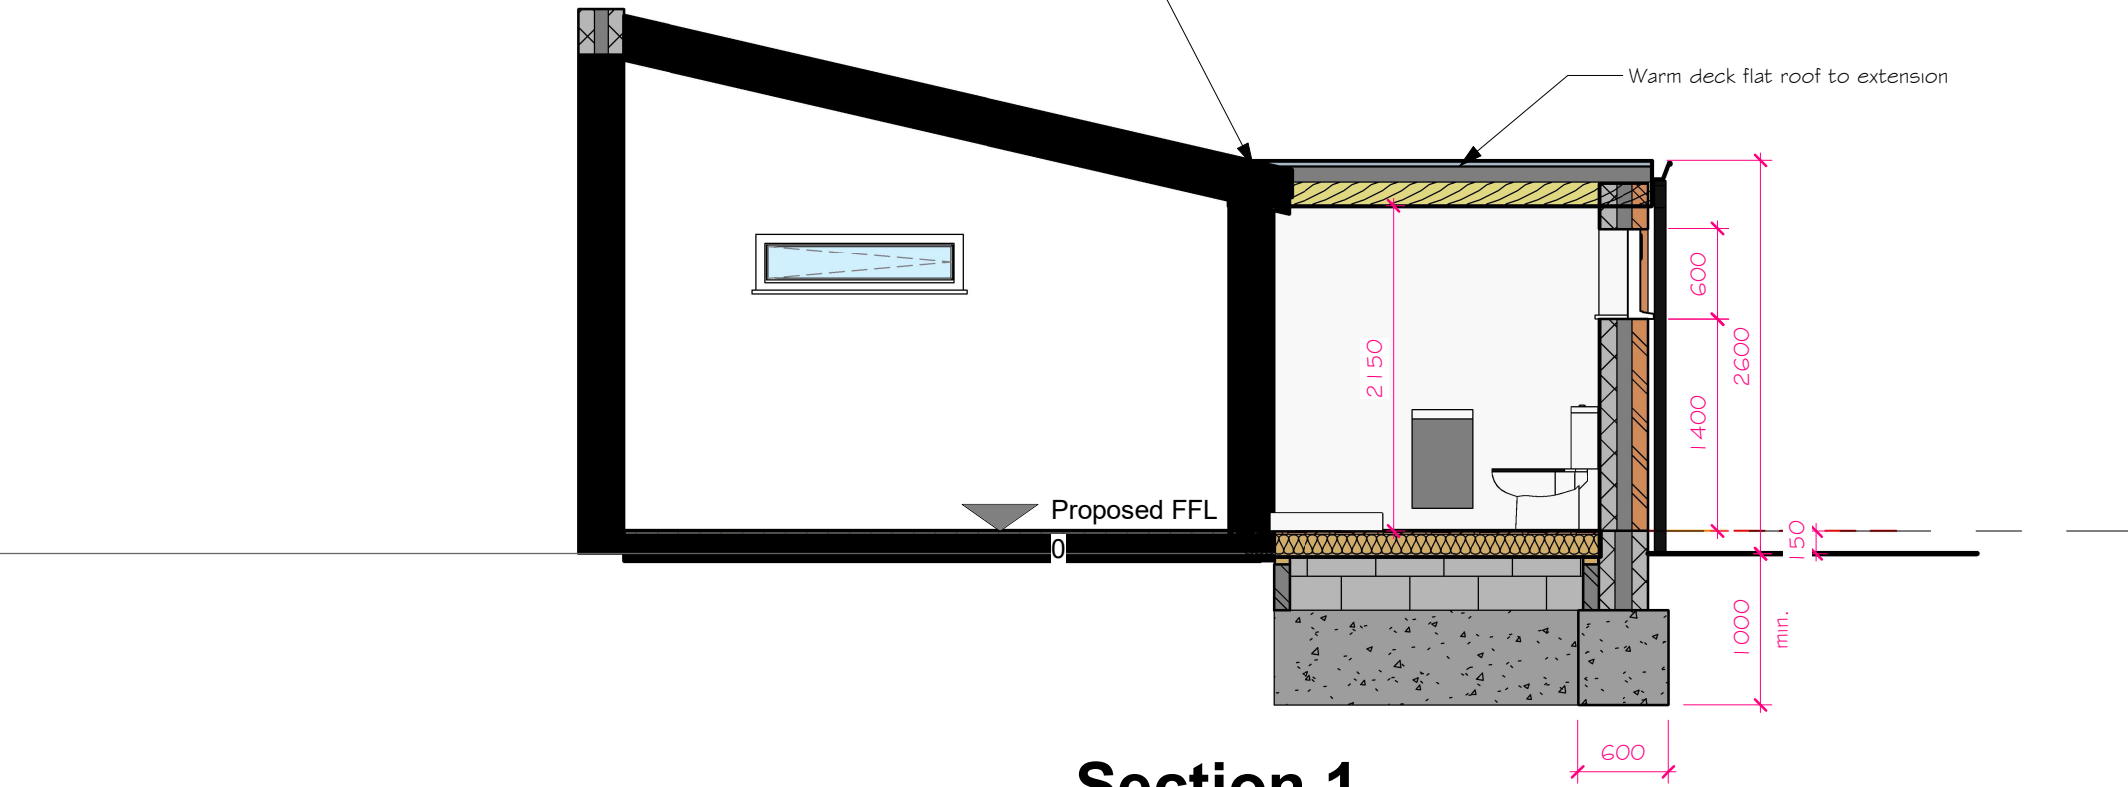

Section 1
1 : 50


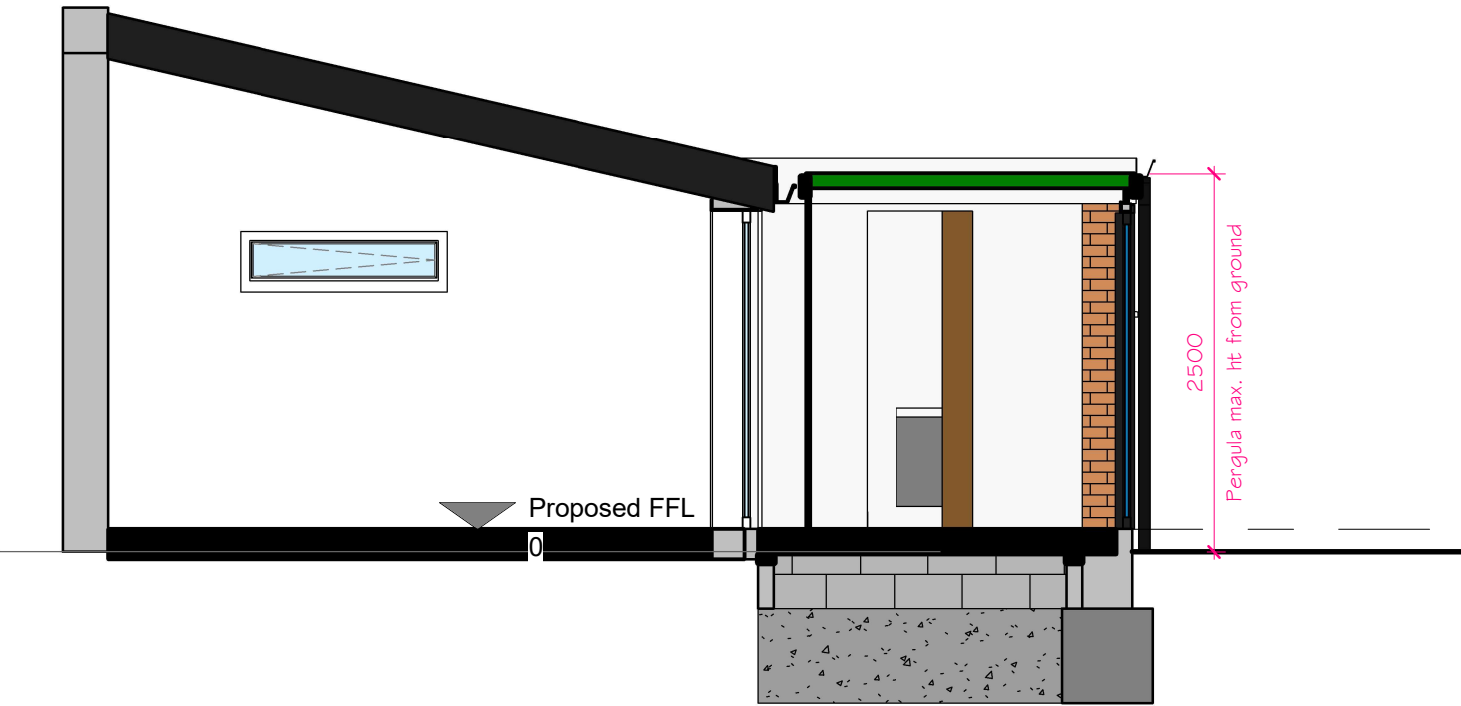


Section 2
1 : 50

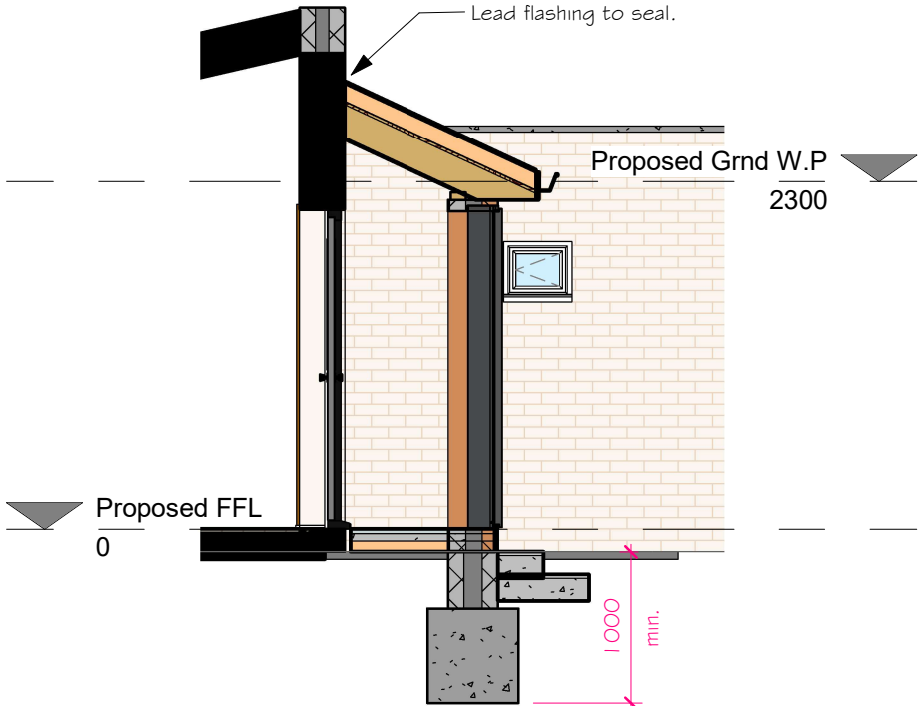

Section 3
1 : 50

THIRD ANGLE PROJECTION

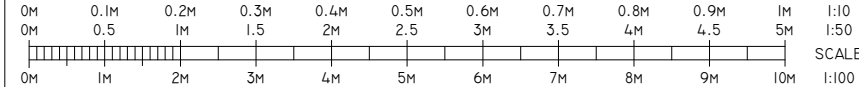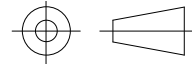


NOTES:

3. 11.01.2026
Redraw Porch as built for planning

2. 11.08.25
Note added to drawings -P2 & -P3 Indicating B/Regs exempt, Porch & Pergola shown for builders info only

1. 06.08.2025

ISSUE AND CHANGE:

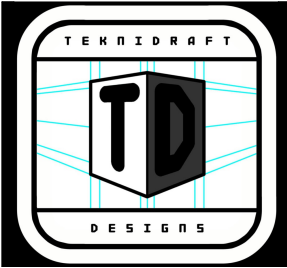

SHEET
SECTIONS 1, 2, 3

PROJECT
PORCH + PERGOLA
SHOWER/WC + INT.
ALTERATION

CLIENT
P PRASAD - S SINGH
17 APPLEBY END, READING
RG30 2NR

DATE
JAN2026

SCALE (@ A3)
1 : 50

DRAWN BY
RDB

REV

CHECKED BY
DCB

3

PROJECT NUMBER
PPRASAD-TD-25-331

DRAWING NUMBER
PPRASAD-TD-25-331-P7