





Proposed Front View
1 : 100

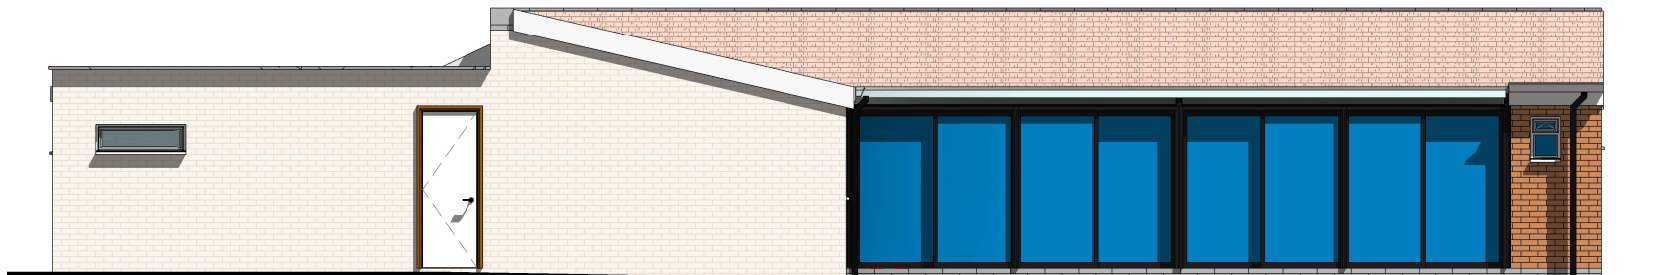

Proposed Left View
1 : 100

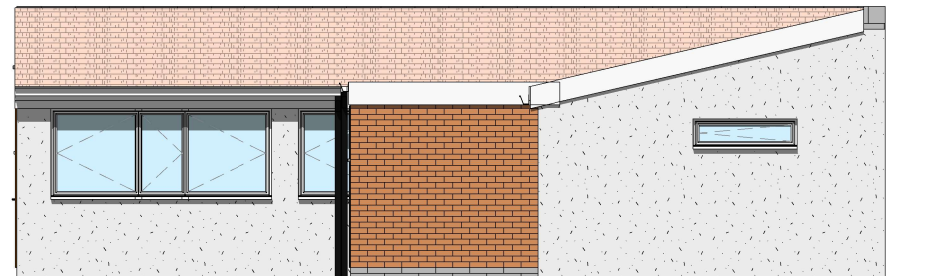

Proposed Rear View
1 : 100




Proposed Right View
1 : 100

NOTES:

3. 11.01.2026
Redraw Porch as built
for planning
2. 11.08.25
Note added to drawings
-P2 & -P3 Indicating B/Regs
exempt, Porch & Pergula
shown for builders info only

1. 06.08.2025

ISSUE AND CHANGE:

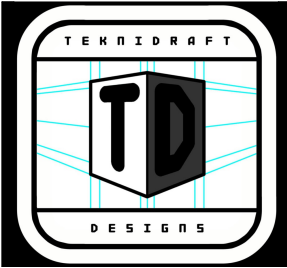

SHEET
PROPOSED
ELEVATIONS

PROJECT
PORCH + PERGOLA
SHOWER/WC + INT.
ALTERATION

CLIENT
P PRASAD - S SINGH
17 APPLEBY END, READING
RG30 2NR

DATE
JAN2026

SCALE (@ A3)
1 : 100

DRAWN BY
RDB

CHECKED BY
DCB



REV

3

PROJECT NUMBER
PPRASAD-TD-25-331

DRAWING NUMBER
PPRASAD-TD-25-331-P2

THIRD ANGLE PROJECTION

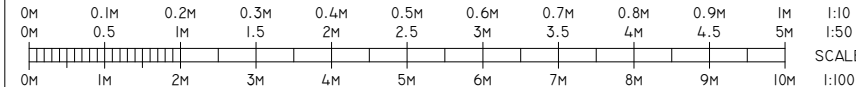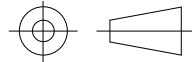

THIS DRAWING IS NOT TO BE COPIED WITHOUT PERMISSION FROM TEKNIDRAFT DESIGNS © FIND INFO AT WWW.TEKNIDRAFT.CI9/01/2026 12:19:00