


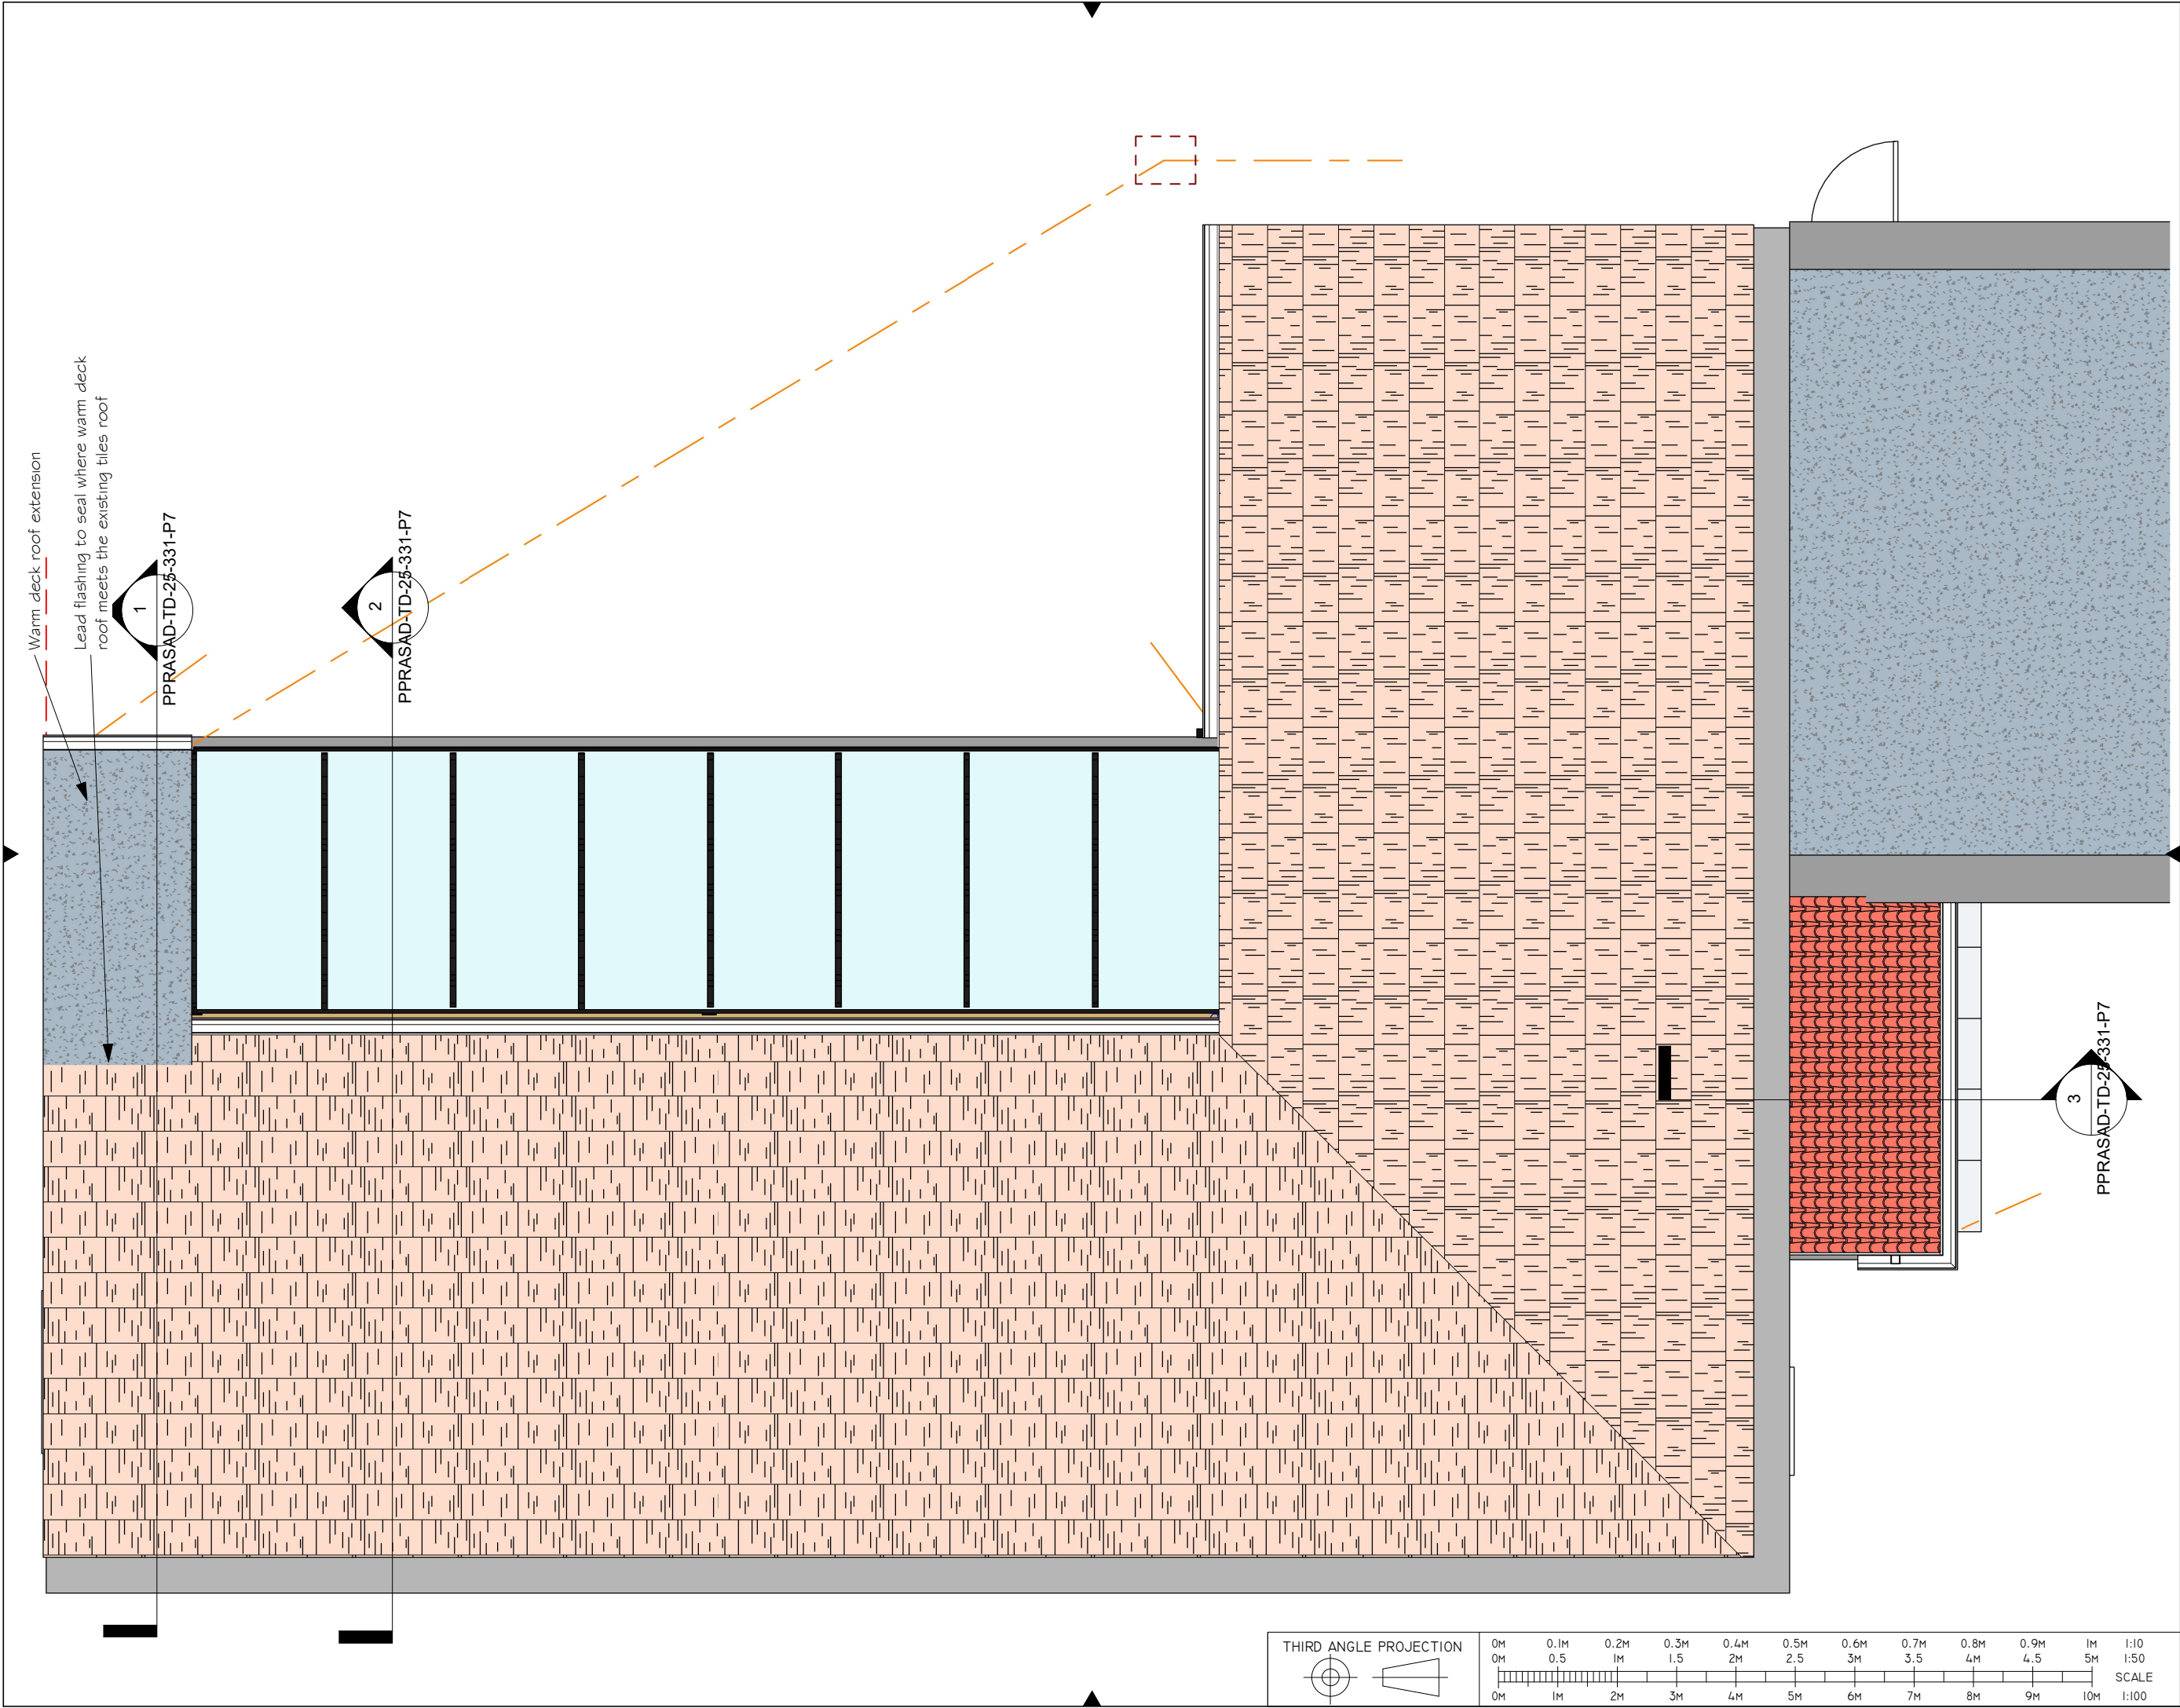

NOTES:

Proposed Roof Plan


1 : 50

3. 11.01.2026
Redraw Porch as built
for planning

2. 11.08.25
Note added to drawings
-P2 & -P3 Indicating B/Regs
exempt, Porch & Pergola
shown for builders info only

1. 06.08.2025

ISSUE AND CHANGE:

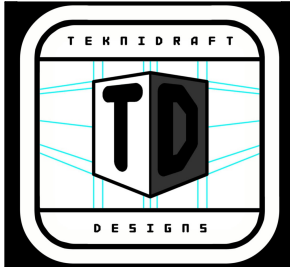

SHEET
PROPOSED ROOF PLAN

PROJECT
PORCH + PERGOLA
SHOWER/WC + INT.
ALTERATION

CLIENT
P PRASAD - S SINGH
17 APPLEBY END, READING
RG30 2NR

DATE	SCALE (@ A3)
JAN2026	1 : 50

DRAWN BY	REV
RDB	3

CHECKED BY	
DCB	

PROJECT NUMBER
PPRASAD-TD-25-331

DRAWING NUMBER
PPRASAD-TD-25-331-P6

THIRD ANGLE PROJECTION

