


KEY

- = Brick Wall Removed
- = As Built Outbuilding (Classroom)
- = Bin Store Commercial- 1 x 660ltr General Waste
- = Bin Store Residential- 2 x 240ltr Recycling 1 x 240ltr General Waste
- = Covered Bike & Buggy Store
4x Bike 4 x Double Buggy



LOCATION PLAN SCALE 1:1250

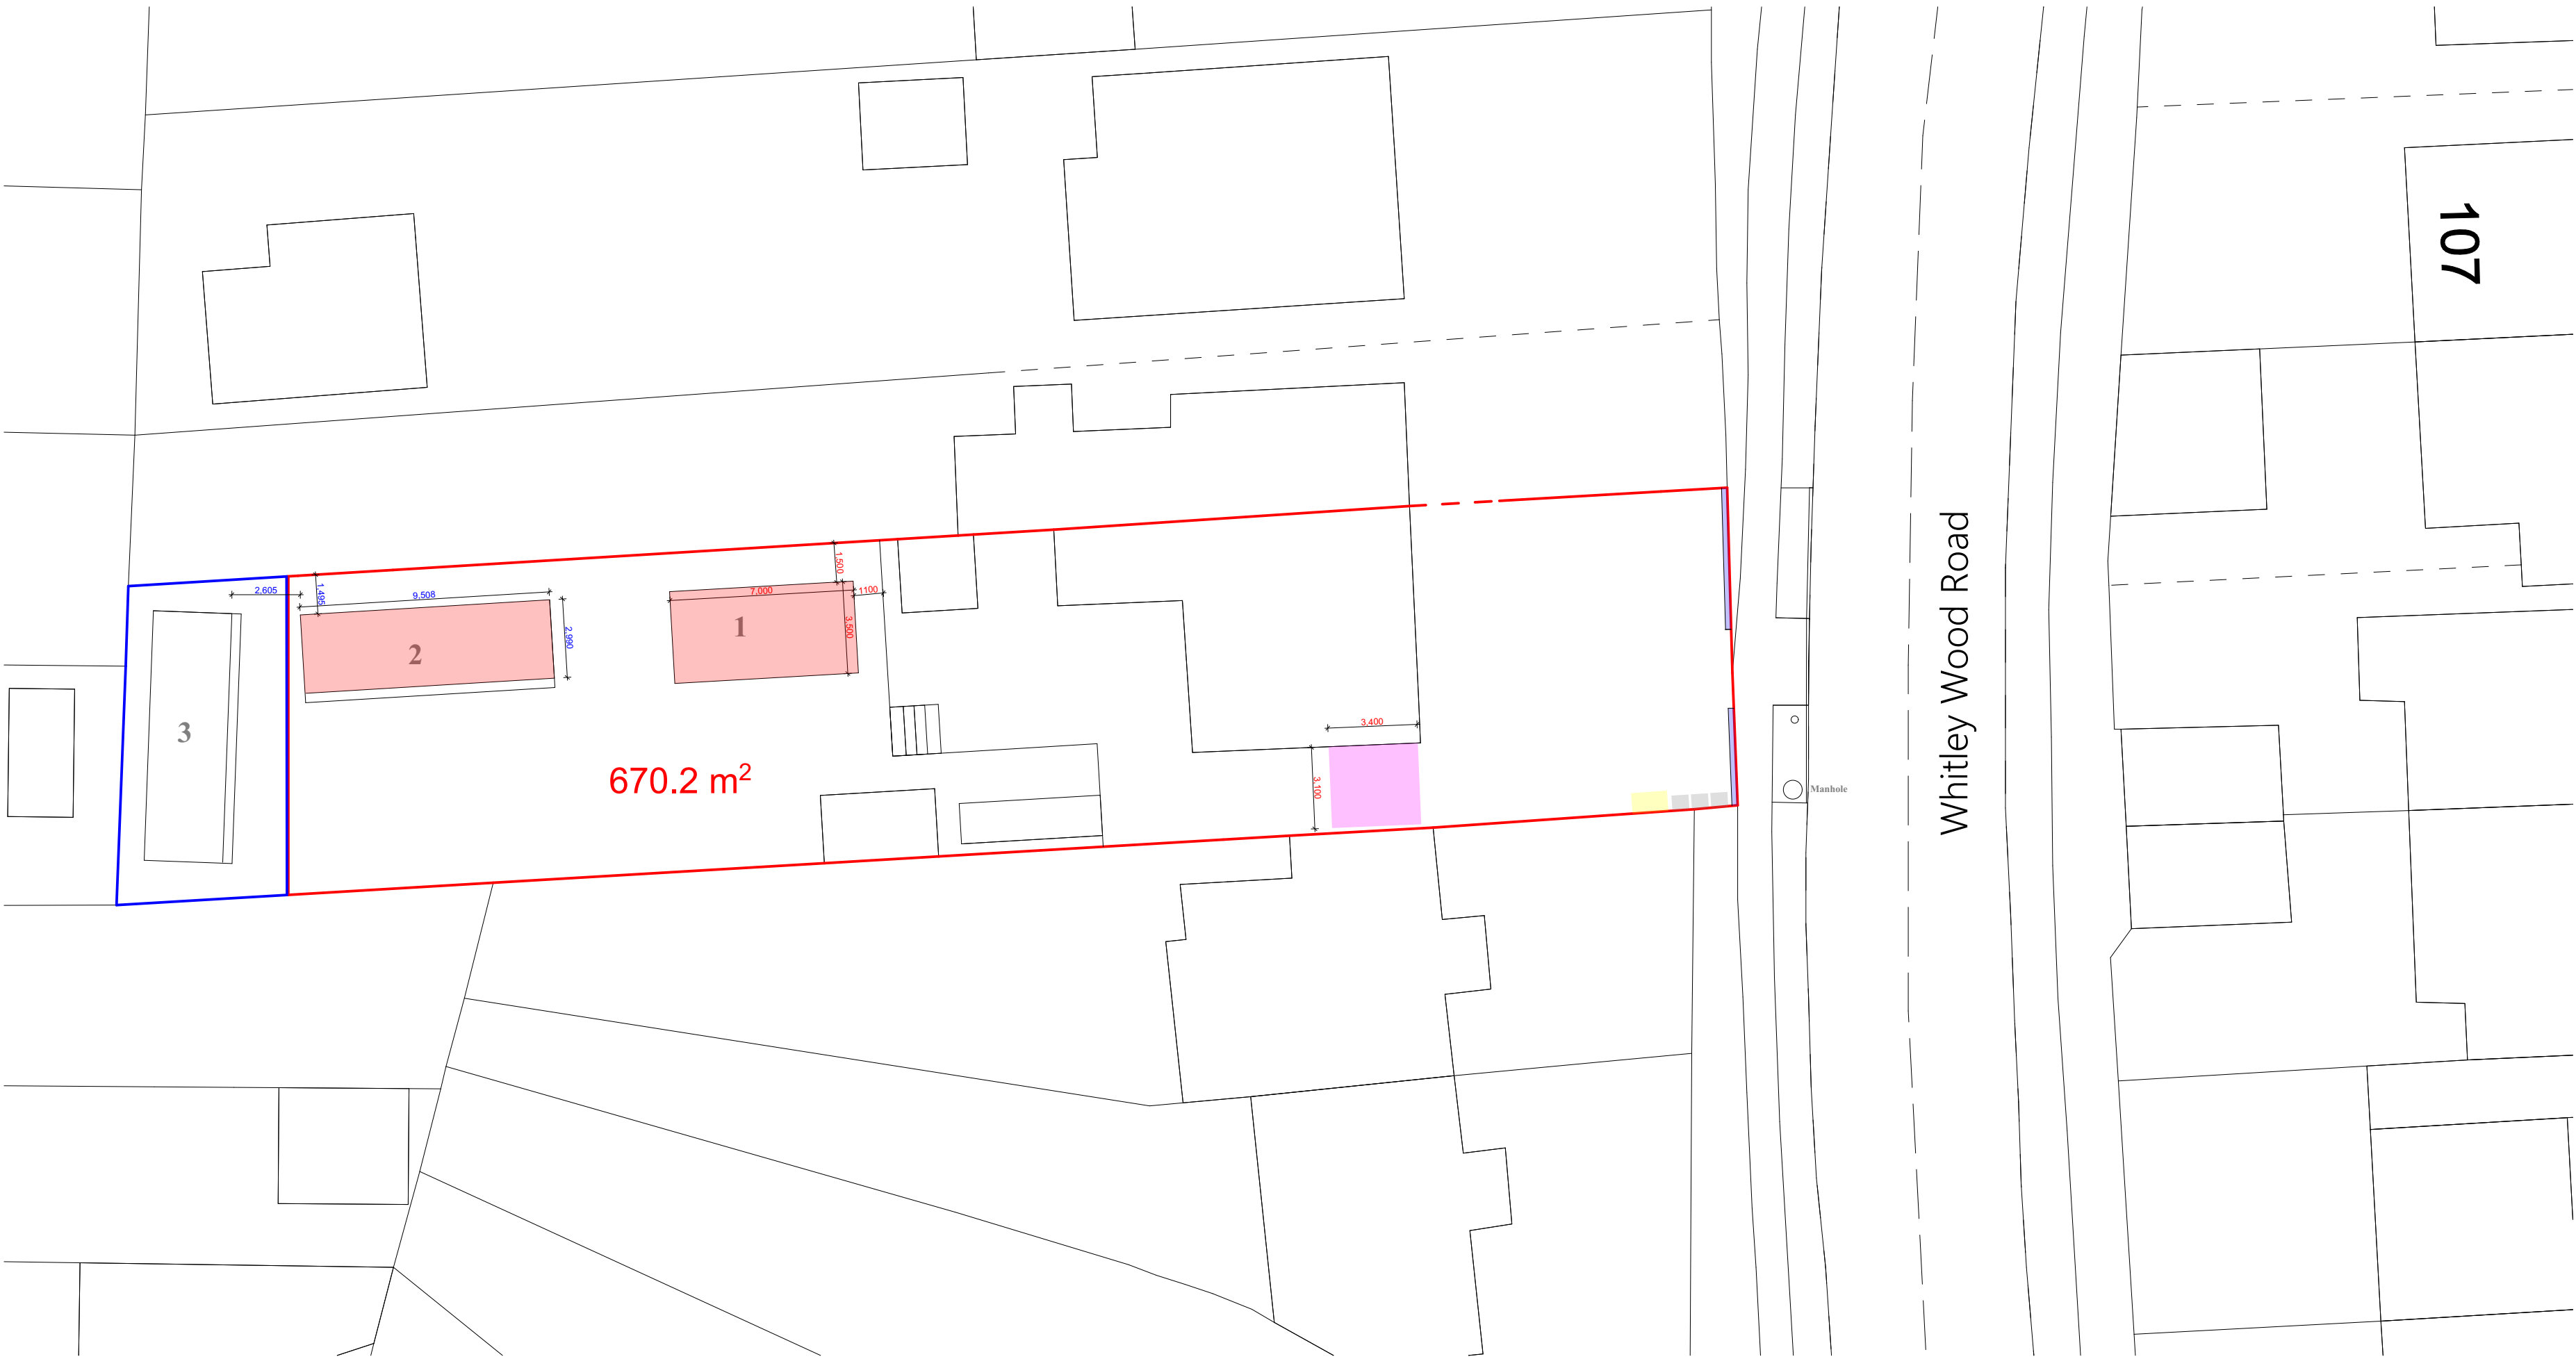

BLOCK PLAN SCALE 1:200



MATERIAL LIST

PROPOSED

Walls
Timber Cladding,

Roof
Grey EPDM

Windows:
Timber

Doors:
Timber
Facia/Soffits:
Timber

Downpipes/Guttering:
Black Plastic

B	04.02.26	RevB
A	21.01.26	RevA
REV	DATE	DESCRIPTION

STATUS: PLANNING PERMISSION

PROJECT NO: 80WWR-25

SCALE: 1:200,1250 @A1

DATE: 24.04.2025

SITE ADDRESS:

80 Whitley Wood Road,
Reading, RG2 8JE.

DRG NO:

80WWR-P-01B

DRG TITLE:

Site & Block Plan

ADAPT ARCHITECTURE LIMITED
INFO@ADAPTARCHITECTURE.CO.UK
T: 01483 904 154

