

DISCLAIMER NOTES:


- THIS DOCUMENT IS COPYRIGHT OF THE ORIGINATOR AND MUST BE TREATED AS CONFIDENTIAL.
- THE ORIGINATOR MUST NOT BE ALTERED, REPRODUCED OR DISTRIBUTED WITHOUT PRIOR WRITTEN CONSENT OF THE ORIGINATOR.
- THIS DOCUMENT MUST NOT BE ALTERED. THE ORIGINATOR ACCEPTS NO RESPONSIBILITY FOR ANY DISCREPANCIES ARISING AS A RESULT OF THE ORIGINATOR'S INFORMATION.
- ANY DISCREPANCY MUST BE REPORTED TO THE ORIGINATOR.
- ALL DIMENSIONS MUST BE CHECKED ON SITE PRIOR TO COMMENCEMENT OF ANY RELATED WORKS.
- THE ORIGINATOR MUST BE KEPT IN CONTACT WITH ALL SUPPORTING DOCUMENTS PRODUCED BY THE ORIGINATOR AND OTHER PROJECT DISCIPLINES.
- THE ORIGINATOR ACCEPTS NO RESPONSIBILITY FOR THE ACCURACY OF BACKGROUND INFORMATION PROVIDED BY THIRD PARTIES. THIS MUST BE TREATED AS INDICATIVE.
- USERS OF THIS DOCUMENT ARE RESPONSIBLE FOR CHECKING WHICH VERSIONS CURRENT.
- THE DOCUMENT STATUS INFORMATION OR 'PRELIMINARY' INDICATES THAT THIS DOCUMENT IS NOT FOR CONSTRUCTION AND THE ORIGINATOR ACCEPTS NO RESPONSIBILITY FOR THE COMPLETENESS OF INFORMATION UNDER THIS STATUS.
- THE DOCUMENT STATUS 'RECORD' OR 'AS BUILT' HAS BEEN PREPARED, IN PART, BASED UPON INFORMATION FURNISHED BY OTHERS. WHILE THIS INFORMATION IS BELIEVED TO BE CORRECT, IT IS NOT GUARANTEED BY THE ORIGINATOR.
- RECORD OR 'AS BUILT' DOCUMENT OR FOR ANY ERRORS OR OMISSIONS THAT MAY HAVE BEEN INCORPORATED INTO IT AS A RESULT OF INCORRECT INFORMATION PROVIDED TO THE ORIGINATOR. THOSE RELYING ON THE 'RECORD' OR 'AS BUILT' DOCUMENT ARE ADVISED TO OBTAIN INDEPENDENT VERIFICATION OF ITS ACCURACY.

DRAWING NOTES:

CONFLICT OR NON-CONFORMANCE RISKS AND RISKS WHICH ARE DIFFICULT TO MANAGE ARE IDENTIFIED BY THE ORIGINATOR AND ARE IDENTIFIED BY THE ORIGINATOR. THE RIGHT WITH BRIEF ACCOMPANYING TEXT FOR FURTHER DETAILS OF THE RISKS IDENTIFIED BY DESIGNERS. REFERENCE SHOULD BE MADE TO CON HAZARD REGISTER.



Comparison outline
of consented
scheme layout
(in red)

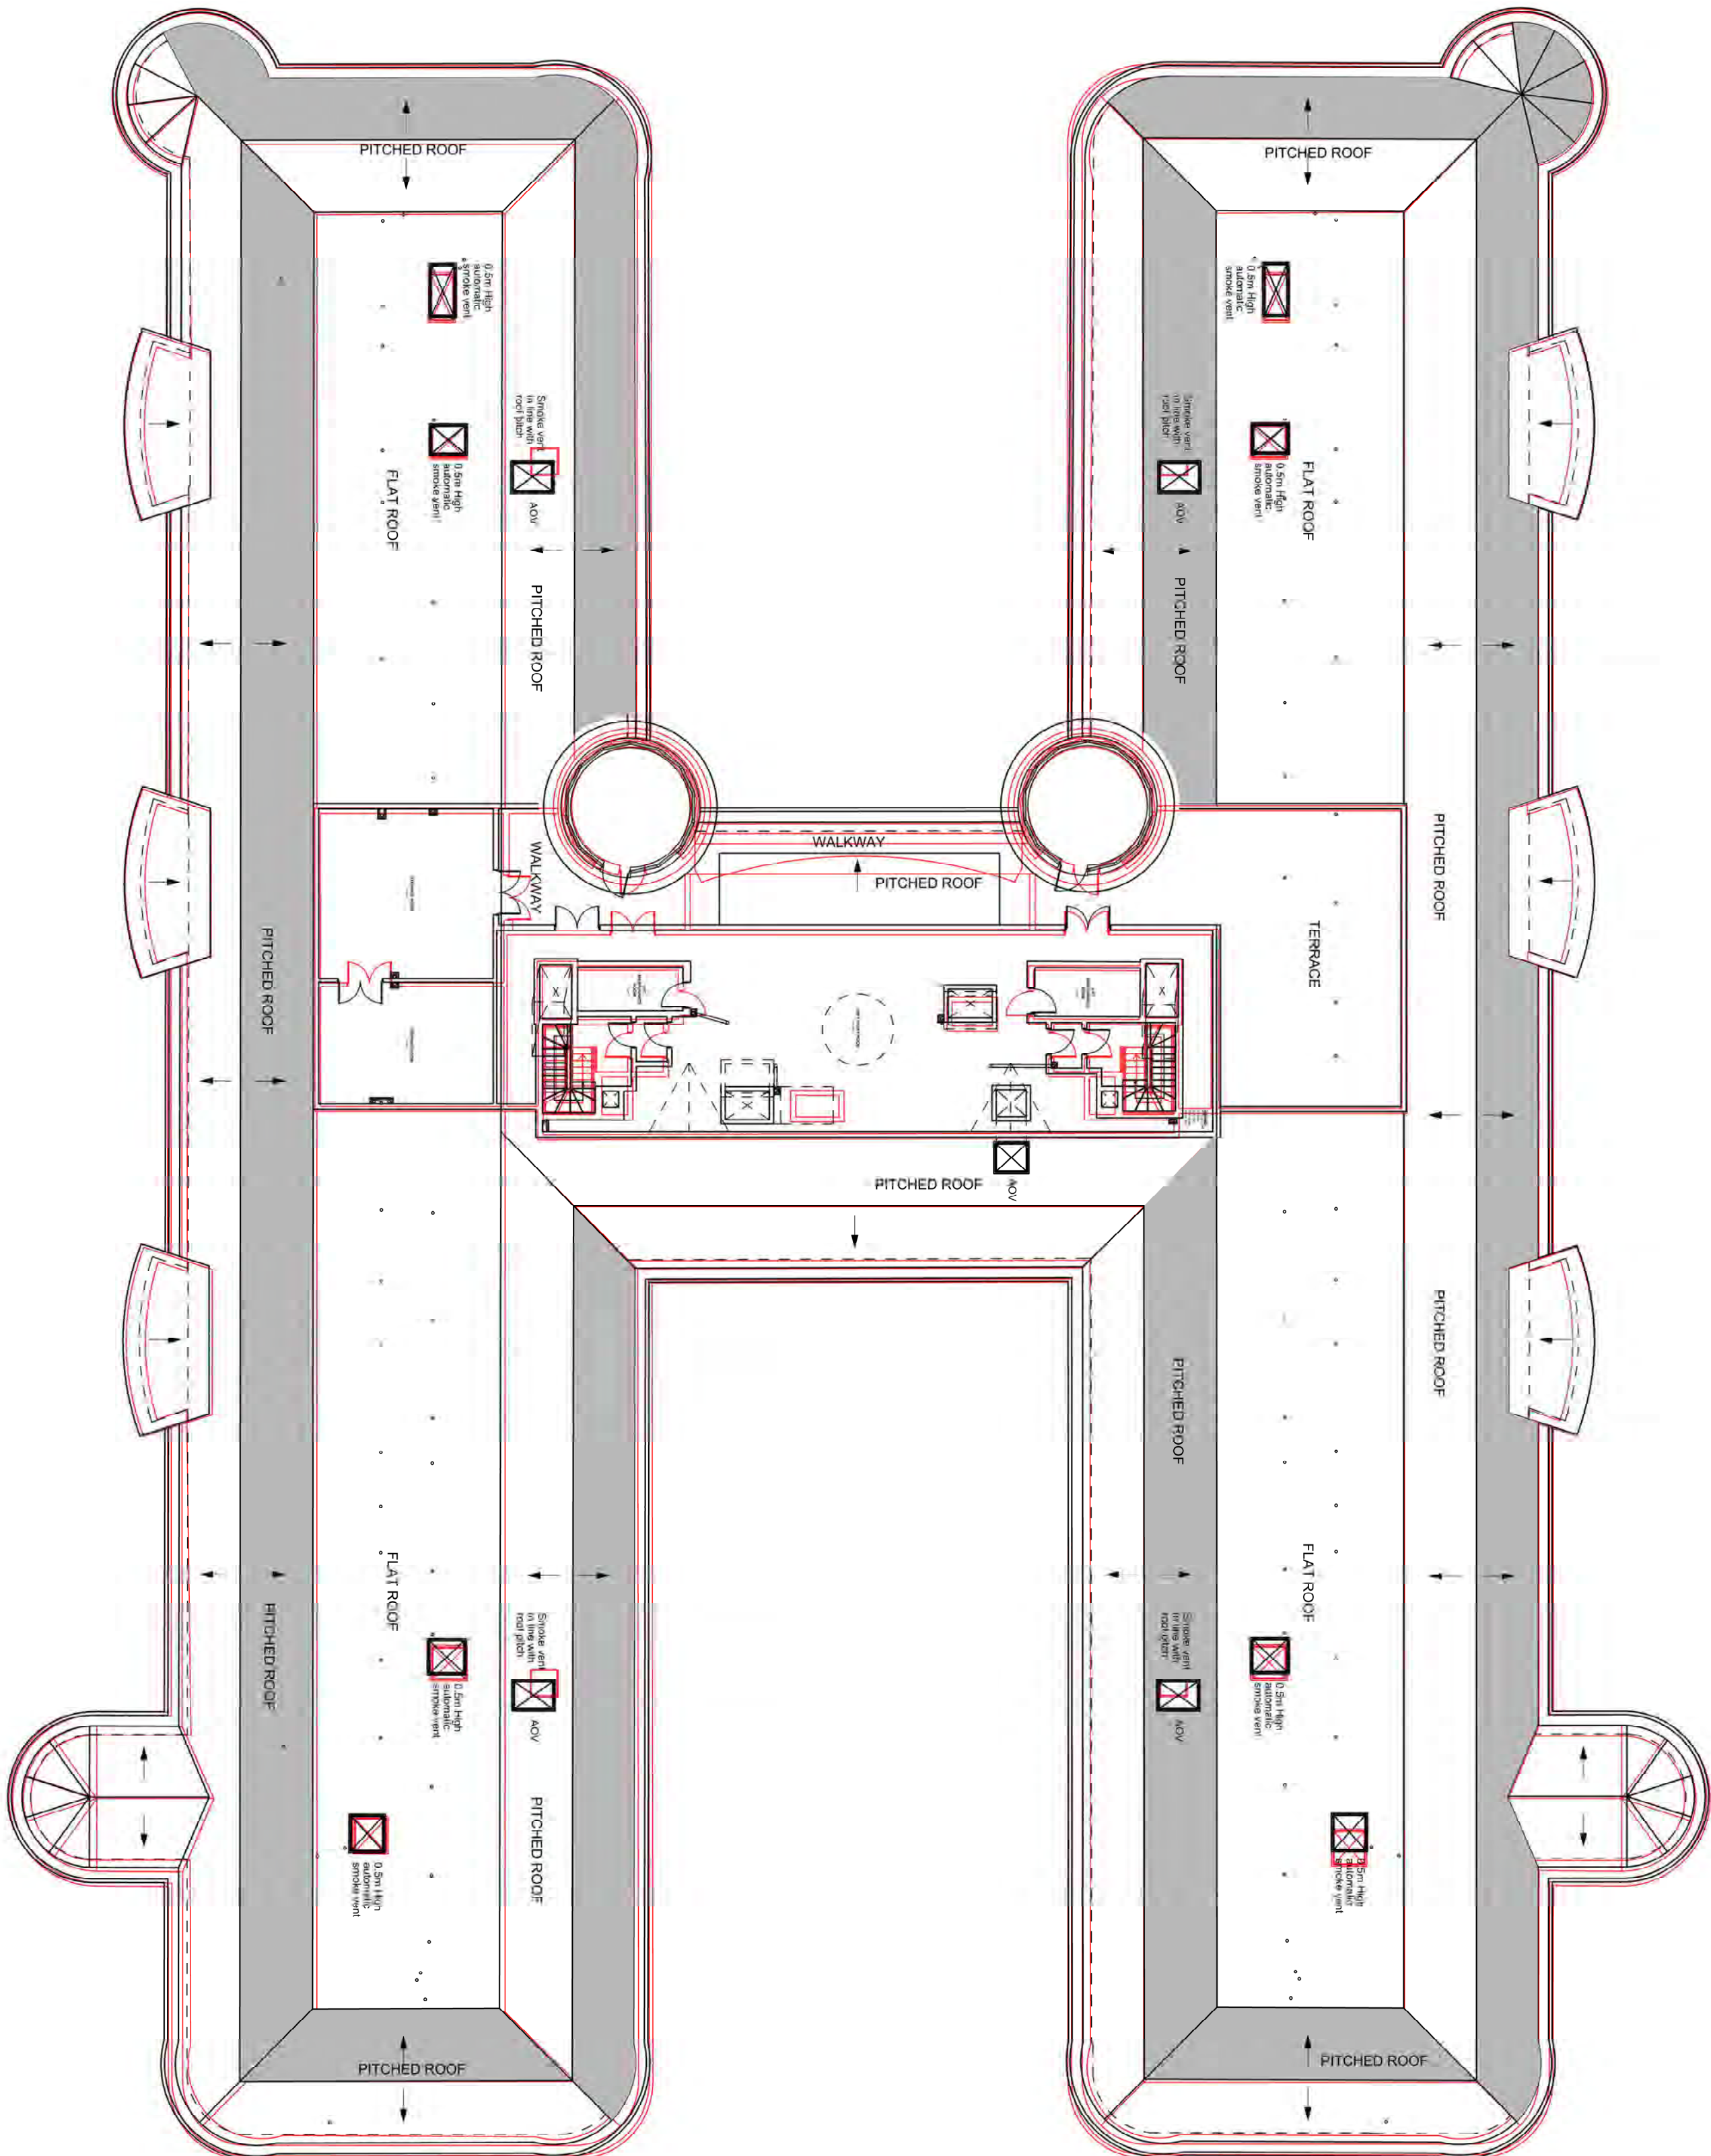

P01	Final Issue	20.12.2026	AM	US
REV	DESCRIPTION	DATE	BY	CHKD
ORIGINATOR	www.rdg.co.uk			

PROJECT NUMBER: 5025893
CLIENT: KINGS OAK MIAMI

IN ASSOCIATION WITH:

PROJECT: GREAT BRIGHAMS MEAD
READING

TITLE: PROPOSED THIRD FLOOR
COMPARISON PLAN
SUITABLE FOR PLANNING

DRAWN BY: AM CHECKED BY: NS APPROVED BY: NS
SCALE: 1:200 @ A1 DATE: 20/02/2026
STATUS: DESCRIPTION: S4 FOR LEAD APPOINTING PARTY AUTHORISATION

DRAWING NO: 5025893-RDG-00P-D-A-5033
PROJECT: GREAT BRIGHAMS MEAD
5025893 RDG 00 PL D A 5033 P01

