




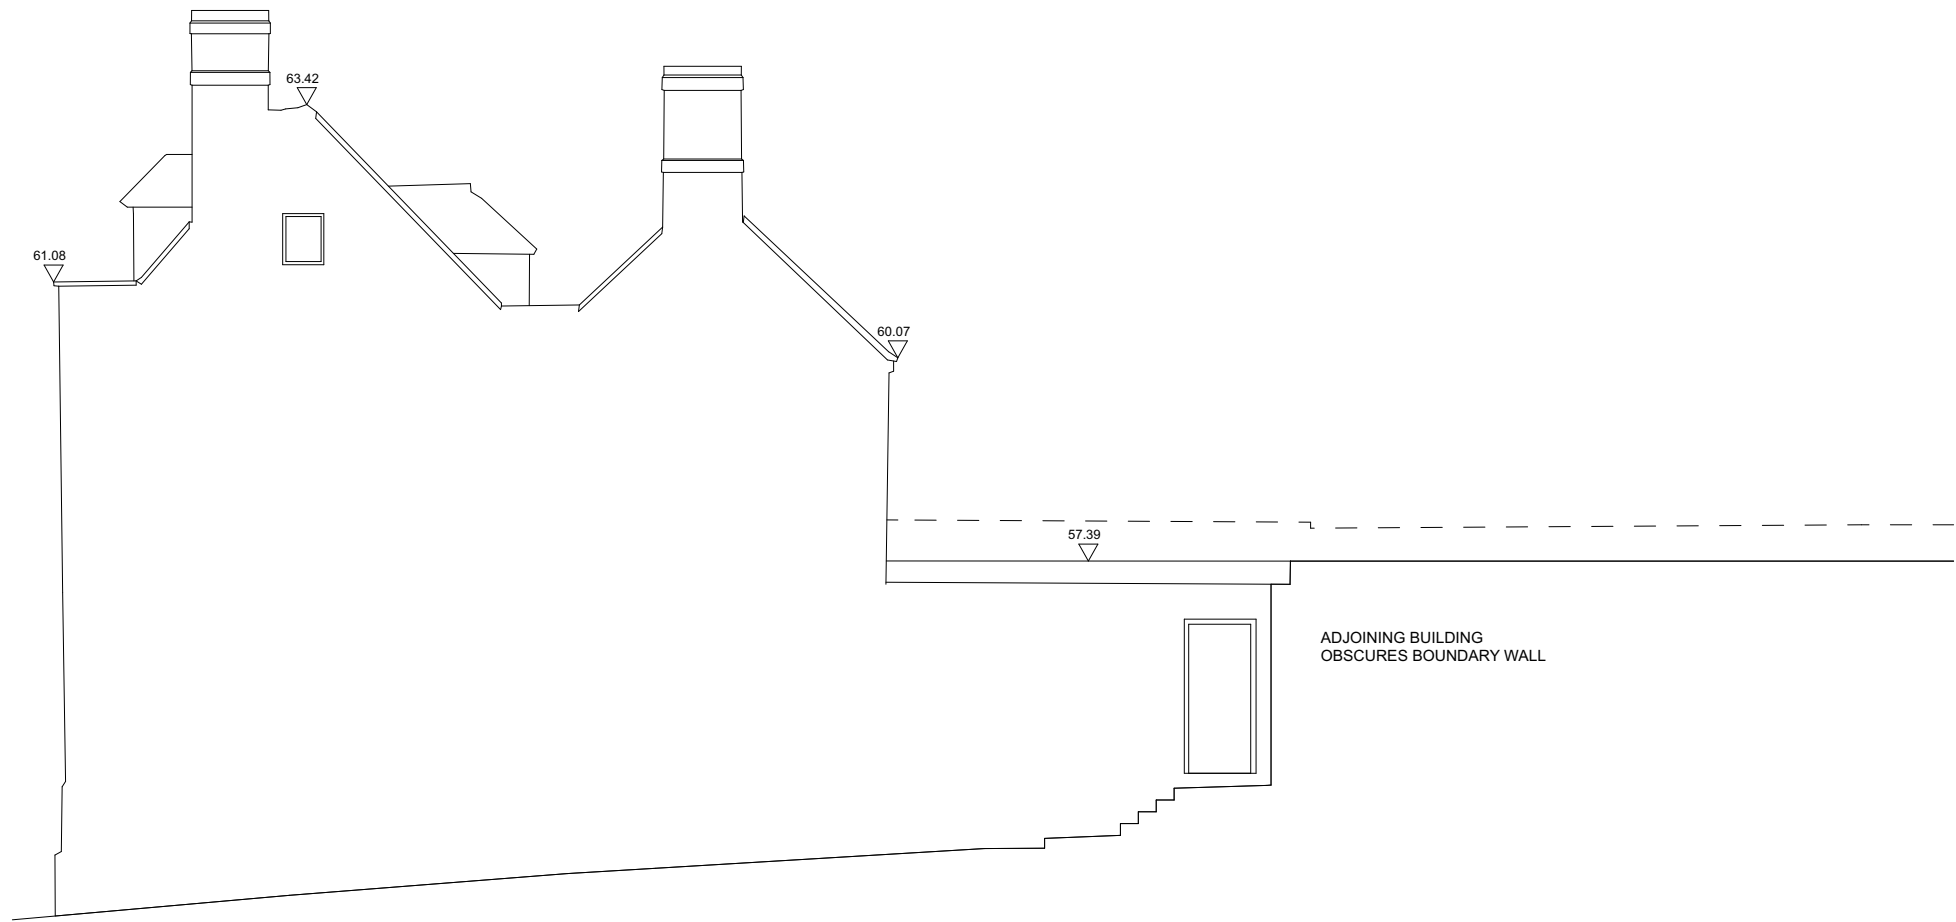


LB-NE PRE-EXISTING NORTH ELEVATION 1:100

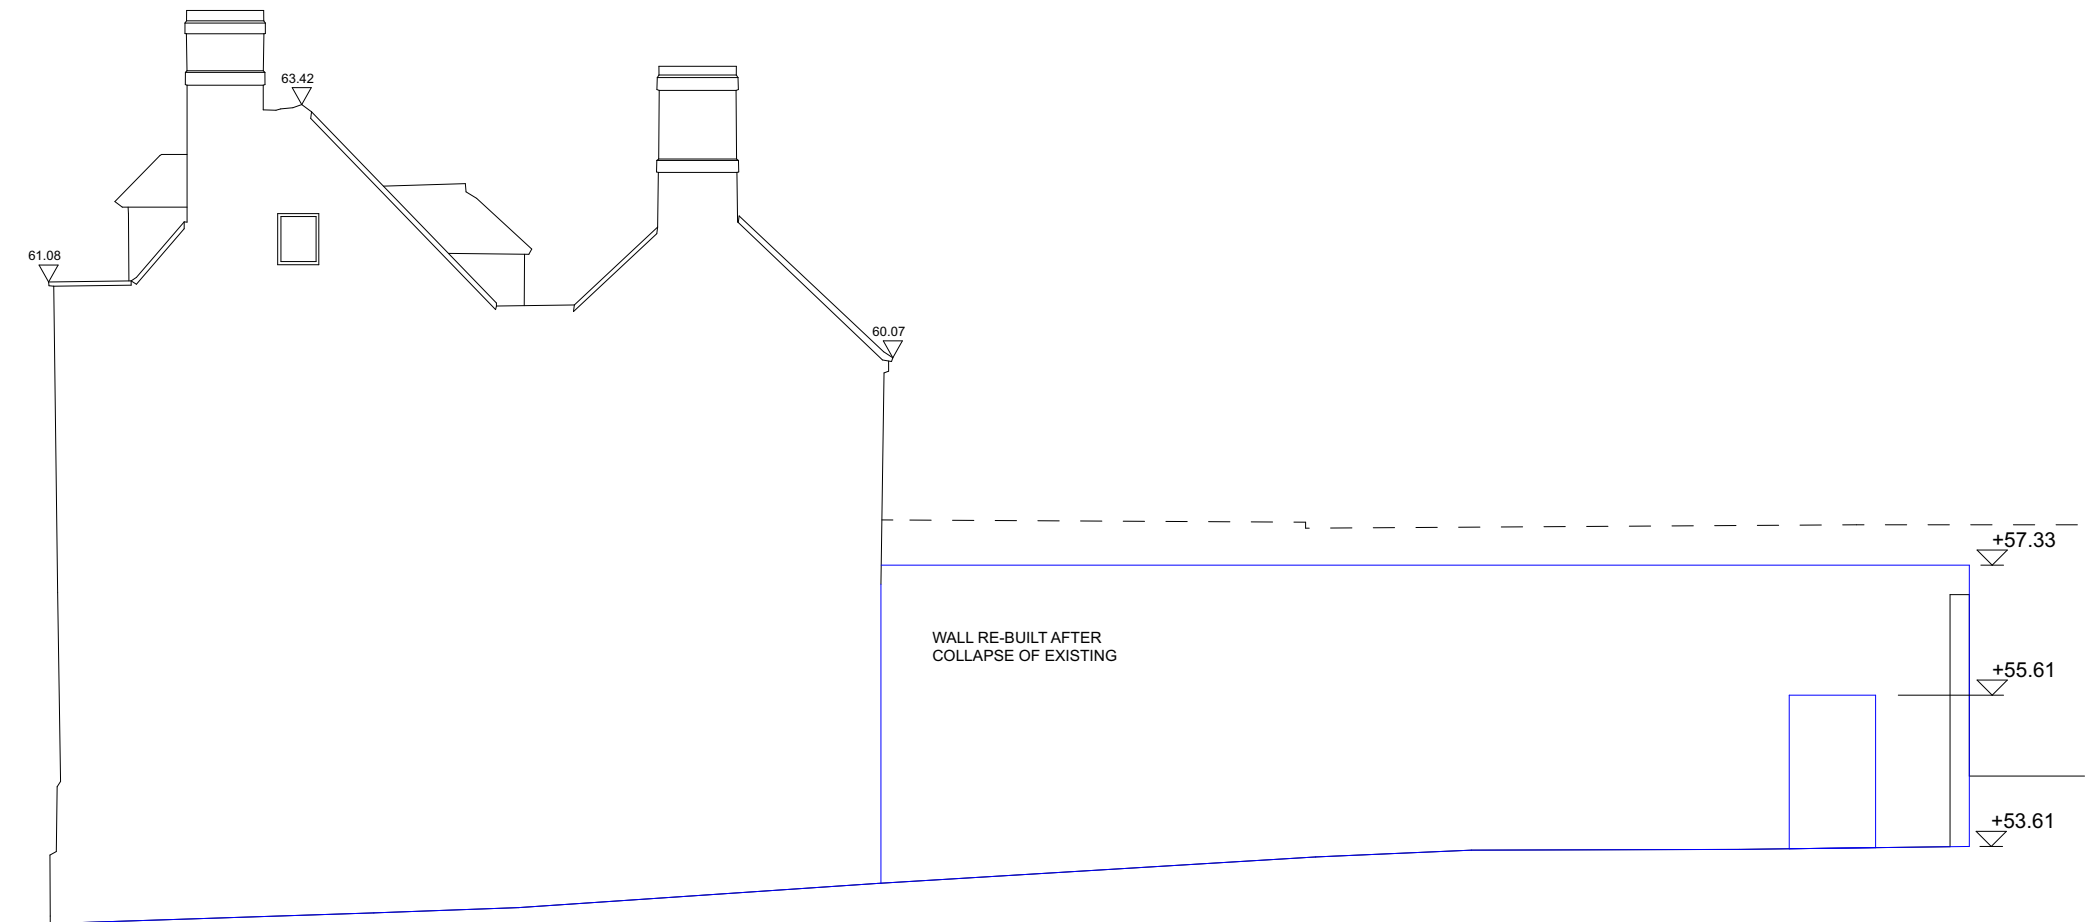


LB-NE AS-BUILT NORTH ELEVATION 1:100

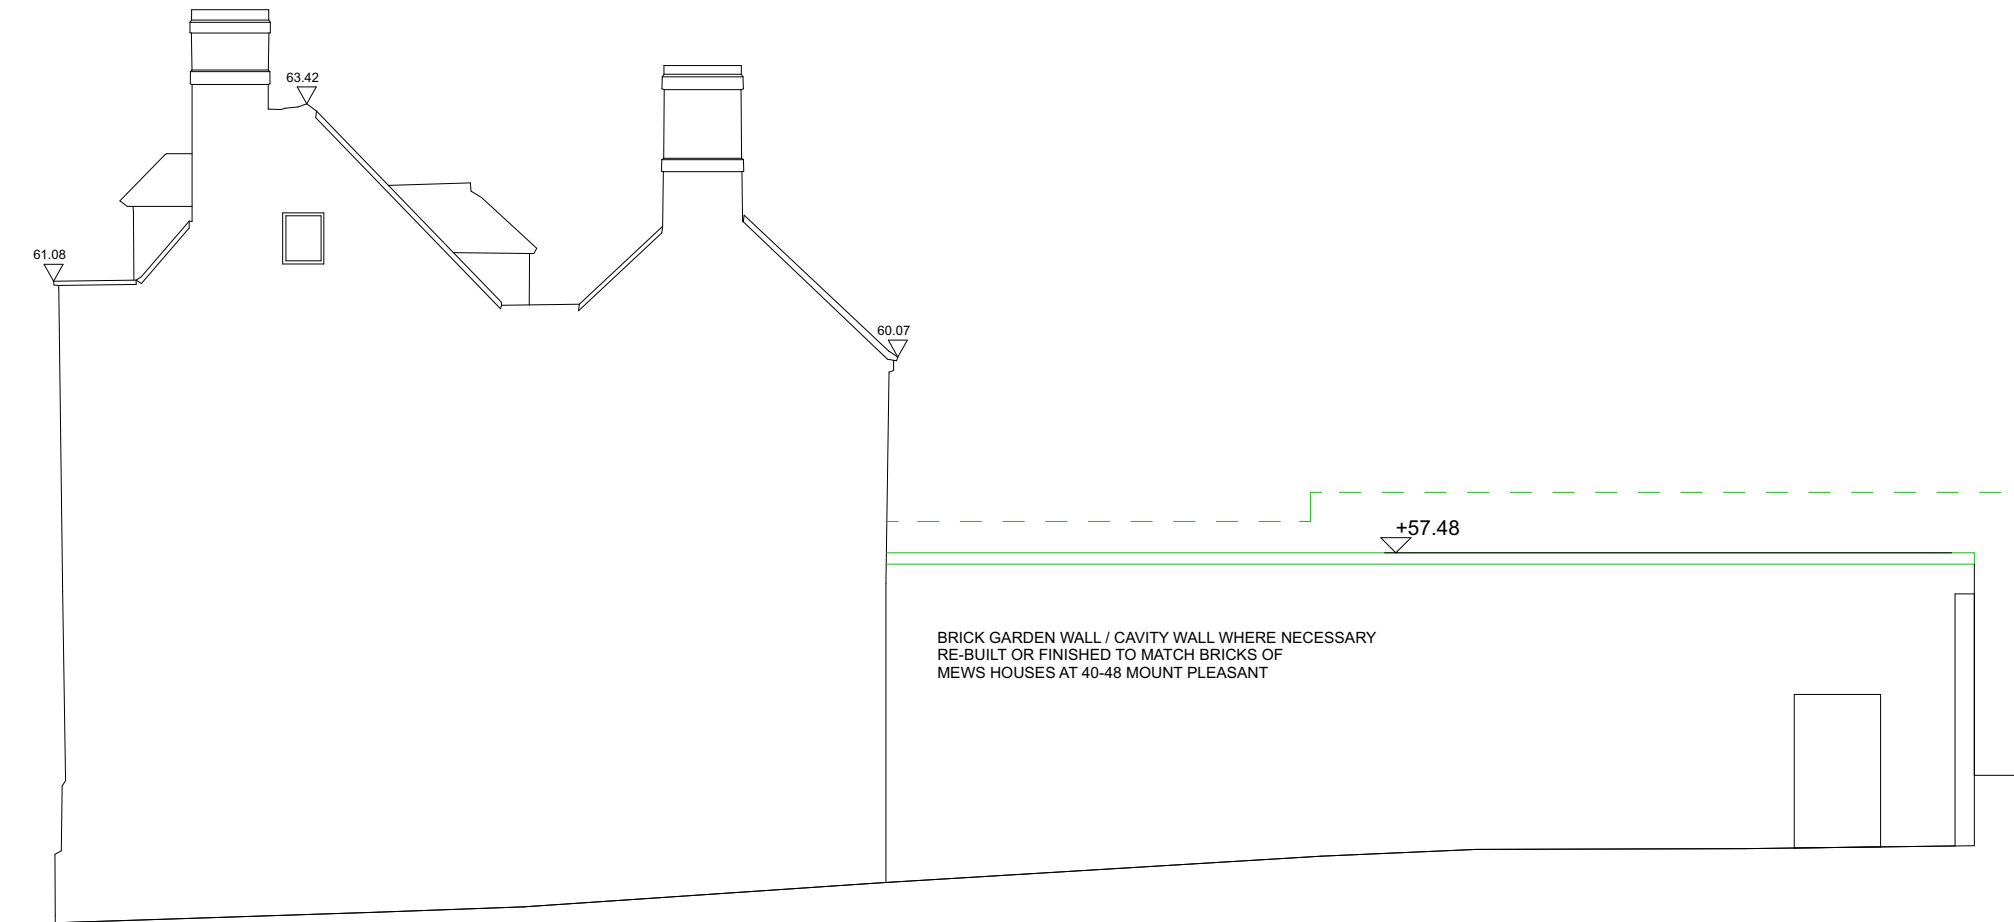

LB-NE PROPOSED NORTH ELEVATION 1:100

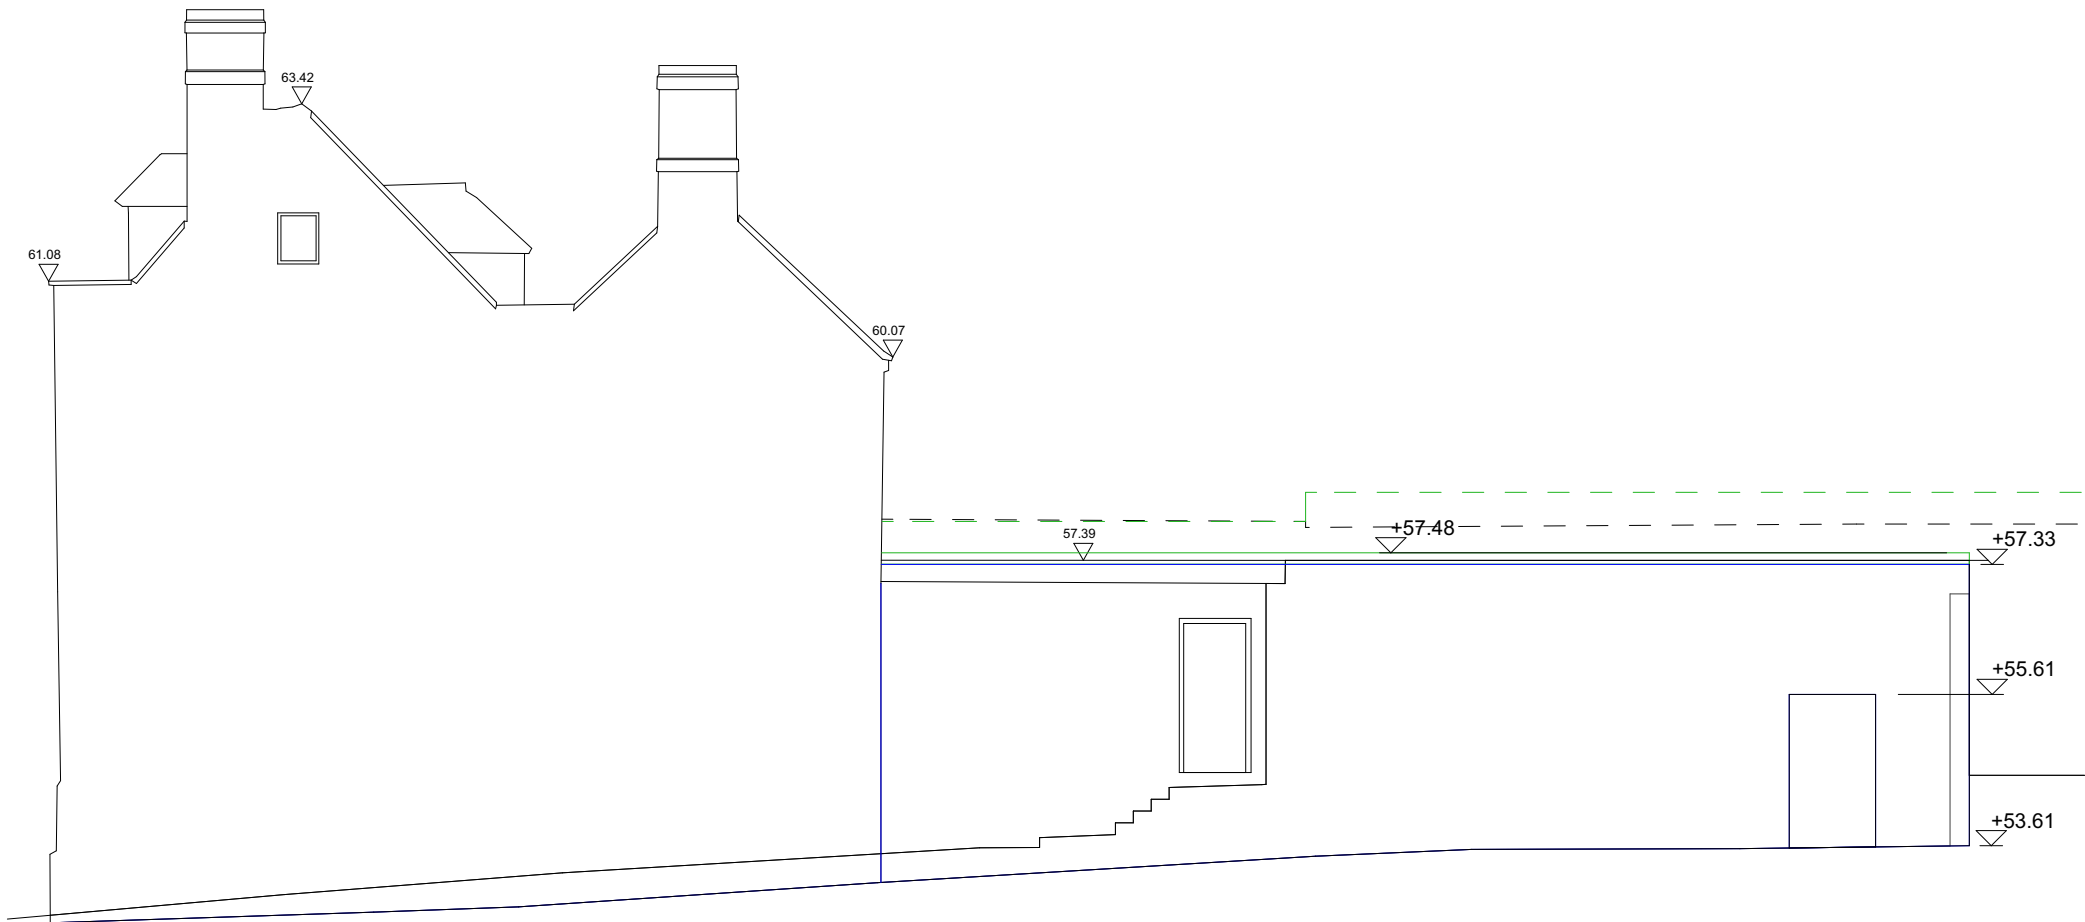

LB-NE OVERLAY COMPARISON NORTH ELEVATION 1:100

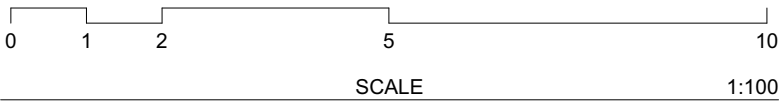

NOTES ORIGINAL A2

NOT FOR CONSTRUCTION
THIS DRAWING IS PREPARED FOR PLANNING ONLY. THIS DRAWING IS BASED ON OS INFORMATION AND OUTLINE SURVEY. THE PROPOSAL IS SUBJECT TO PLANNING, BUILDING CONTROL, DETAILED DESIGN, CDM, LEGAL INVESTIGATIONS, SURVEY, ETC. NO STRUCTURAL SURVEY, OR ADVICE HAS BEEN USED IN THE COMPILATION OF THESE DRAWINGS. AREAS SHOWN ARE APPROXIMATE, AND SUBJECT TO DETAILED DESIGN.

(C) COPYRIGHT HIVES ARCHITECTS LLP

Revision
25/02/2026 PLANNING ISSUE

Client
T&H ASSETS LTD

Job title
**50 MOUNT PLEASANT
READING, RG1 2DT**

Drawing Title
**BOUNDARY WALL PRE-EXISTING, AS-BUILT AND
PROPOSED NORTH ELEVATIONS**

Scale
1:100 @A2

Project Status
PLANNING

HIVES ARCHITECTS
SINCE 1934
Hives Architects LLP
Quadrant House
Broad Street
Reading
RG1 7QE
0118 958 7331
info@hivesarchitects.co.uk

Project	Drawing	Revision
		2787 301P3

Drawn
GP

Checked
HW