





E-01 As-Built South Elevation 01 1:100

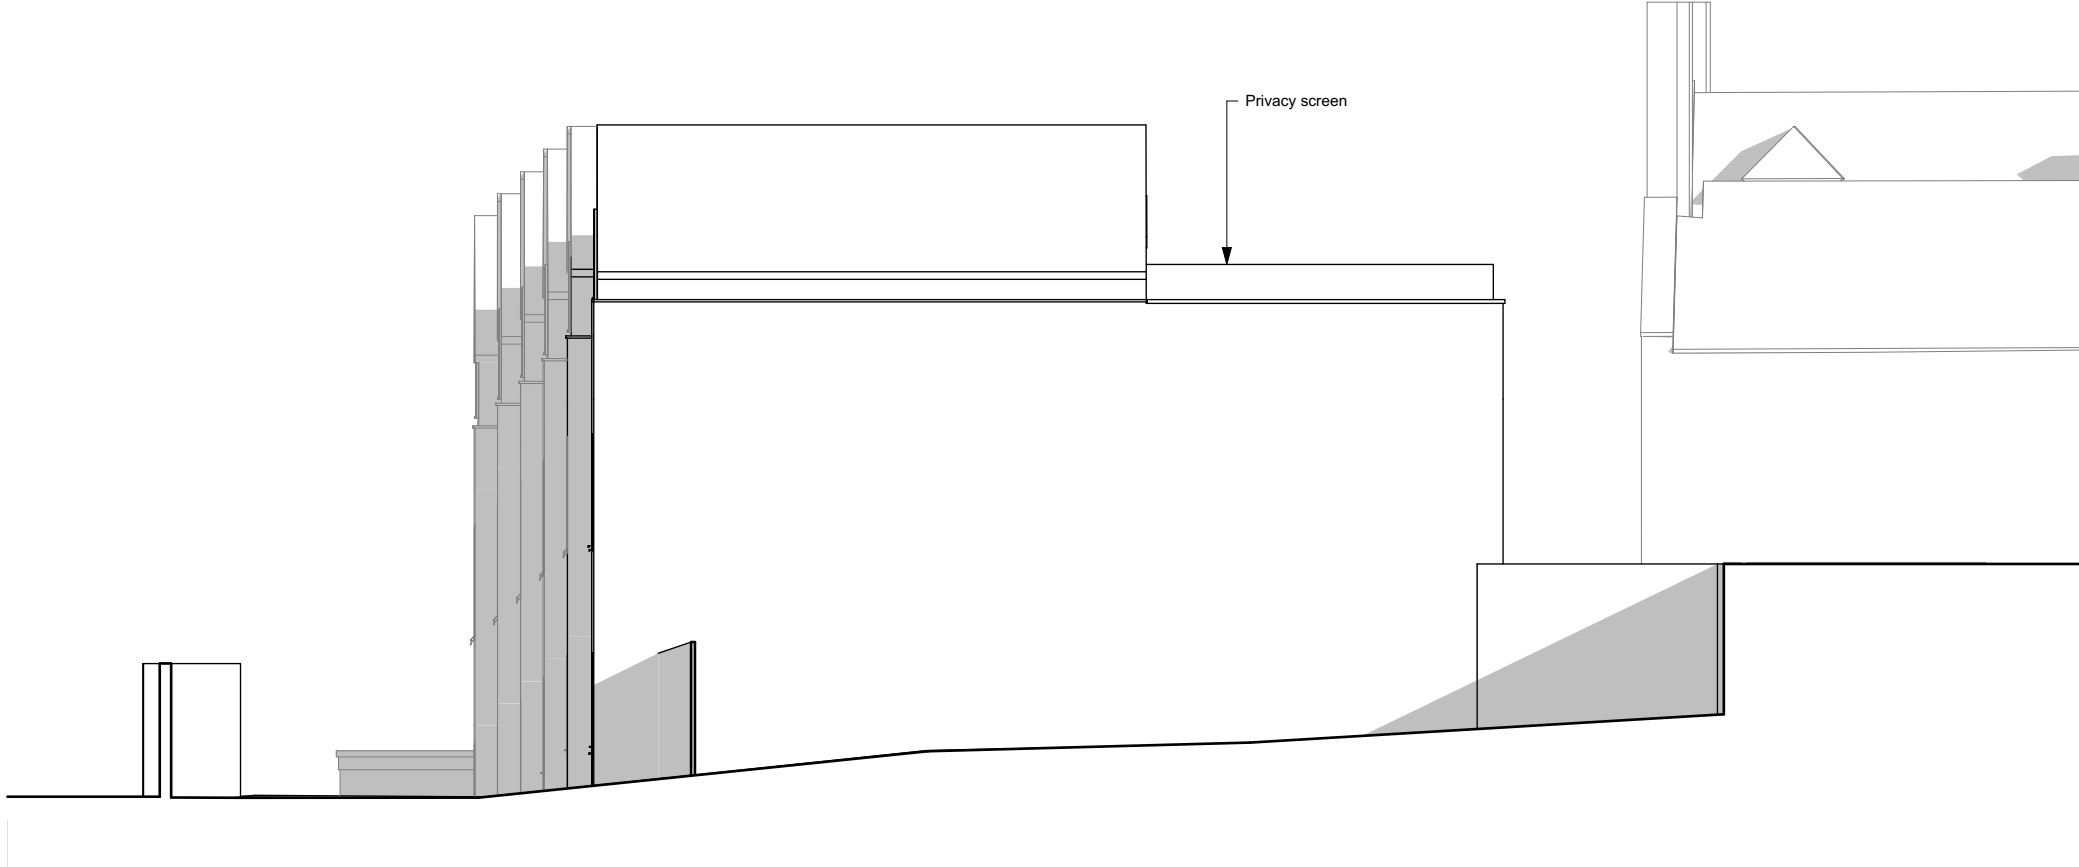

E-04 As-Built West Elevation 04 1:100

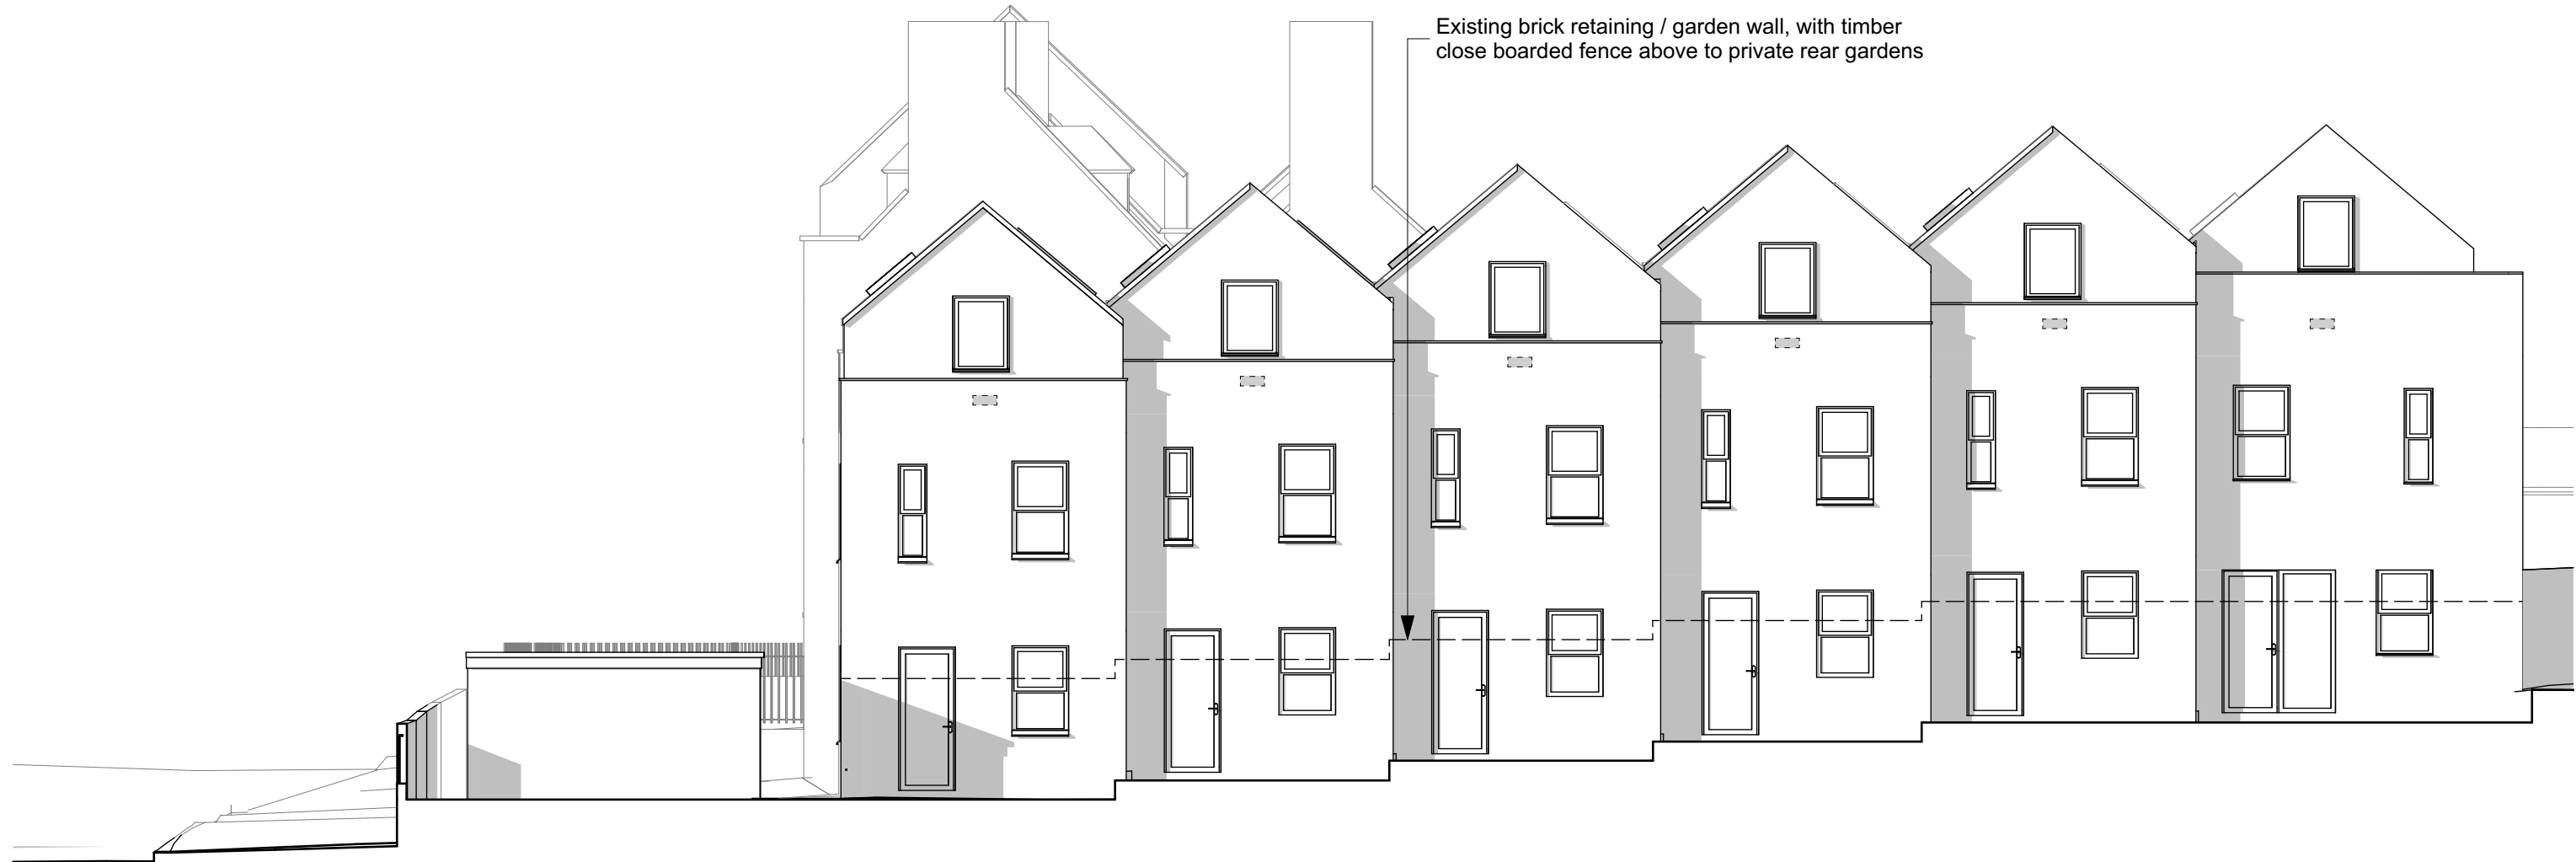


E-03 As-Built North Elevation 03 1:100




E-02 As-Built East Elevation 02 1:100




E-01 Proposed South Elevation 01 1:100

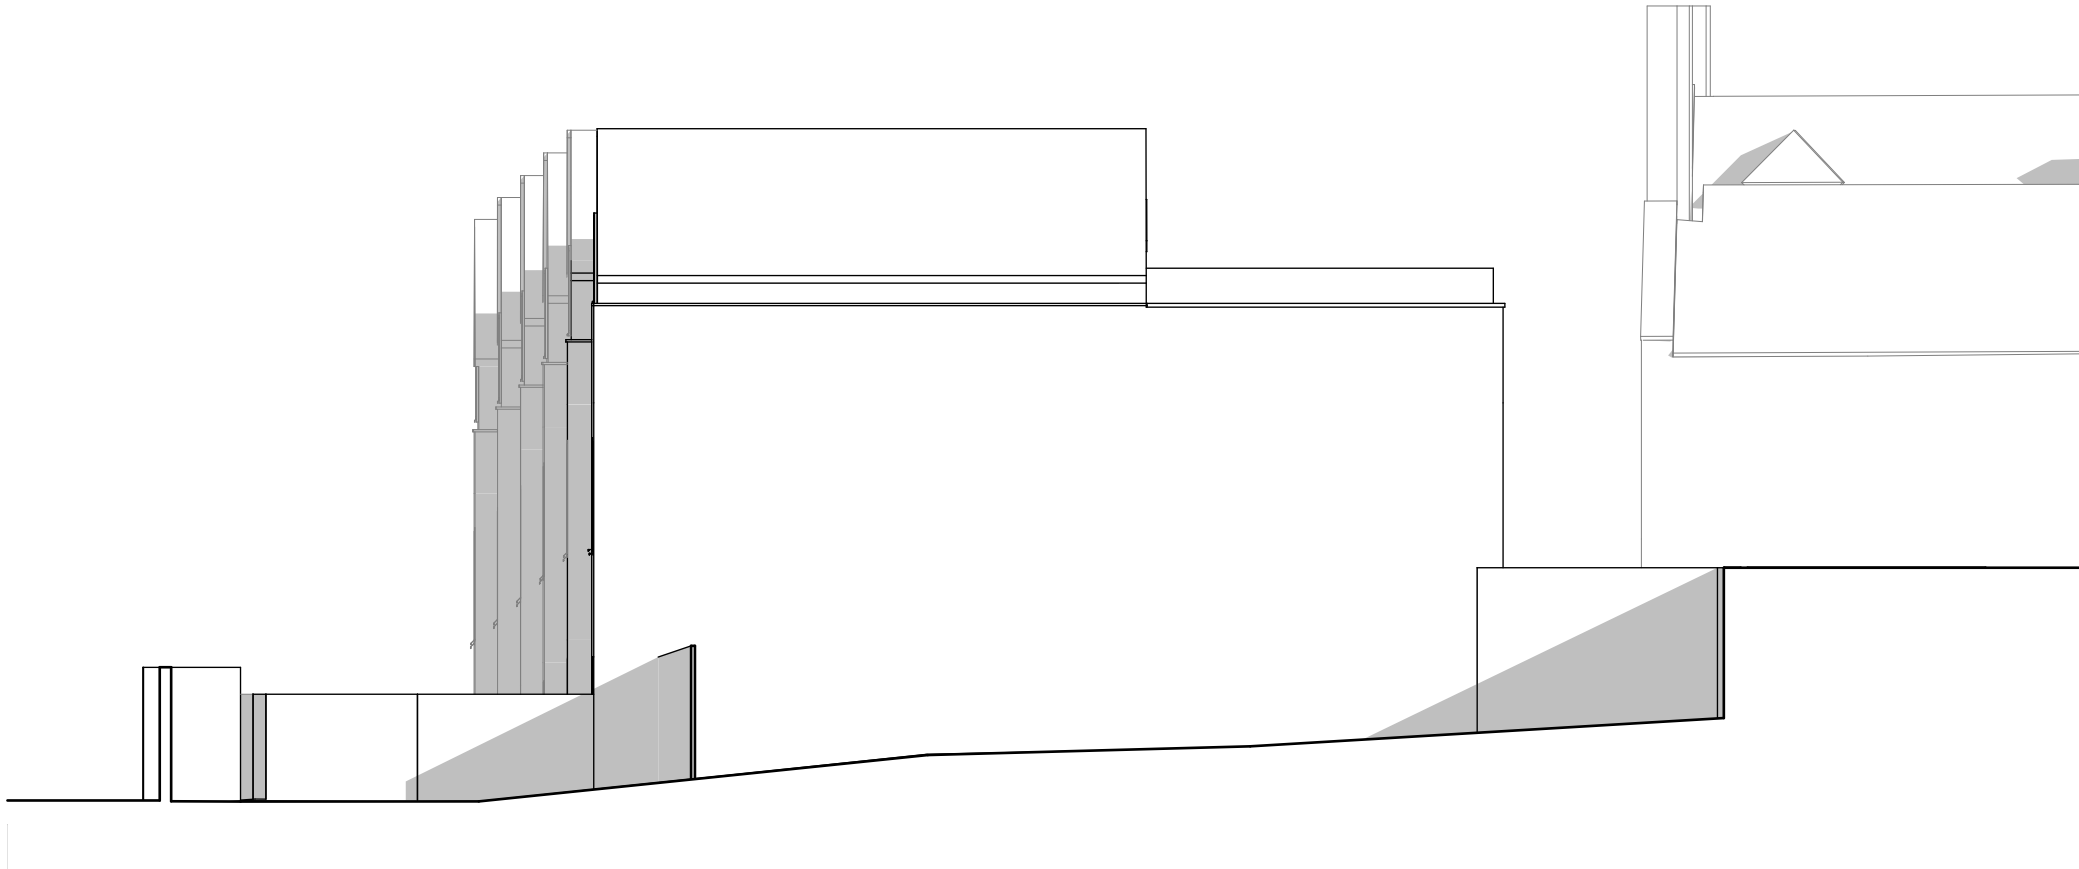

E-04 As-Built West Elevation 04 1:100

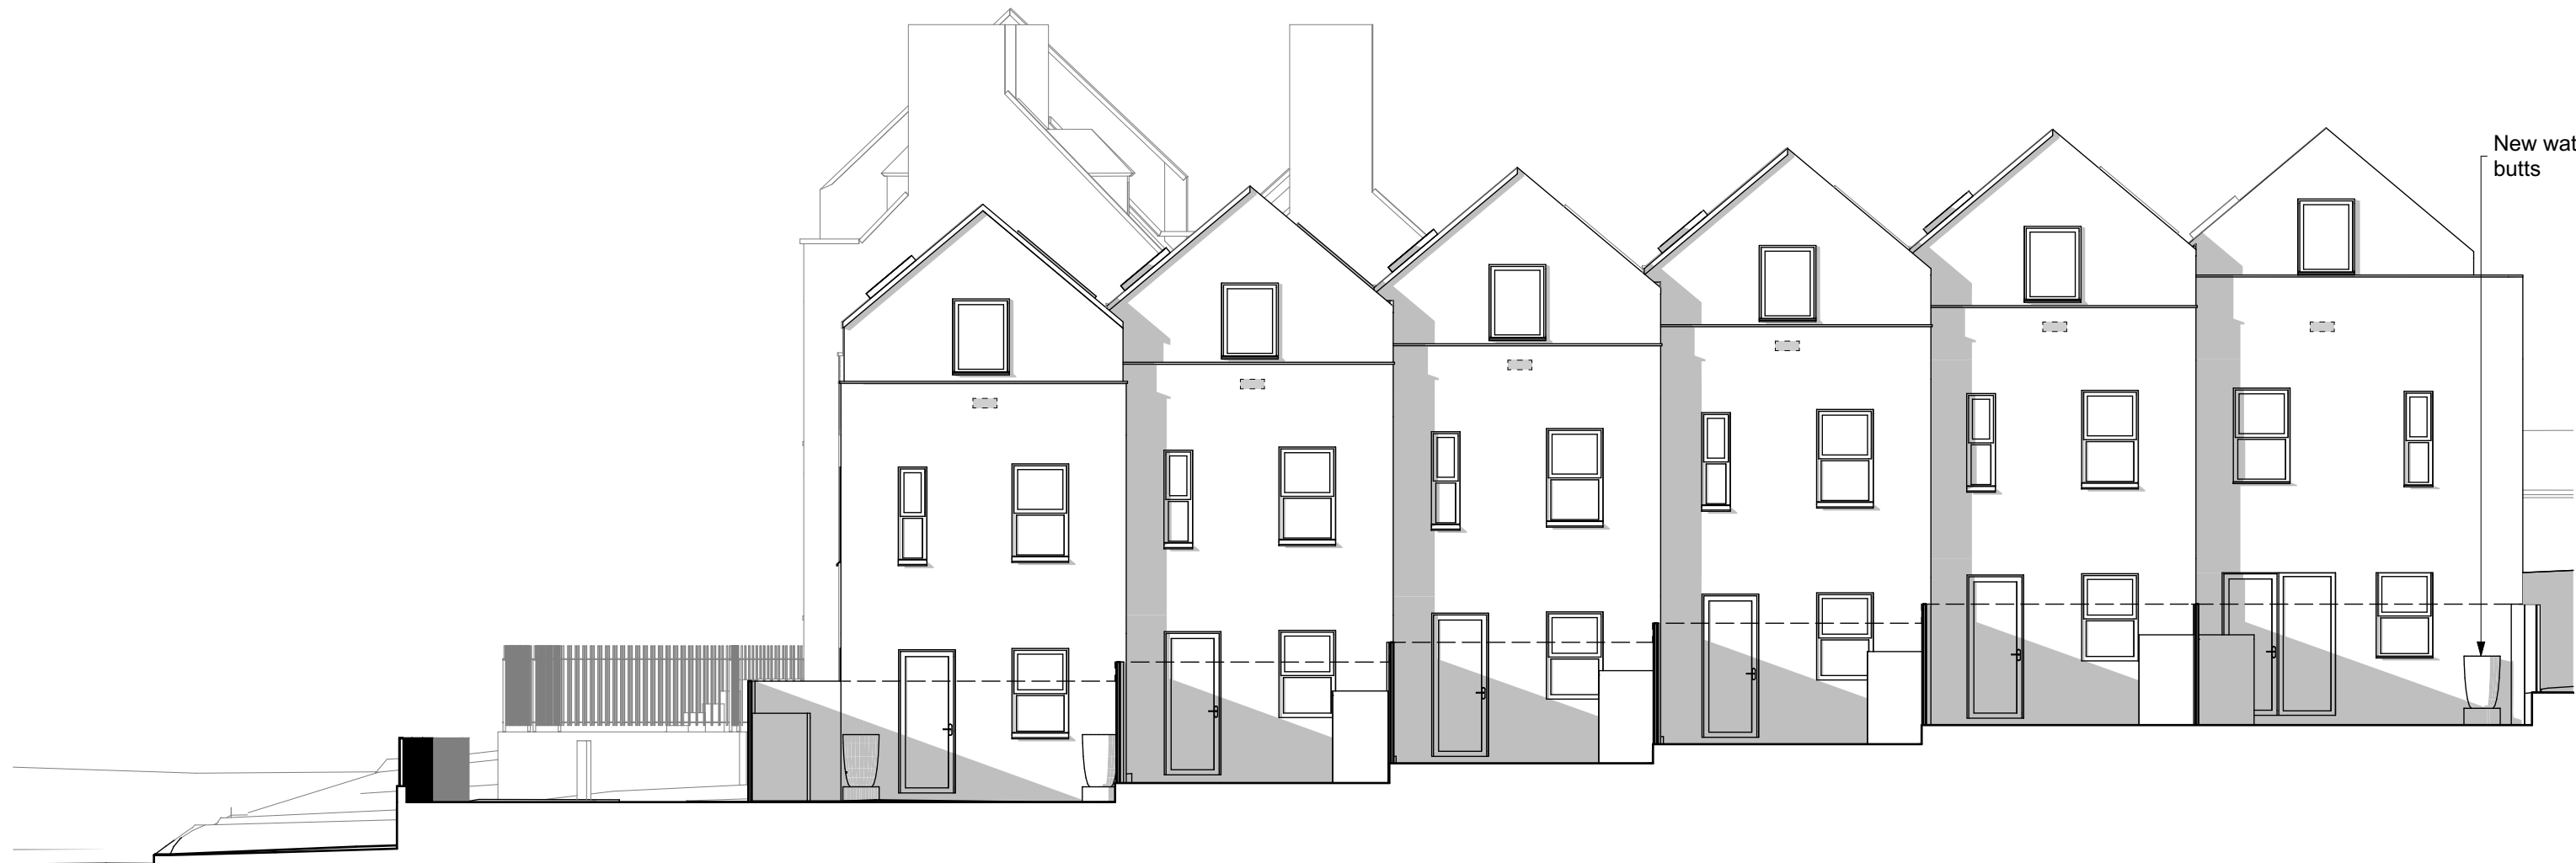

E-03 As-Built North Elevation 03 1:100

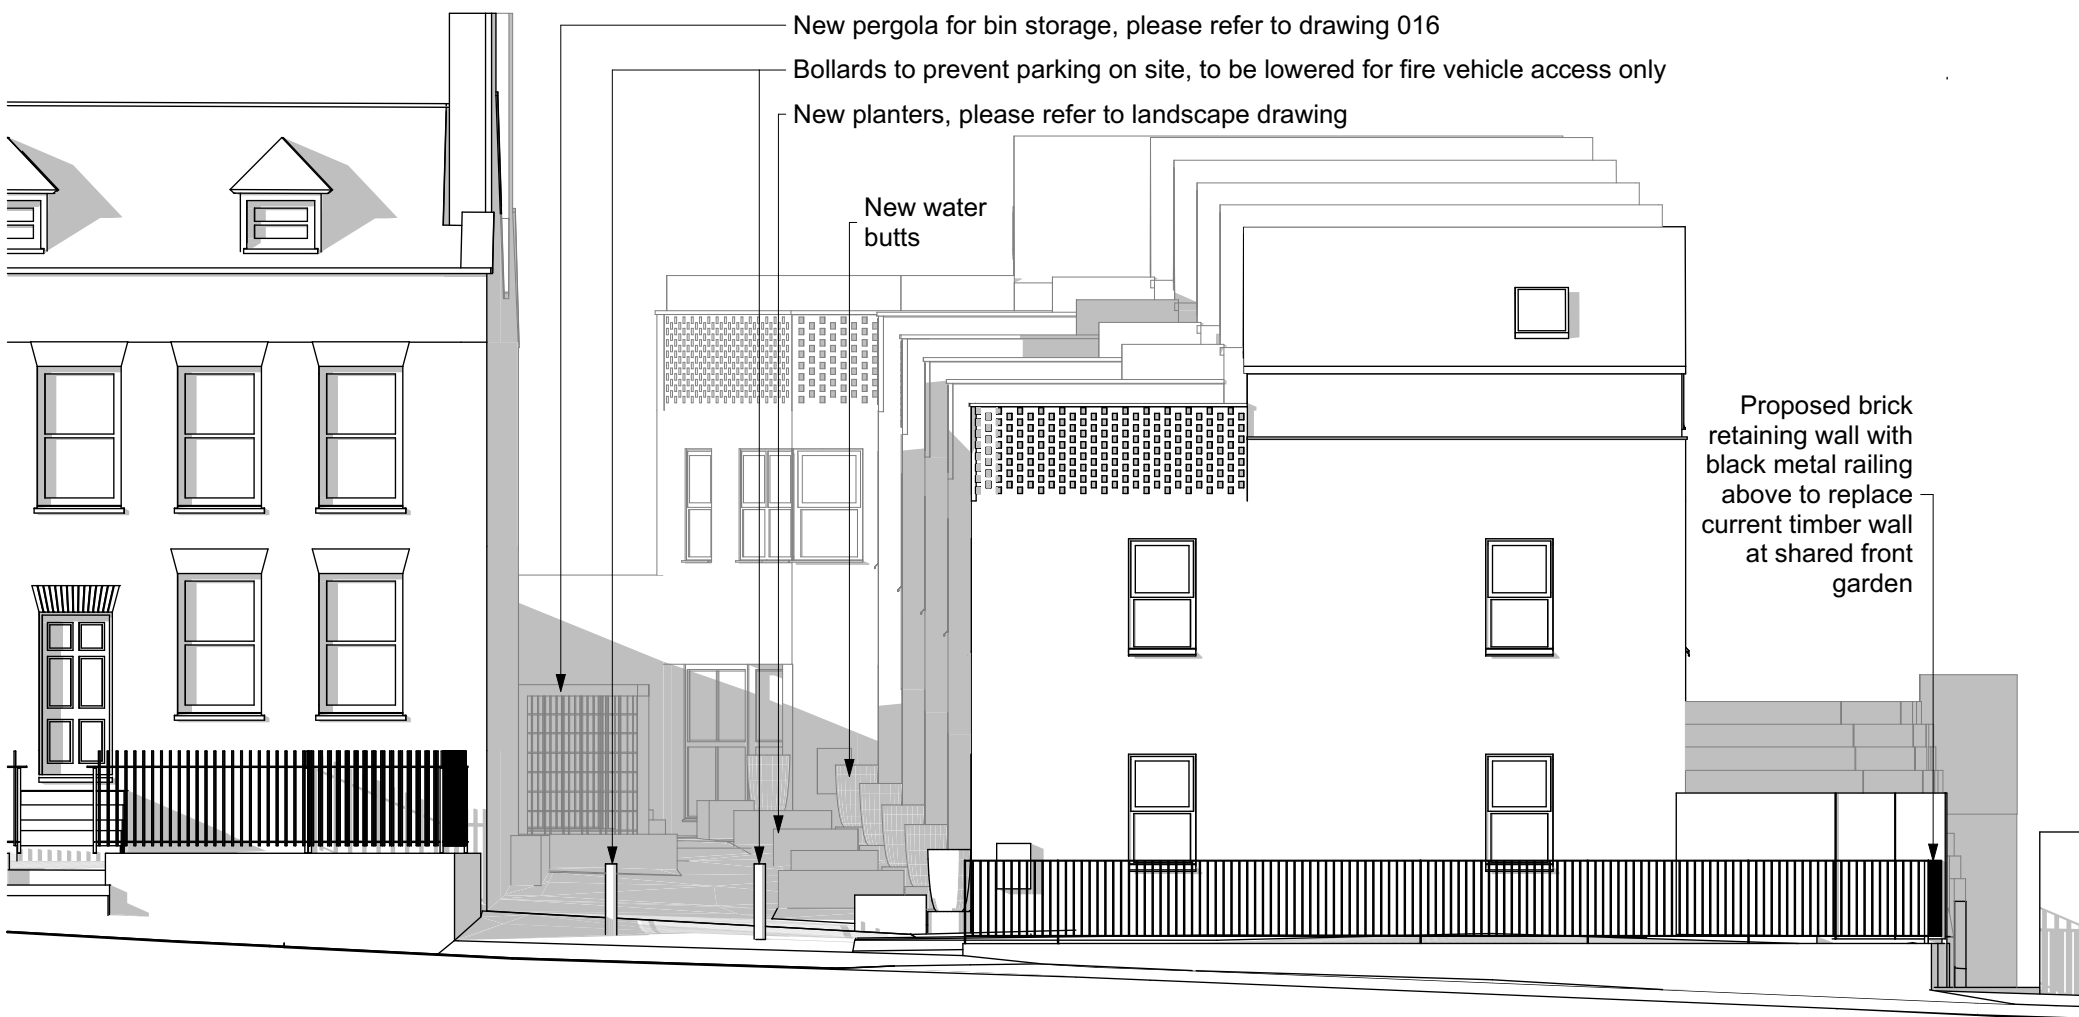

E-02 Proposed East Elevation 02 1:100

NOTES

ORIGINAL A1

NOT FOR CONSTRUCTION
THIS DRAWING IS PREPARED FOR PLANNING ONLY. THE PROPOSAL IS SUBJECT TO PLANNING, BUILDING CONTROL, DETAILED DESIGN, CDM, LEGAL INVESTIGATIONS, SURVEY, ETC. NO STRUCTURAL SURVEY, OR ADVICE HAS BEEN USED IN THE COMPILATION OF THESE DRAWINGS. AREAS SHOWN ARE APPROXIMATE, AND SUBJECT TO DETAILED DESIGN.

(C) COPYRIGHT HIVES ARCHITECTS LLP

DWELLING MATERIALS BUILT AS PER APPROVED DISCHARGE OF CONDITIONS APPLICATION PL/23/0860 ASSOCIATED WITH ORIGINAL PLANNING APPLICATION, UNLESS STATED OTHERWISE

PLEASE REFER TO LANDSCAPE DRAWING FOR DETAILS ON PLANTING, TREES AND SHRUBS OMITTED FOR CLARITY

FOR BIN AND BIKE STORAGE, REFER TO DRAWING 016

0 1 2 5
1:100 SCALE 1:100

11/03/2026 PLANNING ISSUE

Rev

Client

BLOOMFIELD HOMES LIMITED

Site

40-48 Mount Pleasant, Reading, RG1 2TD

Drawing title

As-Built and Proposed Elevations

Scale @ Drawing Size
1:100 @A1

Drawn
GP

Checked
HW

Status

PLANNING

HIVES ARCHITECTS

SINCE 1934

Hives Architects LLP
Quadrant House, Broad Street, Reading, RG1 7QE
0118 958 7331, info@hivesarchitects.co.uk

Project

Drawing

Revision

2787 014P7