


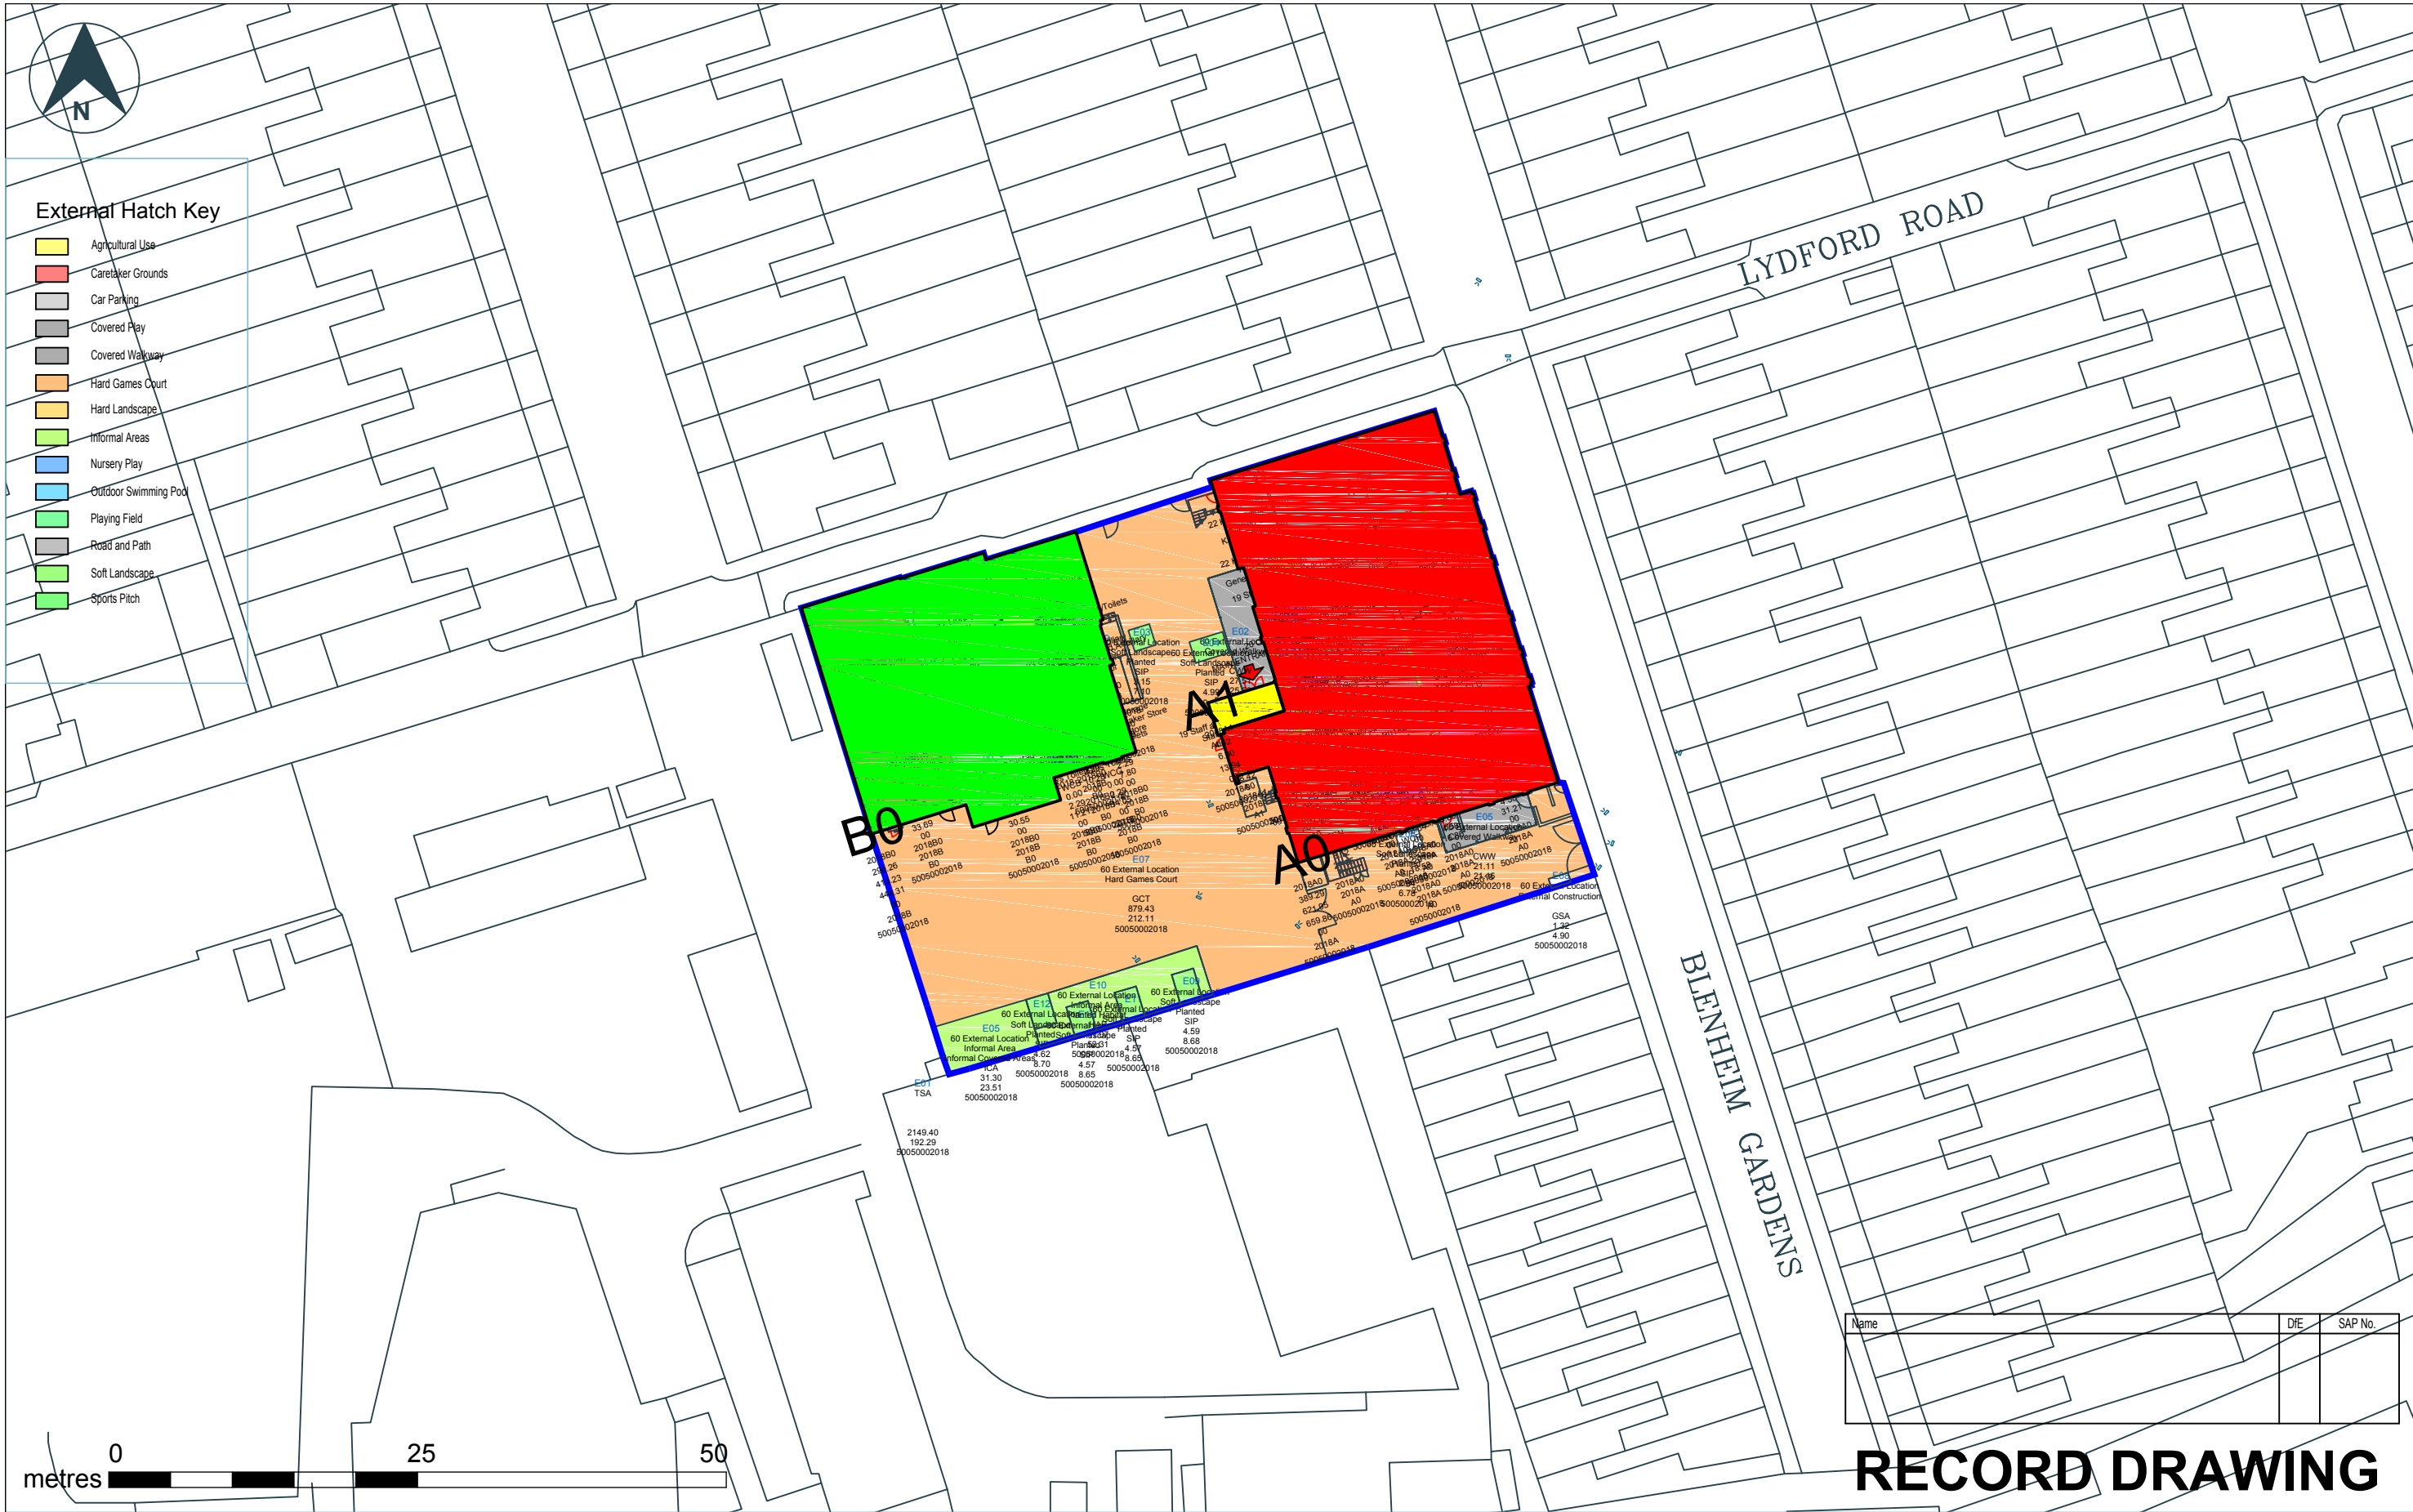

Name	D/E	SAP No.

RECORD DRAWING

 Hampshire
County Council

HCC Property Services,
Three Minsters House,
76 High Street, Winchester SO23 8UL.
Tel: (01962) 847801

NOTES

1 This drawing is © copyright Hampshire County Council 2011. No unauthorised reproduction permitted. All rights reserved.

2 No dimensions are to be scaled from this drawing

3 This map is reproduced from Ordnance Survey material with the permission of Ordnance Survey on behalf of the controller of Her Majesty's Stationery Office © Crown Copyright. Unauthorised reproduction infringes Crown Copyright and may lead to prosecution or civil proceedings. (100019180), (2011)

REV	DESCRIPTION	DATE	BY
A	Initial Supply	08/01/15	CC

PROJECT Redlands Primary School Lydford Road, RG1 5QH 870/2018				SHEET CONTENTS Property Records Site Plan Page 1 of 7	
SCALE 1:250@A1 1:500@A3	DATE 08/01/15	DRAWN. CADCAP	CHKD. ARB	DRAWING No. 01_Rec/001 FILE REF. 2018-50050002018-RedlandsPrimarySchool.dwg	REVISION A

