
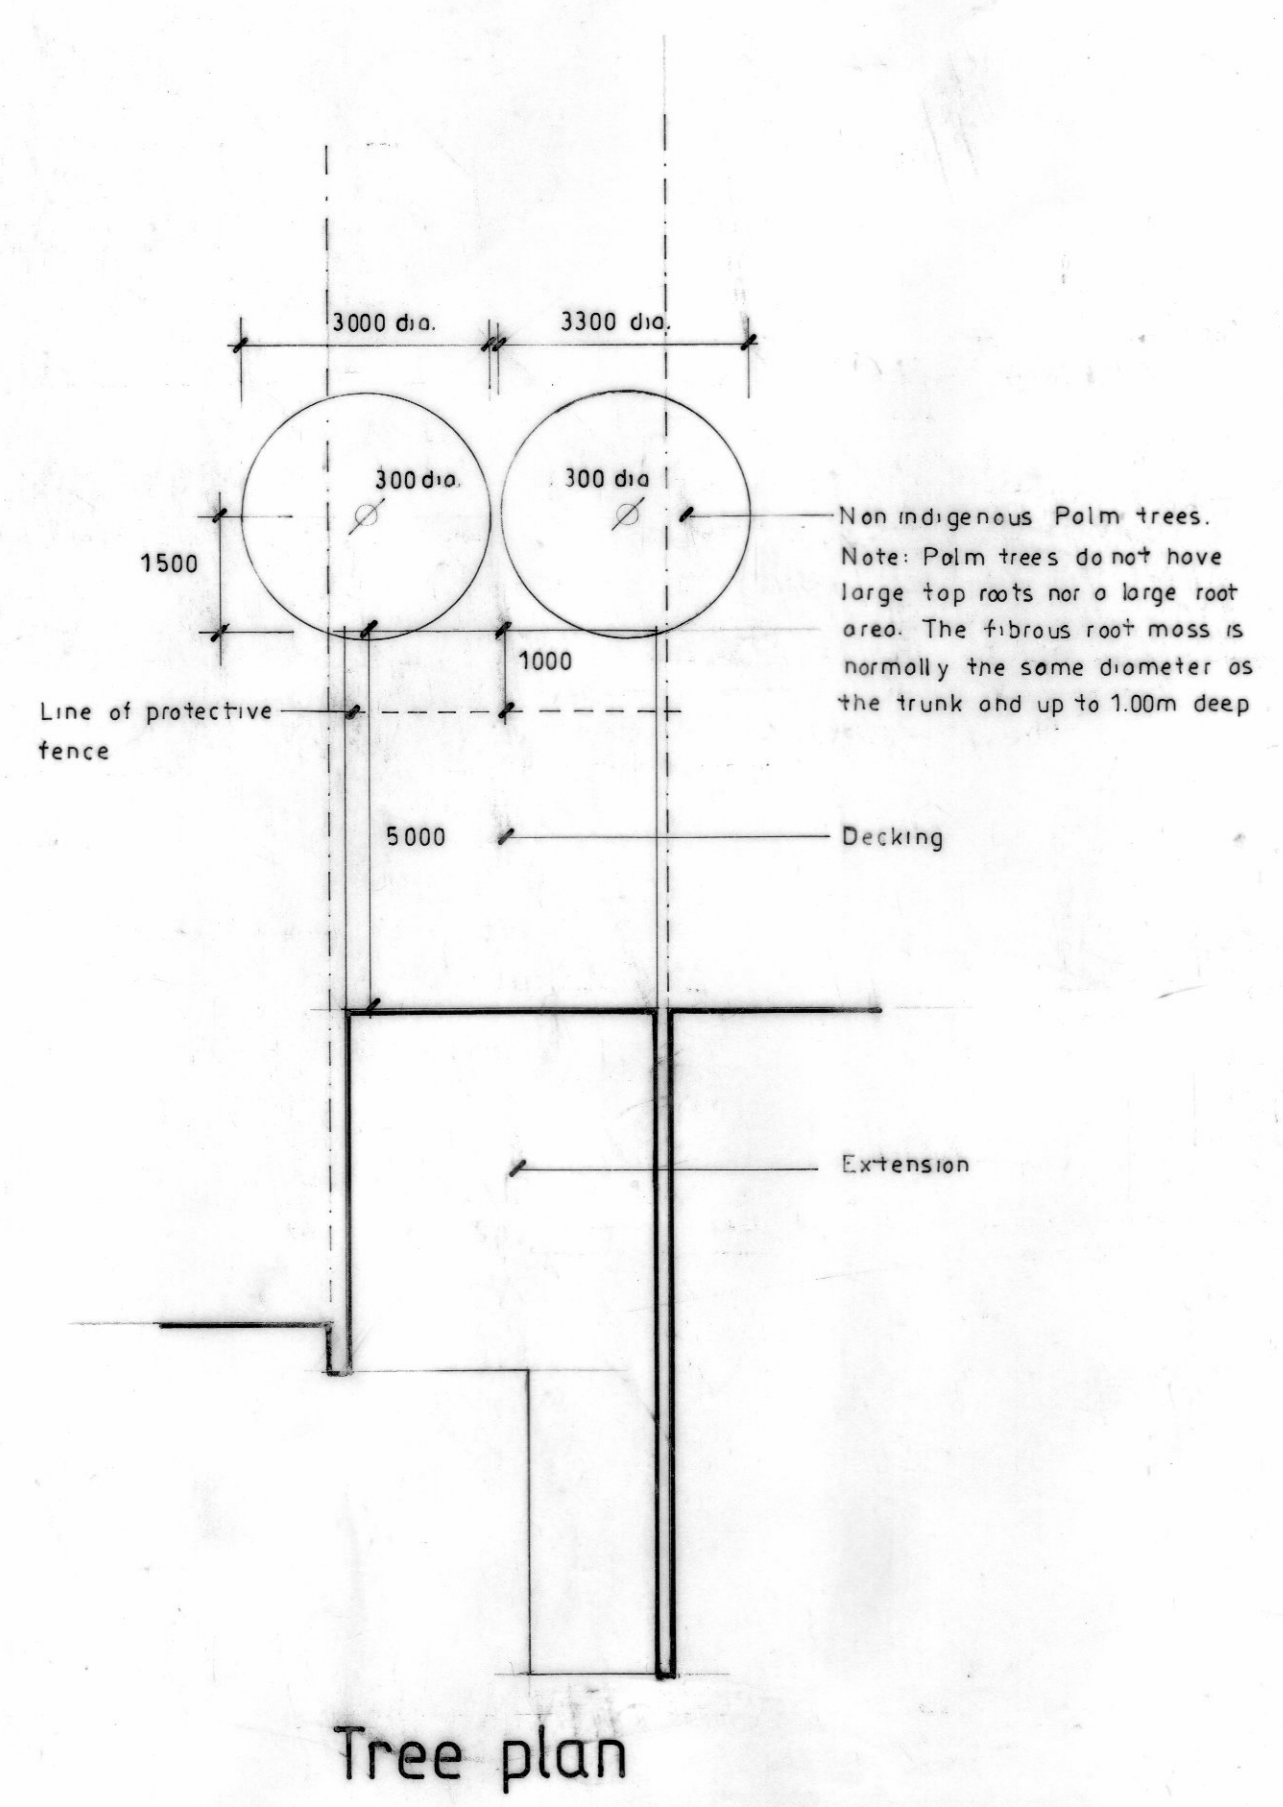
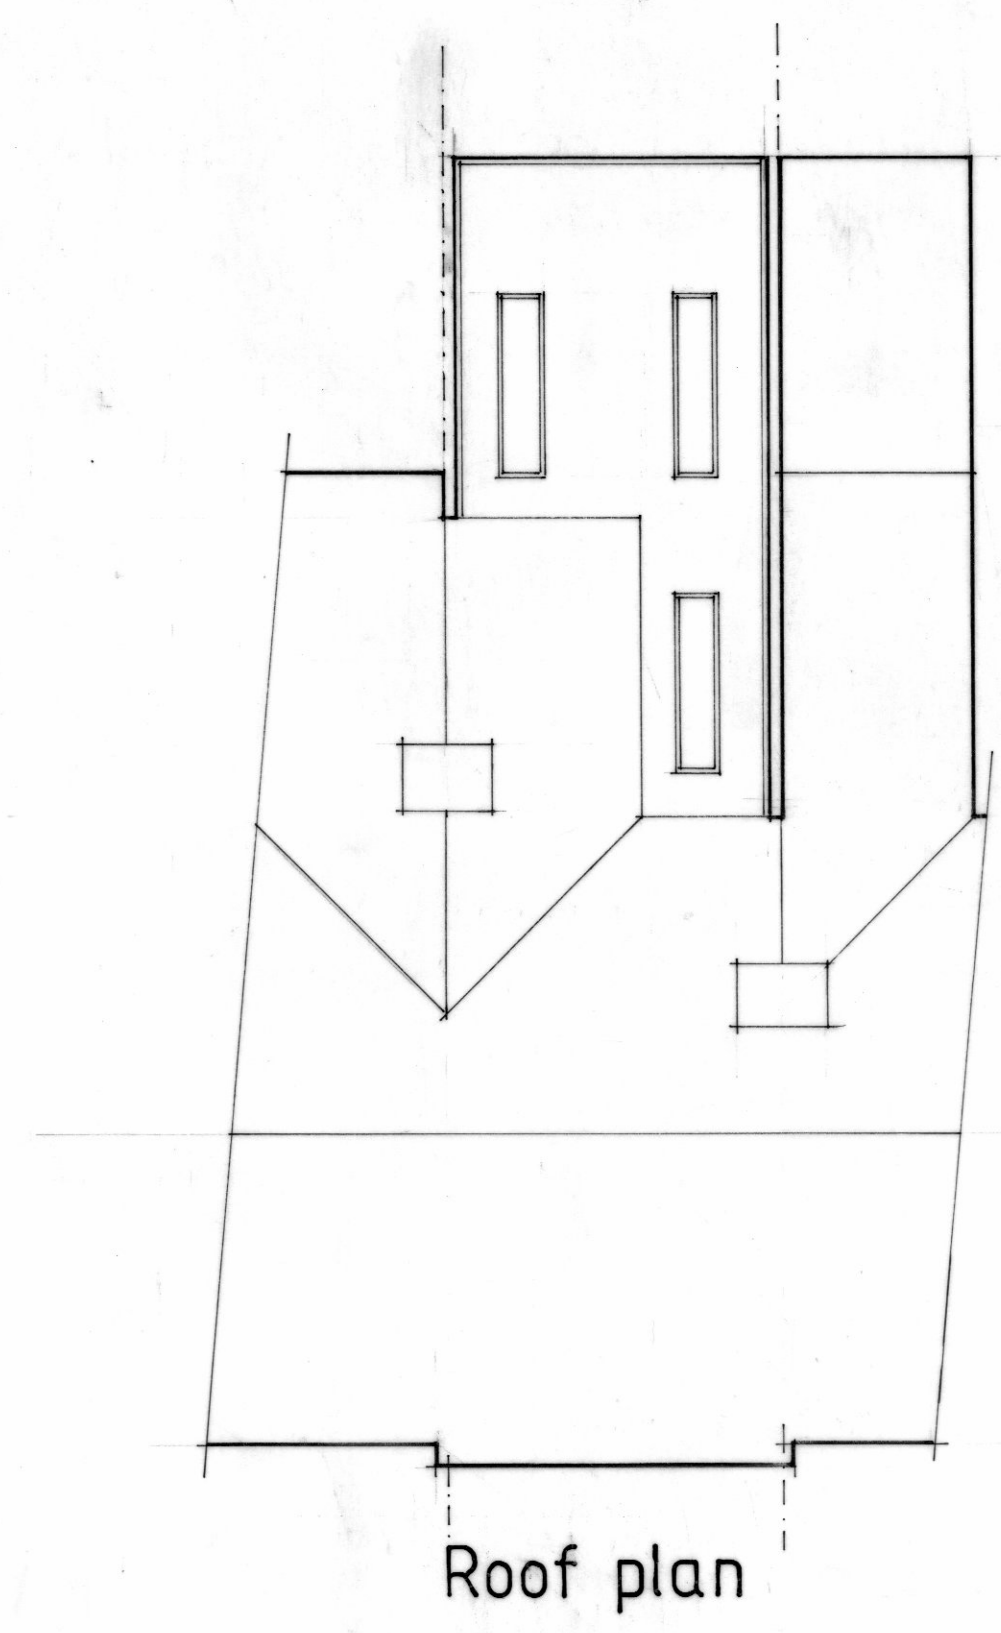
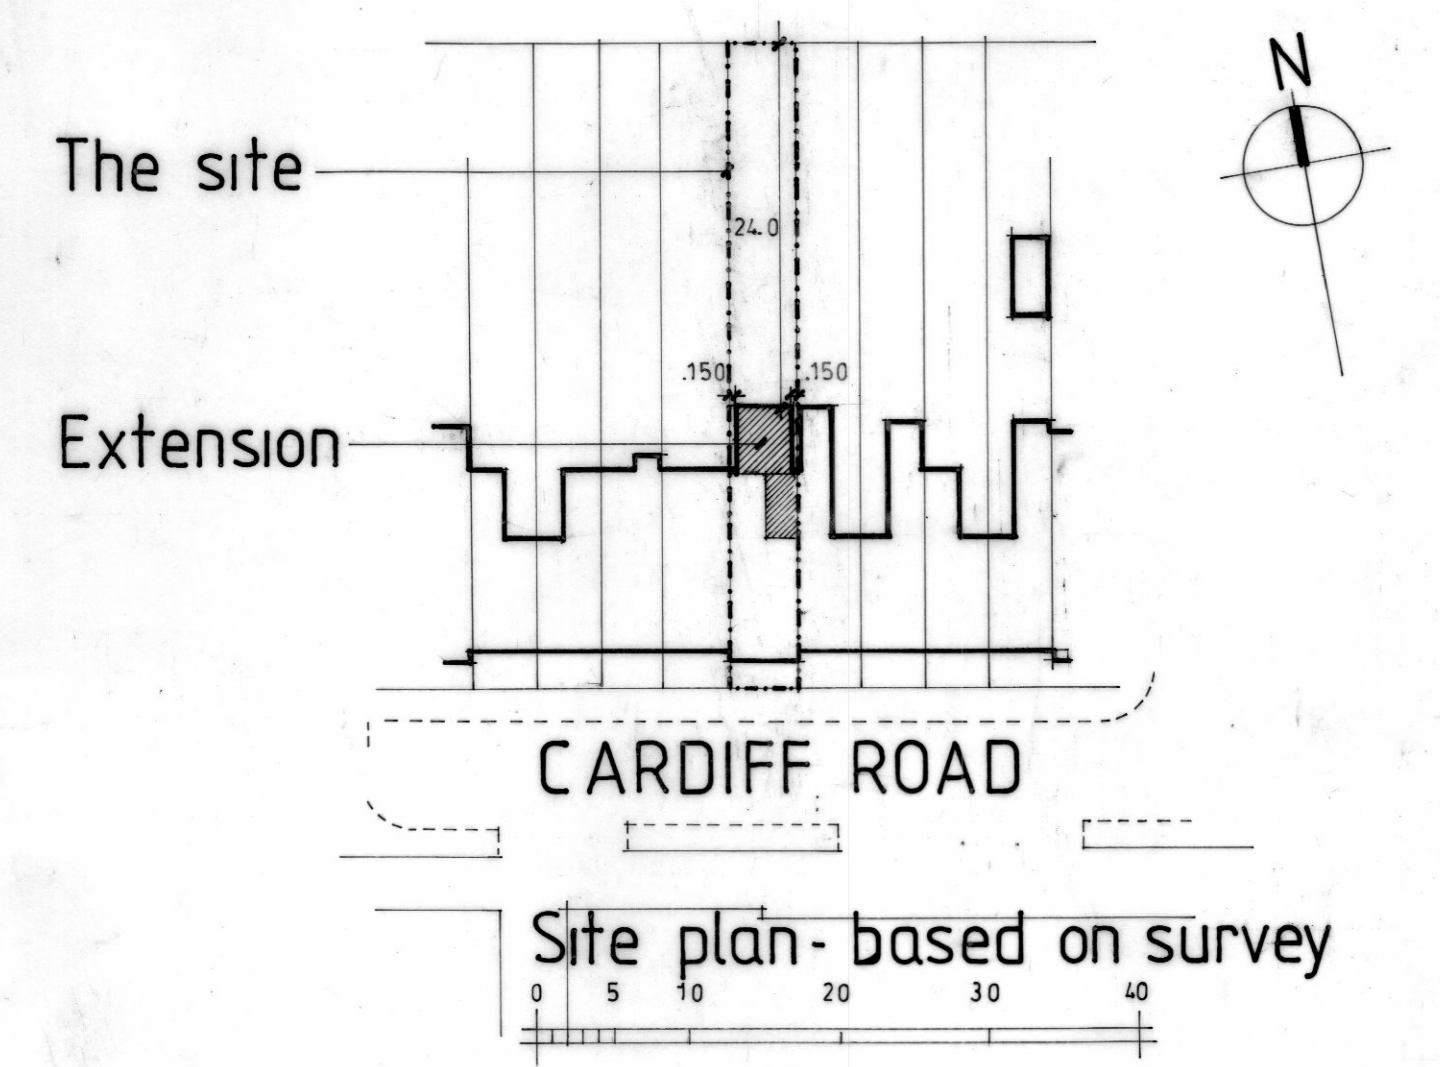
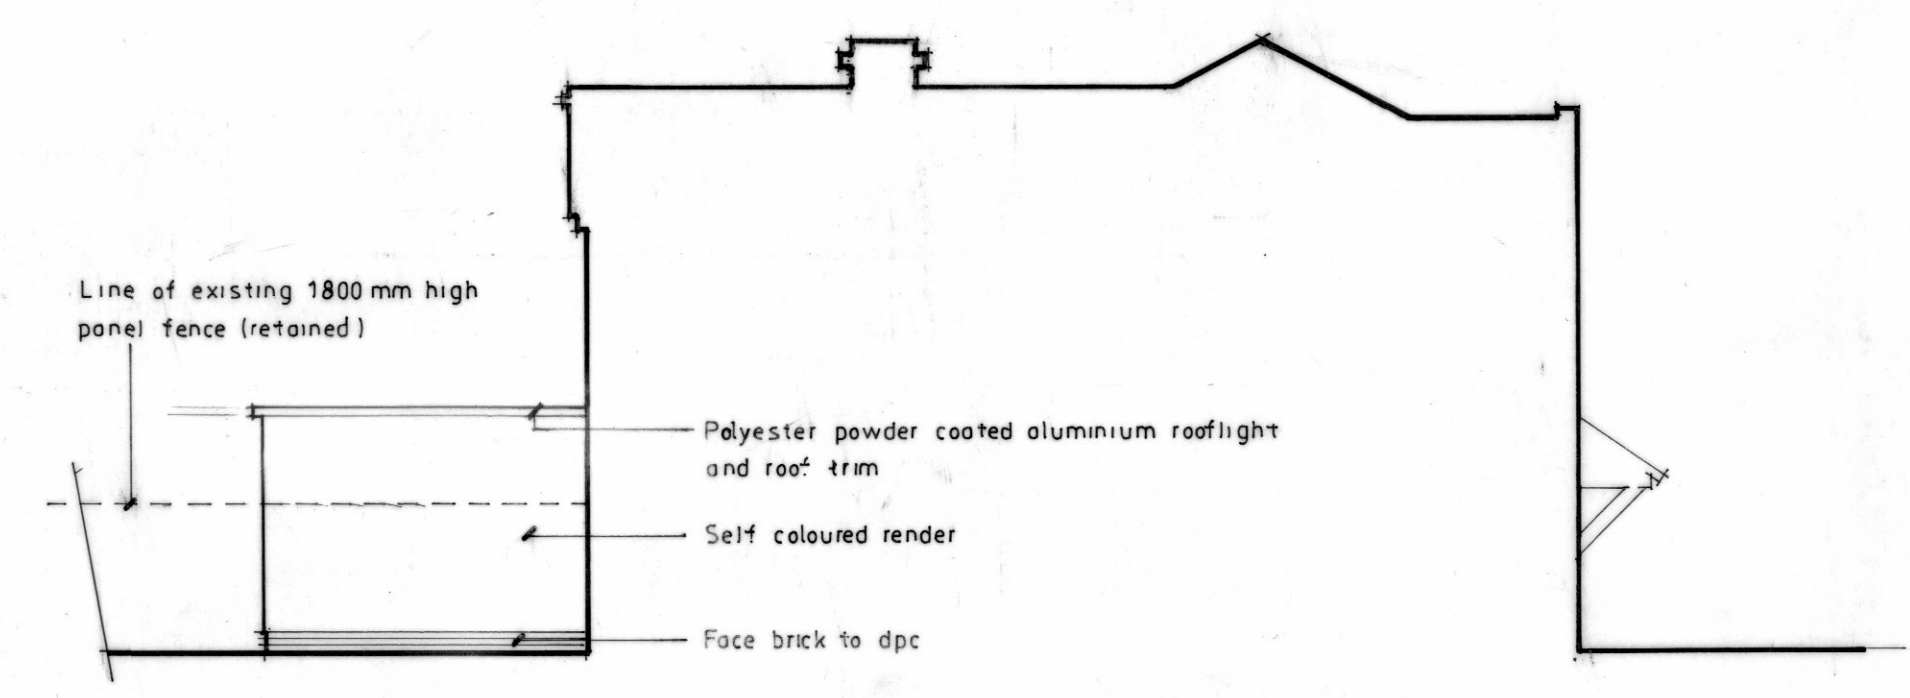
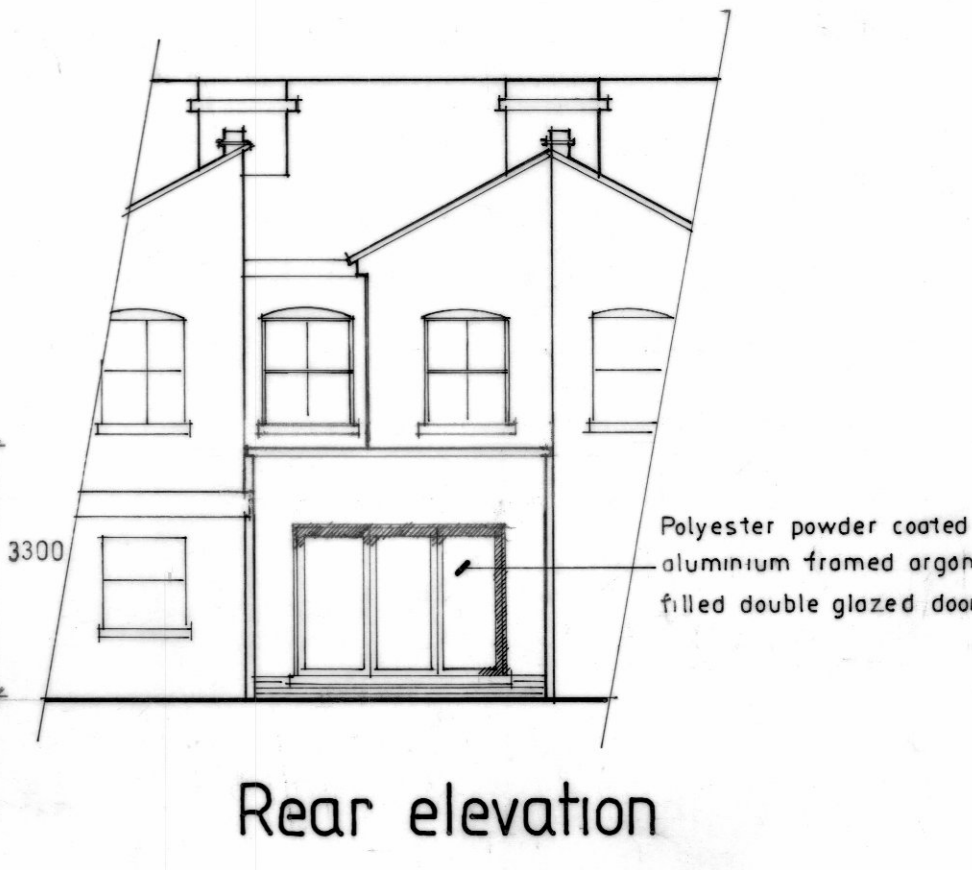
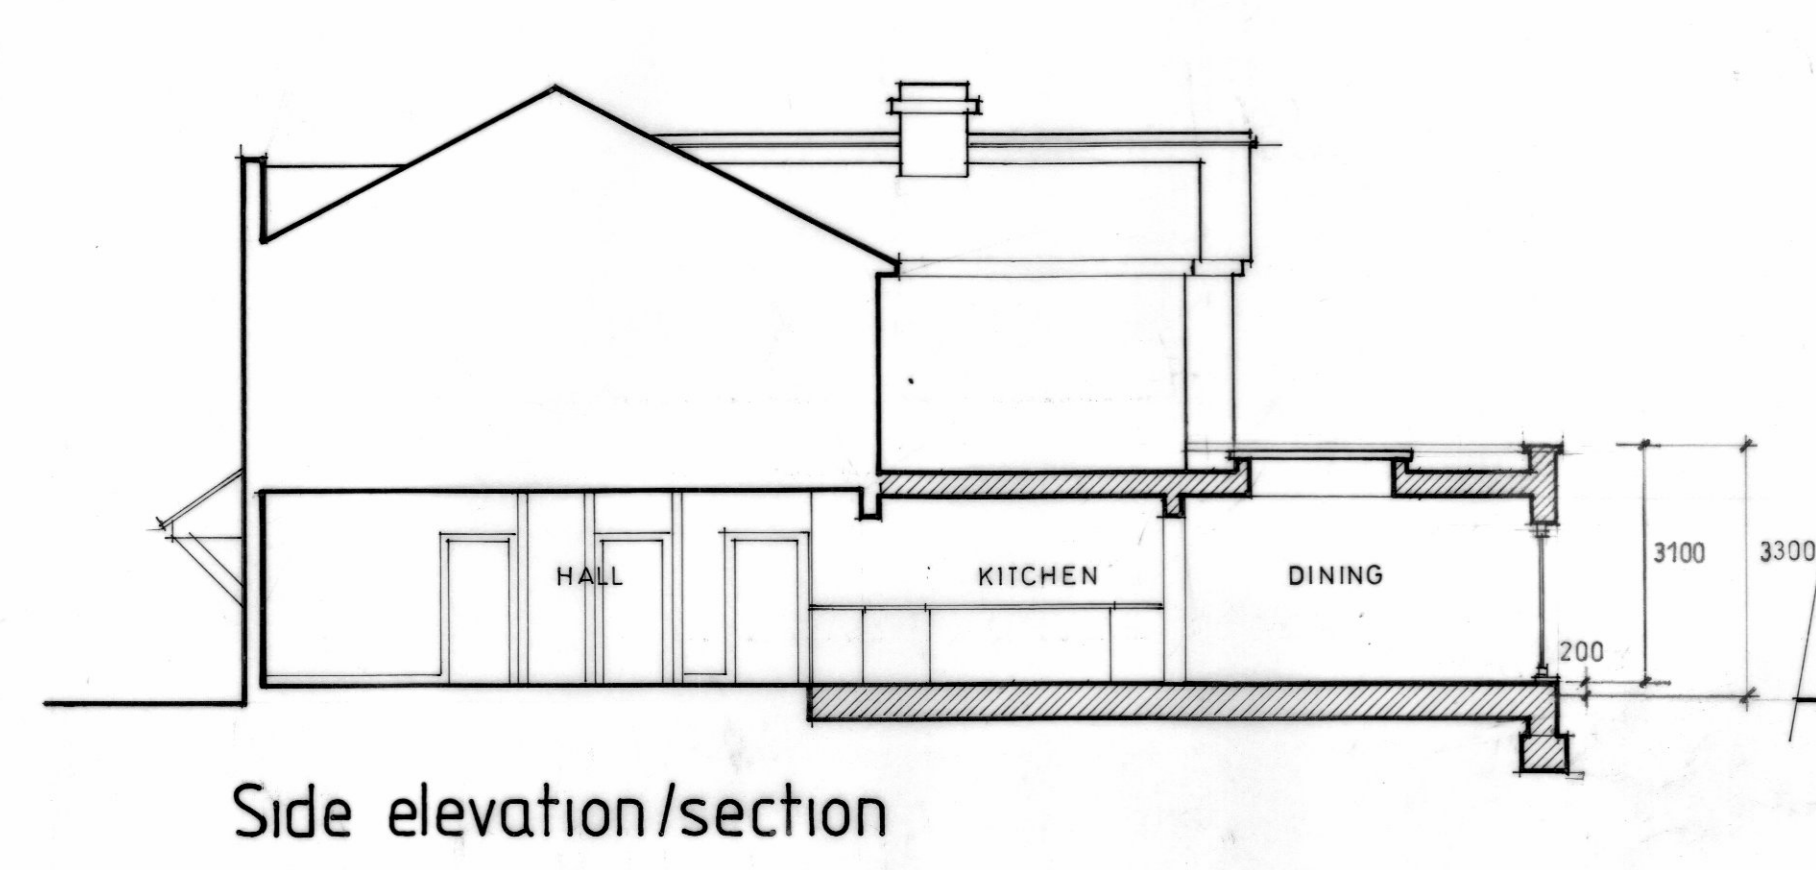


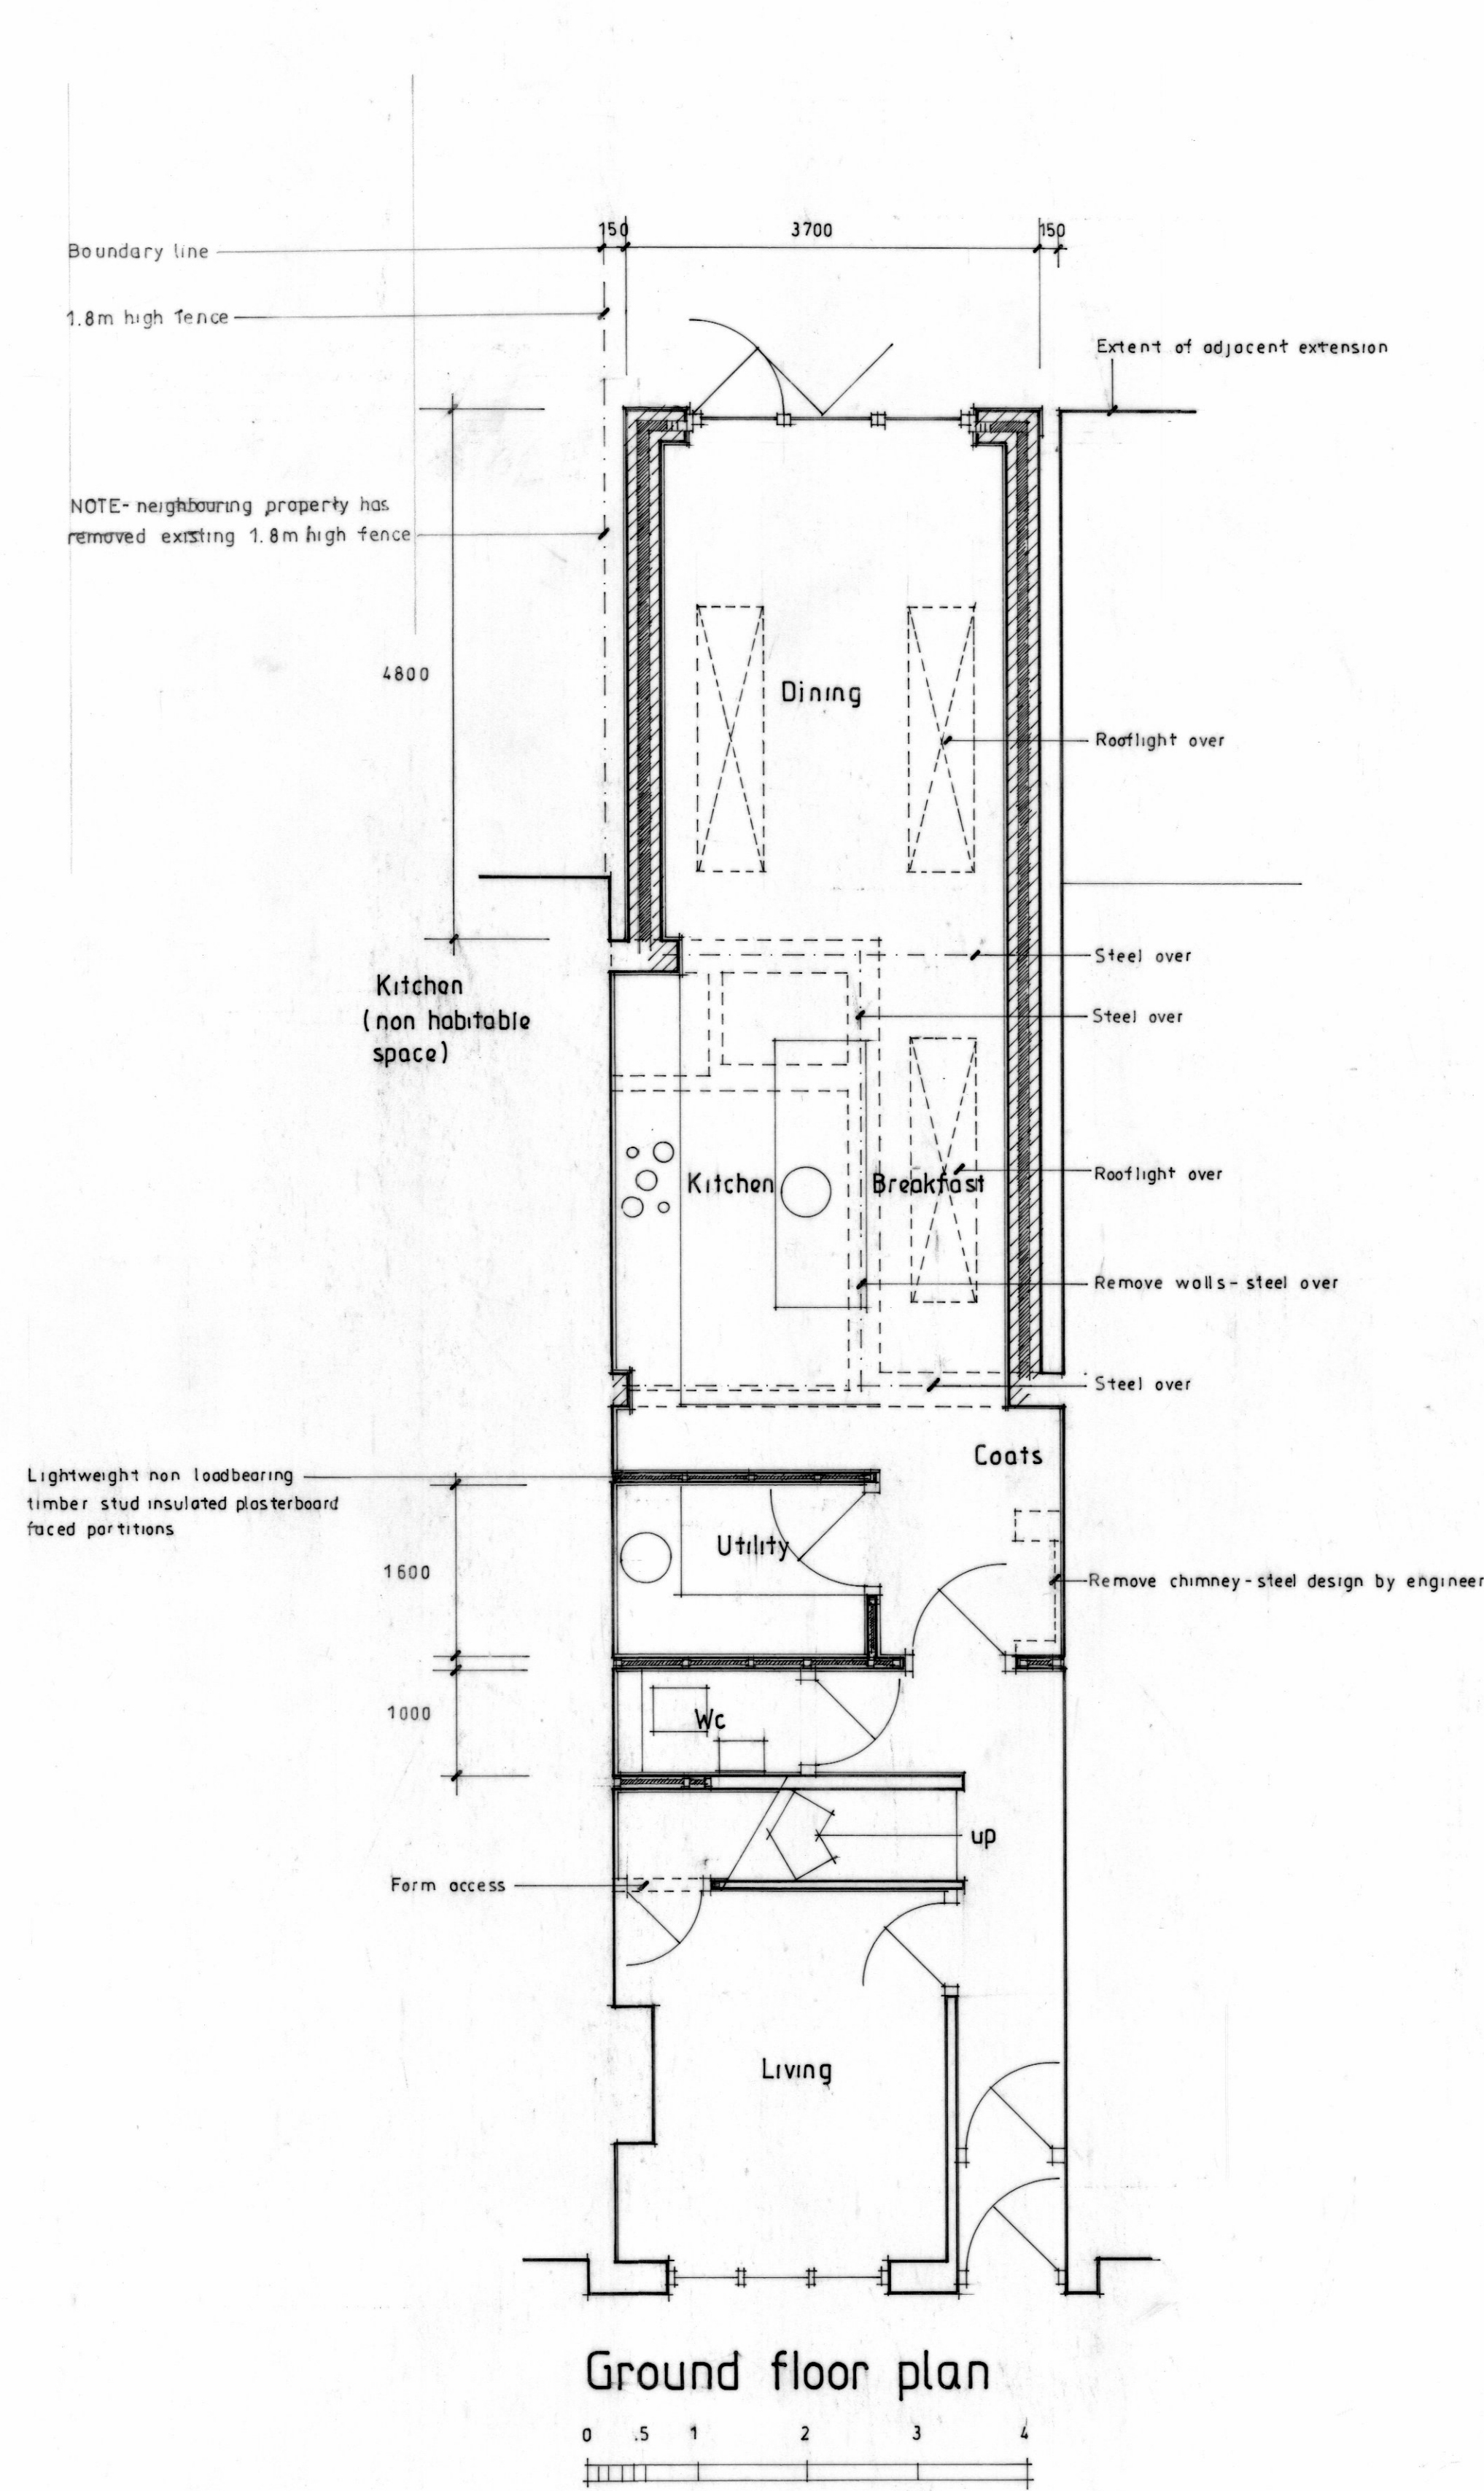

C 16/03/25 Parapet height reduced following confirmation of as built
 B January Parapet height increased to as built
 A June 21 Tree plan indicated. Slab height indicated on section.

project Single storey rear extension
 location 50 Cardiff Road, Reading
 drawing Proposed
 drawing no. 1150 / 05 A & C
 scale 1 : 50 1 : 100 1 : 500
 date May 2024

T.Neal Ltd
 Architectural Design

Mobile: 07970 778 404
 Email: tneal11td@gmail.com
 6 Rockwood, Alton, Hampshire GU34 2AP