

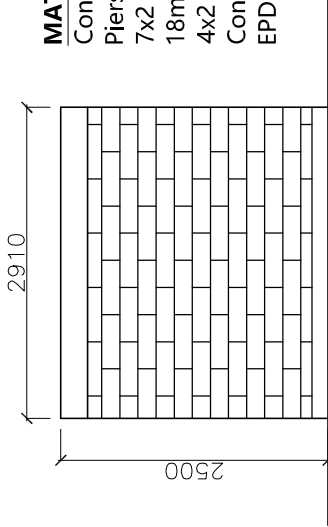
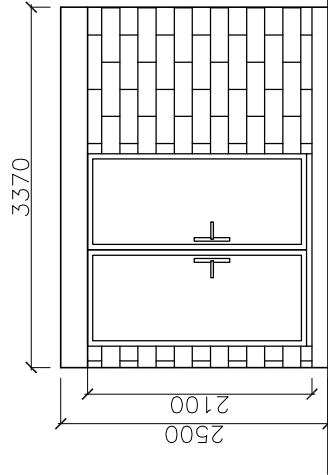


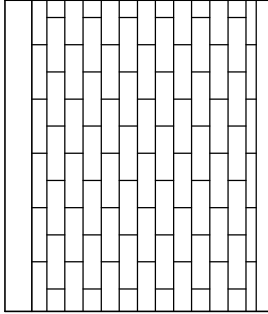

- MATERIALS**
- Concrete block single skin
  - Piers internal
  - 7x2 C24 roof joist
  - 18mm OSB board ceiling
  - 4x2 C24 wall plate
  - Concrete lintle 2.4m pre stressed
  - EPDM rubber flat roof

As-Built And  
Proposed Front Elevation

As-Built And  
Proposed Side Elevation

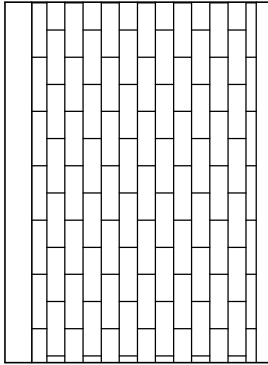

As-Built And  
Proposed Rear Elevation

As-Built And  
Proposed Side Elevation



|                                                                            |                           |
|----------------------------------------------------------------------------|---------------------------|
| <b>Project</b><br>WILSON PRIMARY SCHOOL<br>WILSON ROAD READING<br>RG30 2RW |                           |
| <b>Drawing</b><br>AS-BUILT AND PROPOSED ELEVATIONS                         |                           |
| <b>Dwg No.</b><br>104                                                      | <b>Date</b><br>APRIL 2026 |
| <b>Scale @ A3</b><br>1:50                                                  |                           |

