



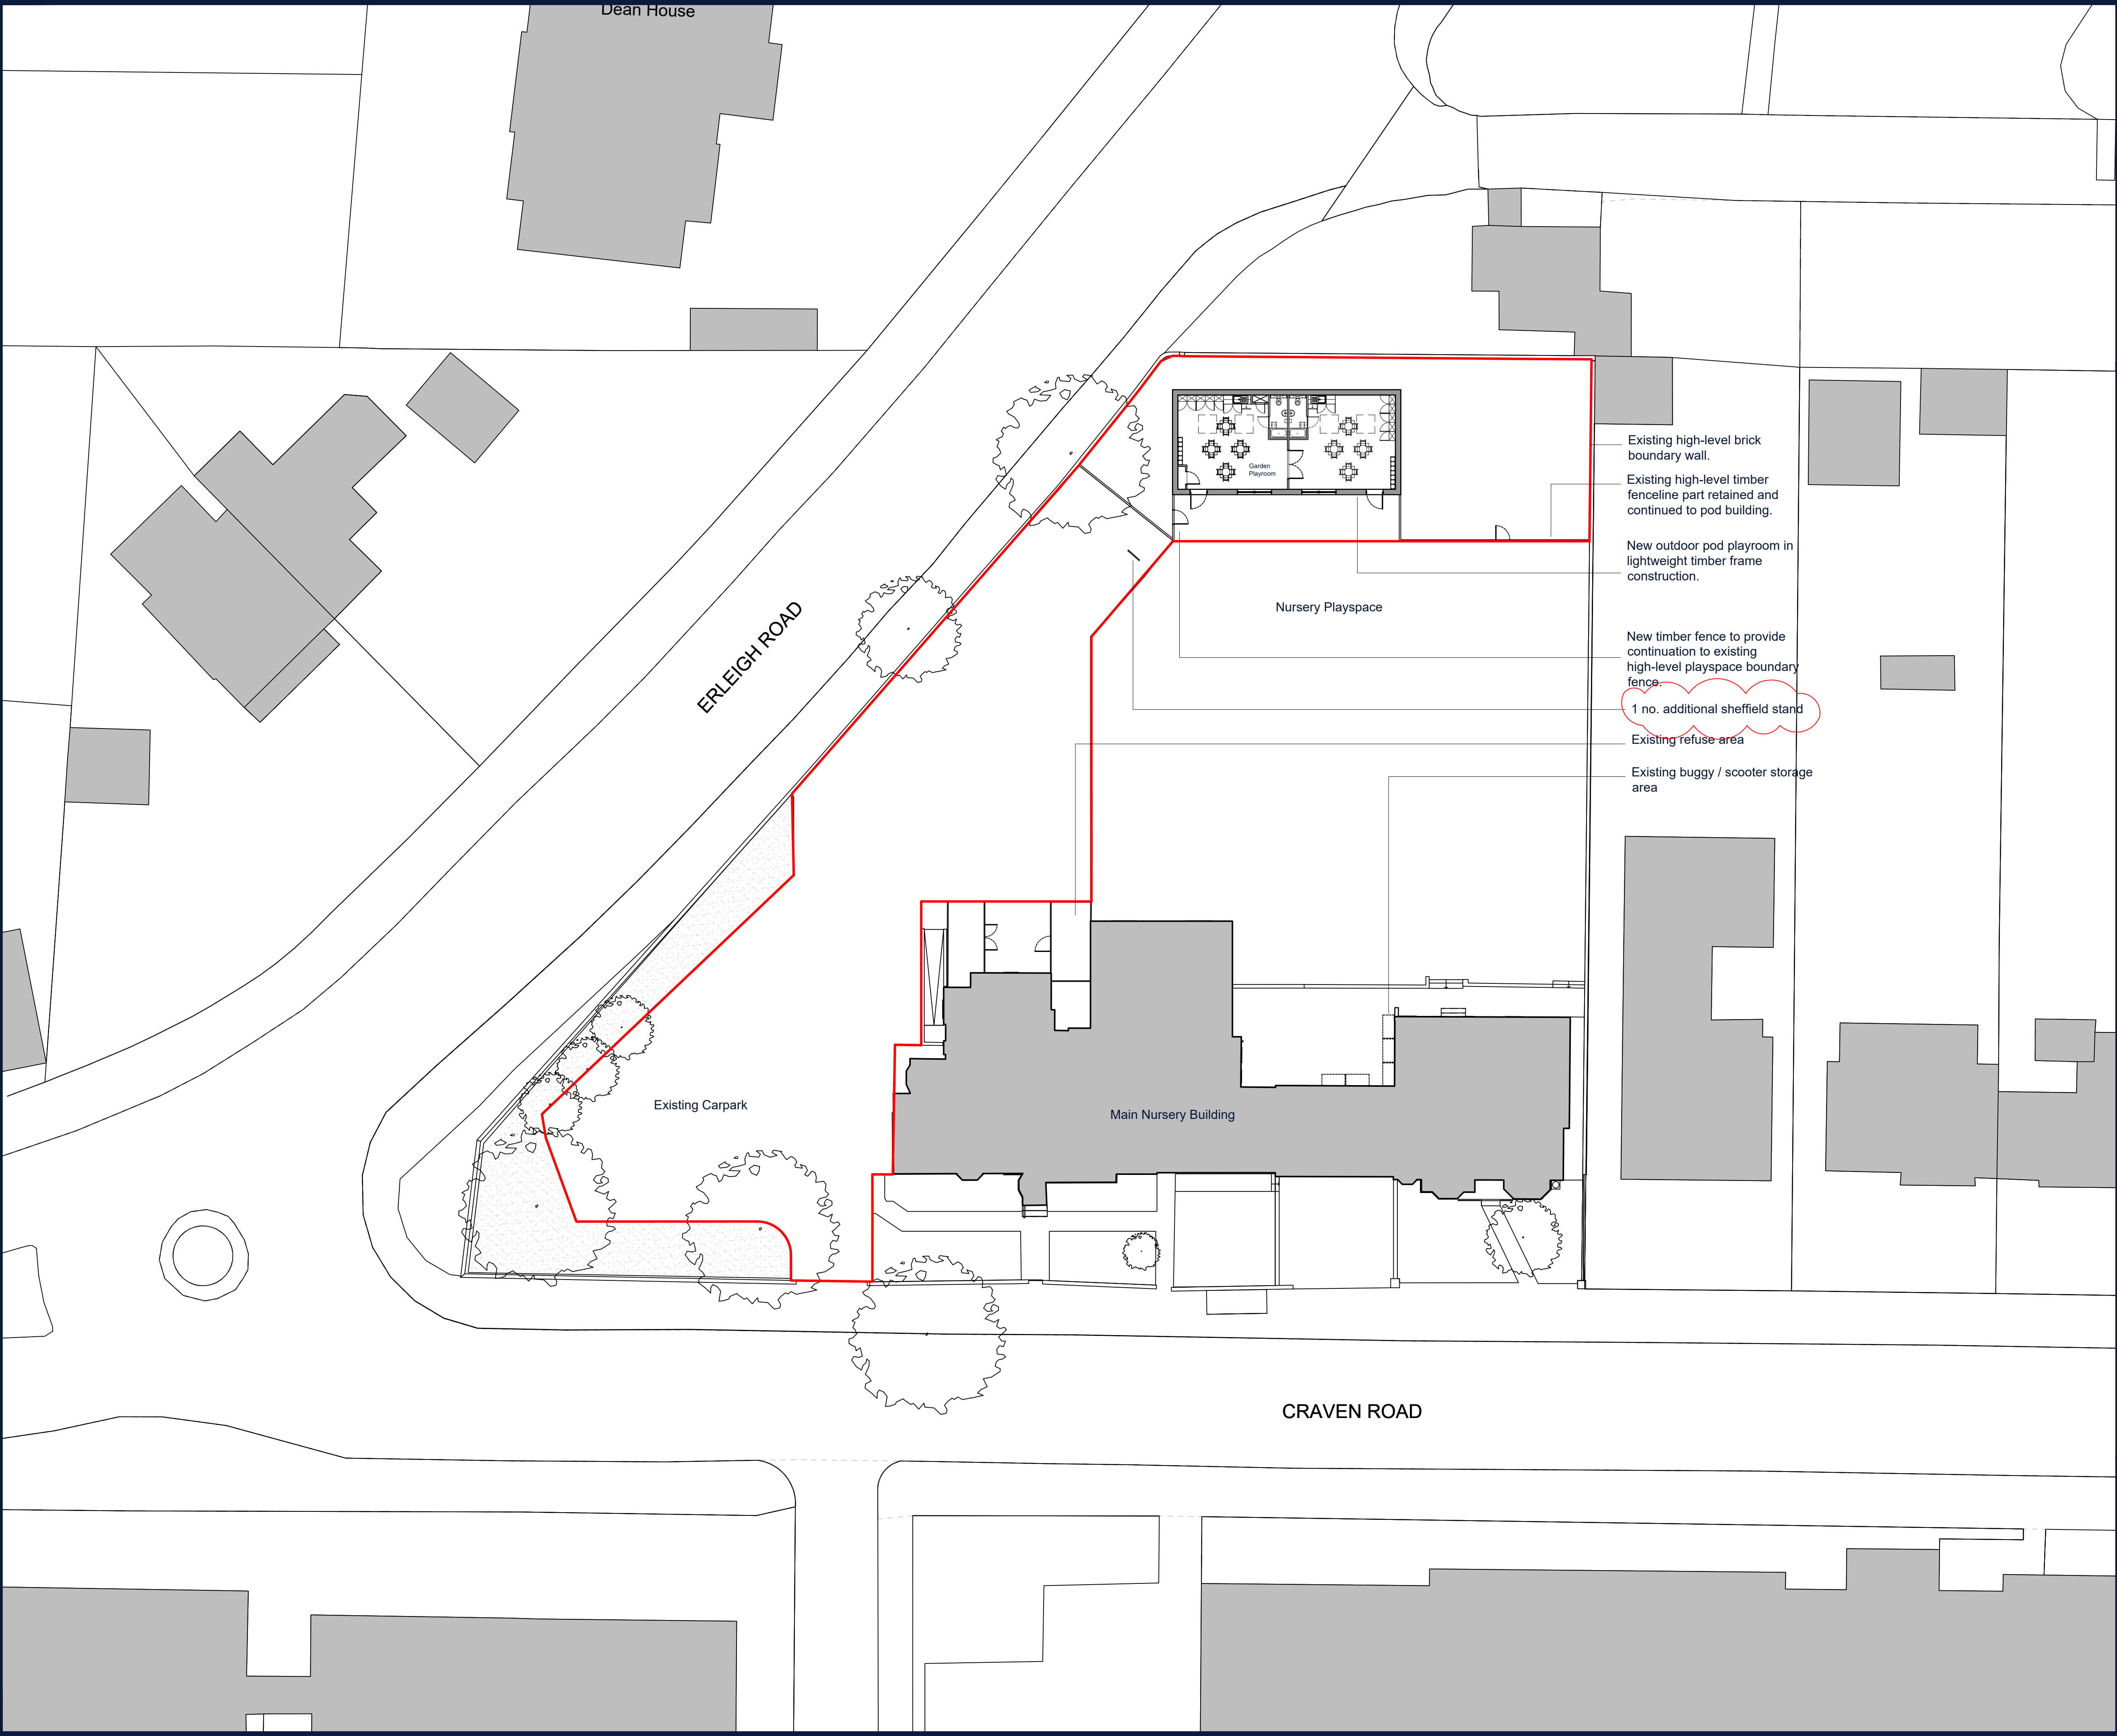

Rev	Date	Note
P1	27.03.26	Planning Issue
P2	12.05.26	Red line updated

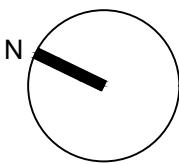

Drawing Title
Site Plan - Proposed

Project
3-5 Craven Road
Reading

Drawing Number
CRR001-PL003

Status
For Planning

Drawing Revision
P2

Scale
1:200 @ A1, 1:400 @ A3

Origination Date
26-01-2026